


187

RS 7/83

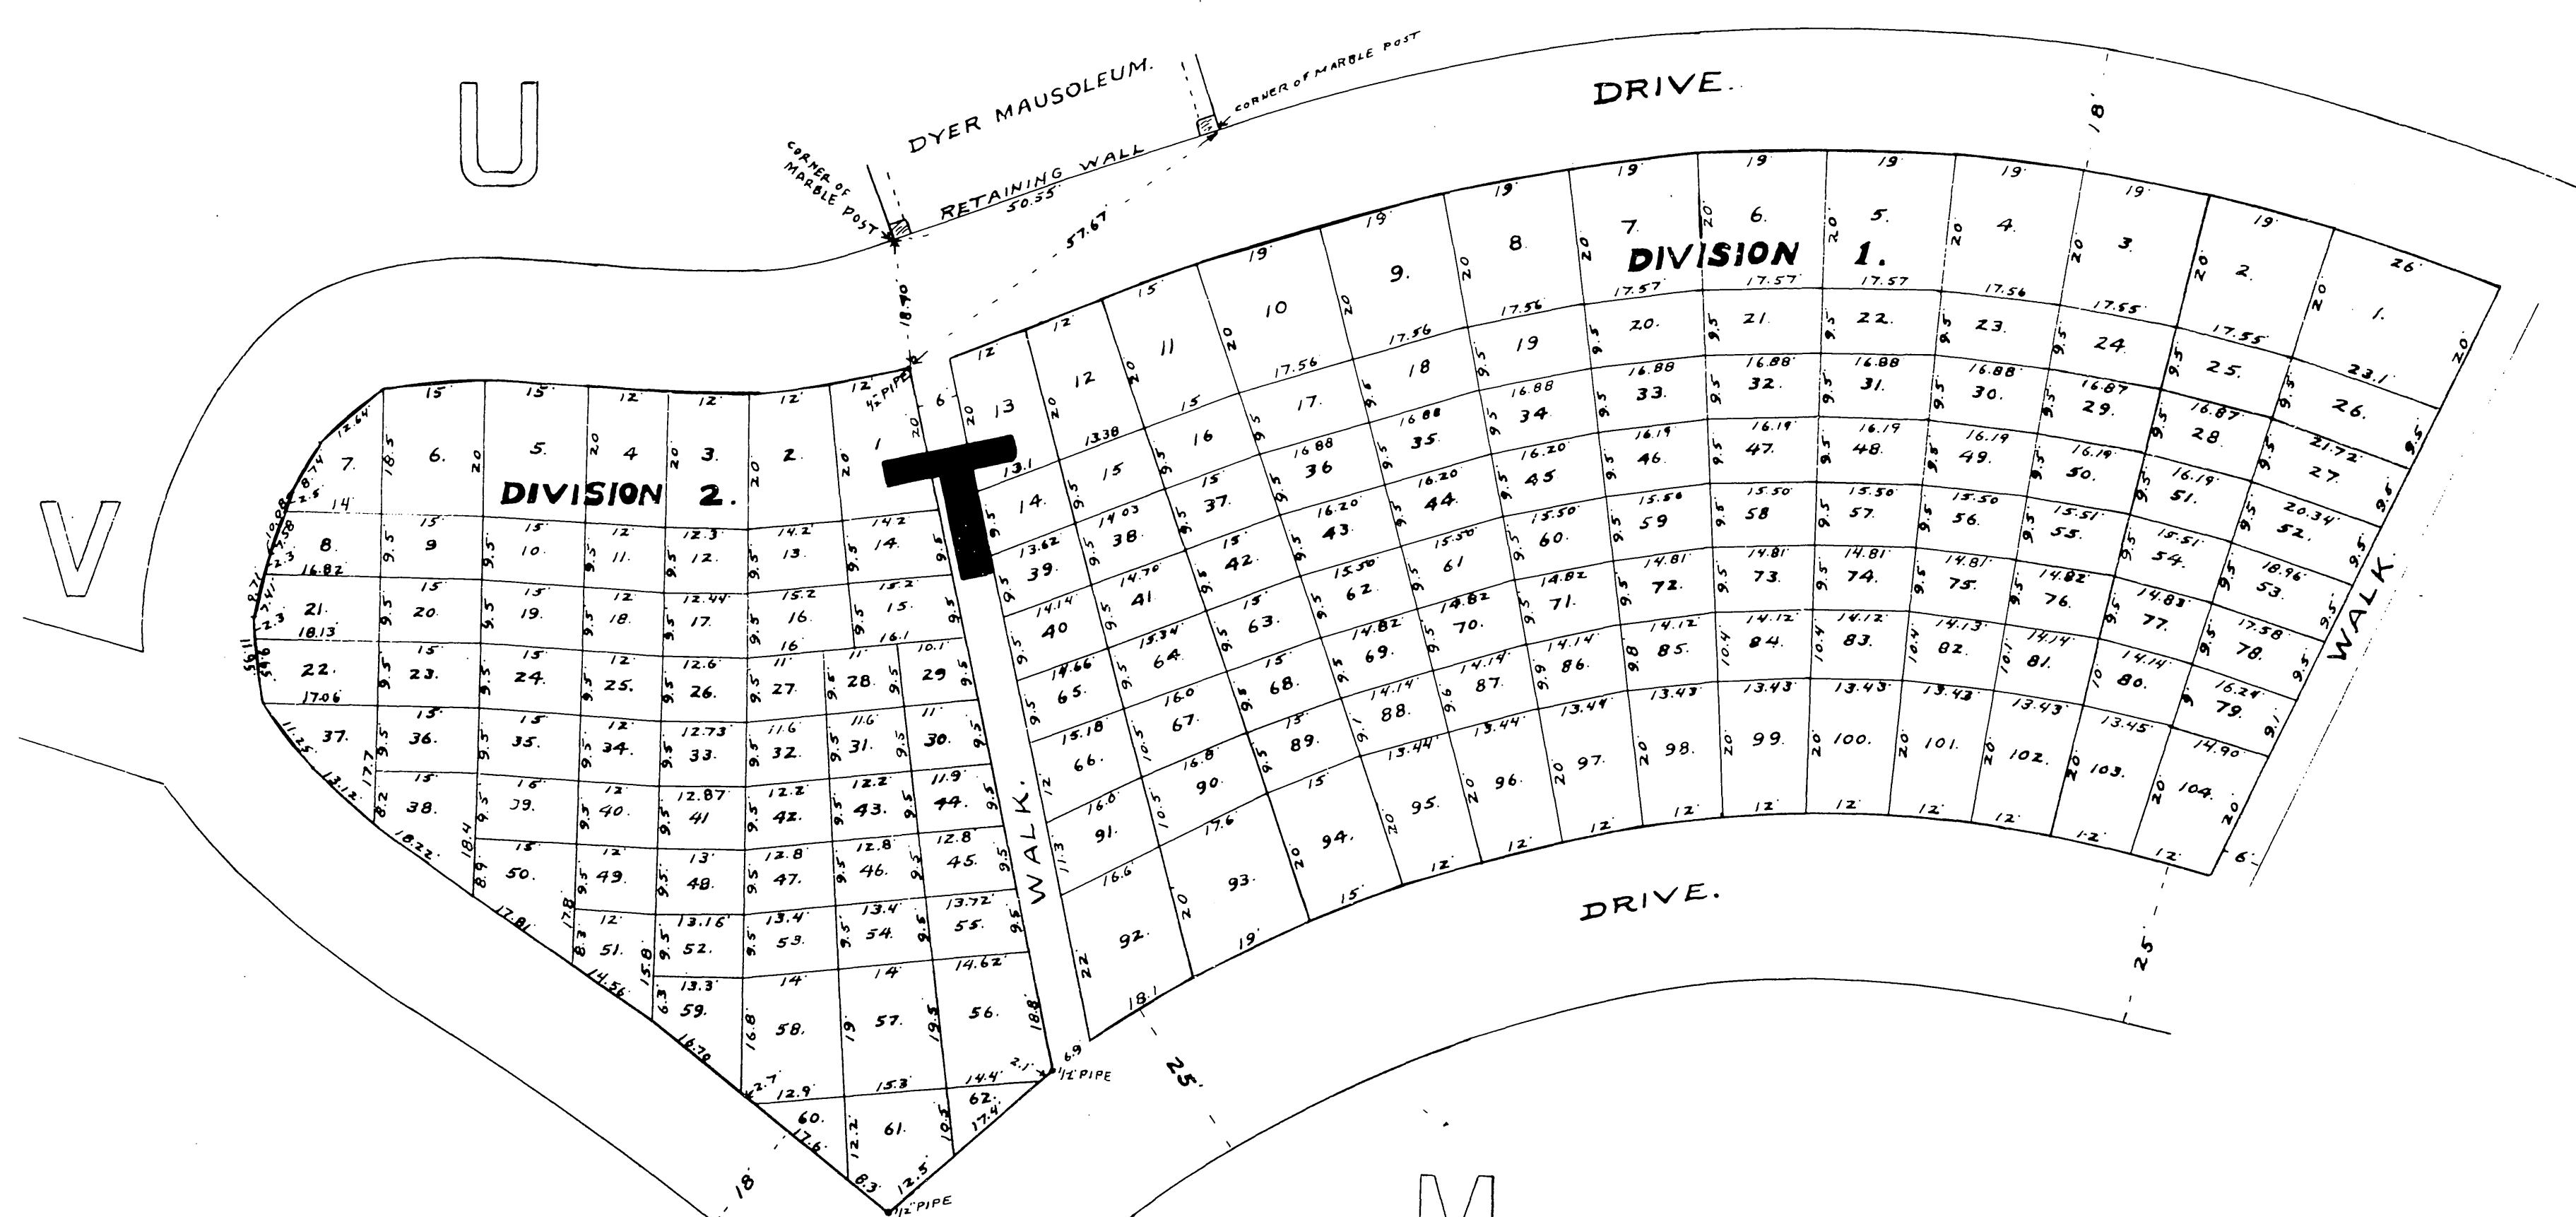


H.D. Bradley
Jack & Rose

PLAT "T"
RECORD SURVEY
 SUBDIVISION OF PLATS "T" AND PART "L"
OLIVEWOOD CEMETERY

SURVEYED BY H.D. BRADLEY - JUNE, 1926. - SCALE 1 INCH = 20 FEET.

I HEREBY CERTIFY THAT THIS MAP
 CORRECTLY REPRESENTS A SURVEY AS
 MADE BY ME IN JUNE, 1926.
H. D. Bradley
 LICENSED SURVEYOR

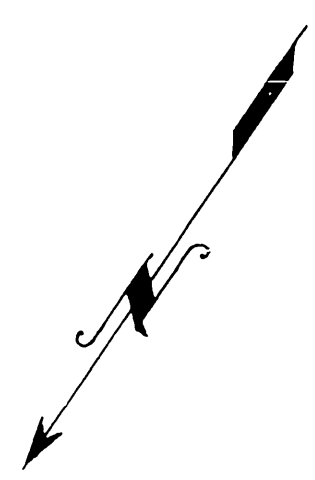

RS 7 83

RS 7/83