


BOOK	ONE	PAGE	20
DATE	DRWN BY	CHKD BY	APP. BY
	W. L.		



55.15	1
	2
15	3
	4
	5
	6

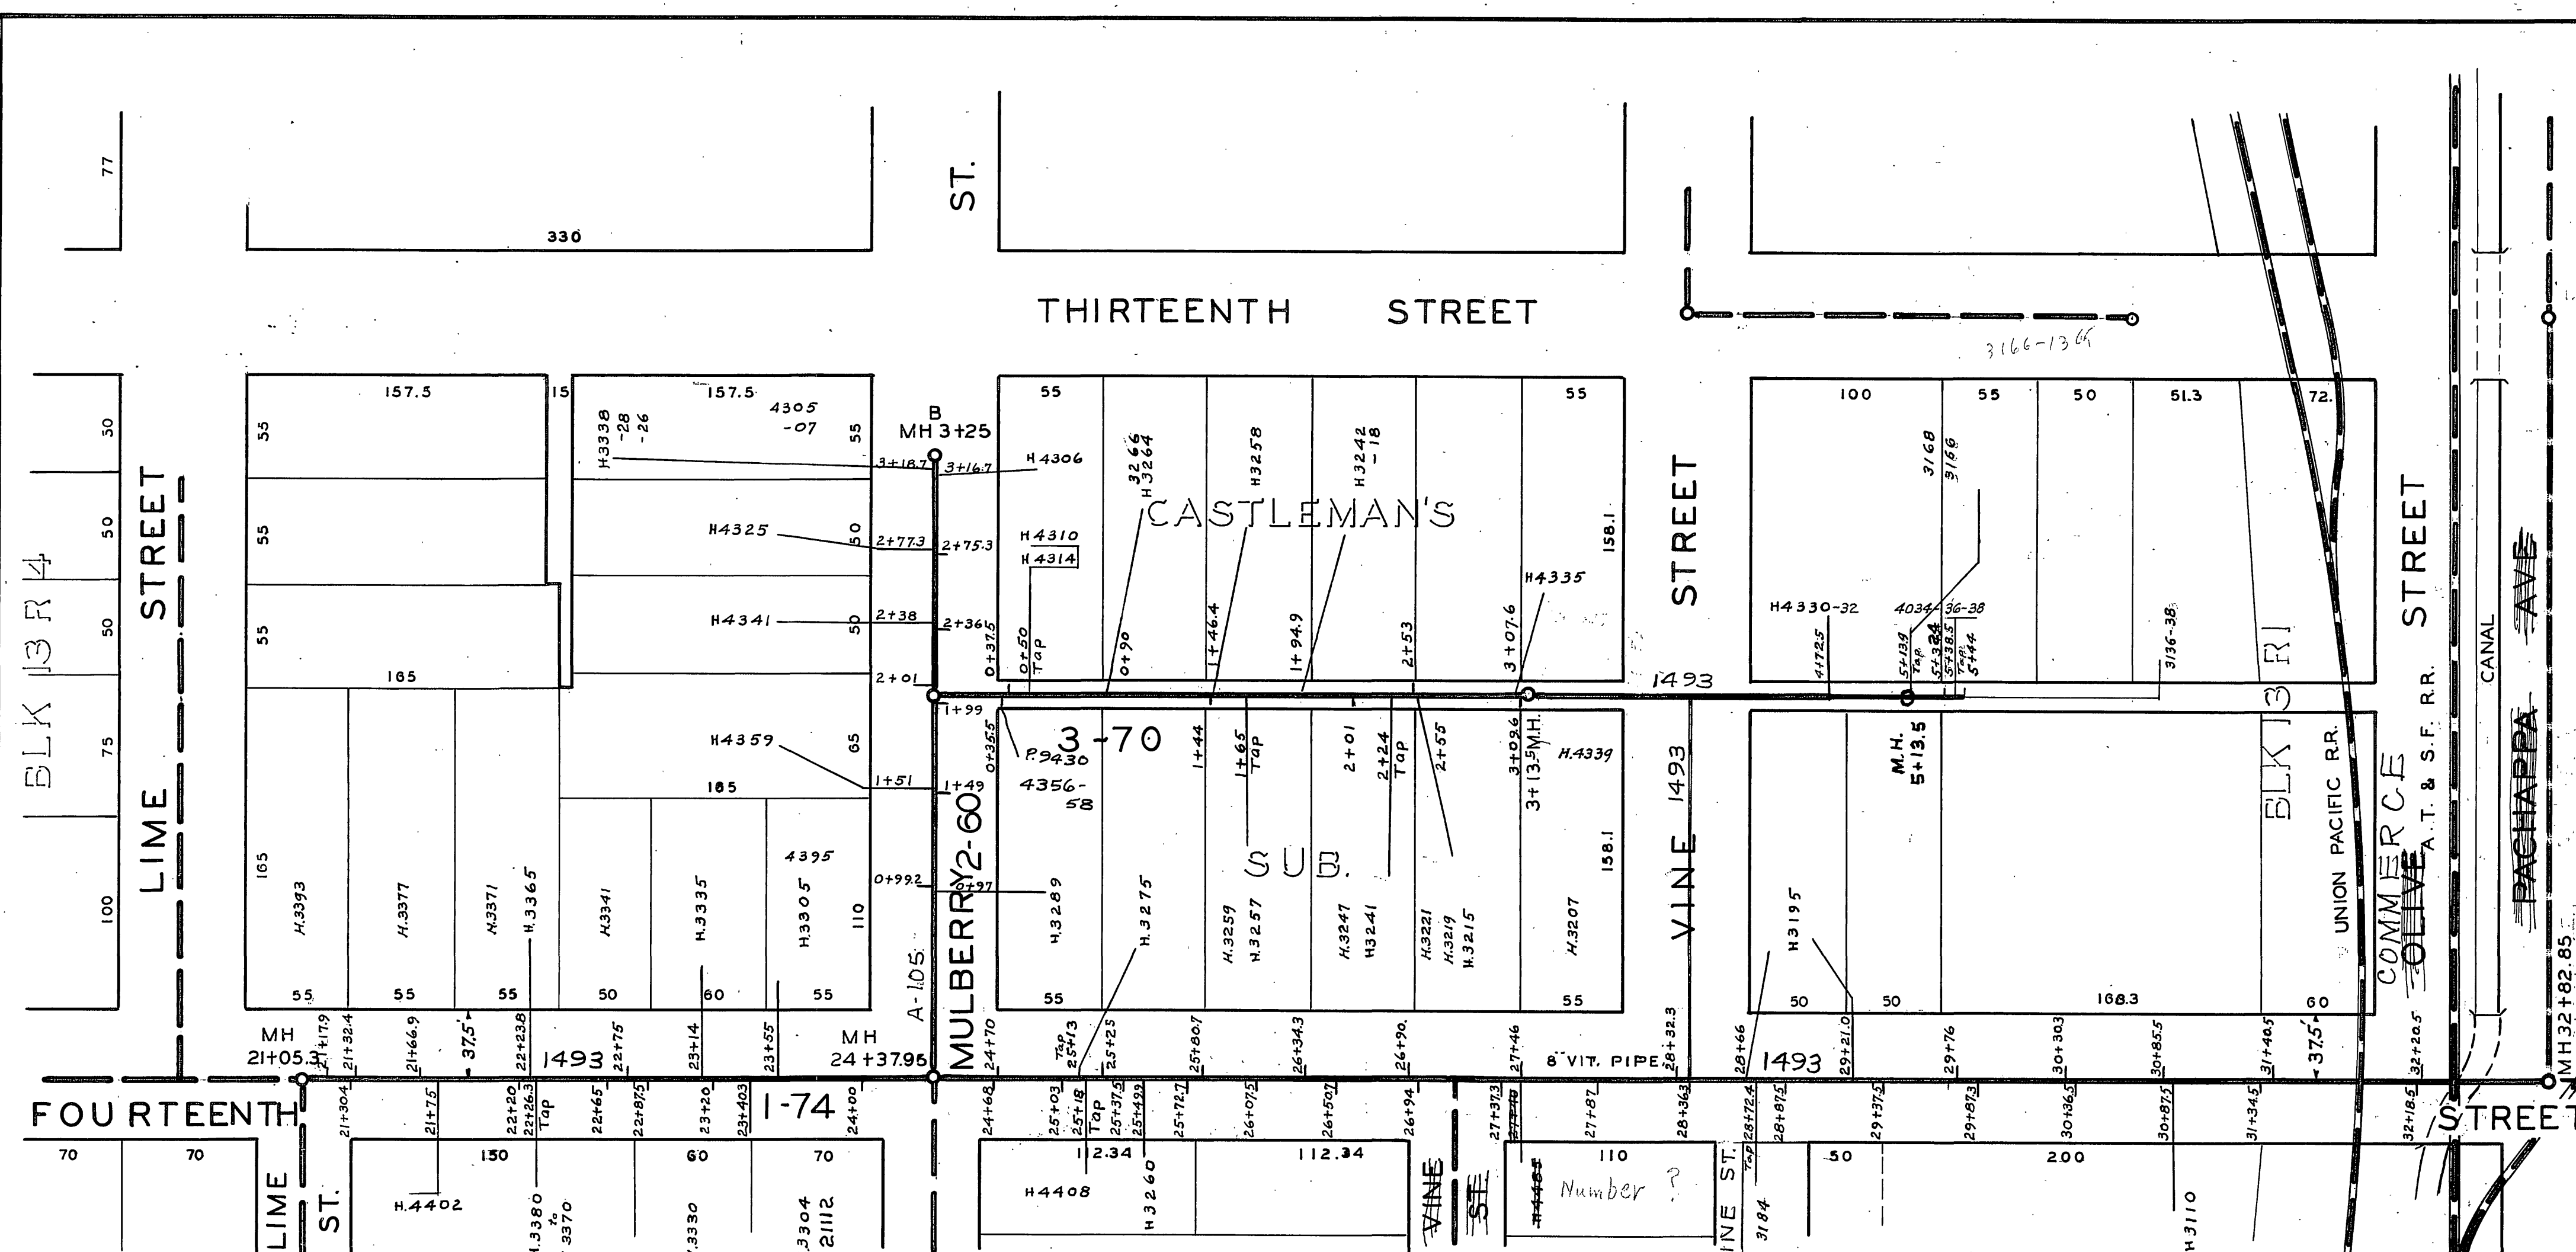