


BOOK	ONE	PAGE	22

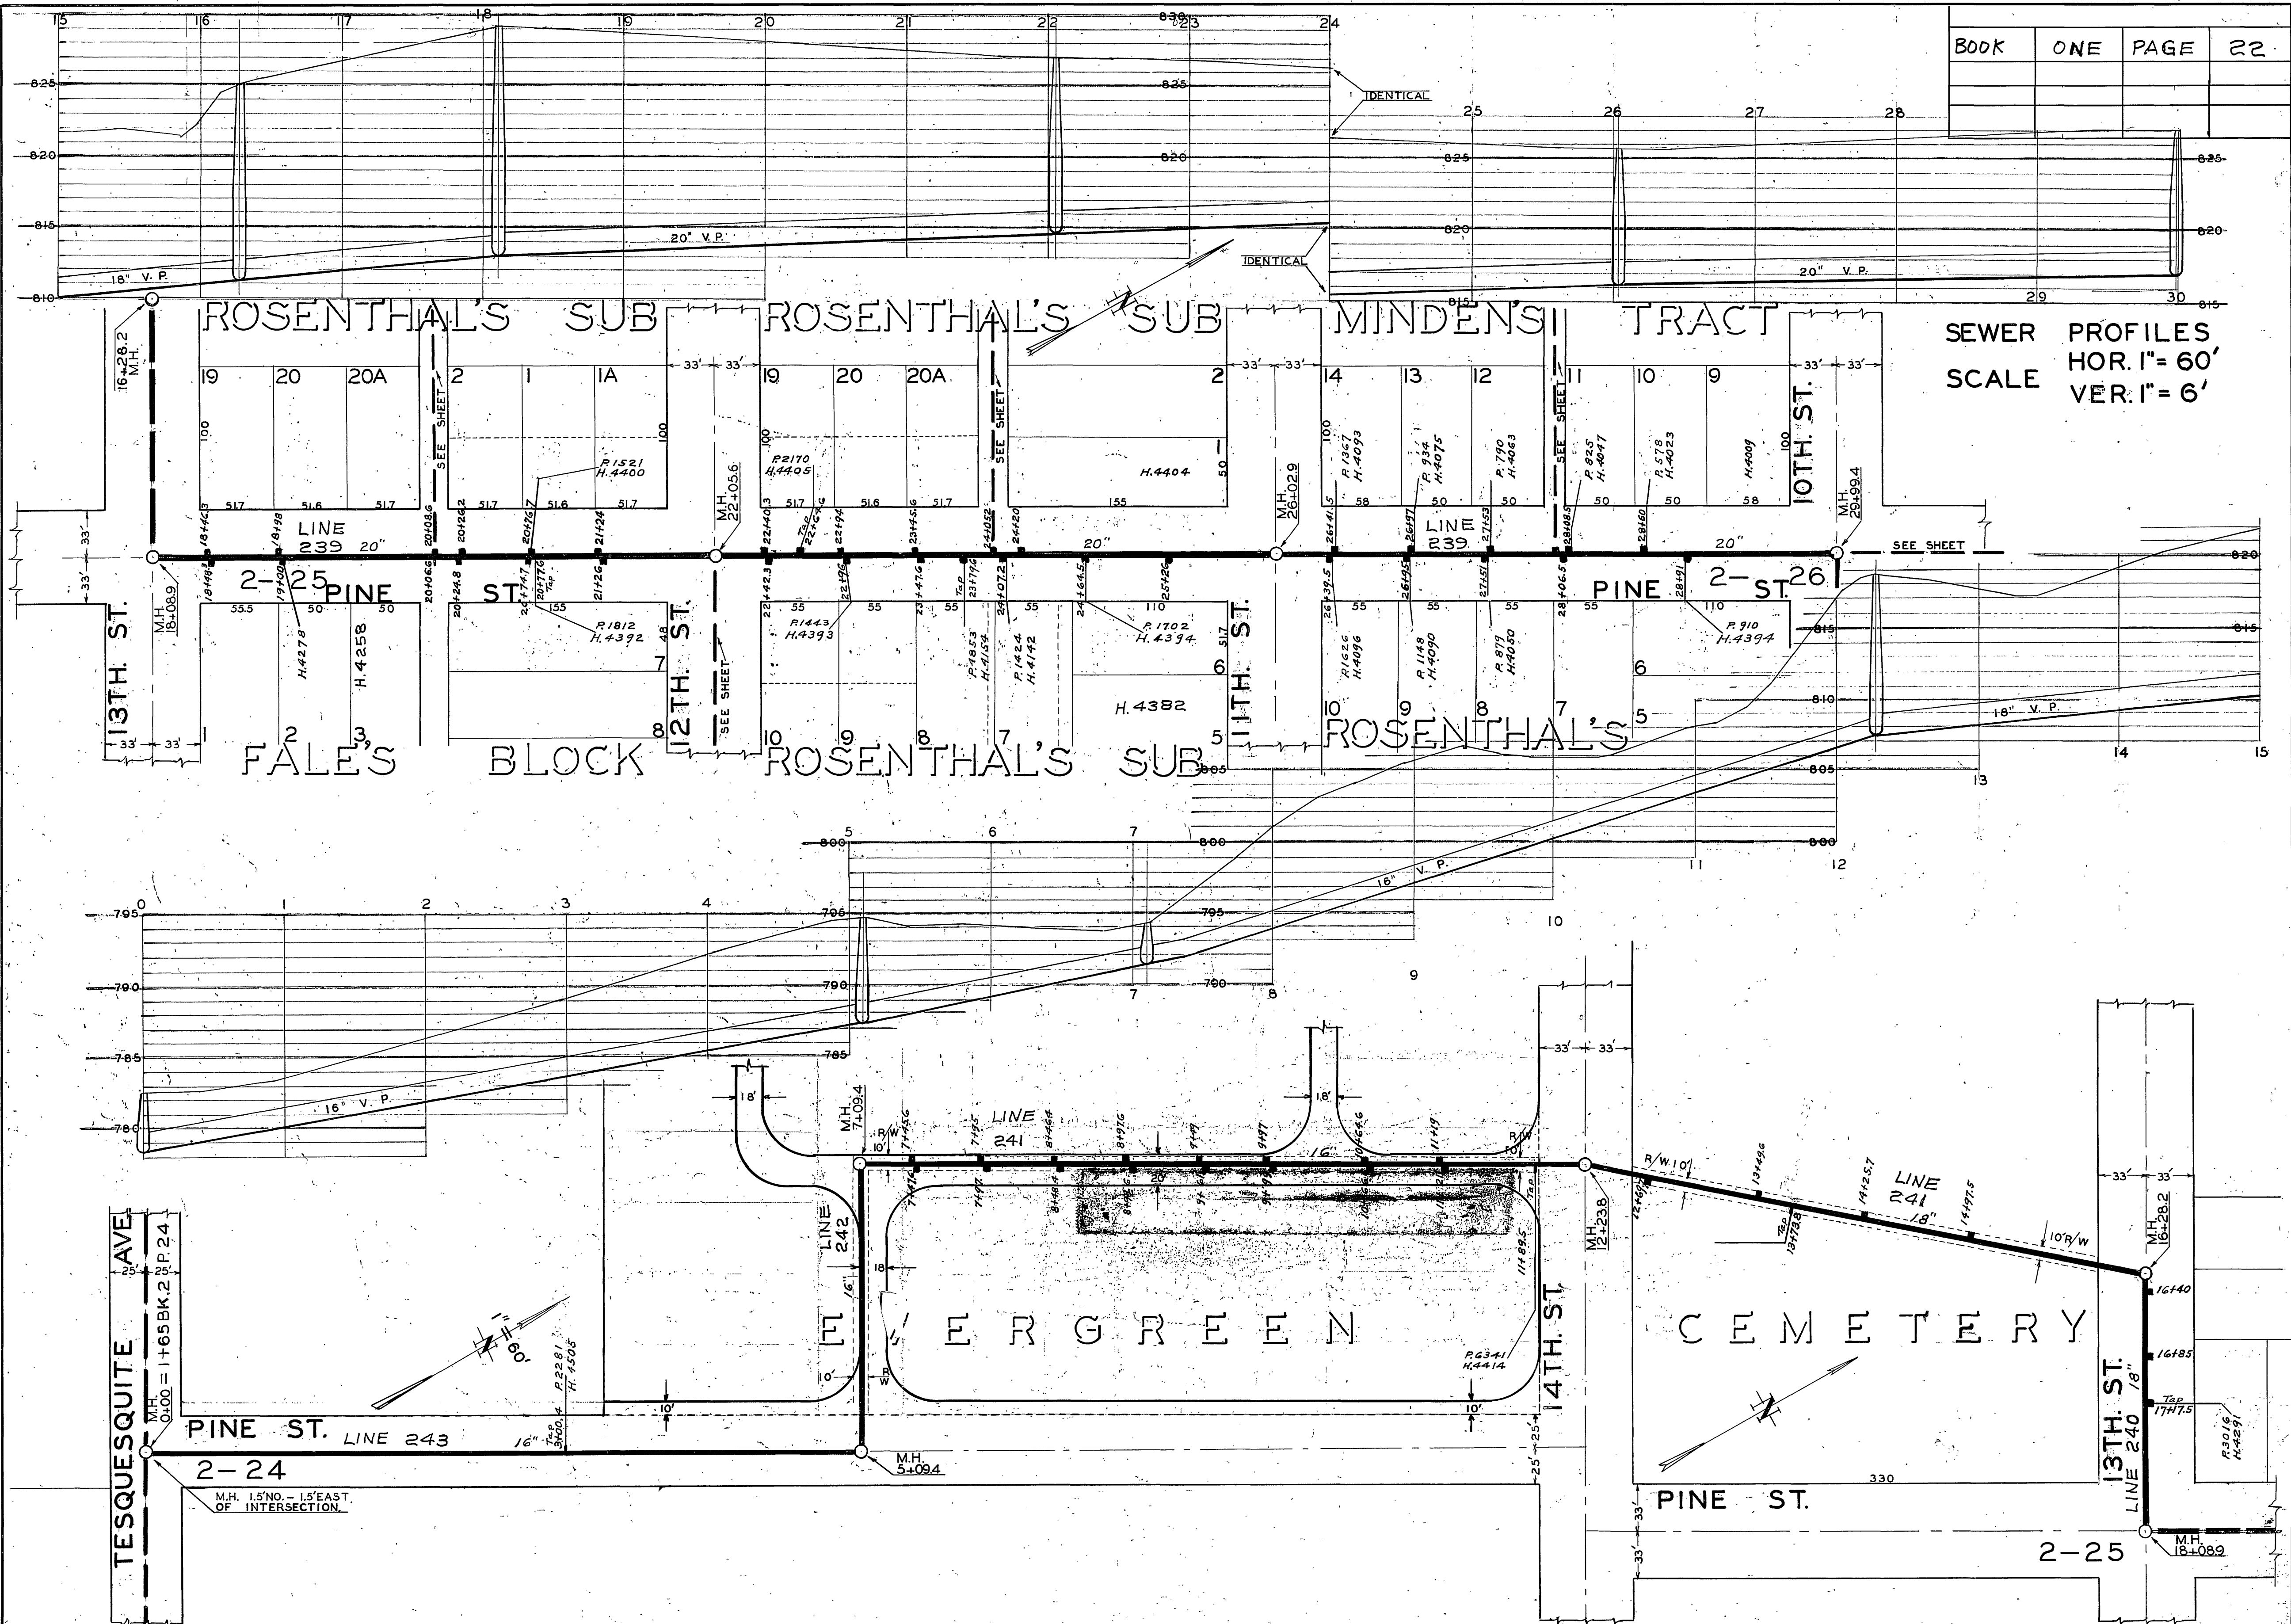

SEWER PROFILES
SCALE HOR. 1" = 60'
VER. 1" = 6'

TESQUESQUITE AVE
M.H. 0.00 = 1+65 BK. 2 P. 24

M.H. 1.5' NO. - 15' EAST OF INTERSECTION