


BOOK	ONE	SHEET	25
------	-----	-------	----

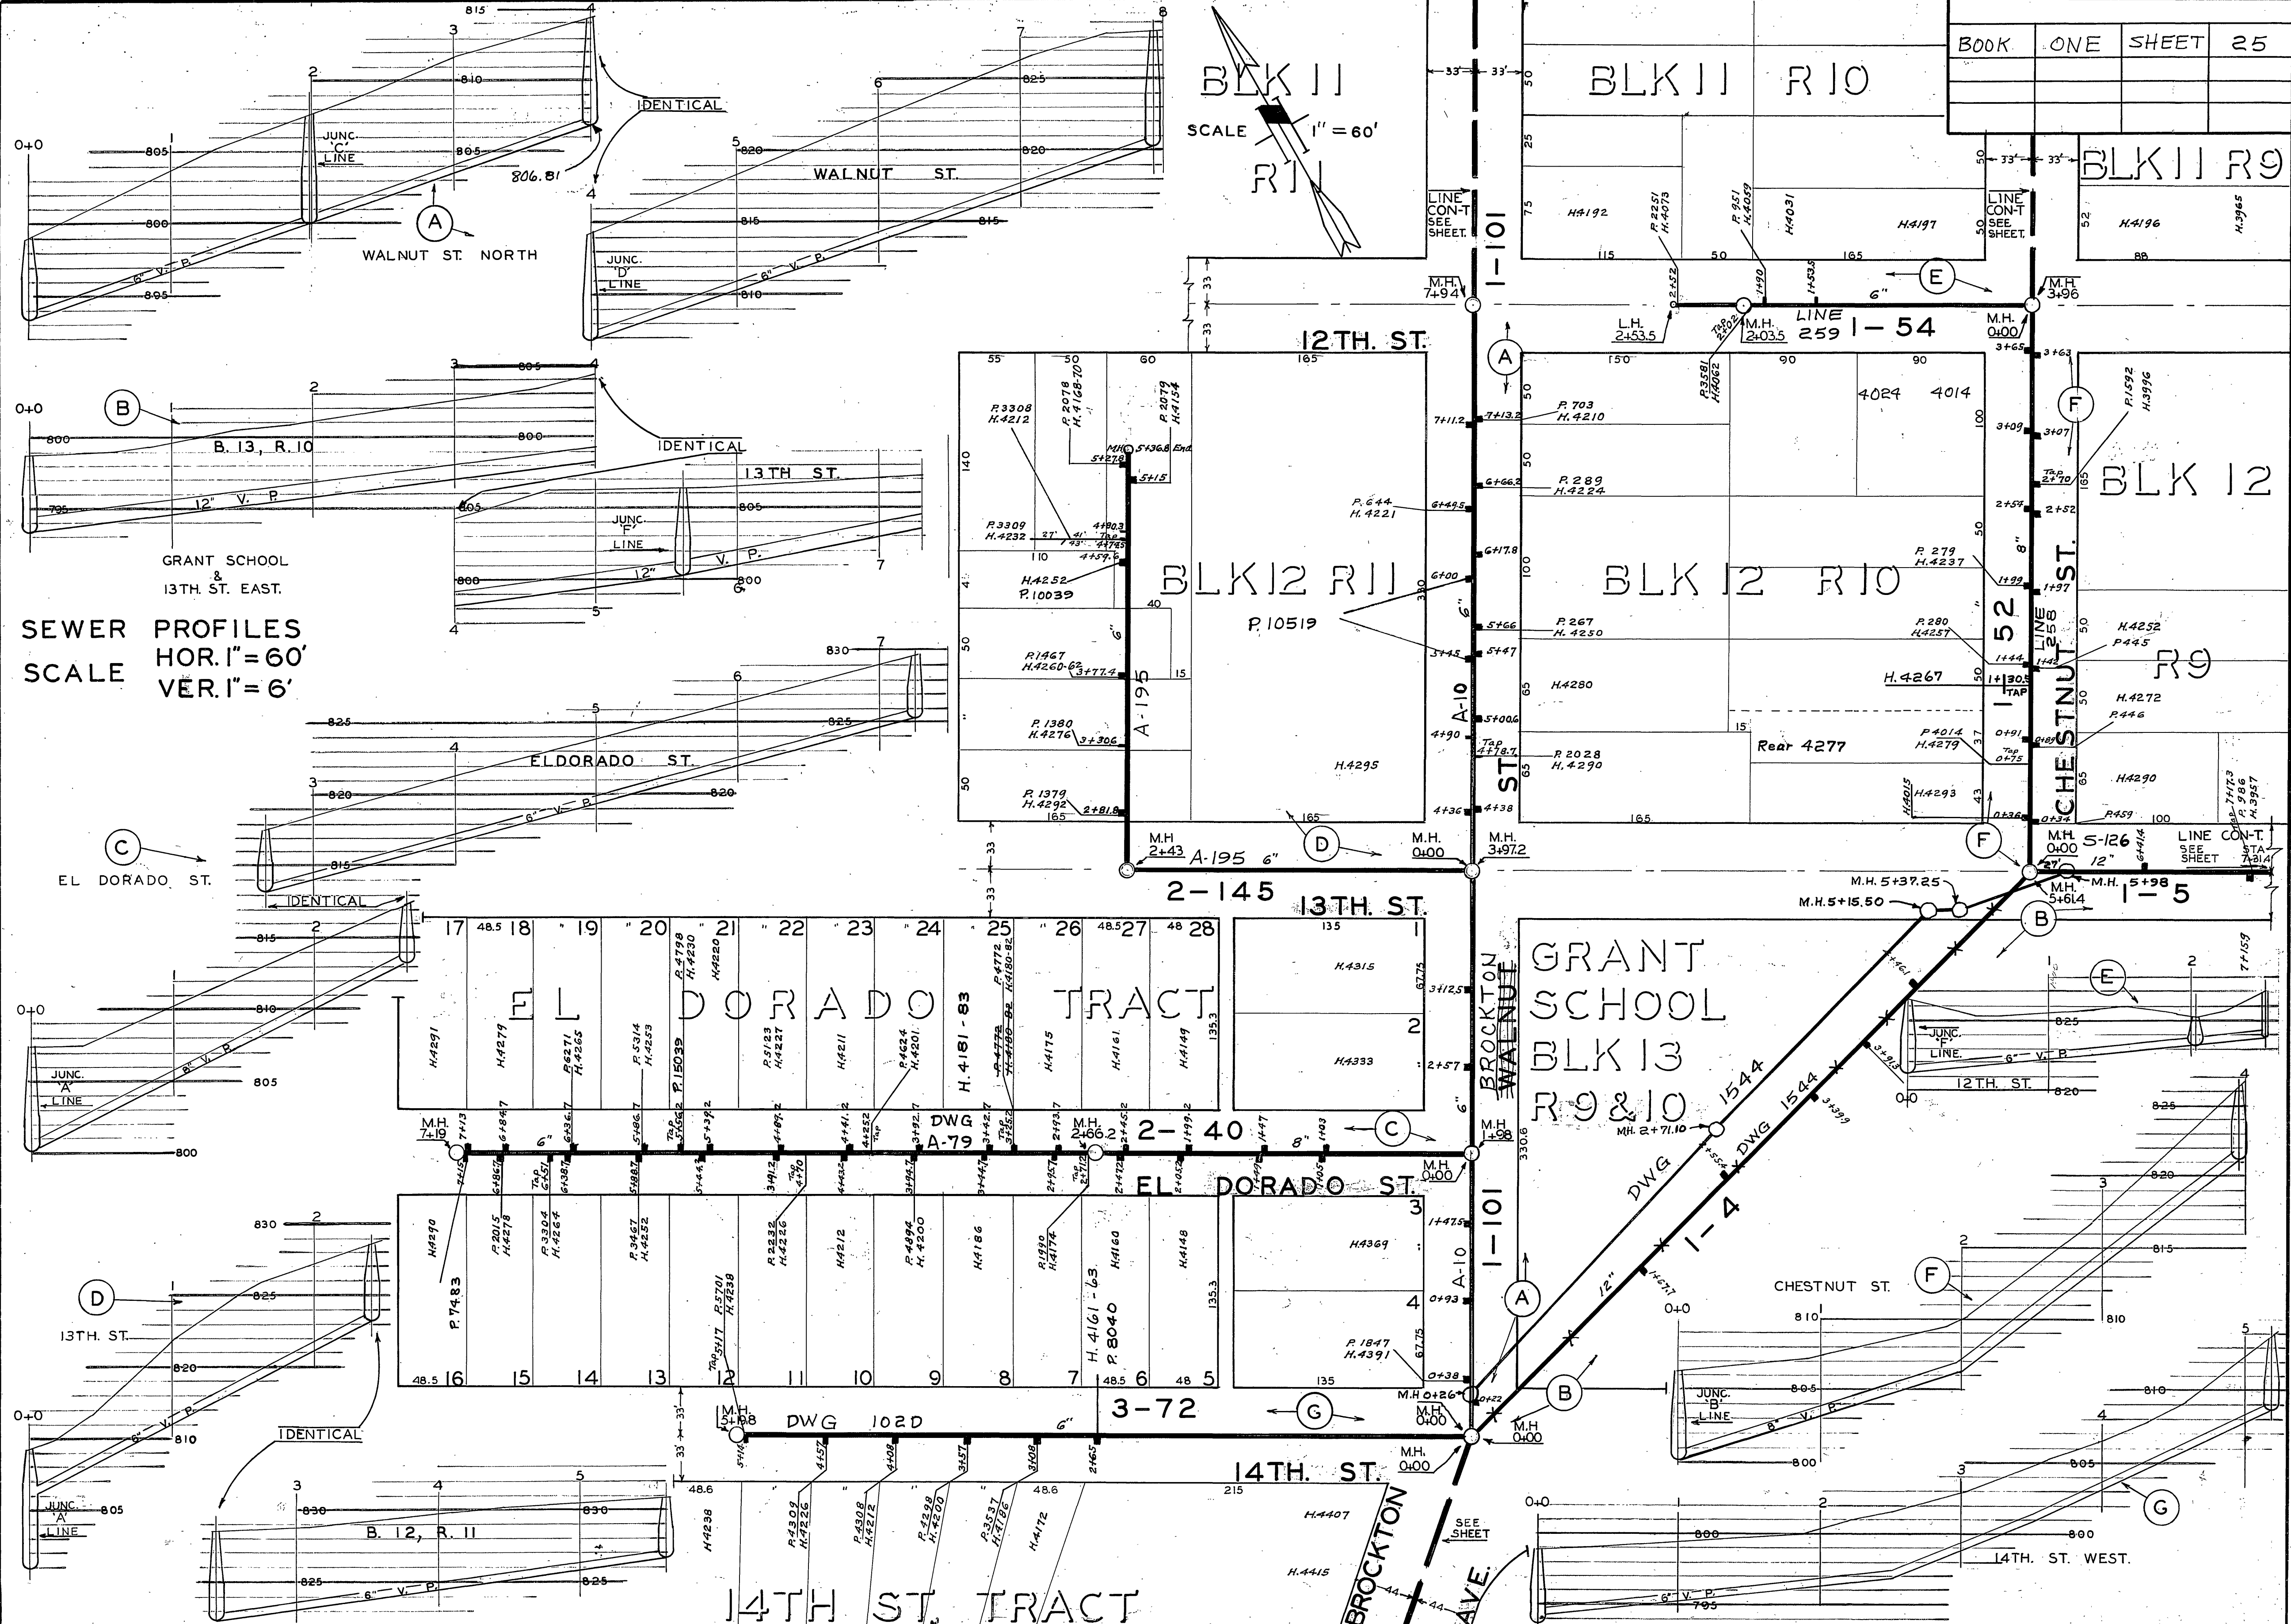

SEWER PROFILES  
 SCALE HOR. 1" = 60'  
 VER. 1" = 6'