


SEWER PROFILES
SCALE HOR. 1"=60'
VER. 1"=6'

BOOK	ONE	PAGE	26

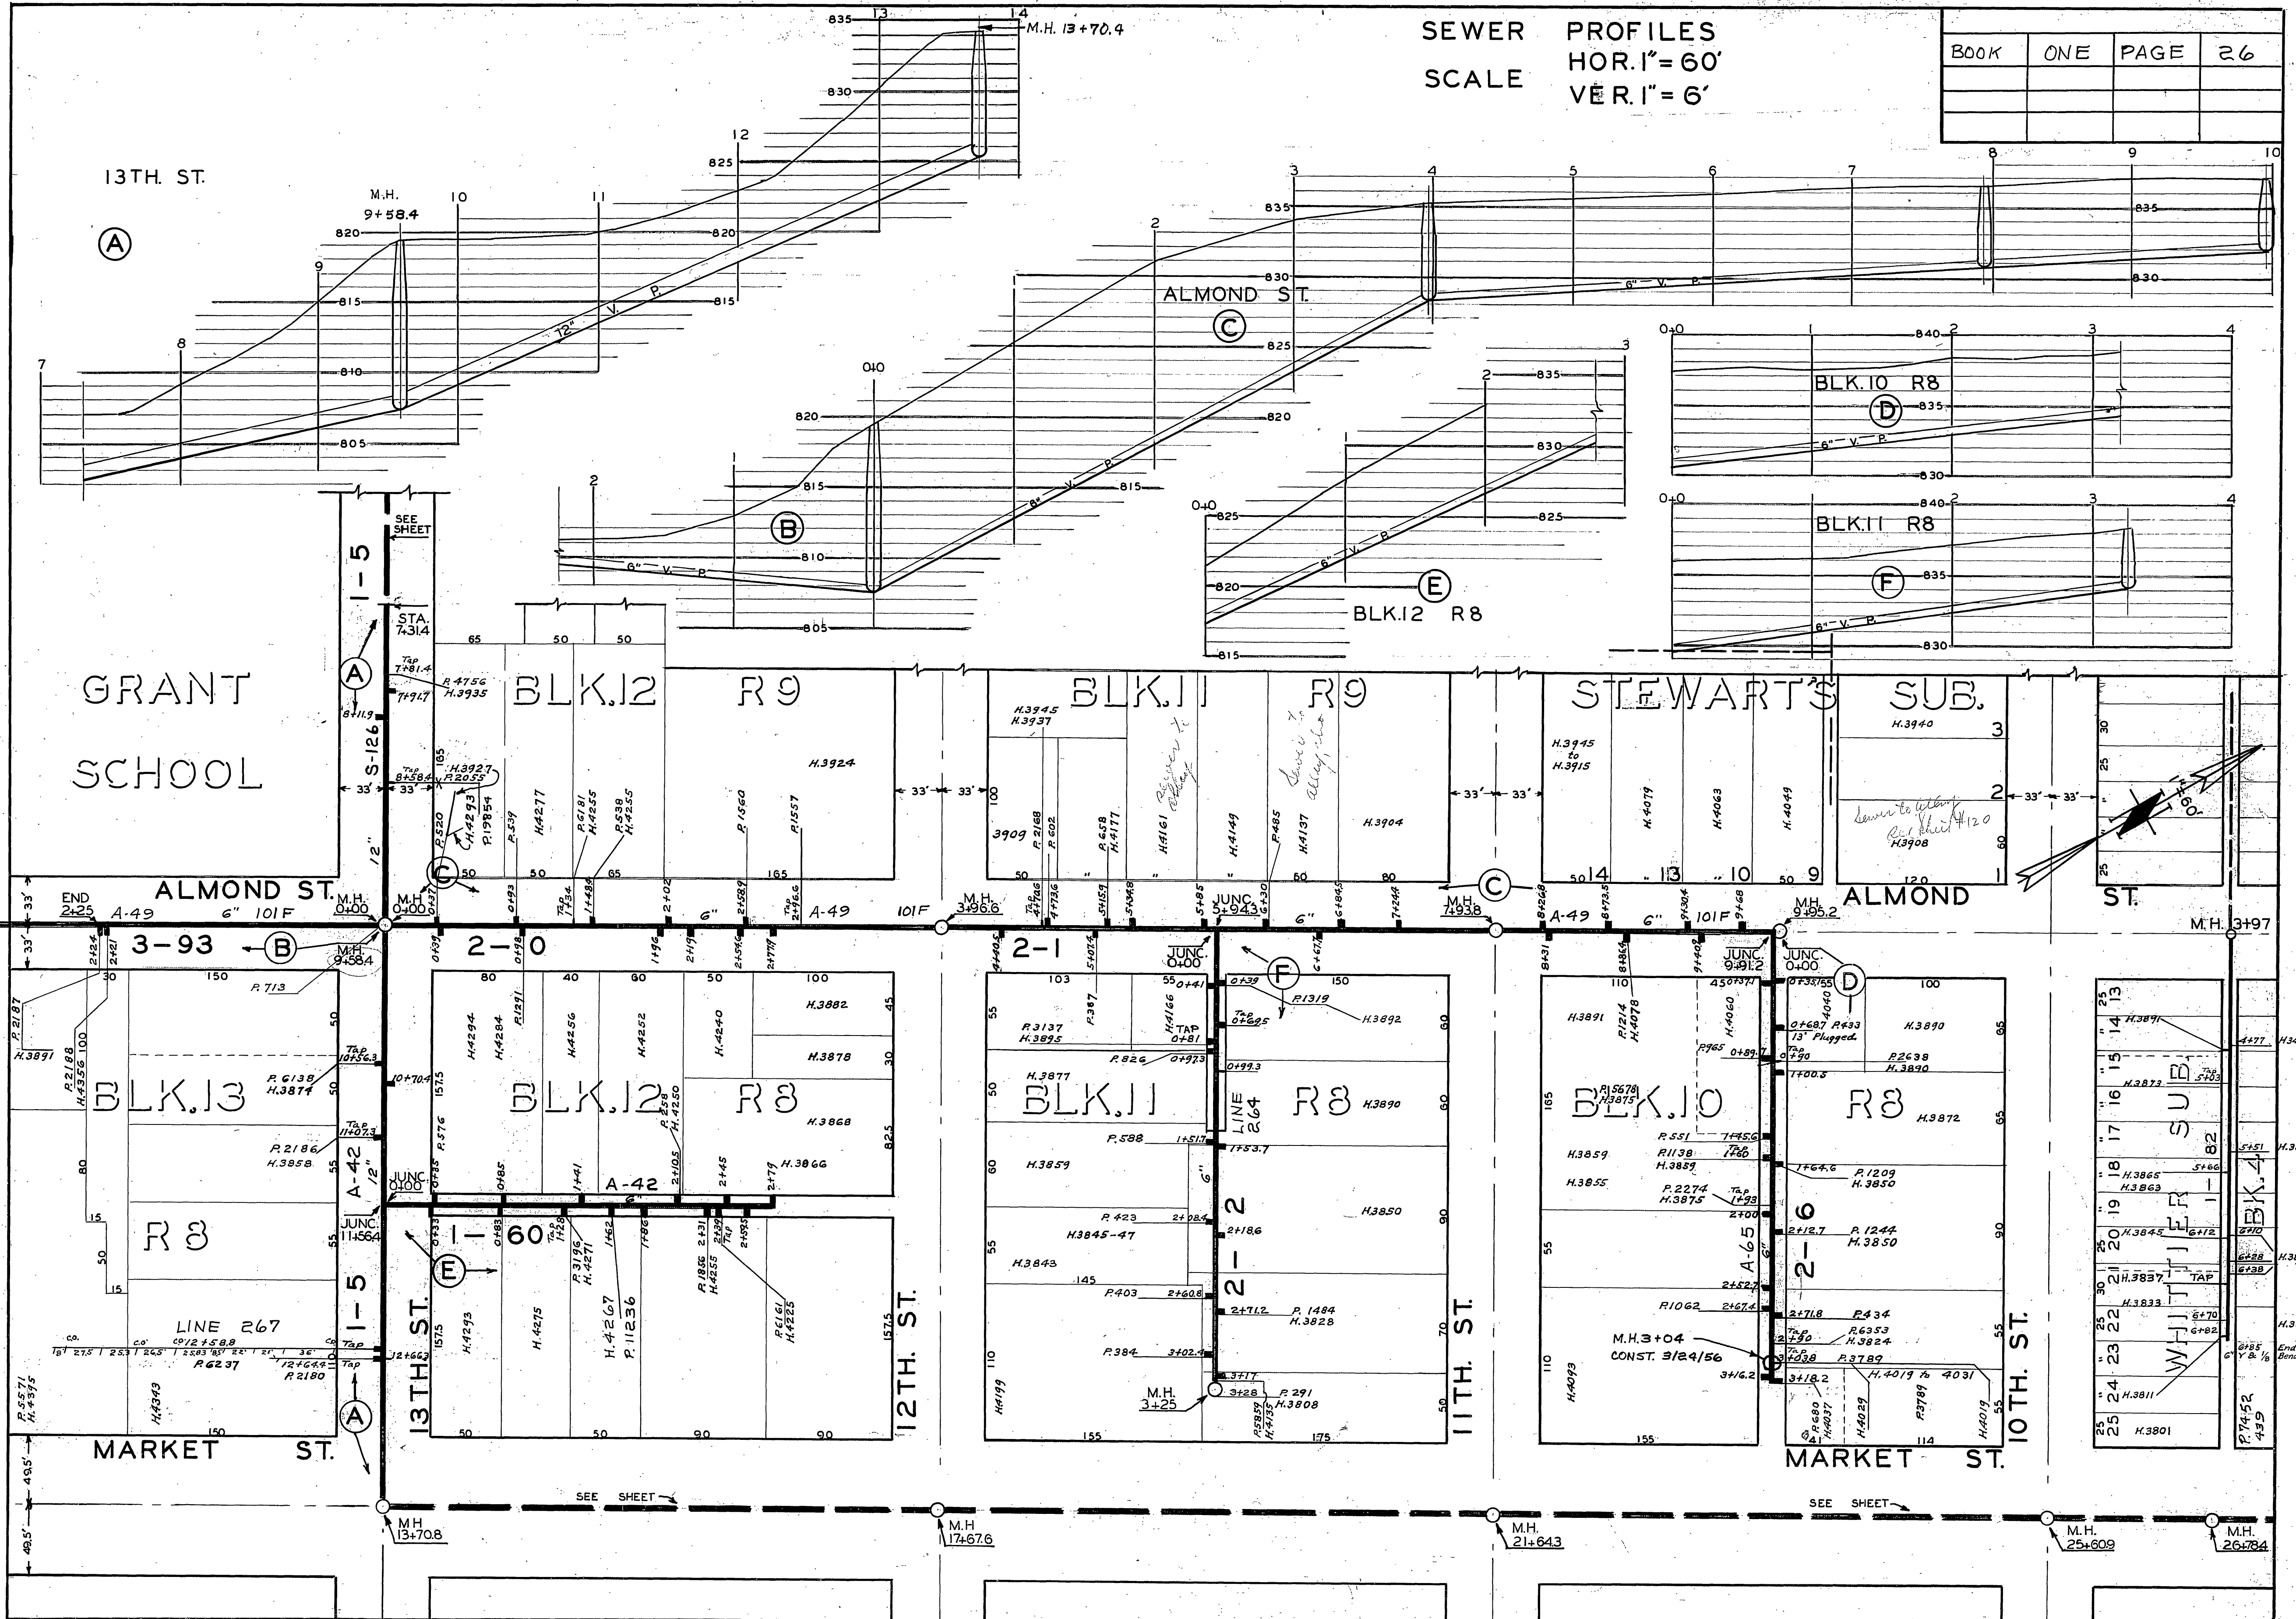

Hosp. Conn. P. 16578
 4+45 Tap E. Community Hospital
 Manhole at end (Side of 14th St) 4+35