
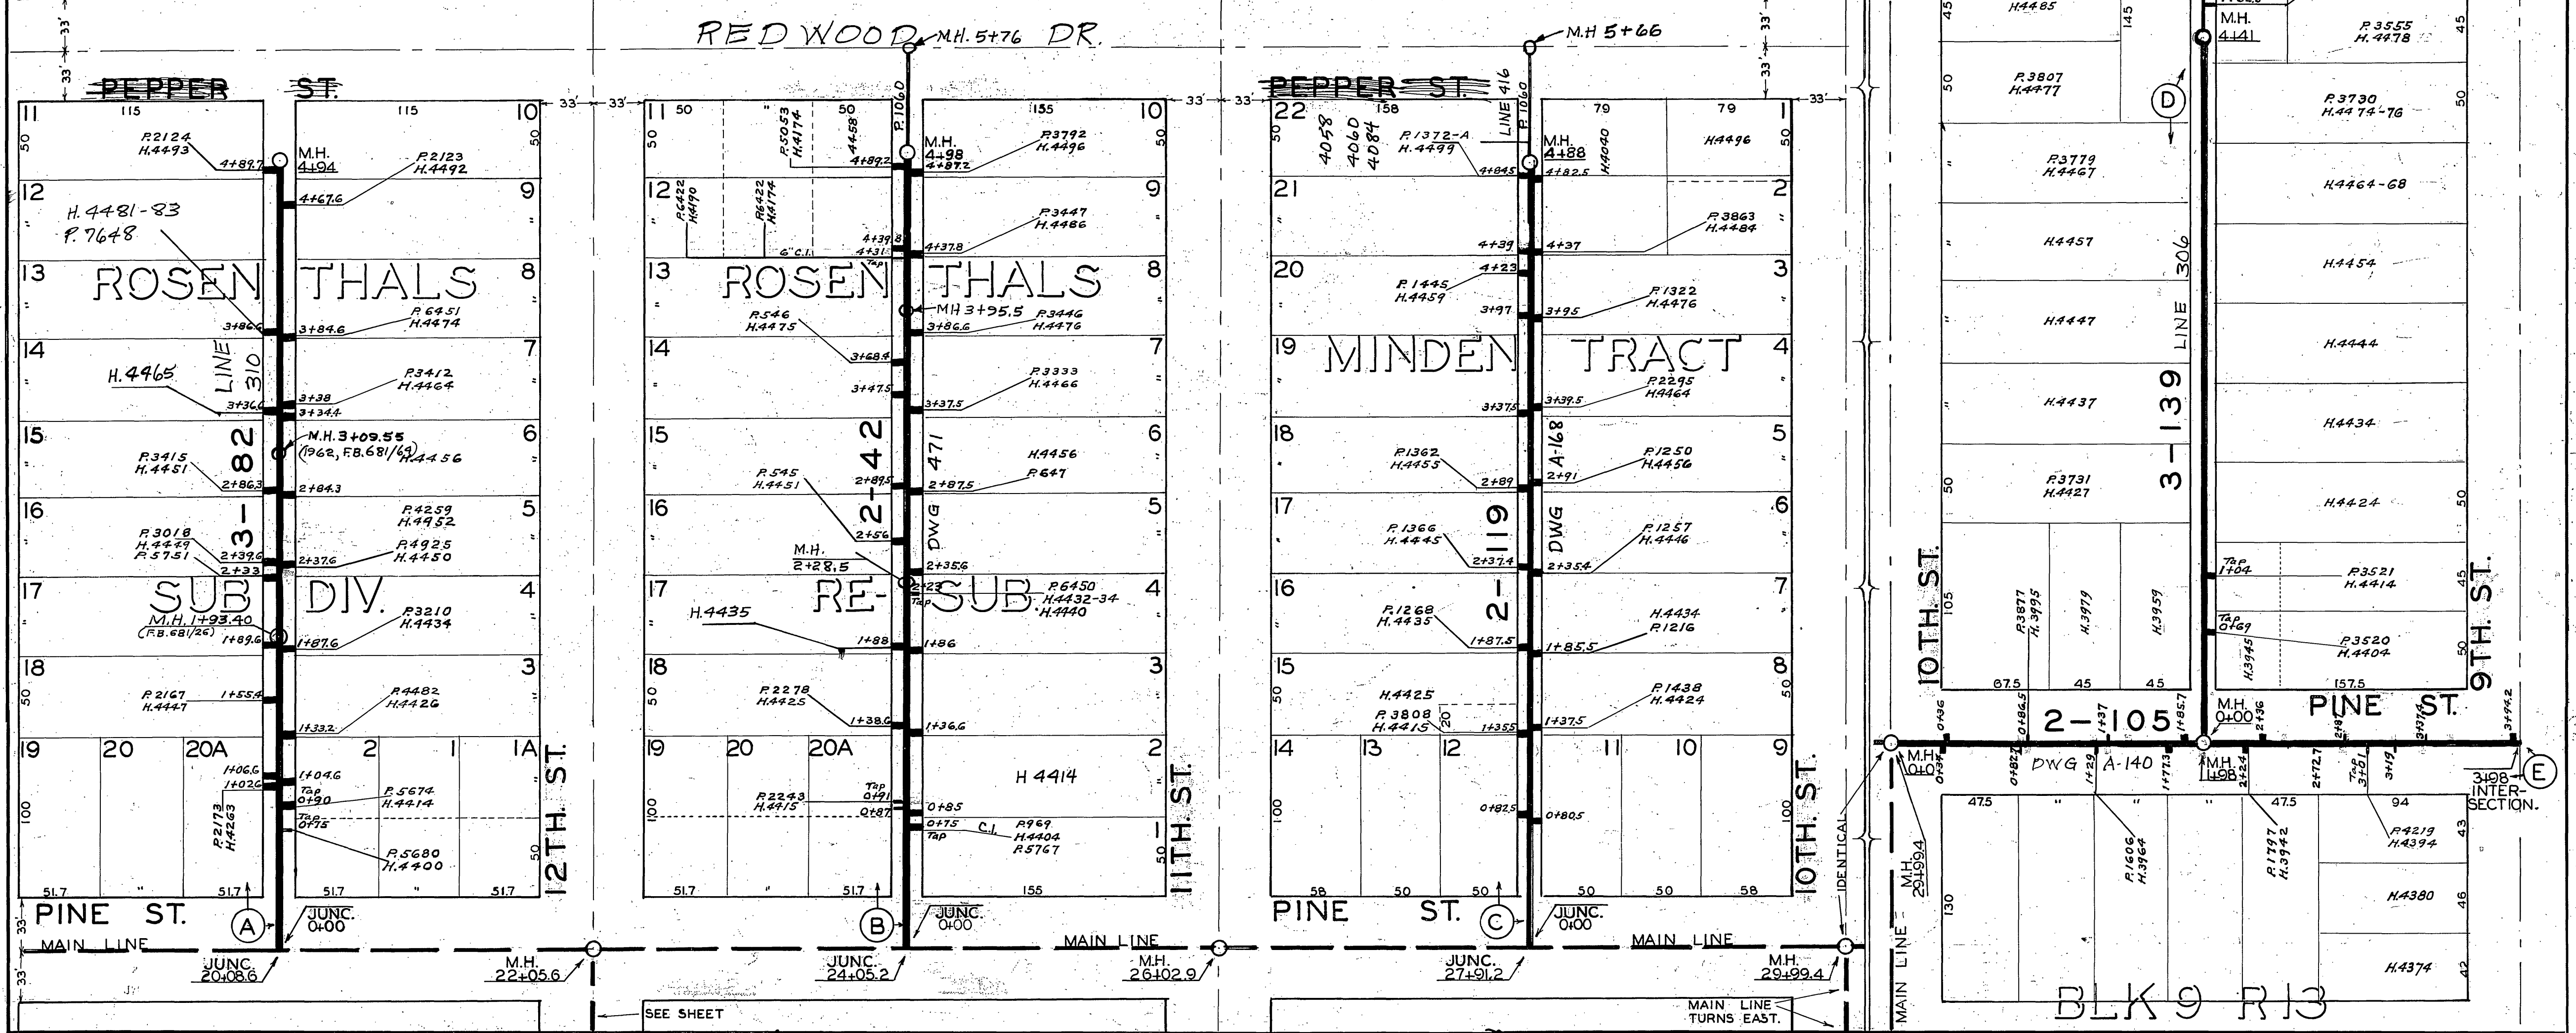
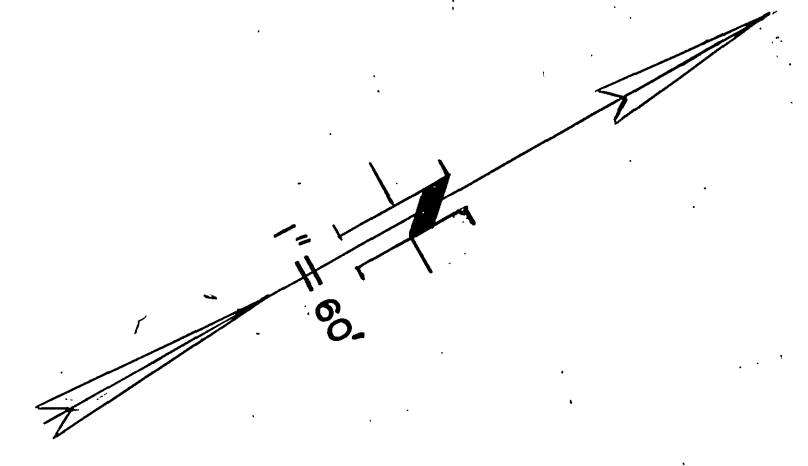


BOOK	ONE	PAGE	35

SEWER PROFILES  
SCALE HOR. 1" = 60'  
VER. 1" = 6'

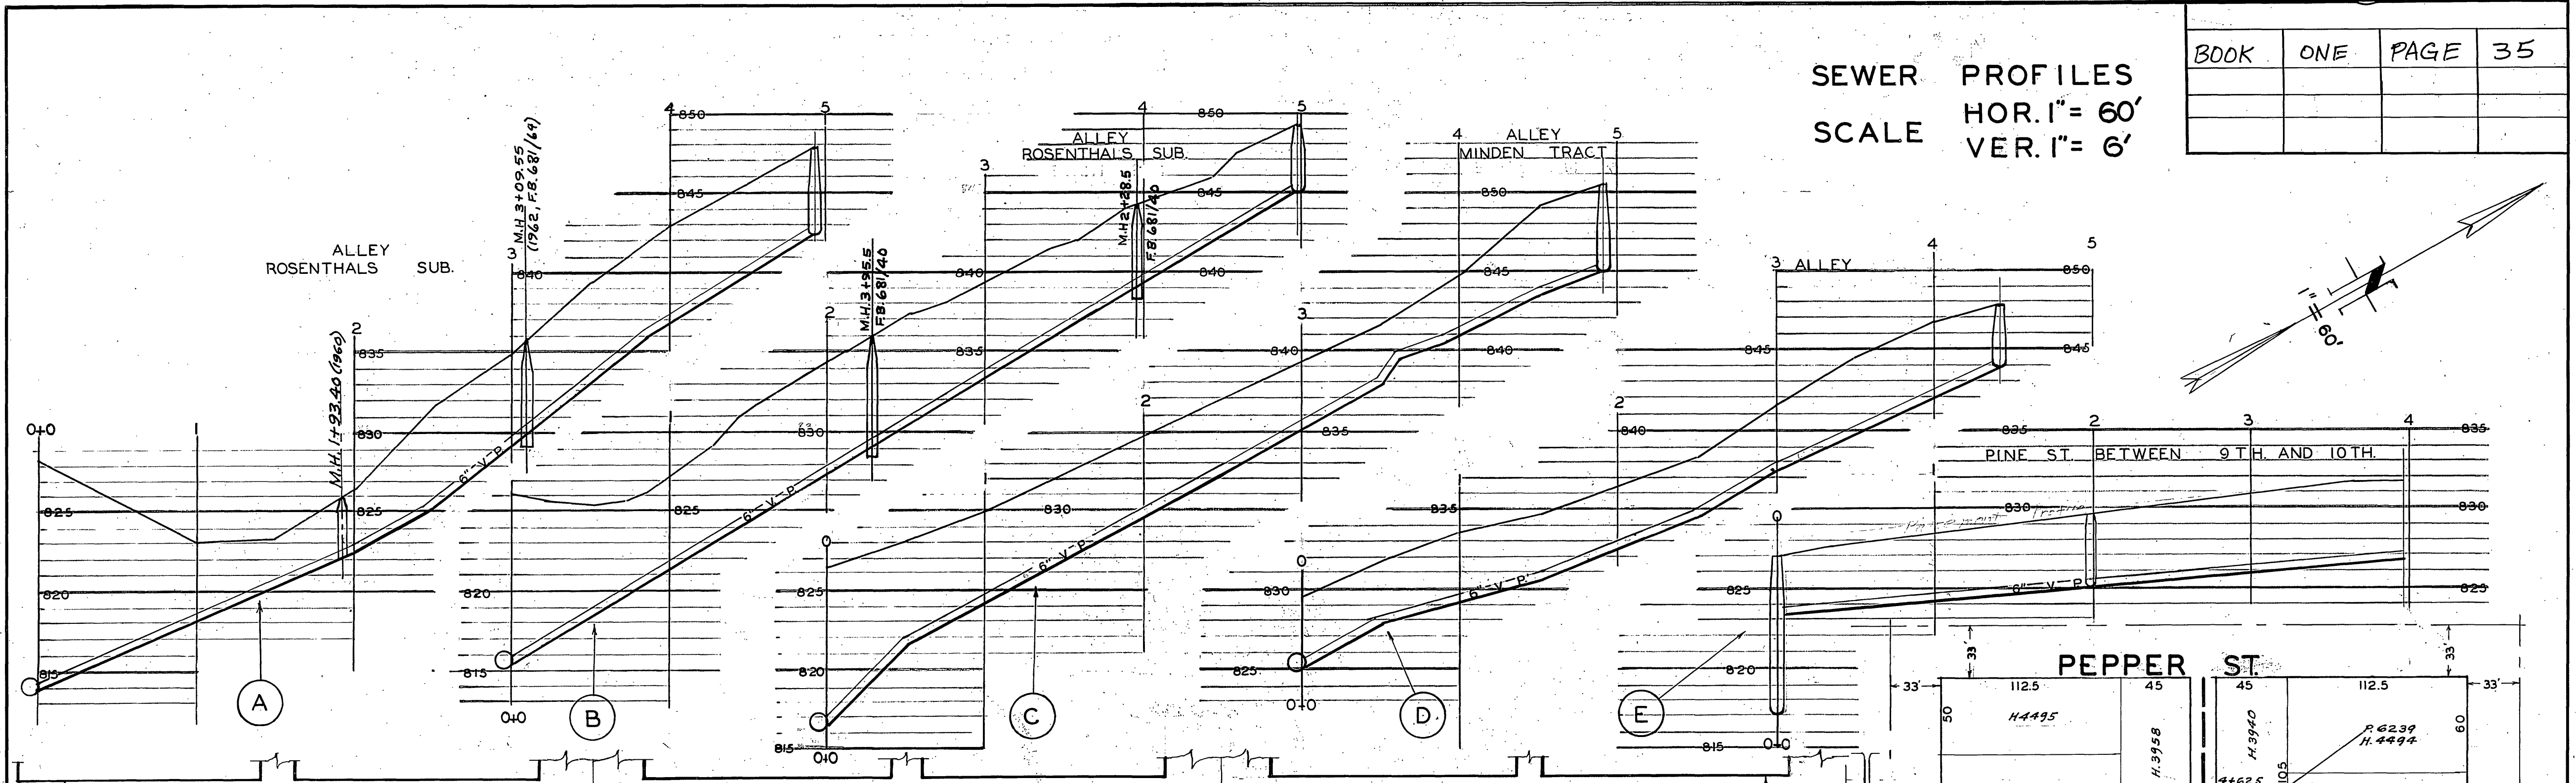

SEE SHEET

MAIN LINE TURNS EAST.

BLK 9 R13