

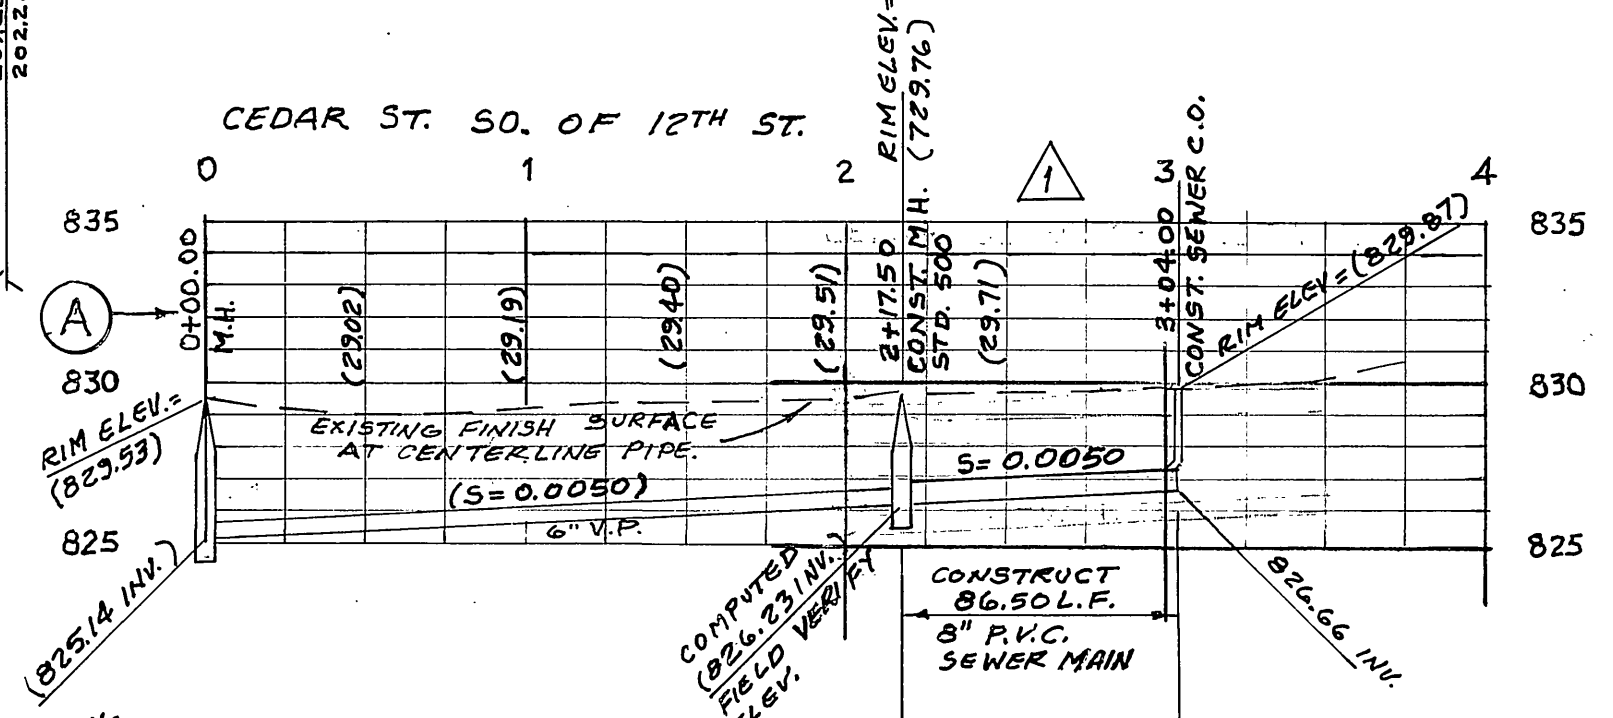
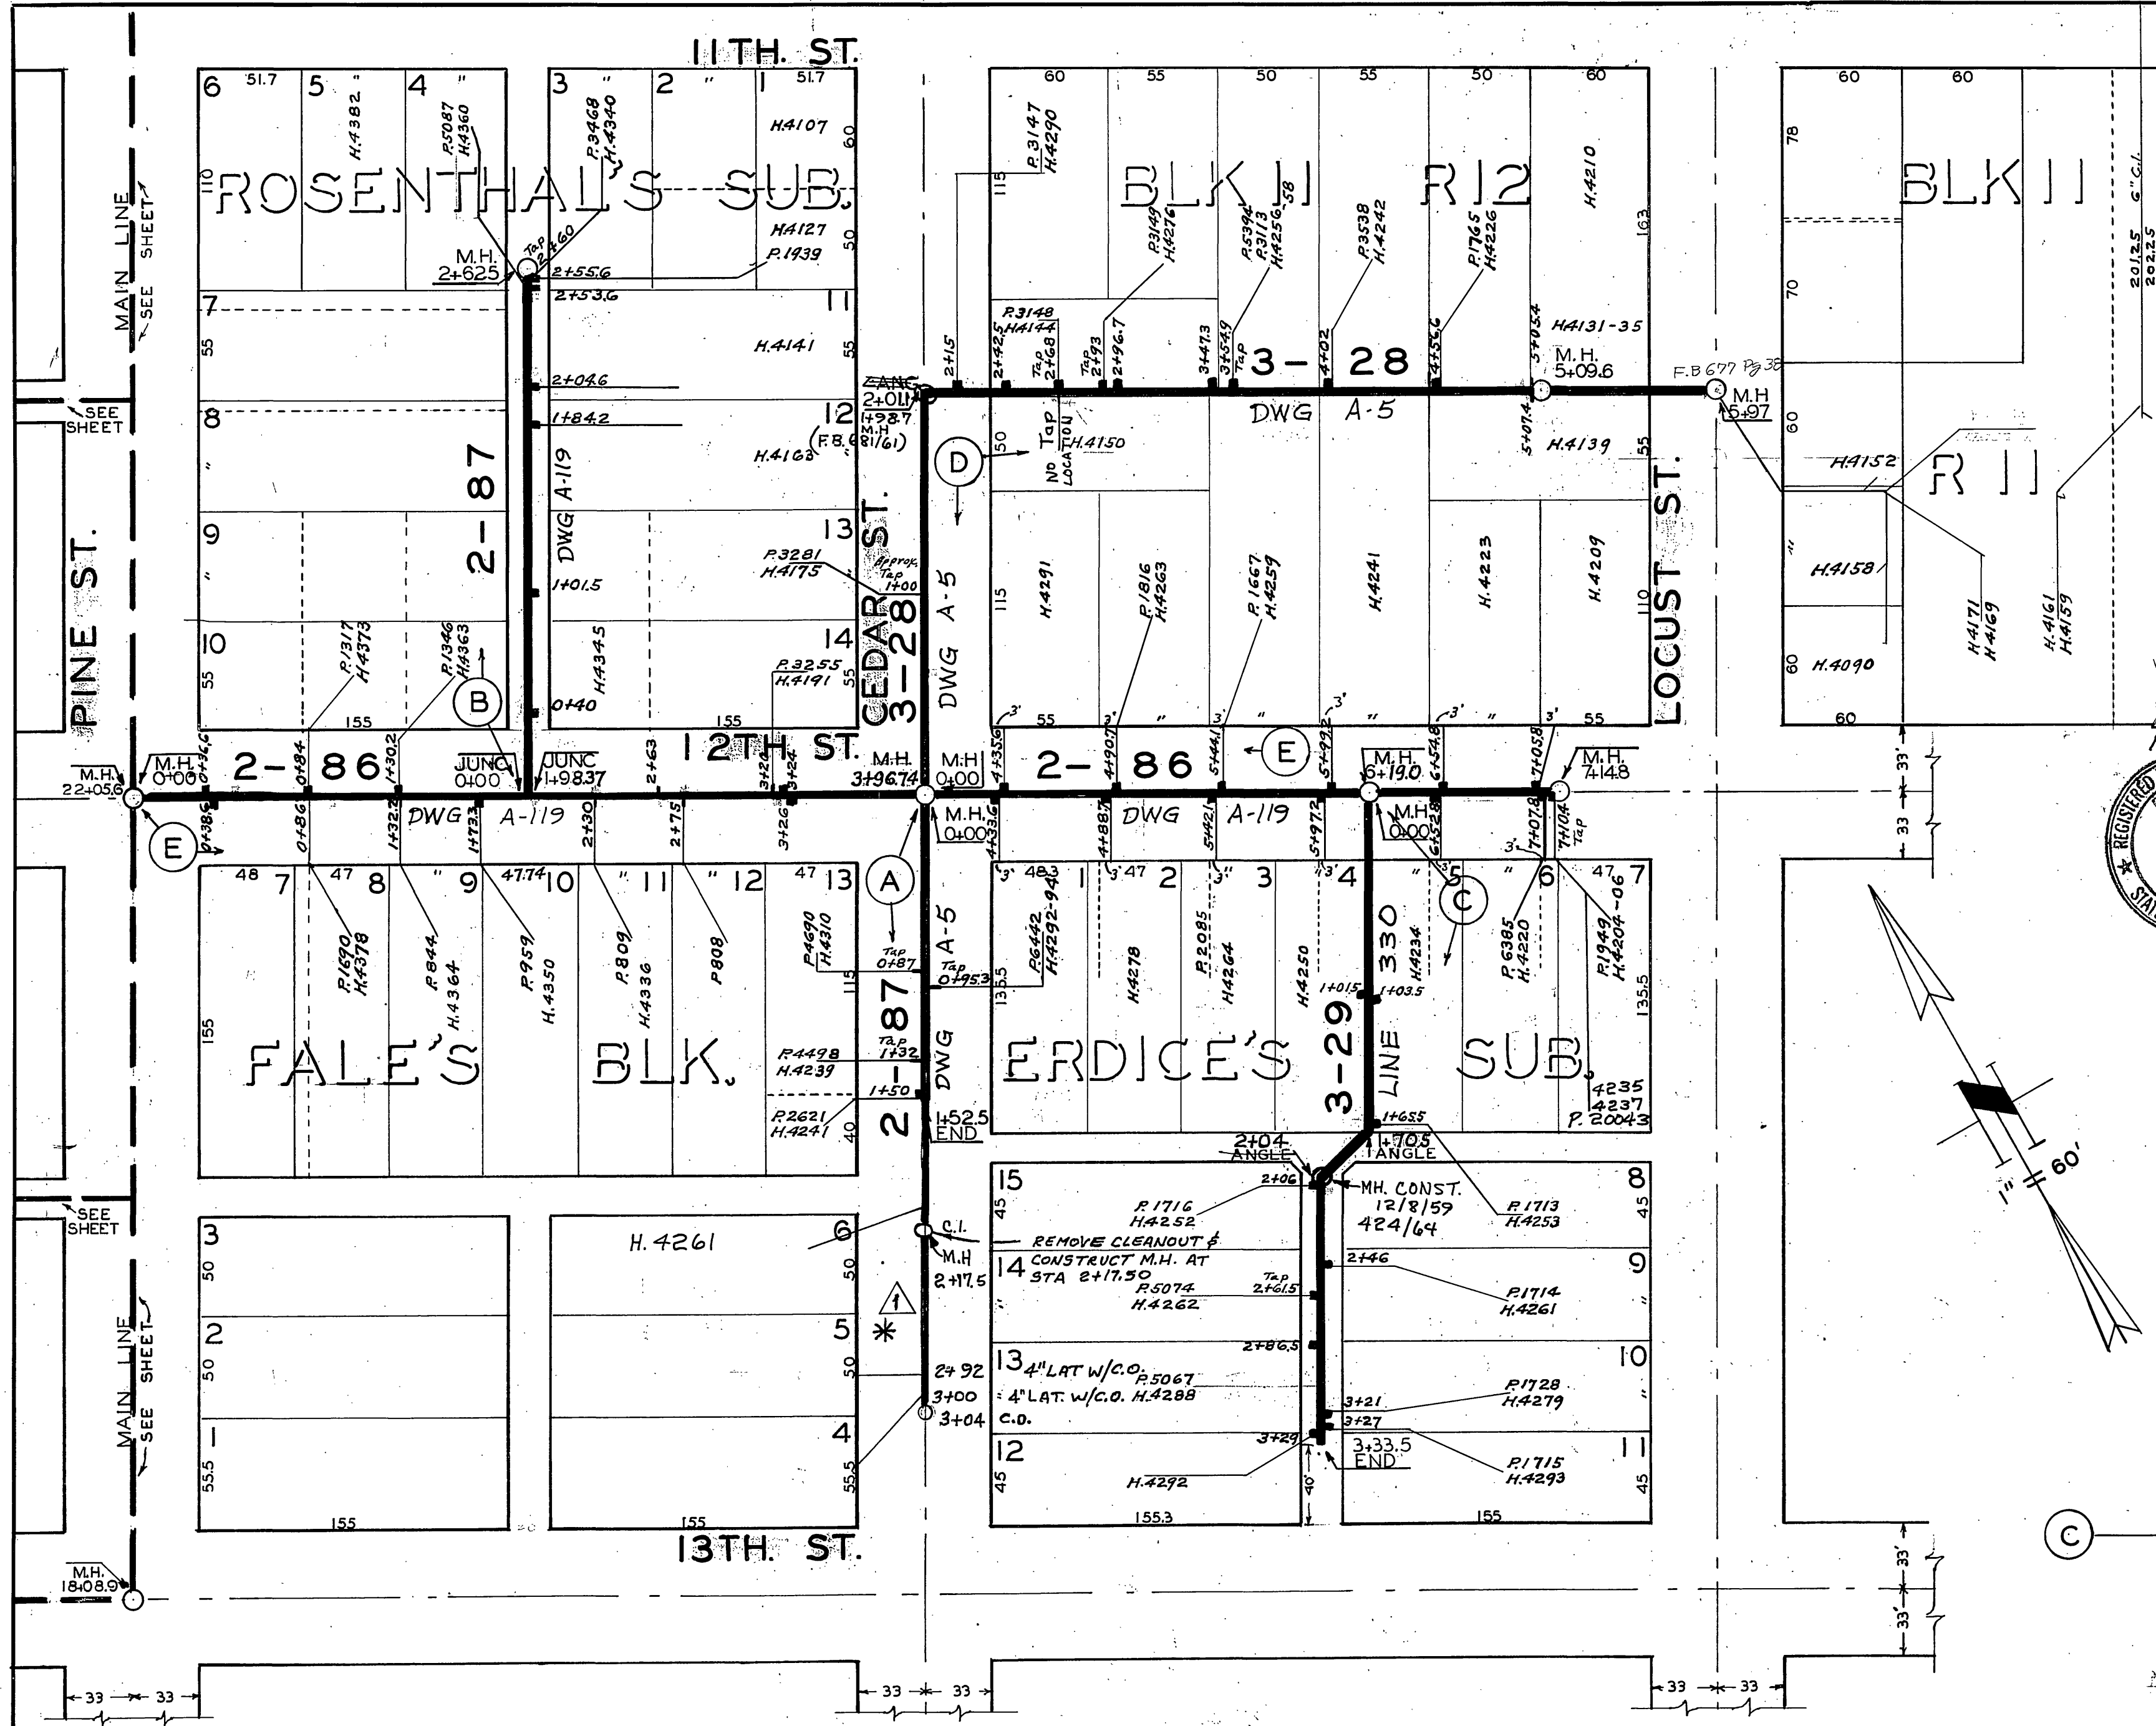
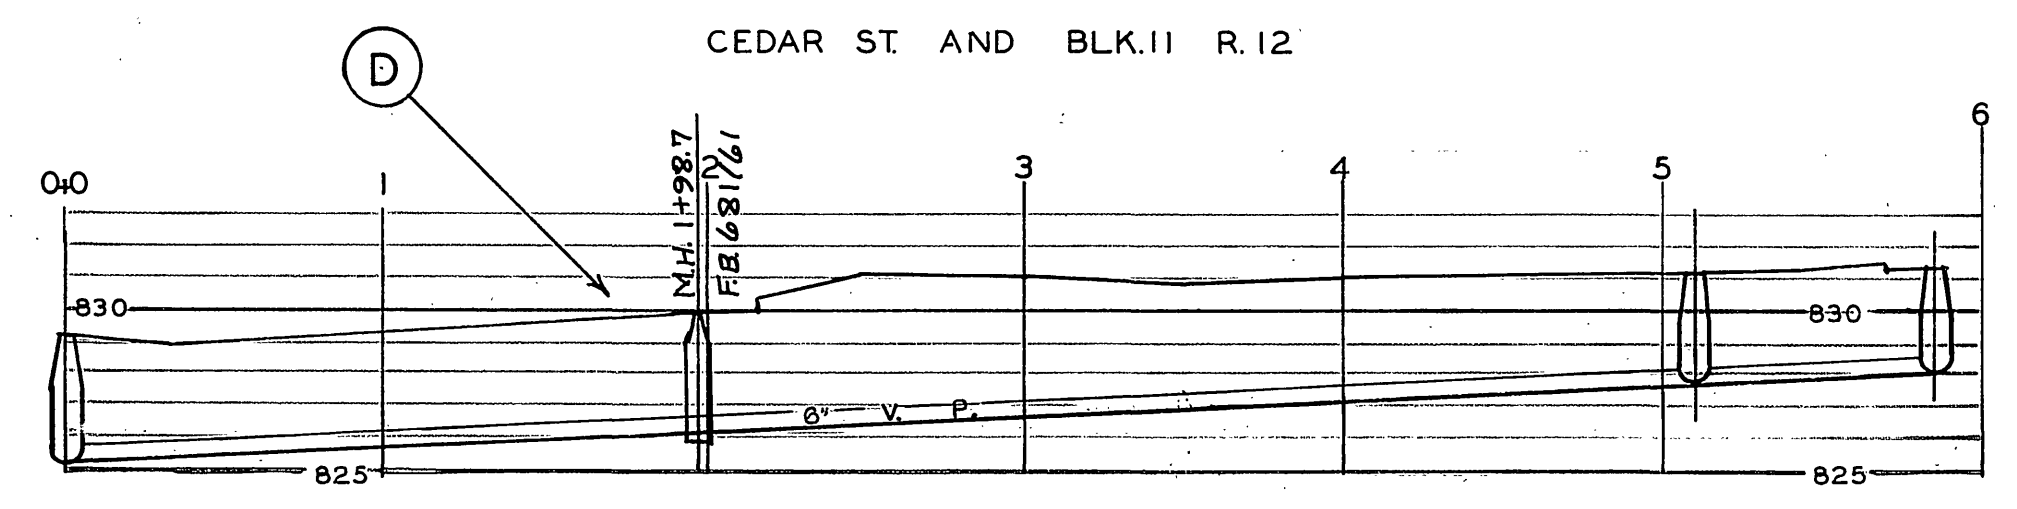
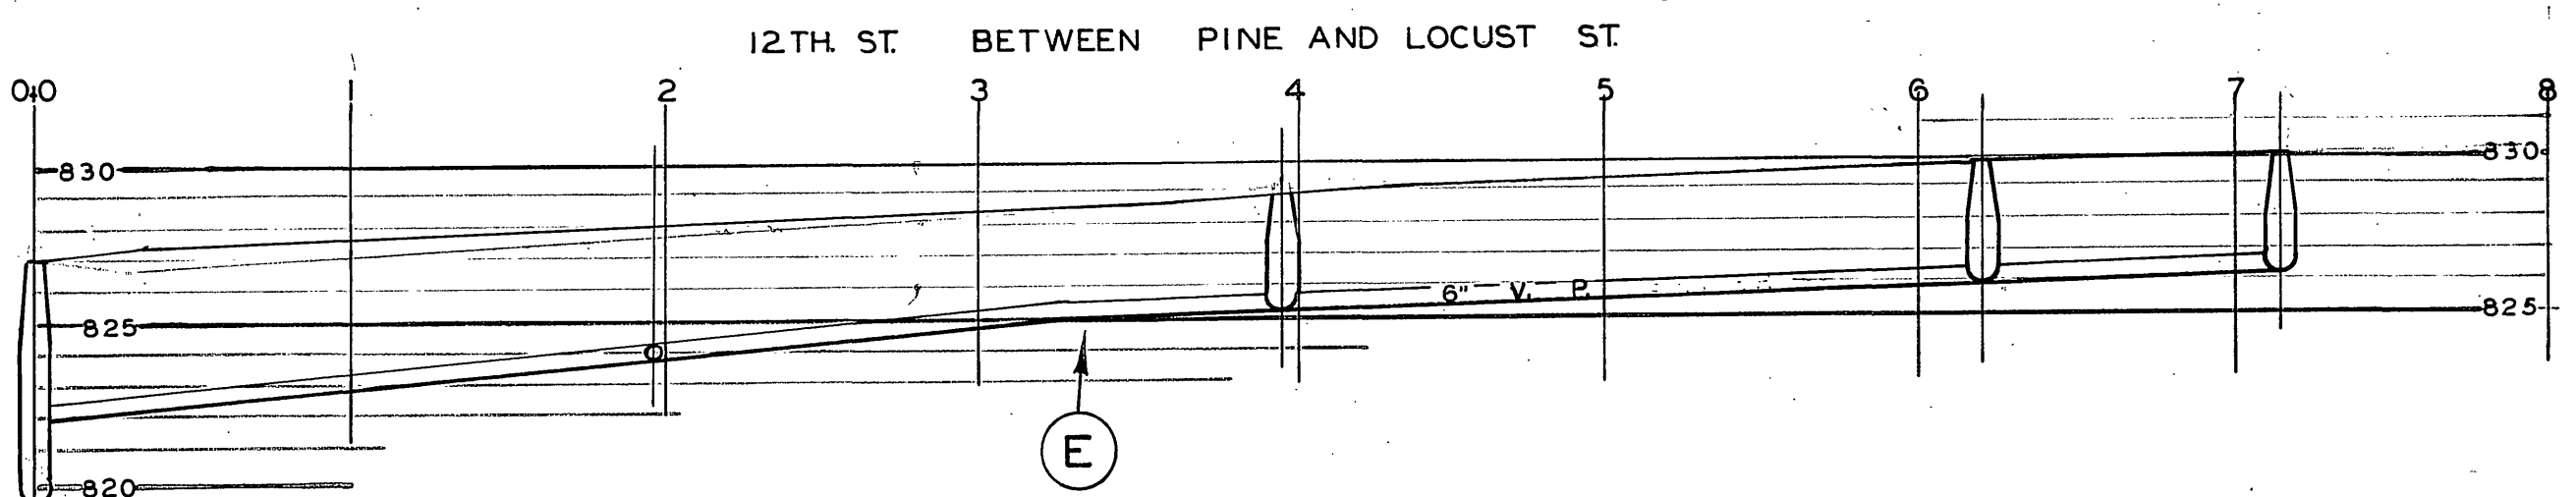
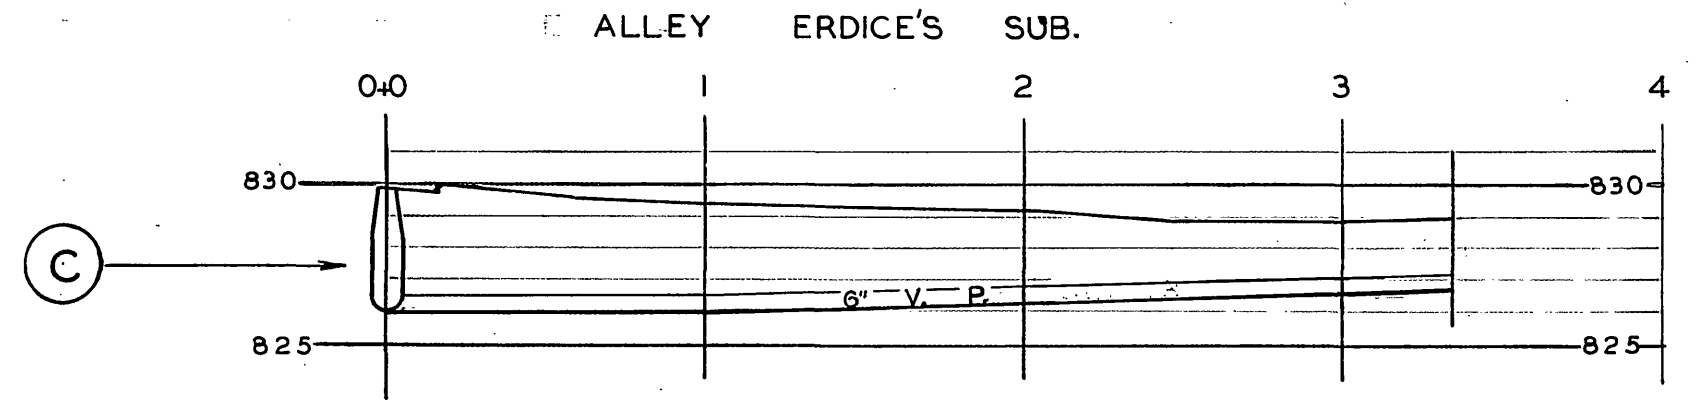


BOOK	ONE	PAGE	38
EXTEND LINE A-5, SOUTH			8-24-2006

SEWER PROFILES
SCALE HOR. 1" = 60'
VER. 1" = 6'

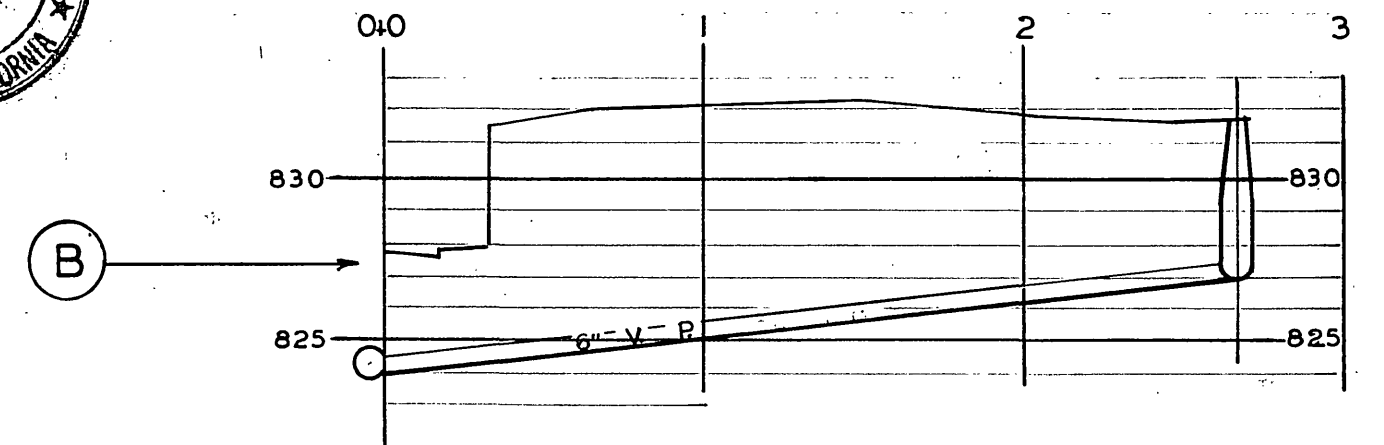

* REVISION: SEWER EXTENSION FROM STA 2+17.50 TO STA 3+04.00
PW05-0564 PREPARED BY PAUL DIEGGS R.C.E. 13234 EXP 3-31-2007
1051 DAVIDS ROAD PERRIS CA 92571 (951) 657-2822
CITY OF RIVERSIDE TAX CERTIFICATE NO. 01880,
EXPIRATION DATE 4-14-2006.
Paul Dieggs PAUL DIEGGS, RCE 13234
ALLEY ROSENTHAL'S SUB.

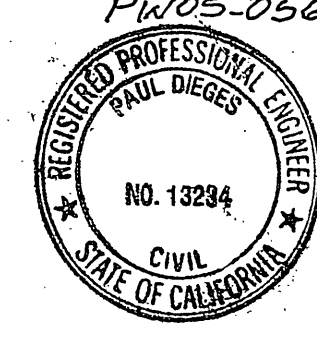

* A5-BUILT REV. 1 1-12-06 LHH