


BOOK	ONE	PAGE	45

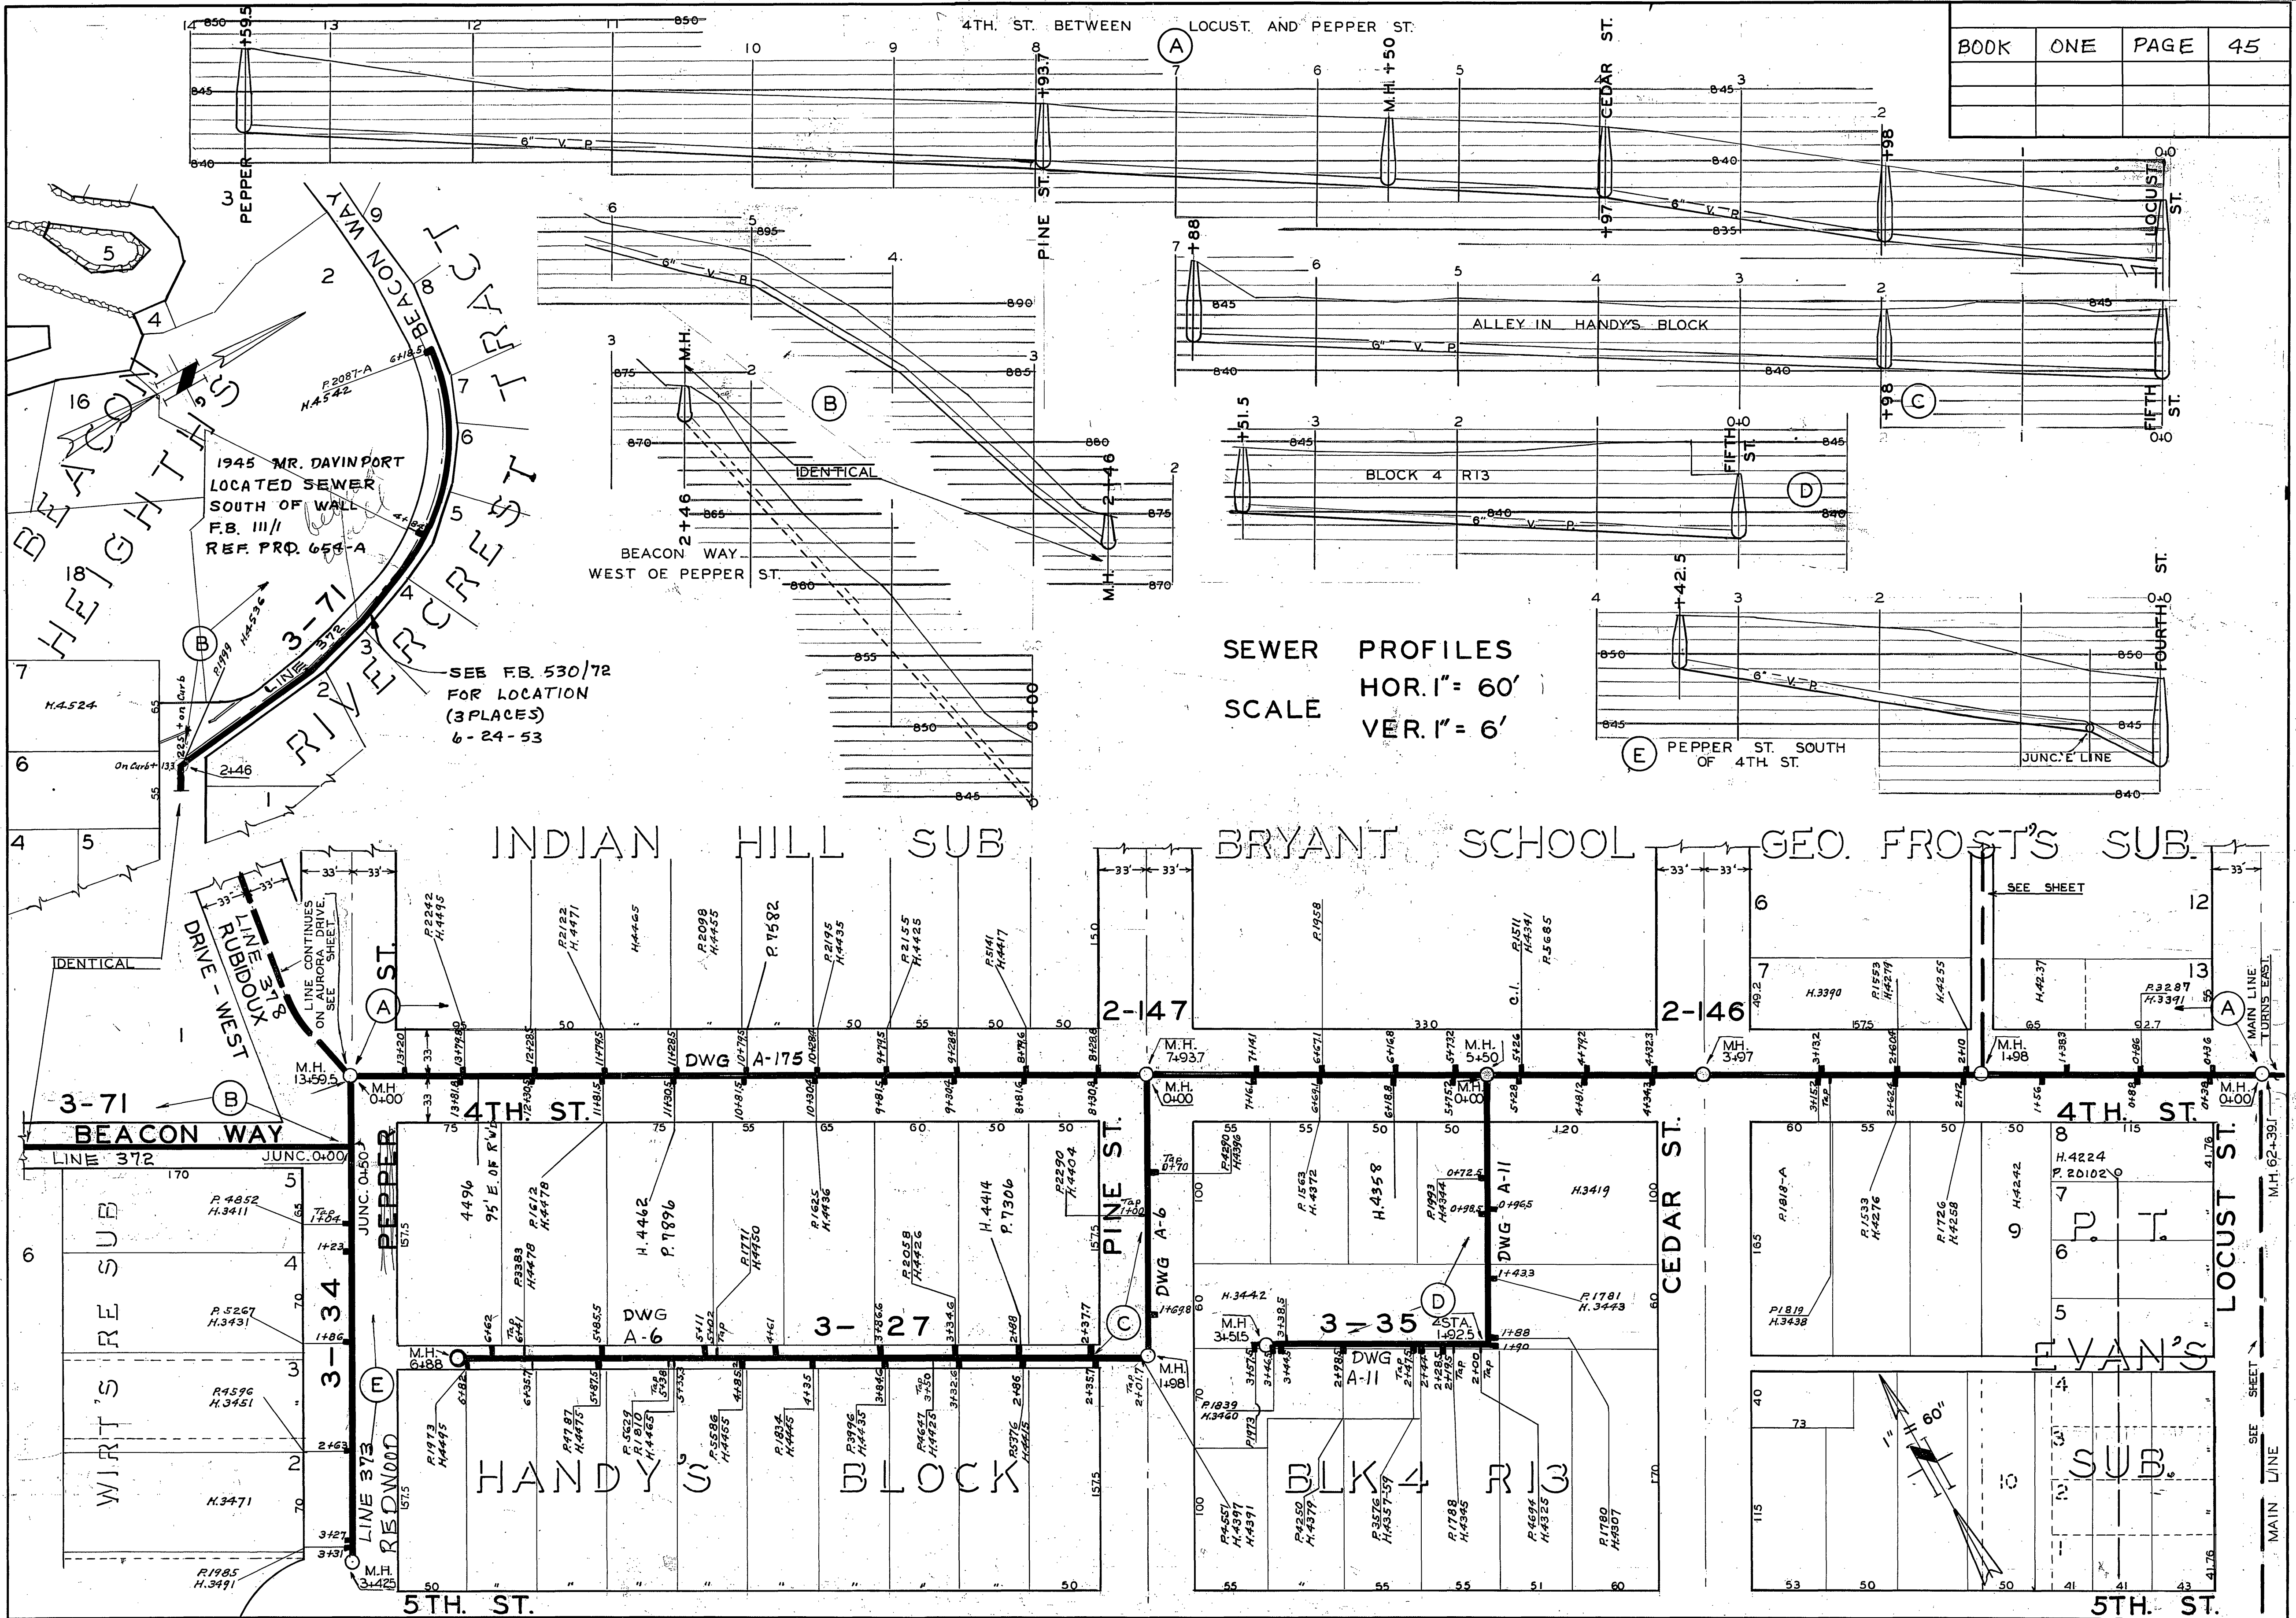

SEWER PROFILES
SCALE HOR. 1" = 60'
VER. 1" = 6'

1945 MR. DAVINPORT
LOCATED SEWER
SOUTH OF WALL
F.B. III//
REF. PRD. 653-A

SEE FB. 530/72
FOR LOCATION
(3 PLACES)
6-24-53

INDIAN HILL SUB BRYANT SCHOOL GEO. FROST'S SUB

HANDY'S BLOCK

EVAN'S SUB