



BOOK	ONE	PAGE	46

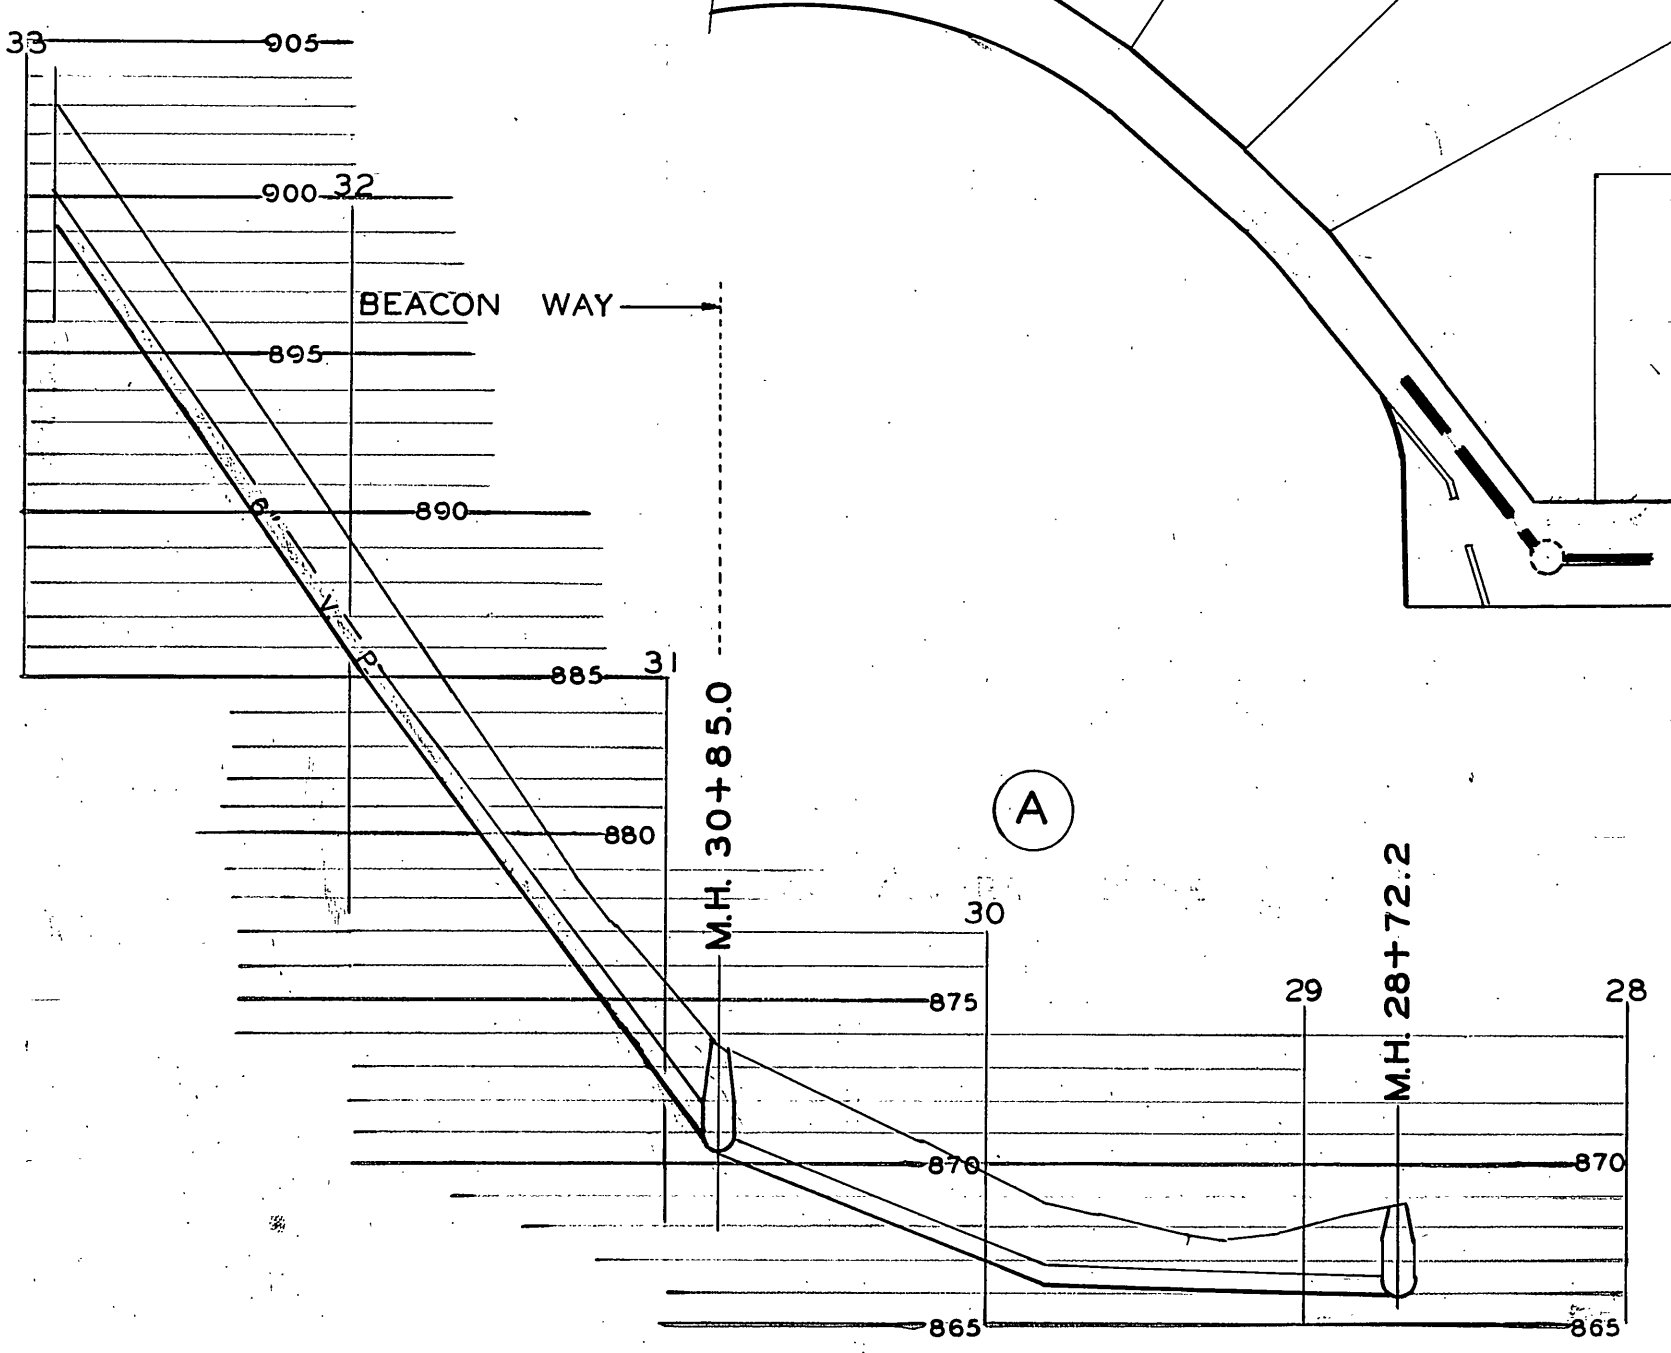

SEWER PROFILES
 SCALE HOR. 1" = 60'
 VER. 1" = 6'

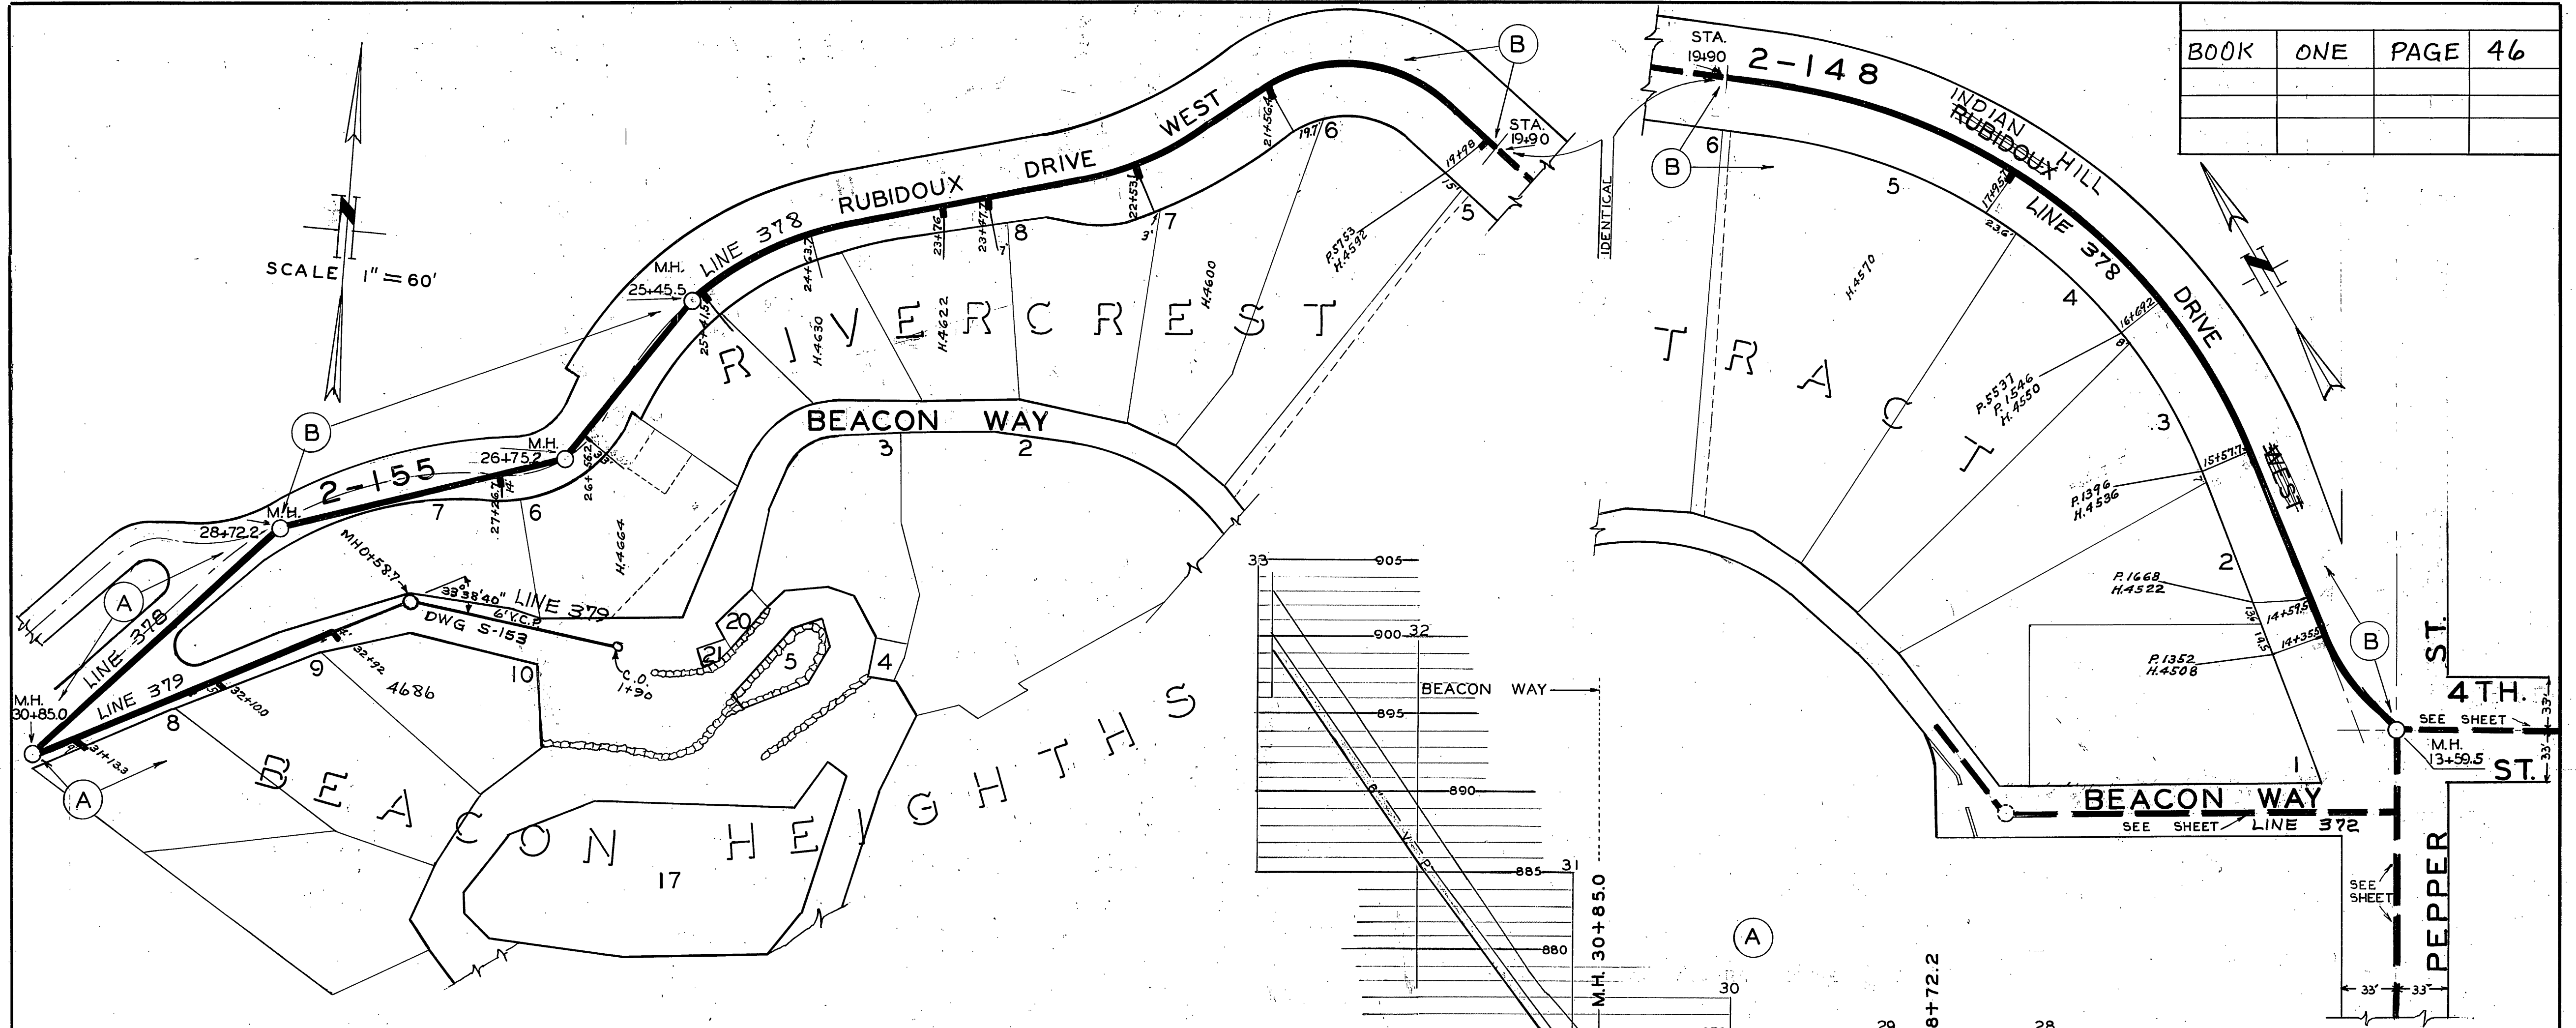