


PREPARED BY:
ESGATE (951) 313-2058
 335 PACHAPPA HILL
 ENGINEERING RIVERSIDE, CA 92506
 DATE: 1-5-2006
 CITY BUSINESS TAX CERT NO 110950 EXR 10/2006

BOOK	ONE	PAGE	50
REVISION	Δ	ADDED 6" VCP TO	SERIE
		2749 MULBERRY 11/27/2005	RIZ 12606

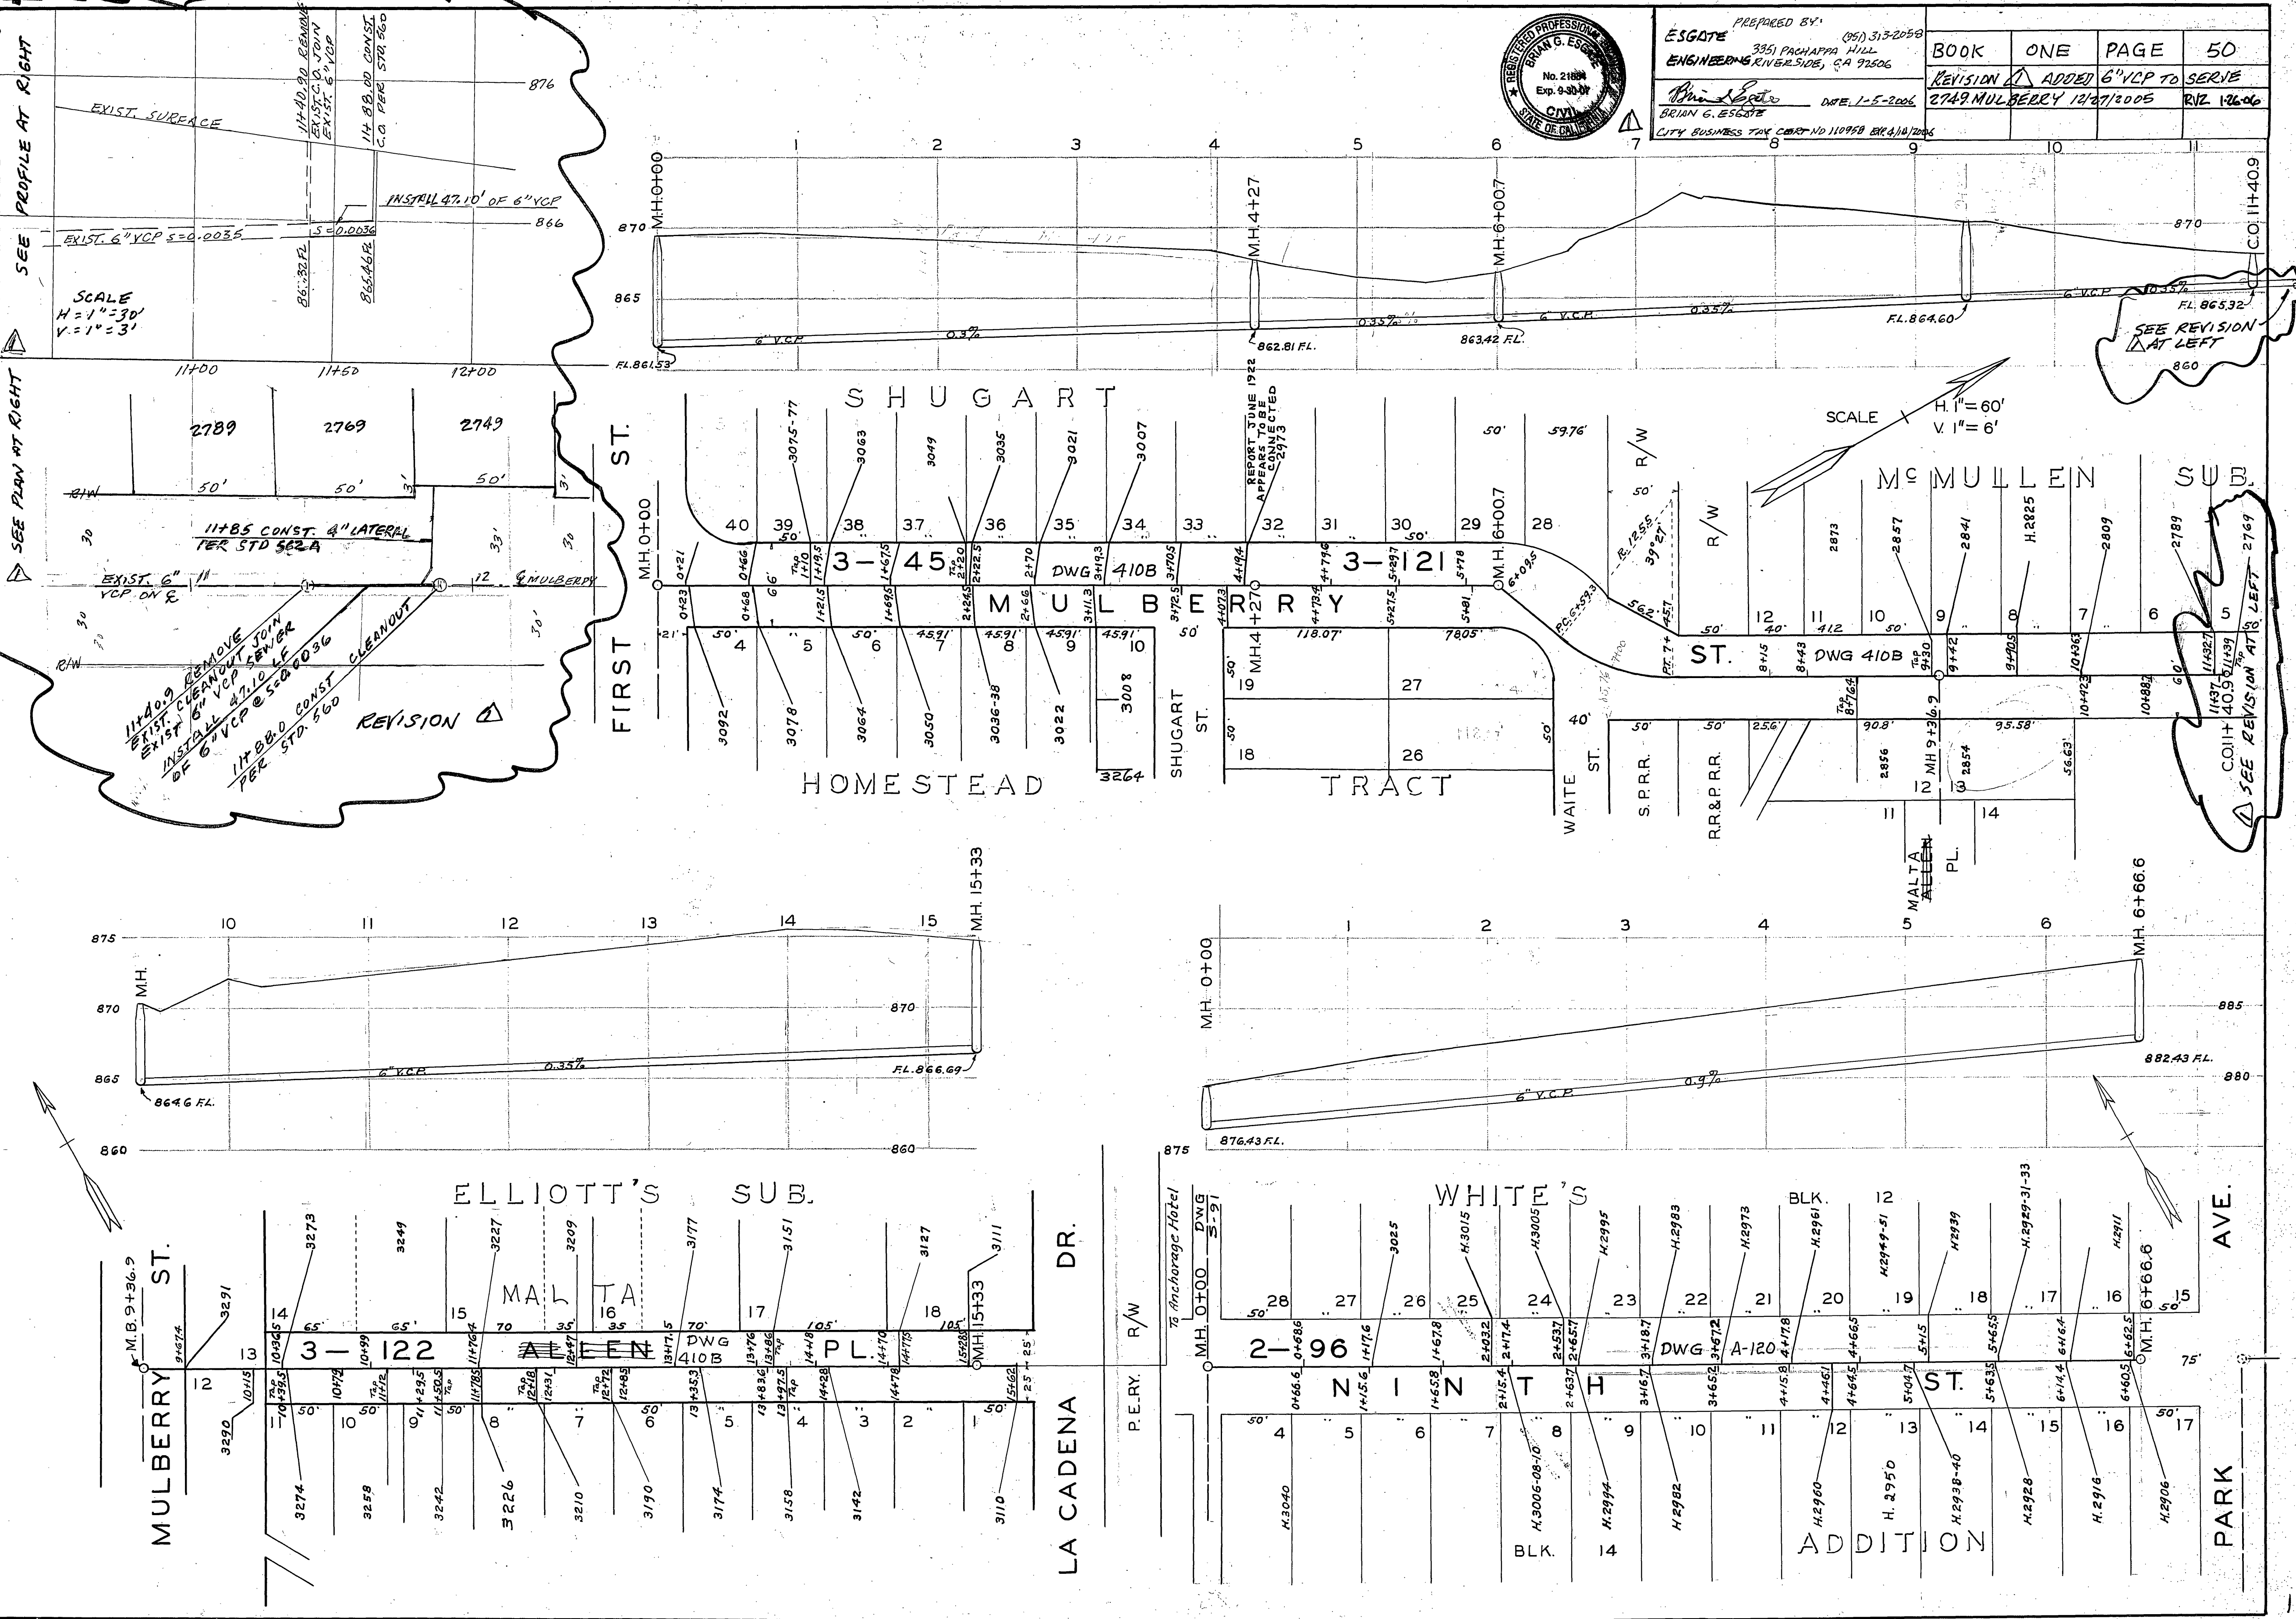

SCALE
 H = 1" = 30'
 V = 1" = 3'

SCALE
 H = 1" = 60'
 V = 1" = 6'

