
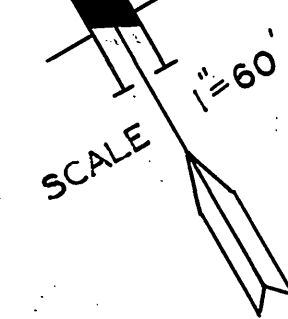
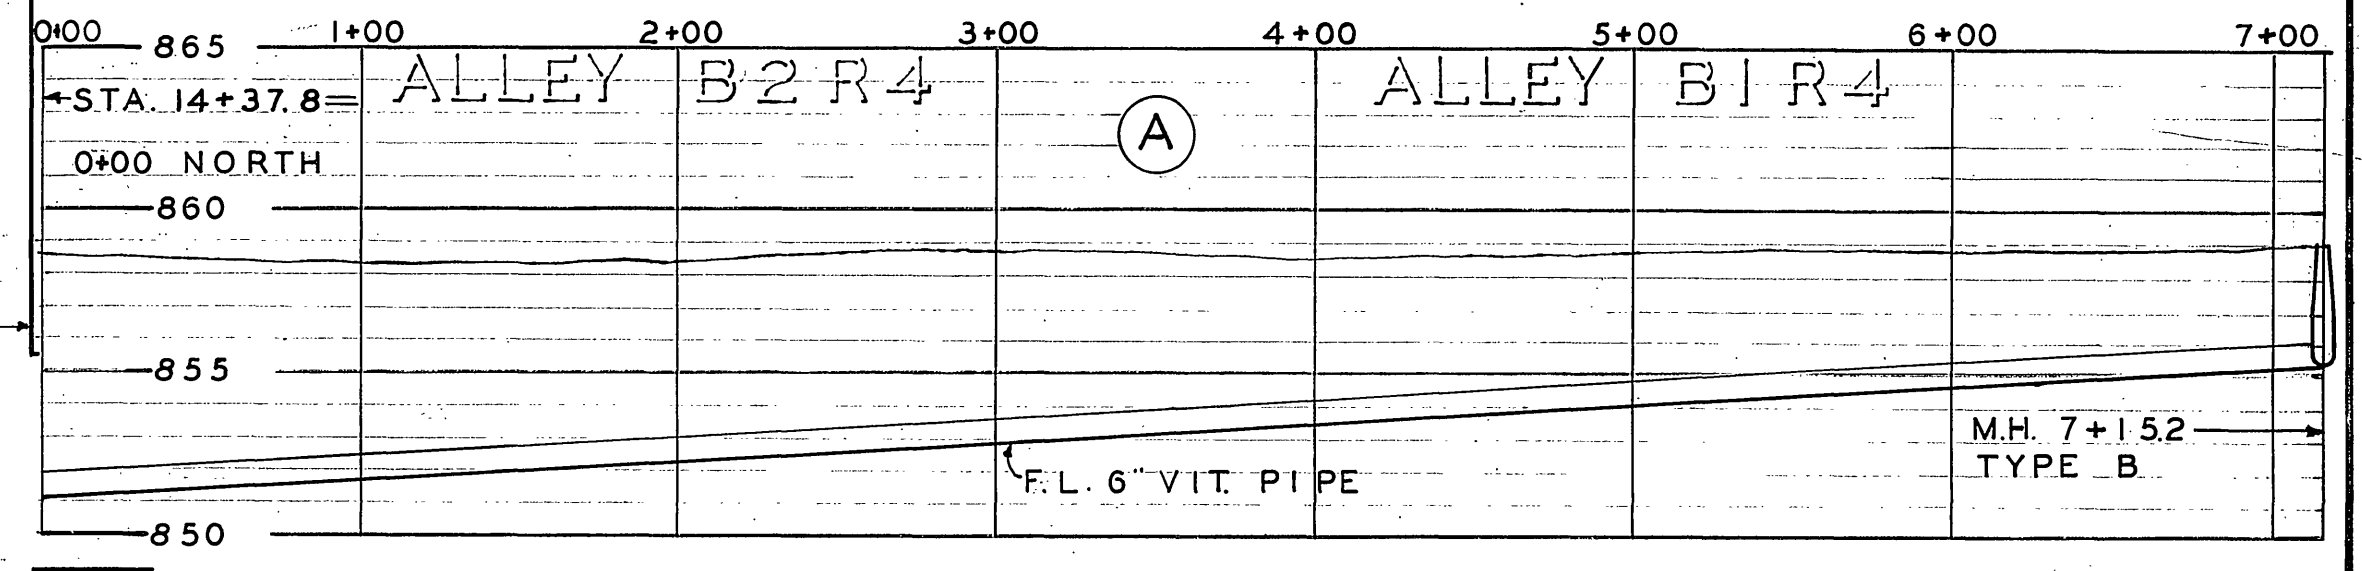
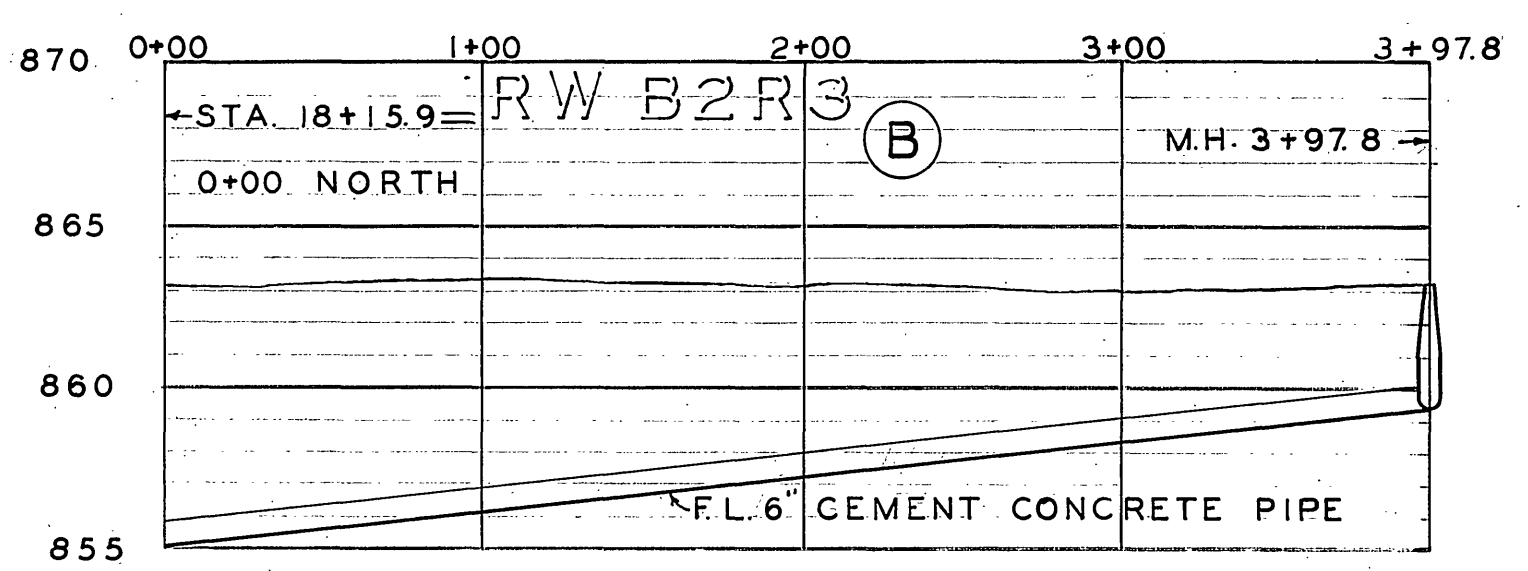
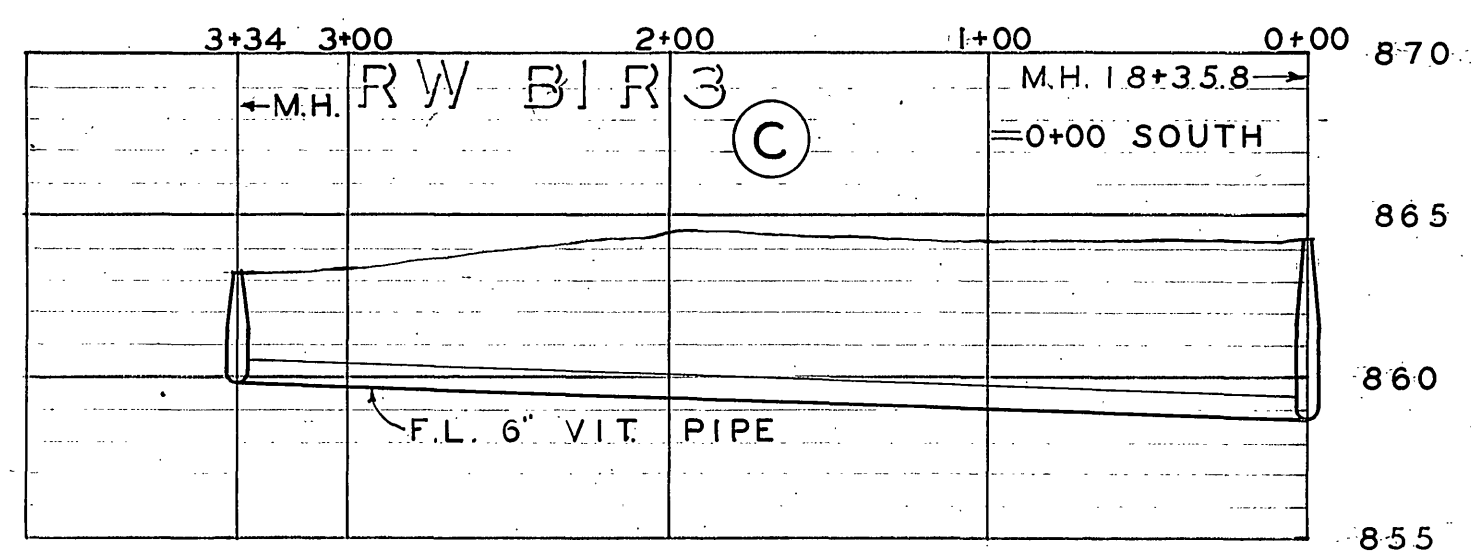


BOOK	ONE	PAGE	53
DATE	DRAWN BY	CHKD BY	APP. BY
	K.L.		

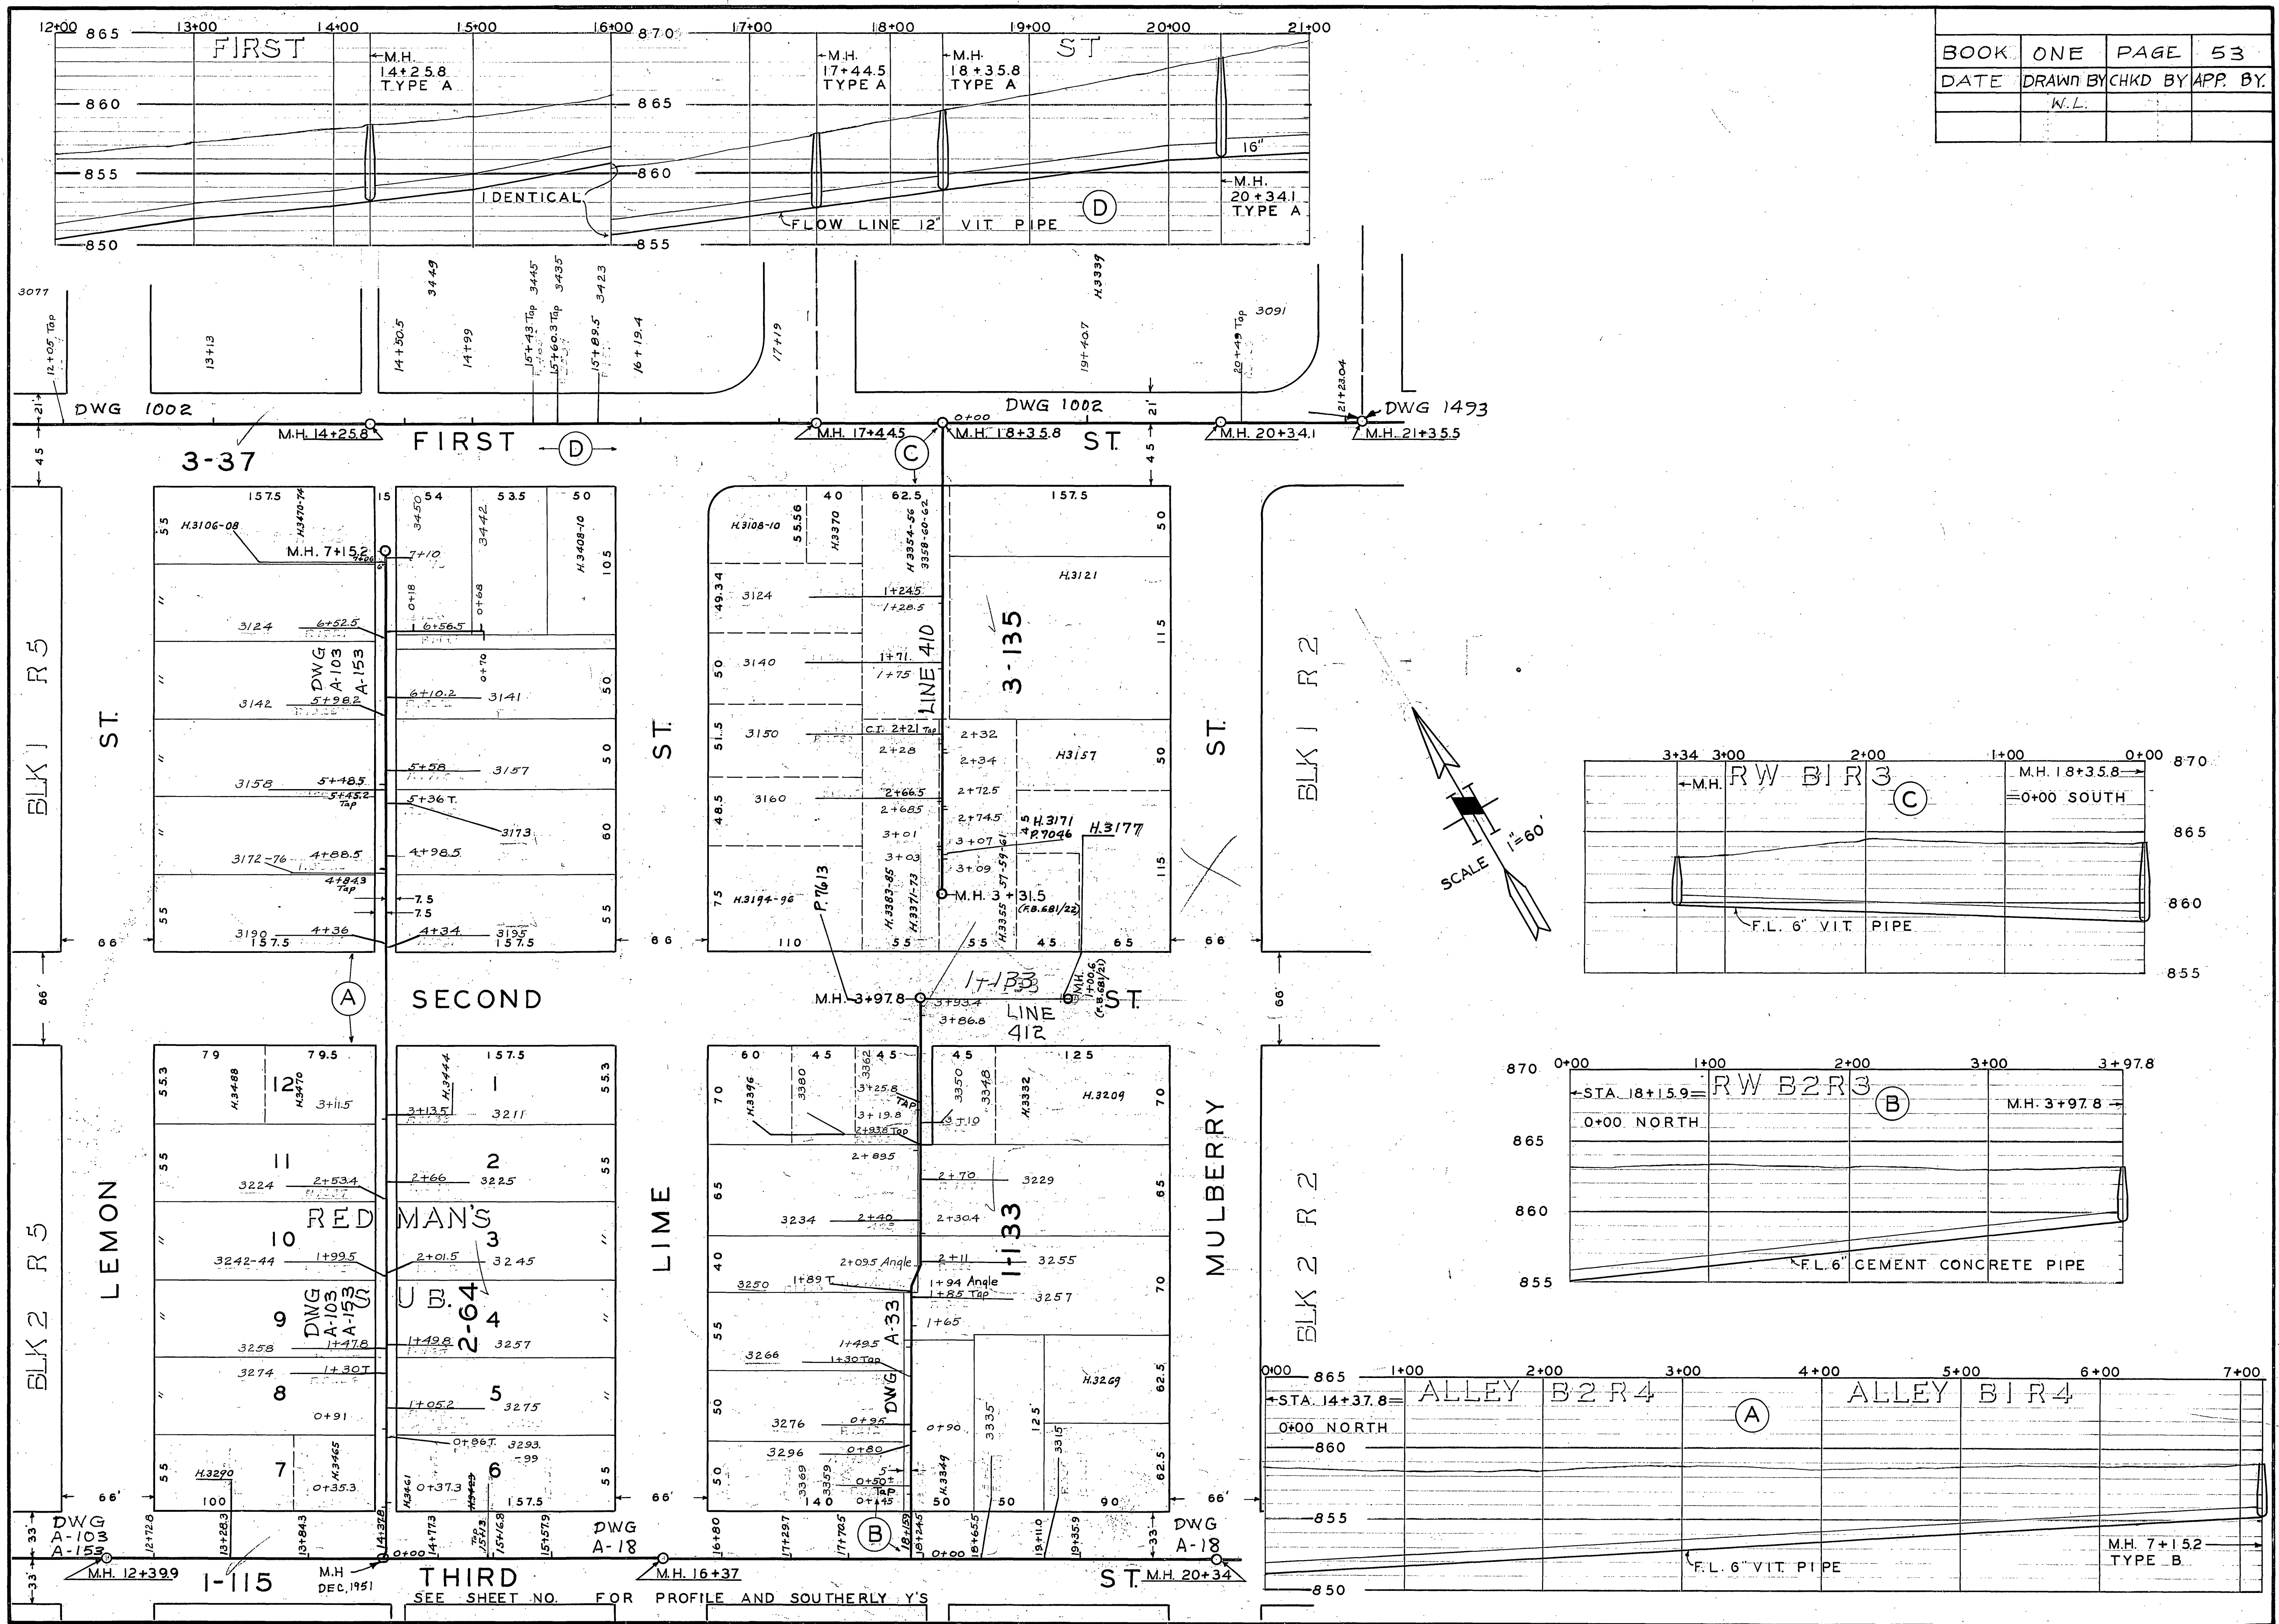

SEE SHEET NO. FOR PROFILE AND SOUTHERLY Y'S