

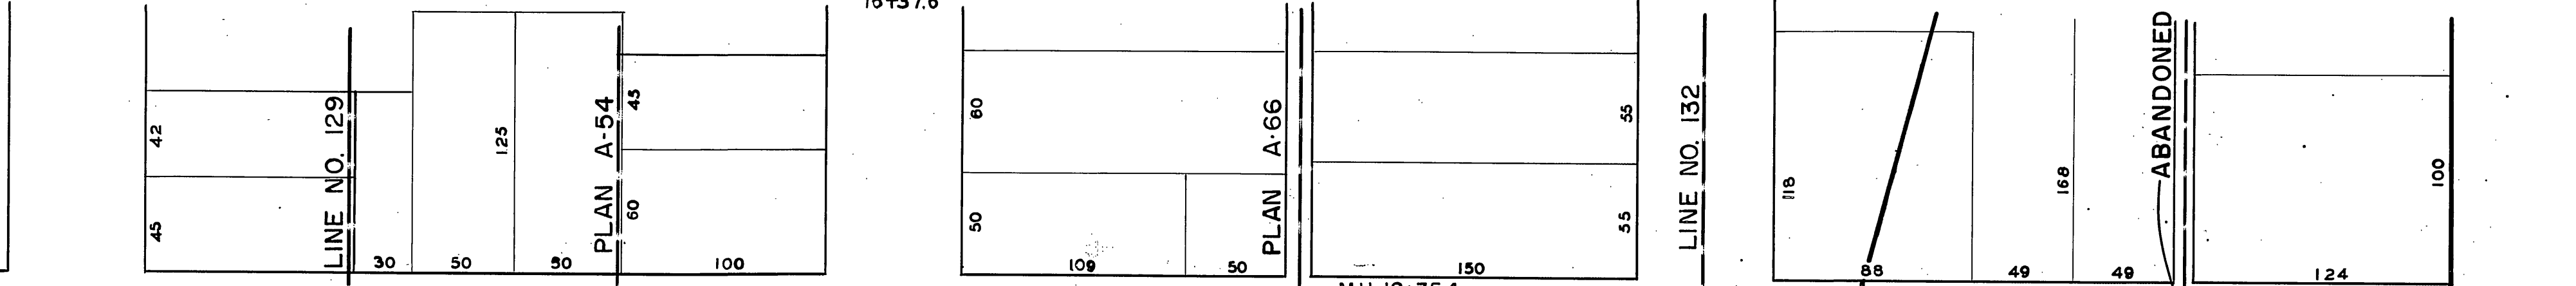
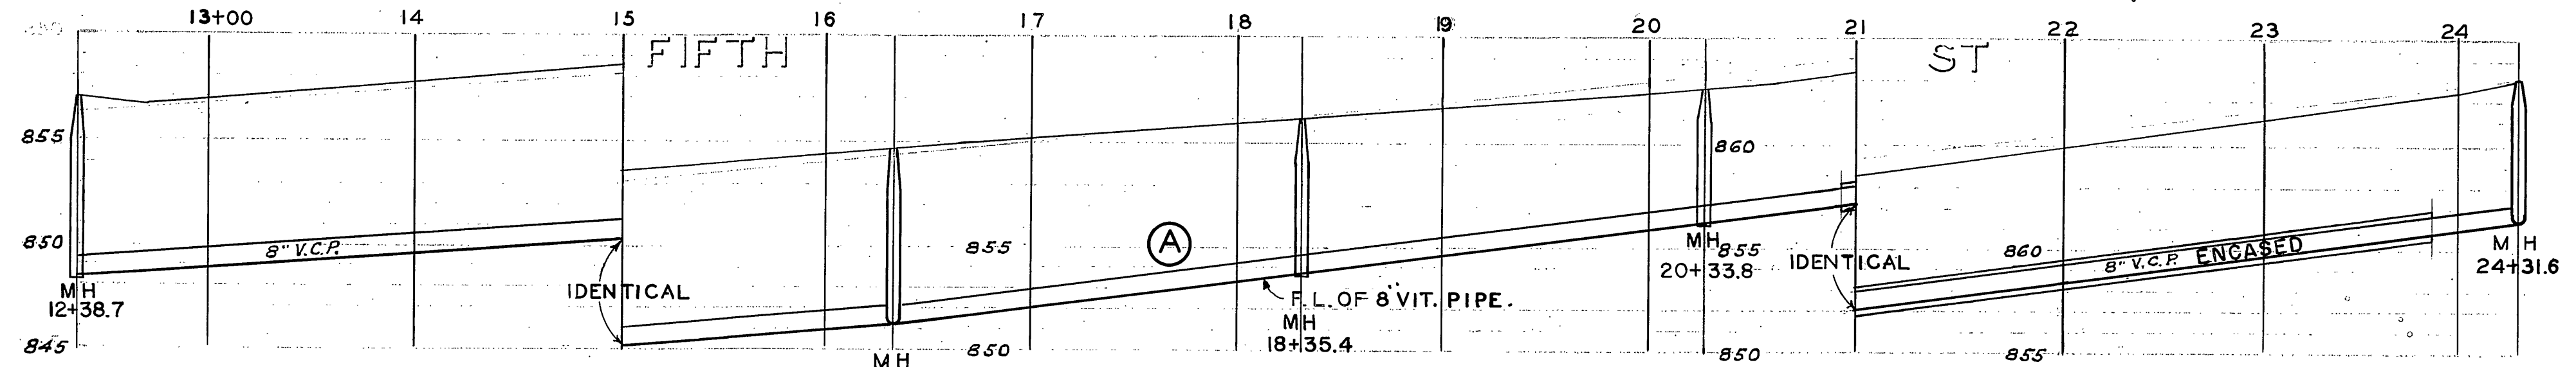


BOOK	ONE	PAGE	7
DATE	DRAWN BY	CHKD BY	APP. BY
	W.L.		

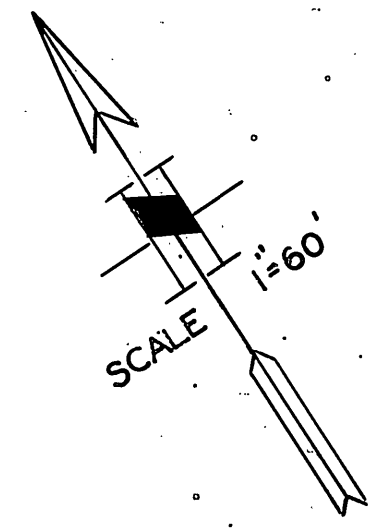

M.H. 12+38.7 F.B. 681/56
 M.H. 16+37.6
 M.H. 18+35.4 F.B. 662/50
 M.H. 20+33.8 F.B. 662/50
 M.H. 24+31.6

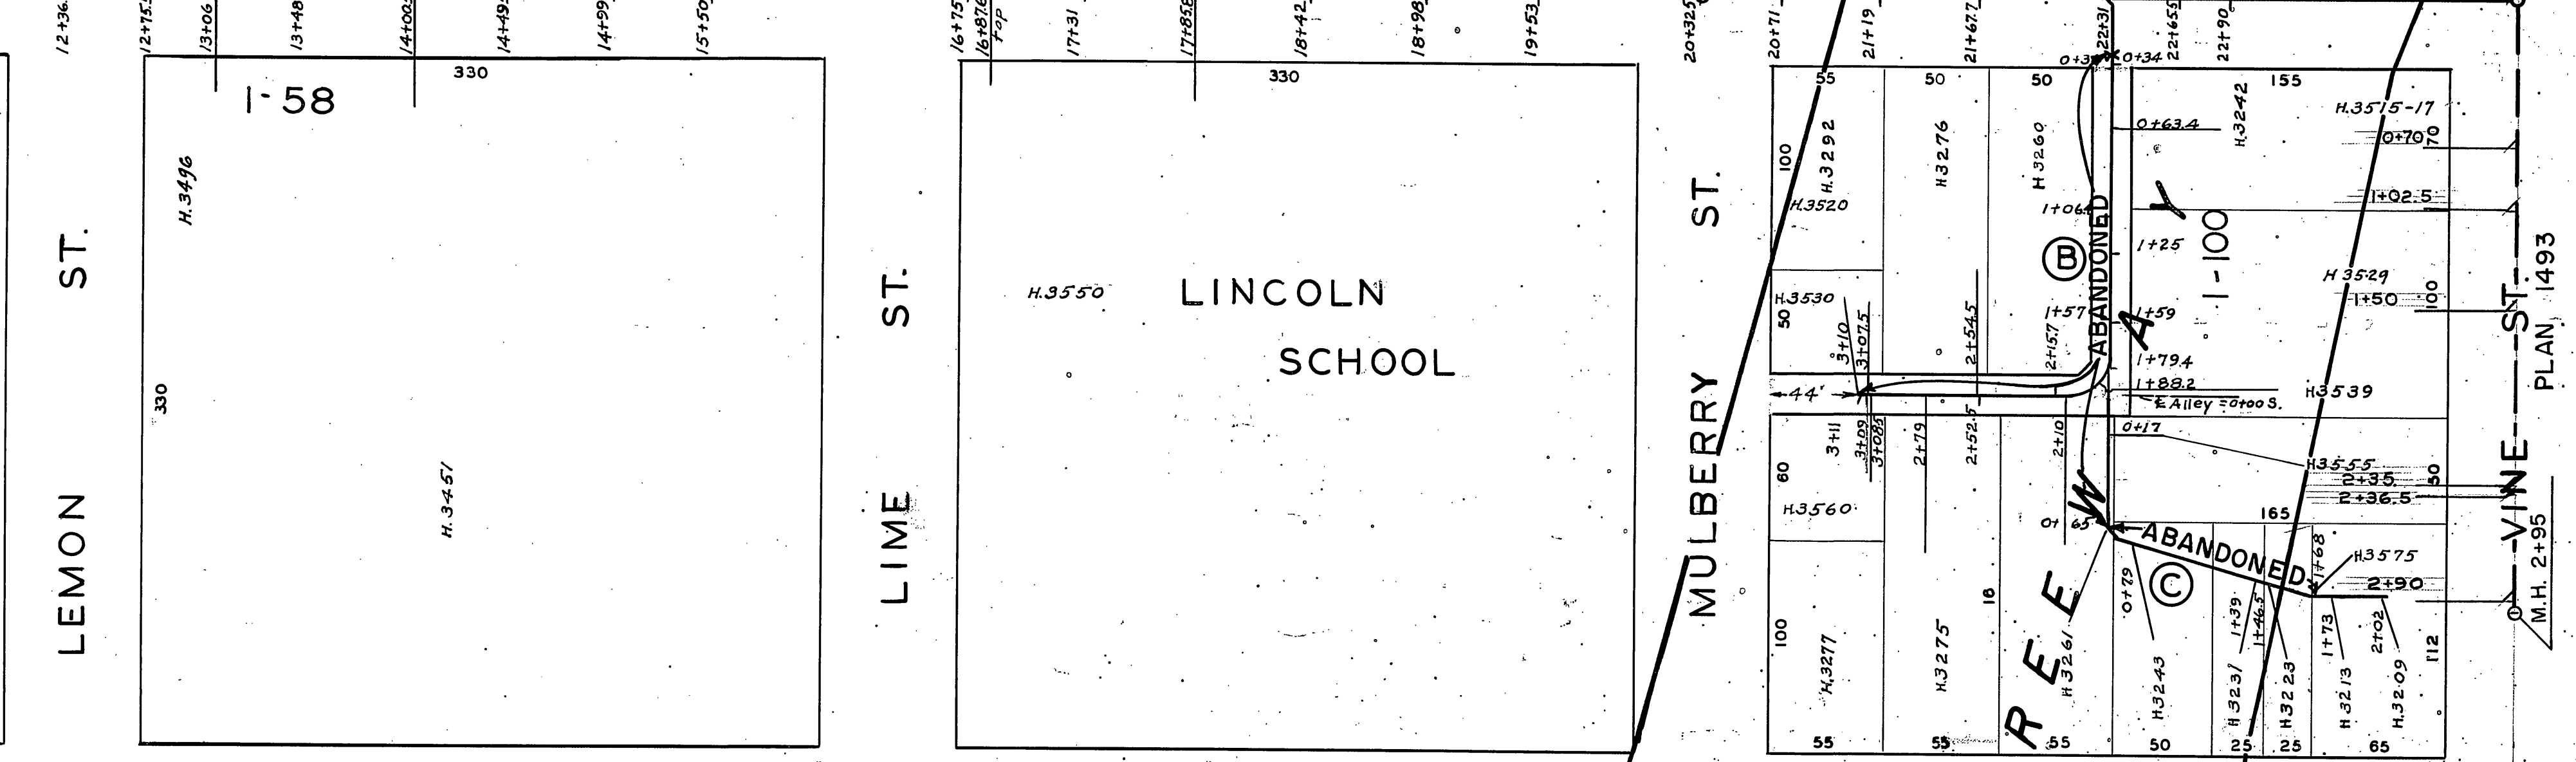

SEWER PROFILES
 SCALE HOR 1"=60'
 VER 1"=6'

