


BOOK	THREE-A	PAGE	11-A

SEWER PROFILE



SCALE - HOR. 1"=60'
VER. 1"=6'

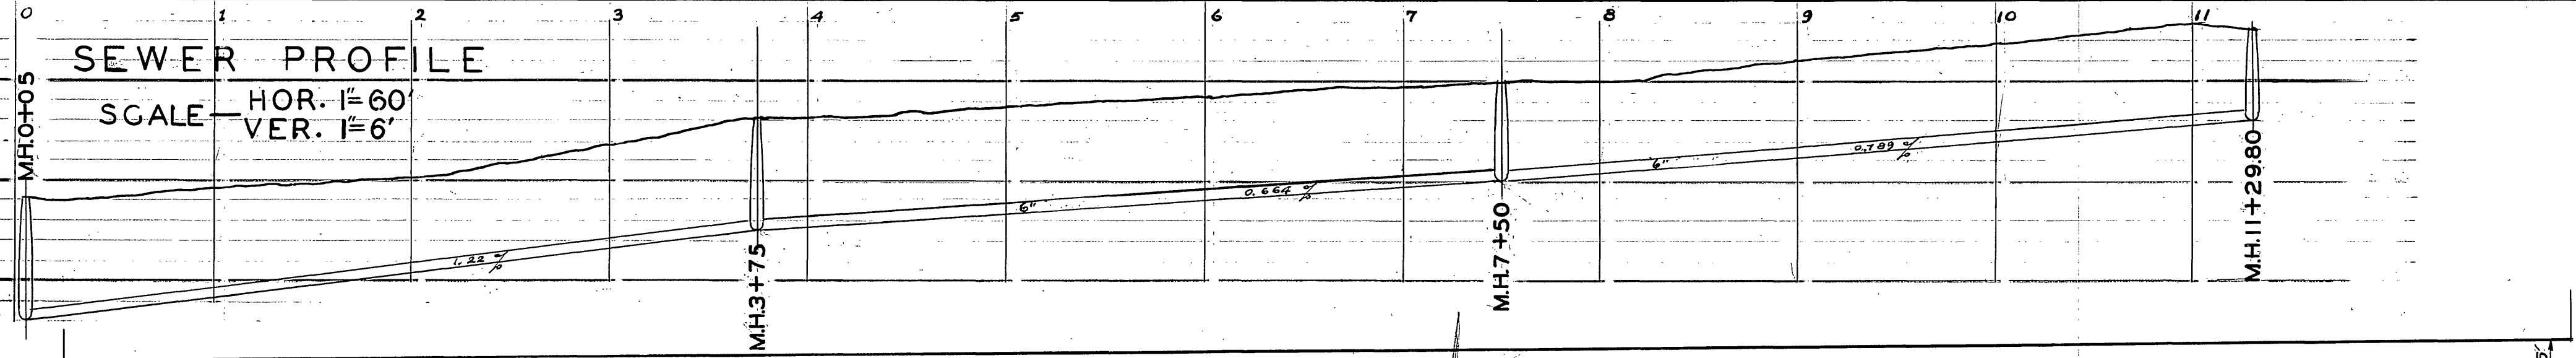

BEATTY DRIVE

DRIVE


N. 89° 57' W

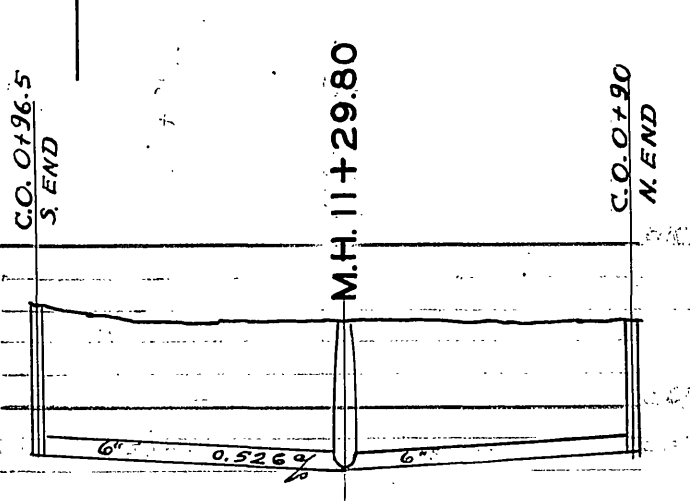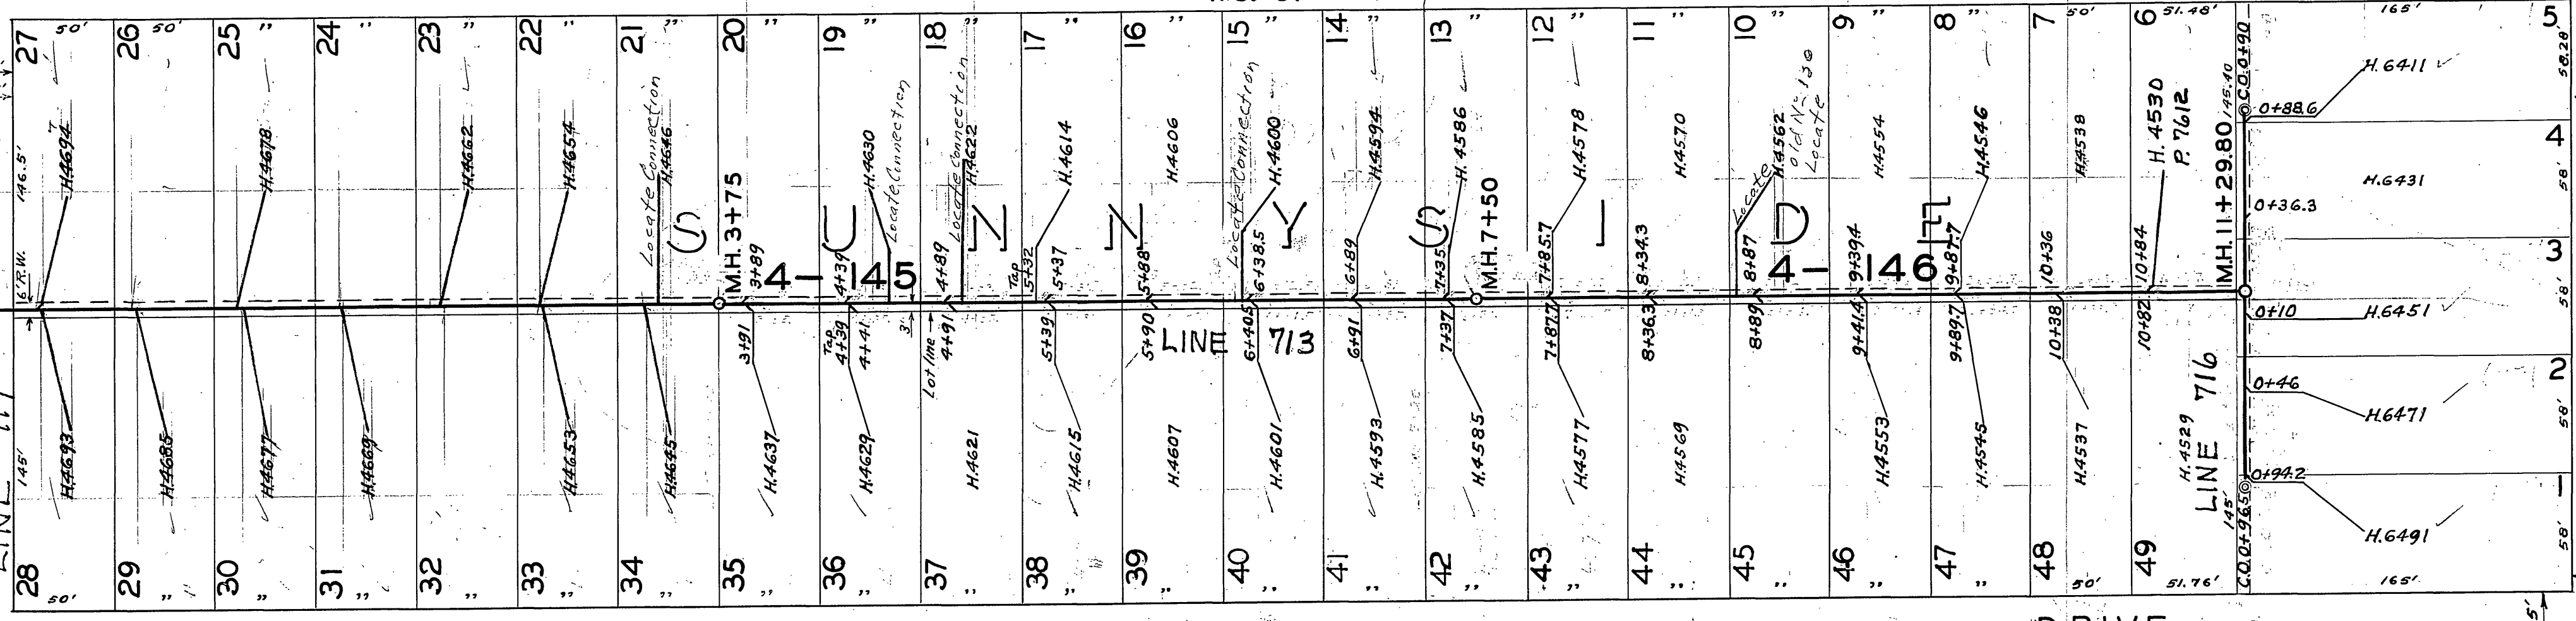

LATERAL IN LOTS 1 TO 5



SEWER PROFILE

SCALE - HOR. 1"=60'
VER. 1"=6'

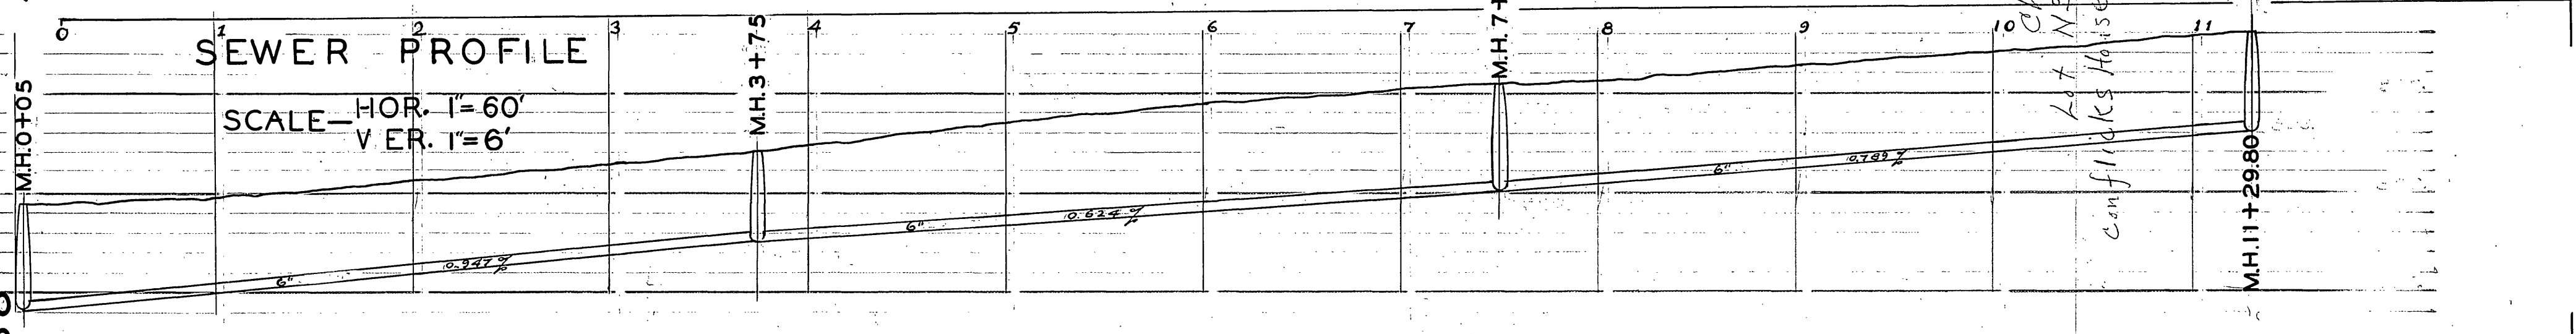

SUNNYSIDE DRIVE

DRIVE

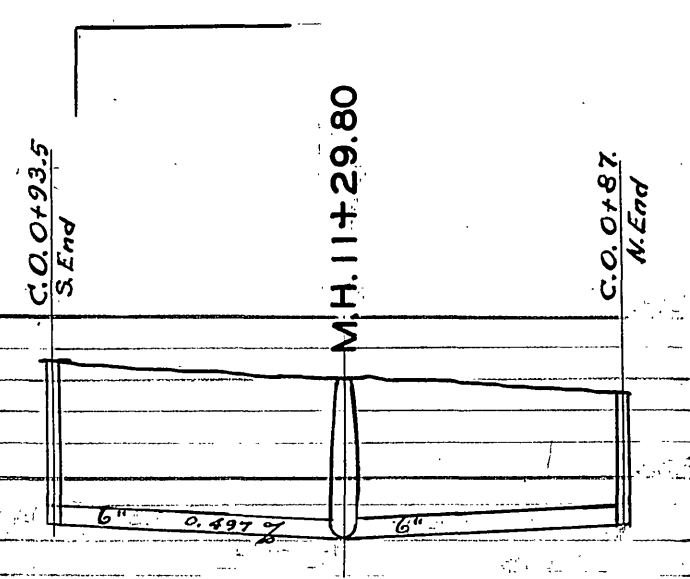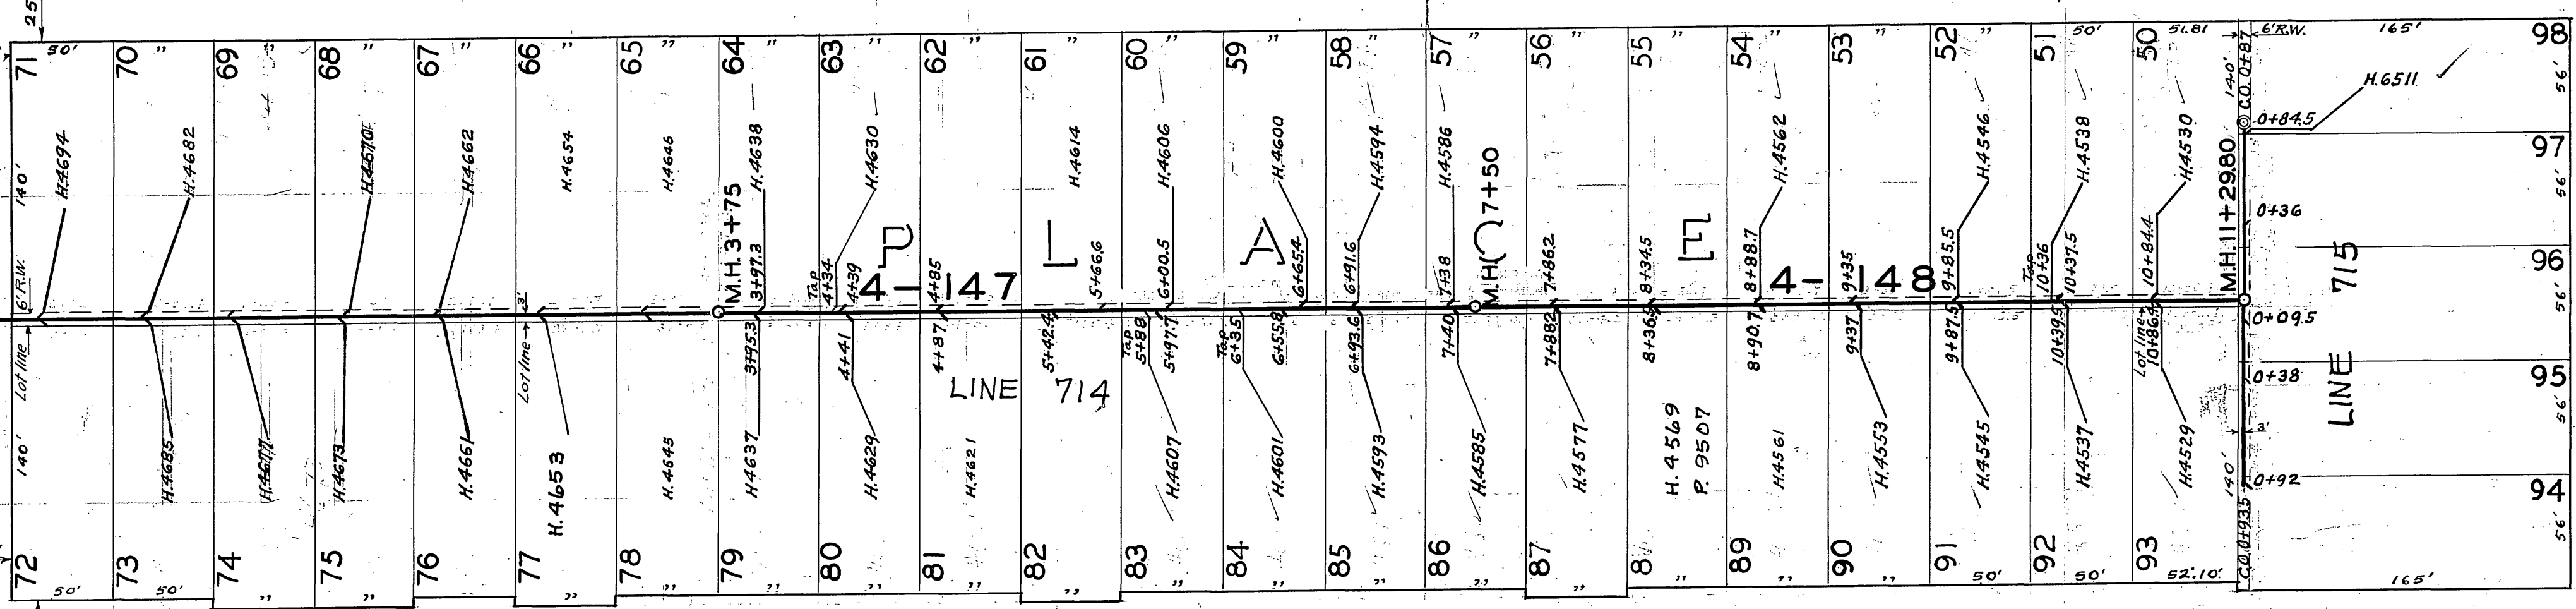

LATERAL IN LOTS 94 TO 98

C-D

A-B