


BOOK	THREE-A	PAGE	13-A

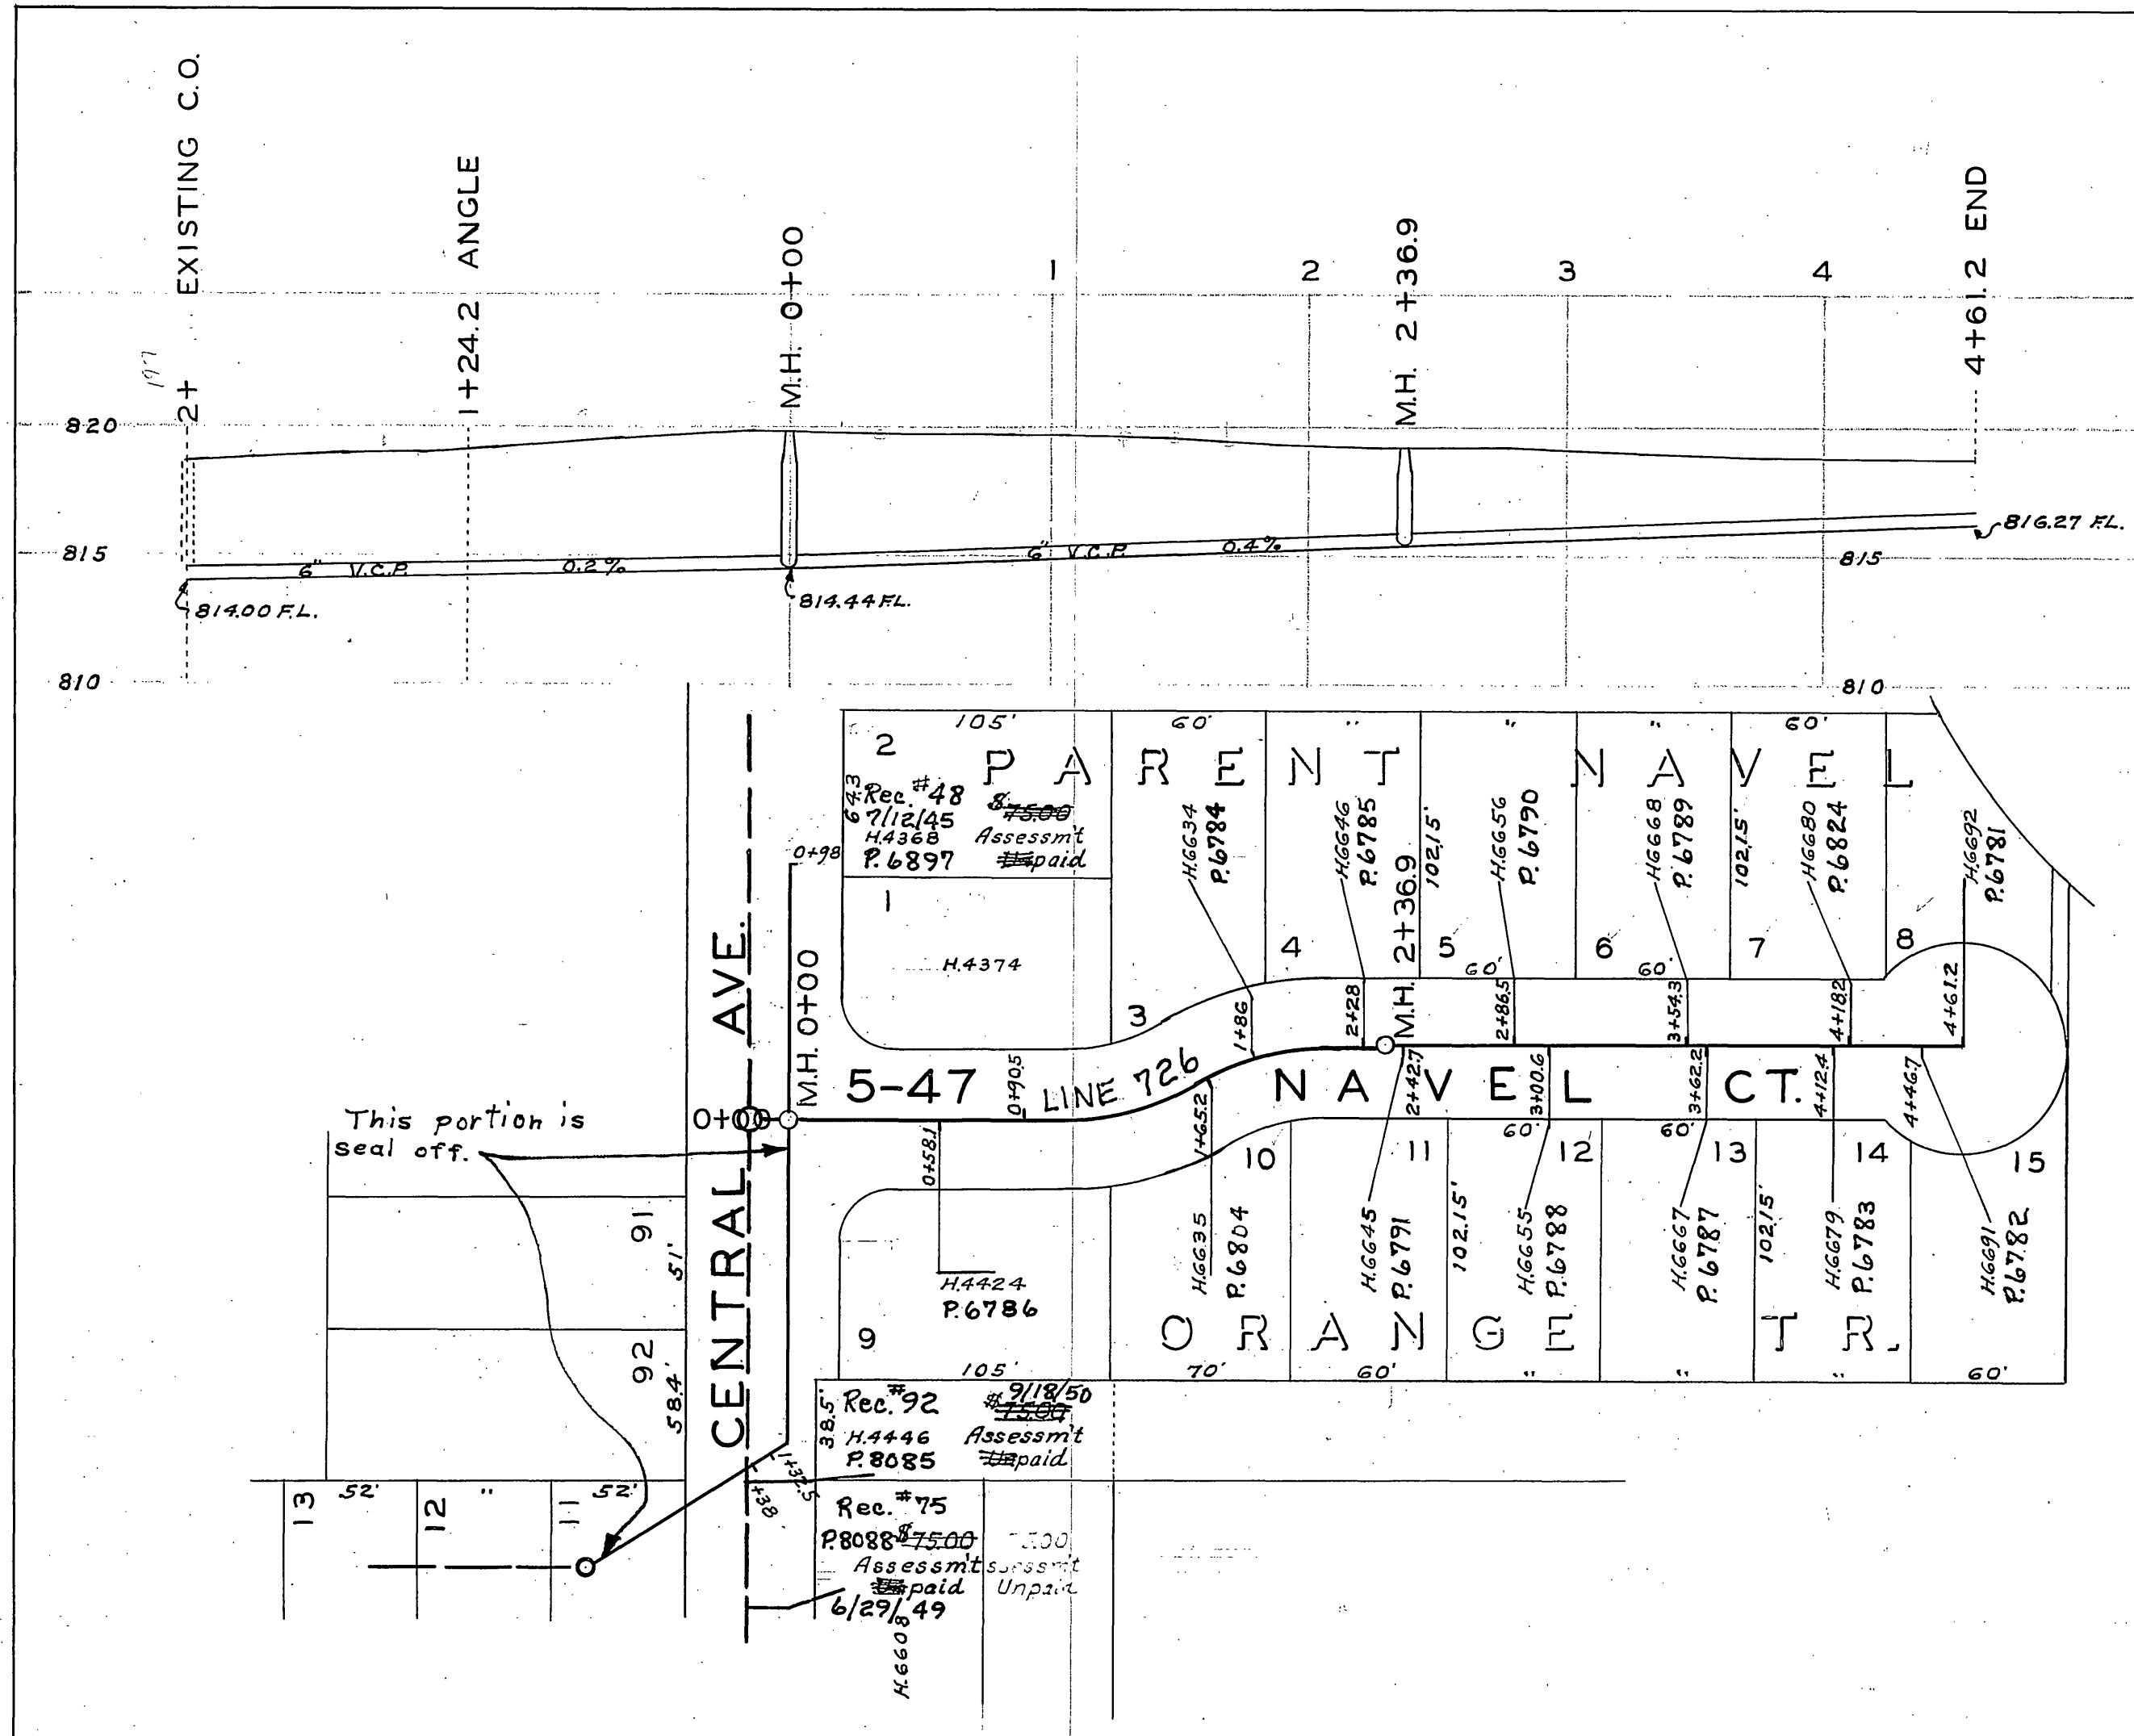

13 add