


Refs
495
665

BOOK	THREE-A	PAGE	15-A

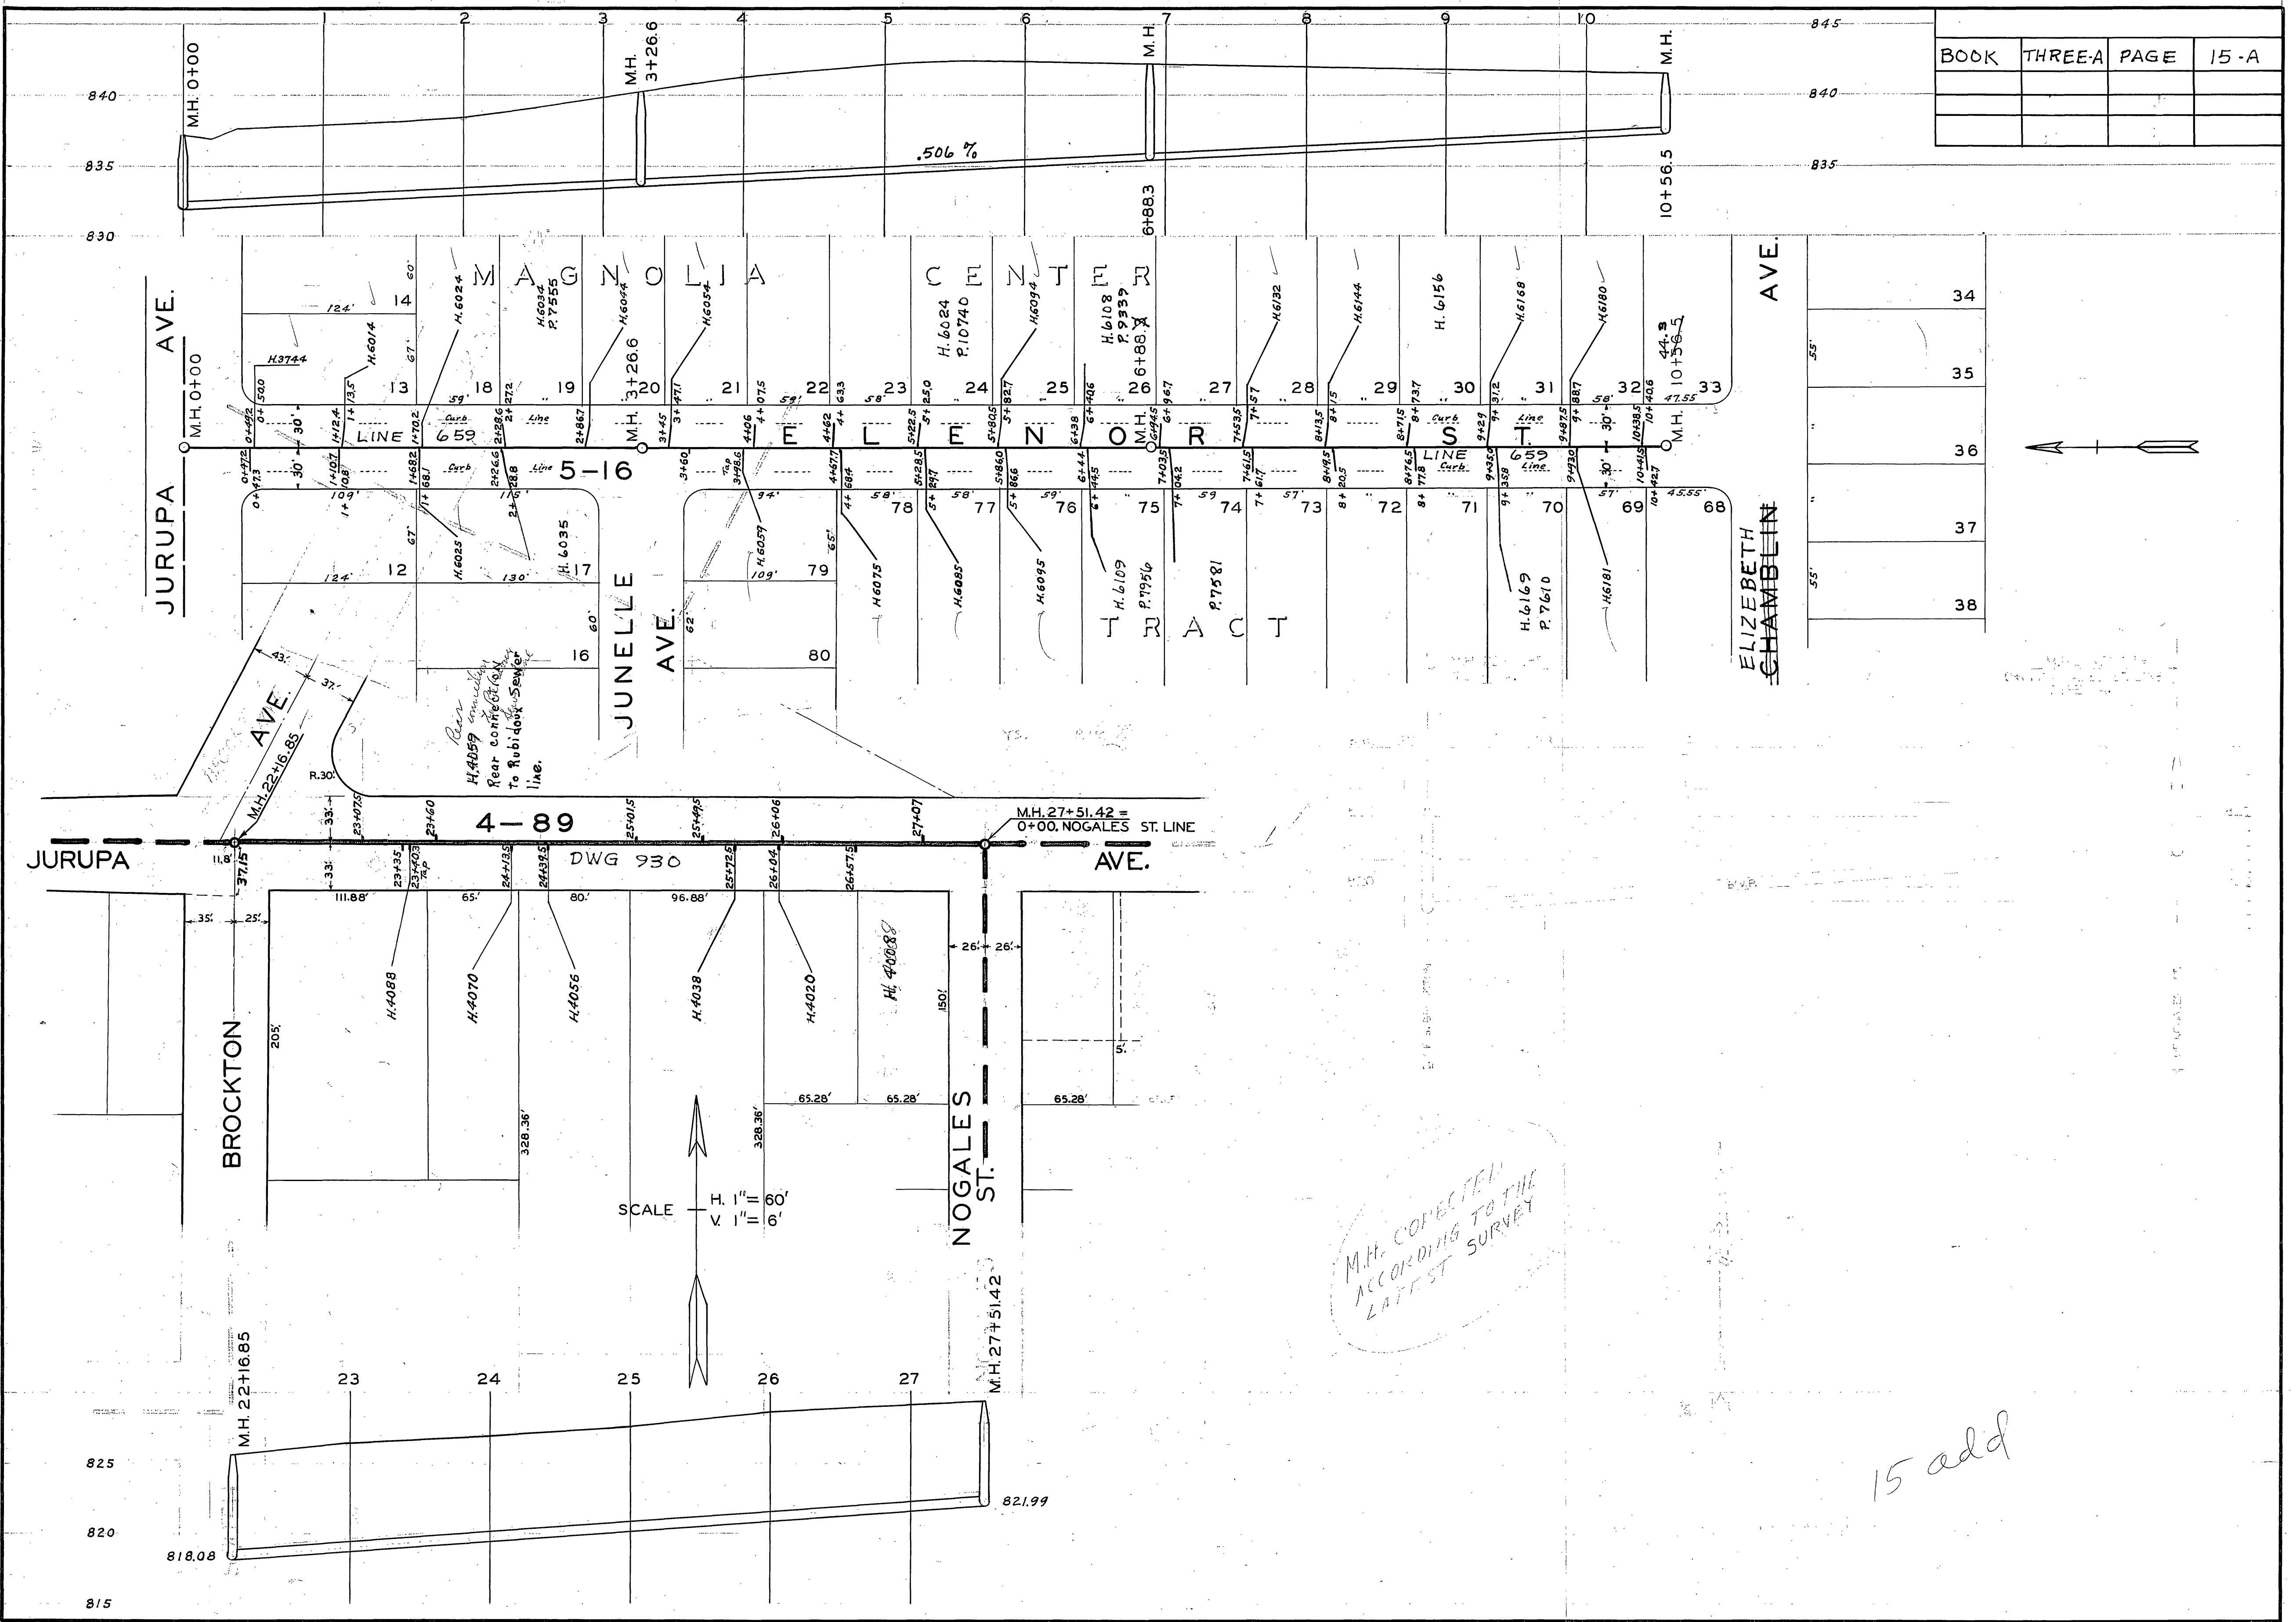

34
35
36
37
38

M.H. CORRECTED
ACCORDING TO THE
LATEST SURVEY

15 add