
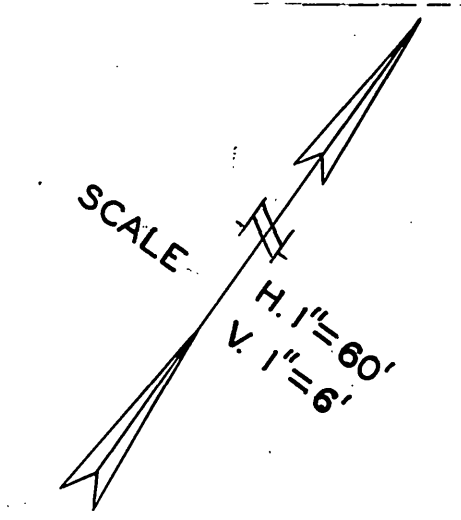
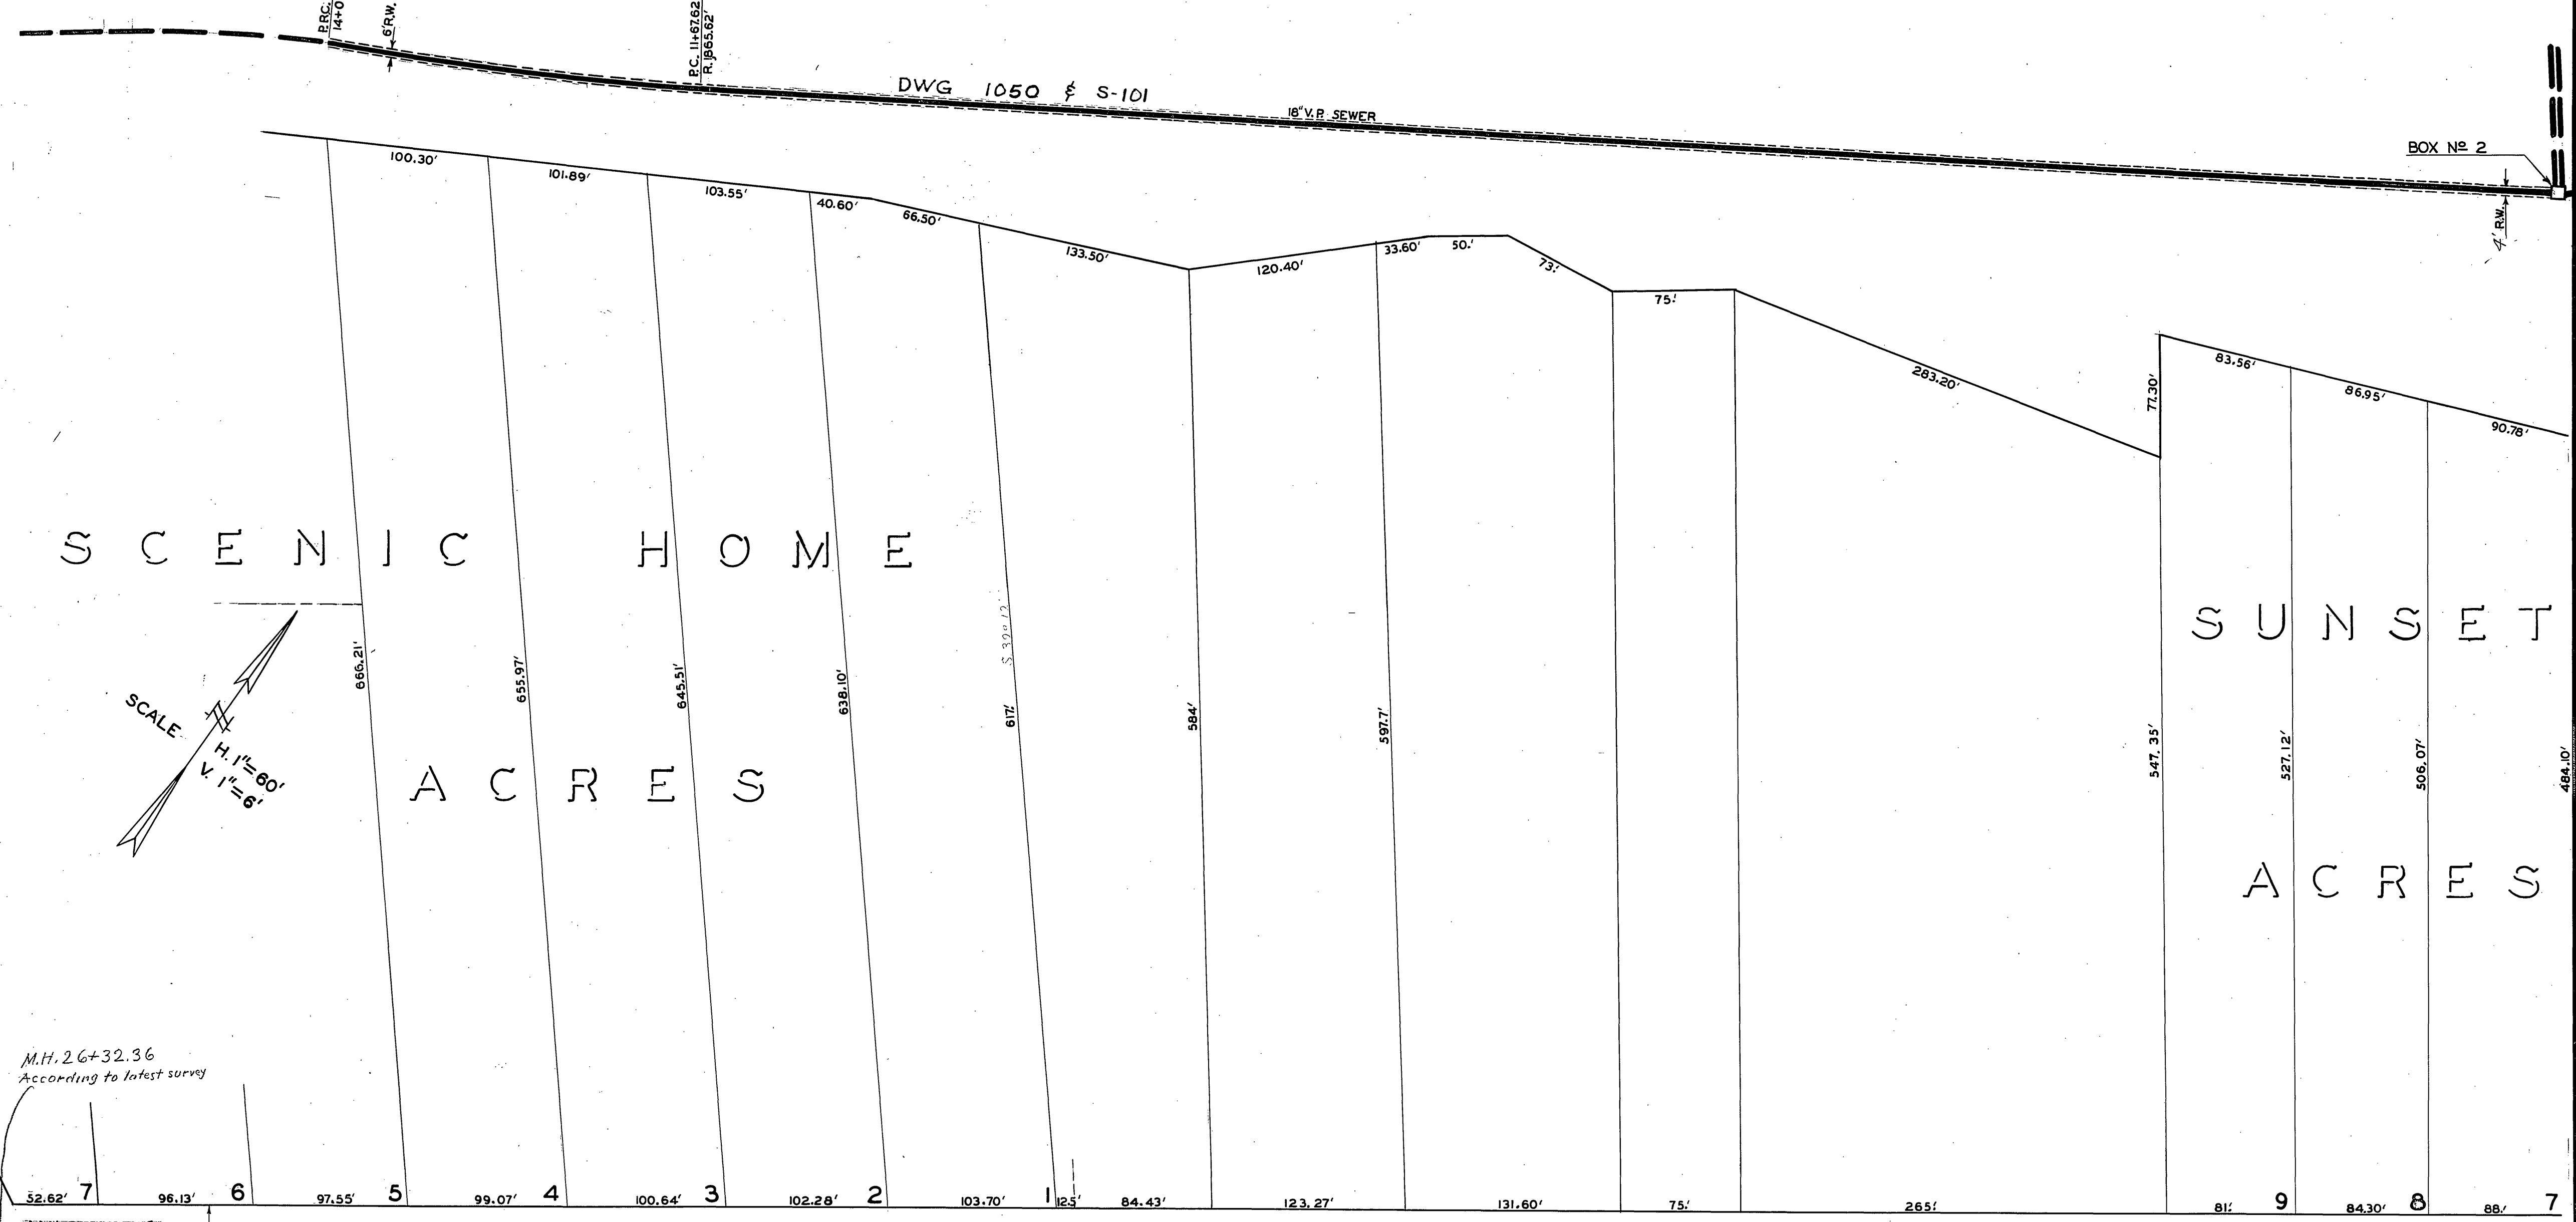


BOOK	THREE-A	PAGE	1-A

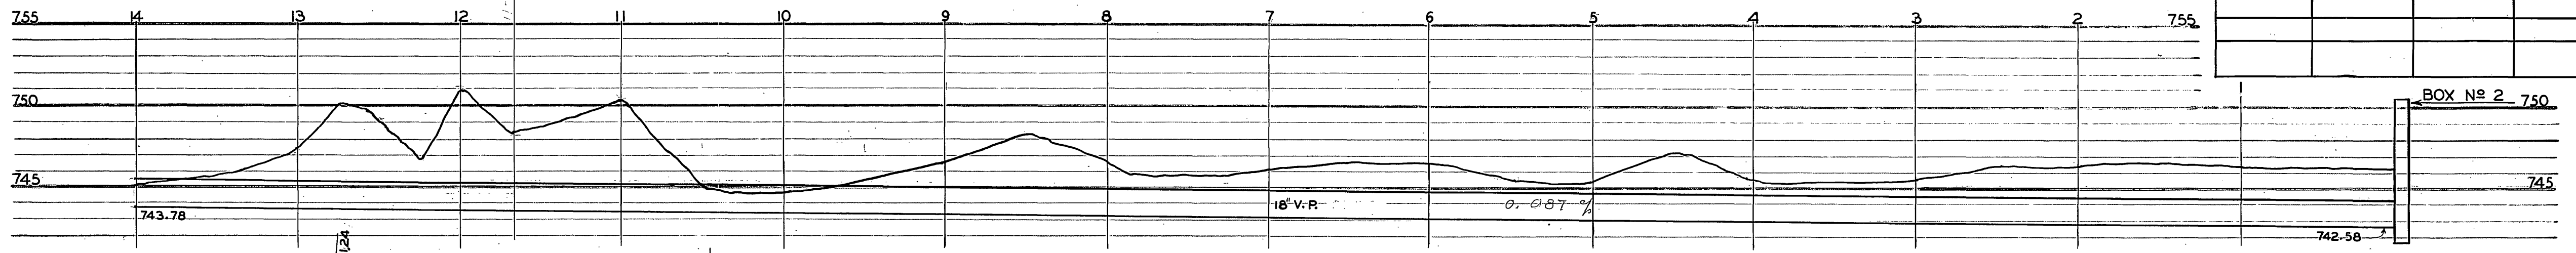

M.H. 26+32.36
According to latest survey

M.H. 26+32.36

RUBIDOUX AVE.

1 add.