


# SEWER PROFILE

SCALE— HOR. 1"=60'  
VER. 1"=6'

BOOK	THREE-A	PAGE	2-A

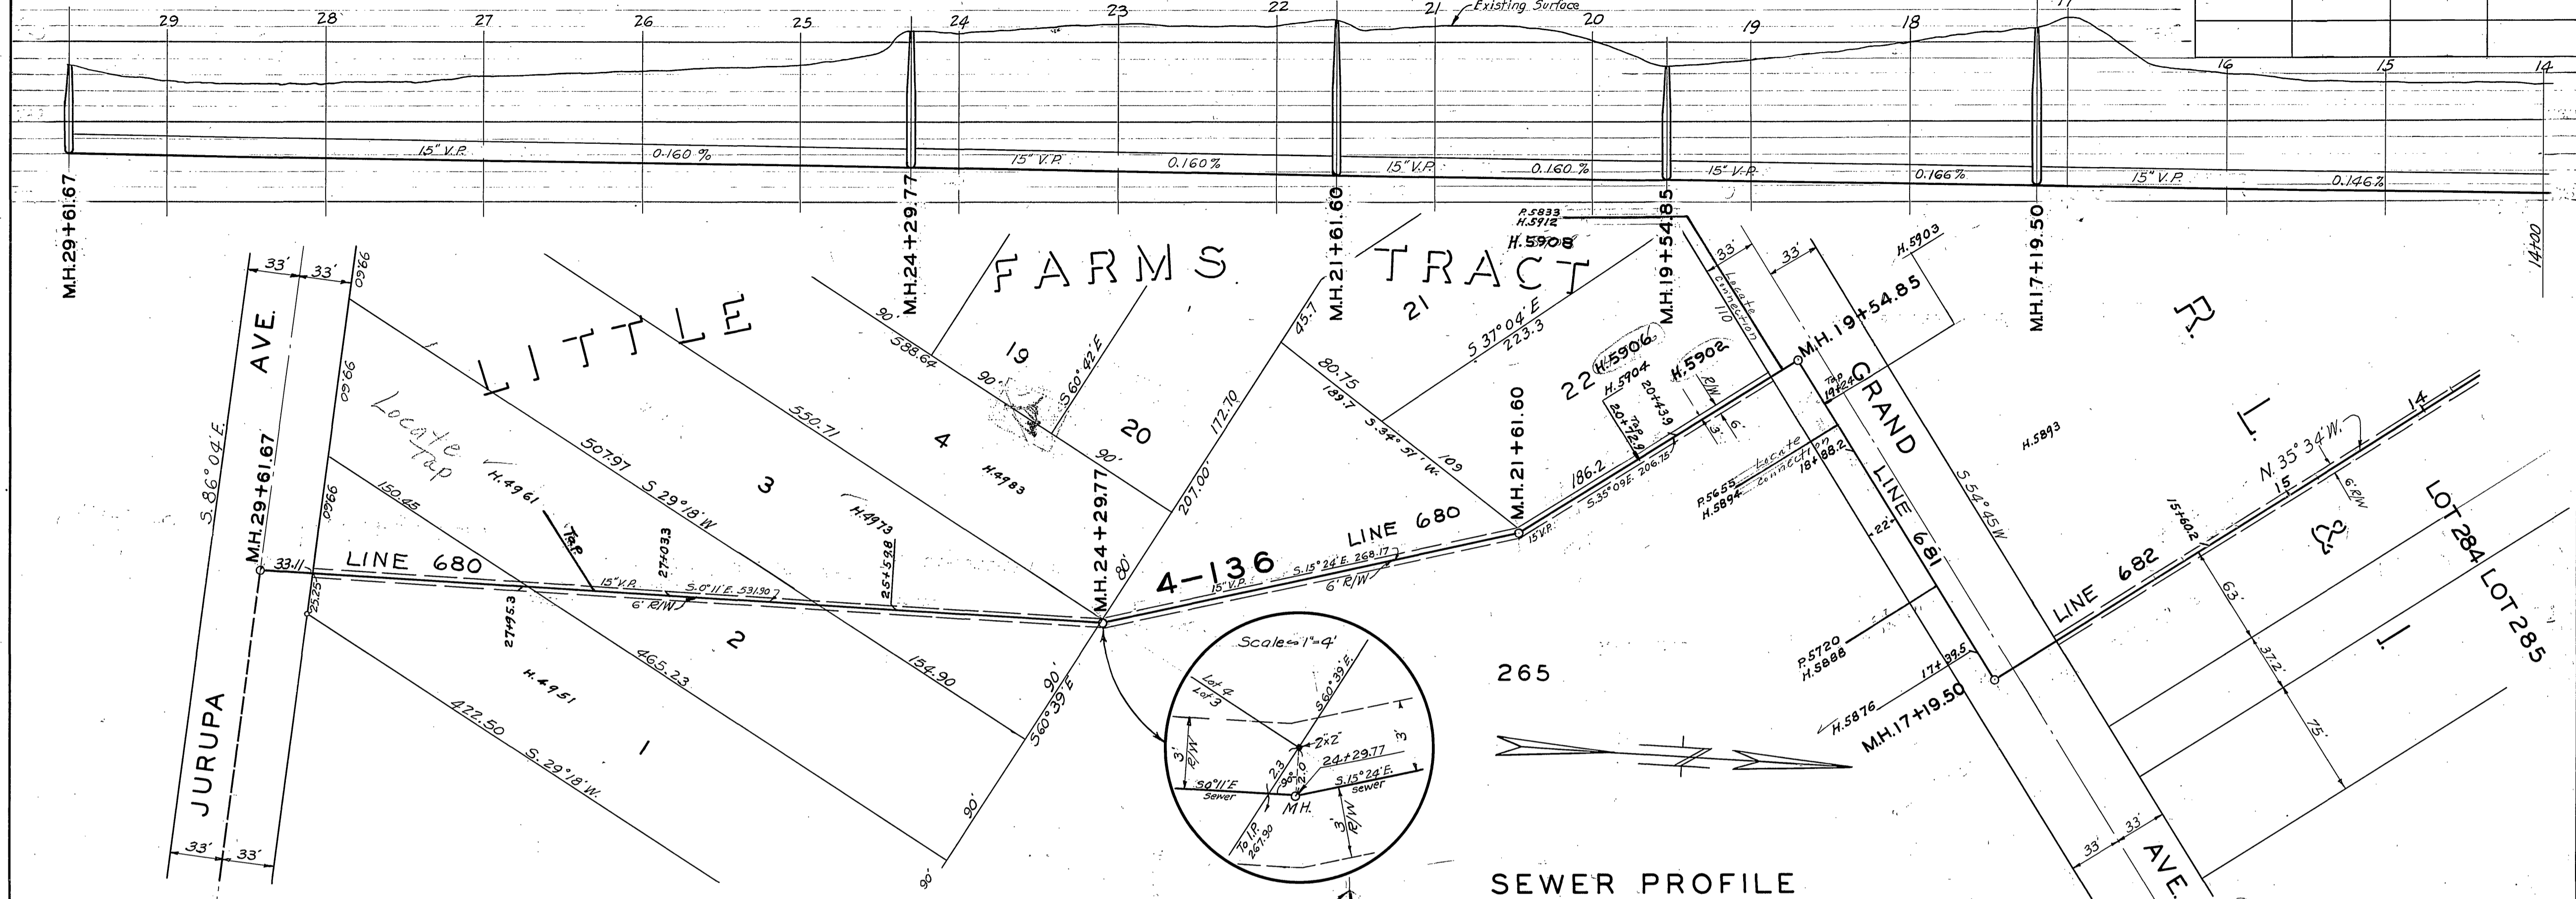

# SEWER PROFILE

SCALE— HOR. 1"=60'  
VER. 1"=6'

