


BOOK	THREE-A	PAGE	3-A


SEWER PROFILE

SCALE— HOR. 1"=60'
VER. 1"=6'

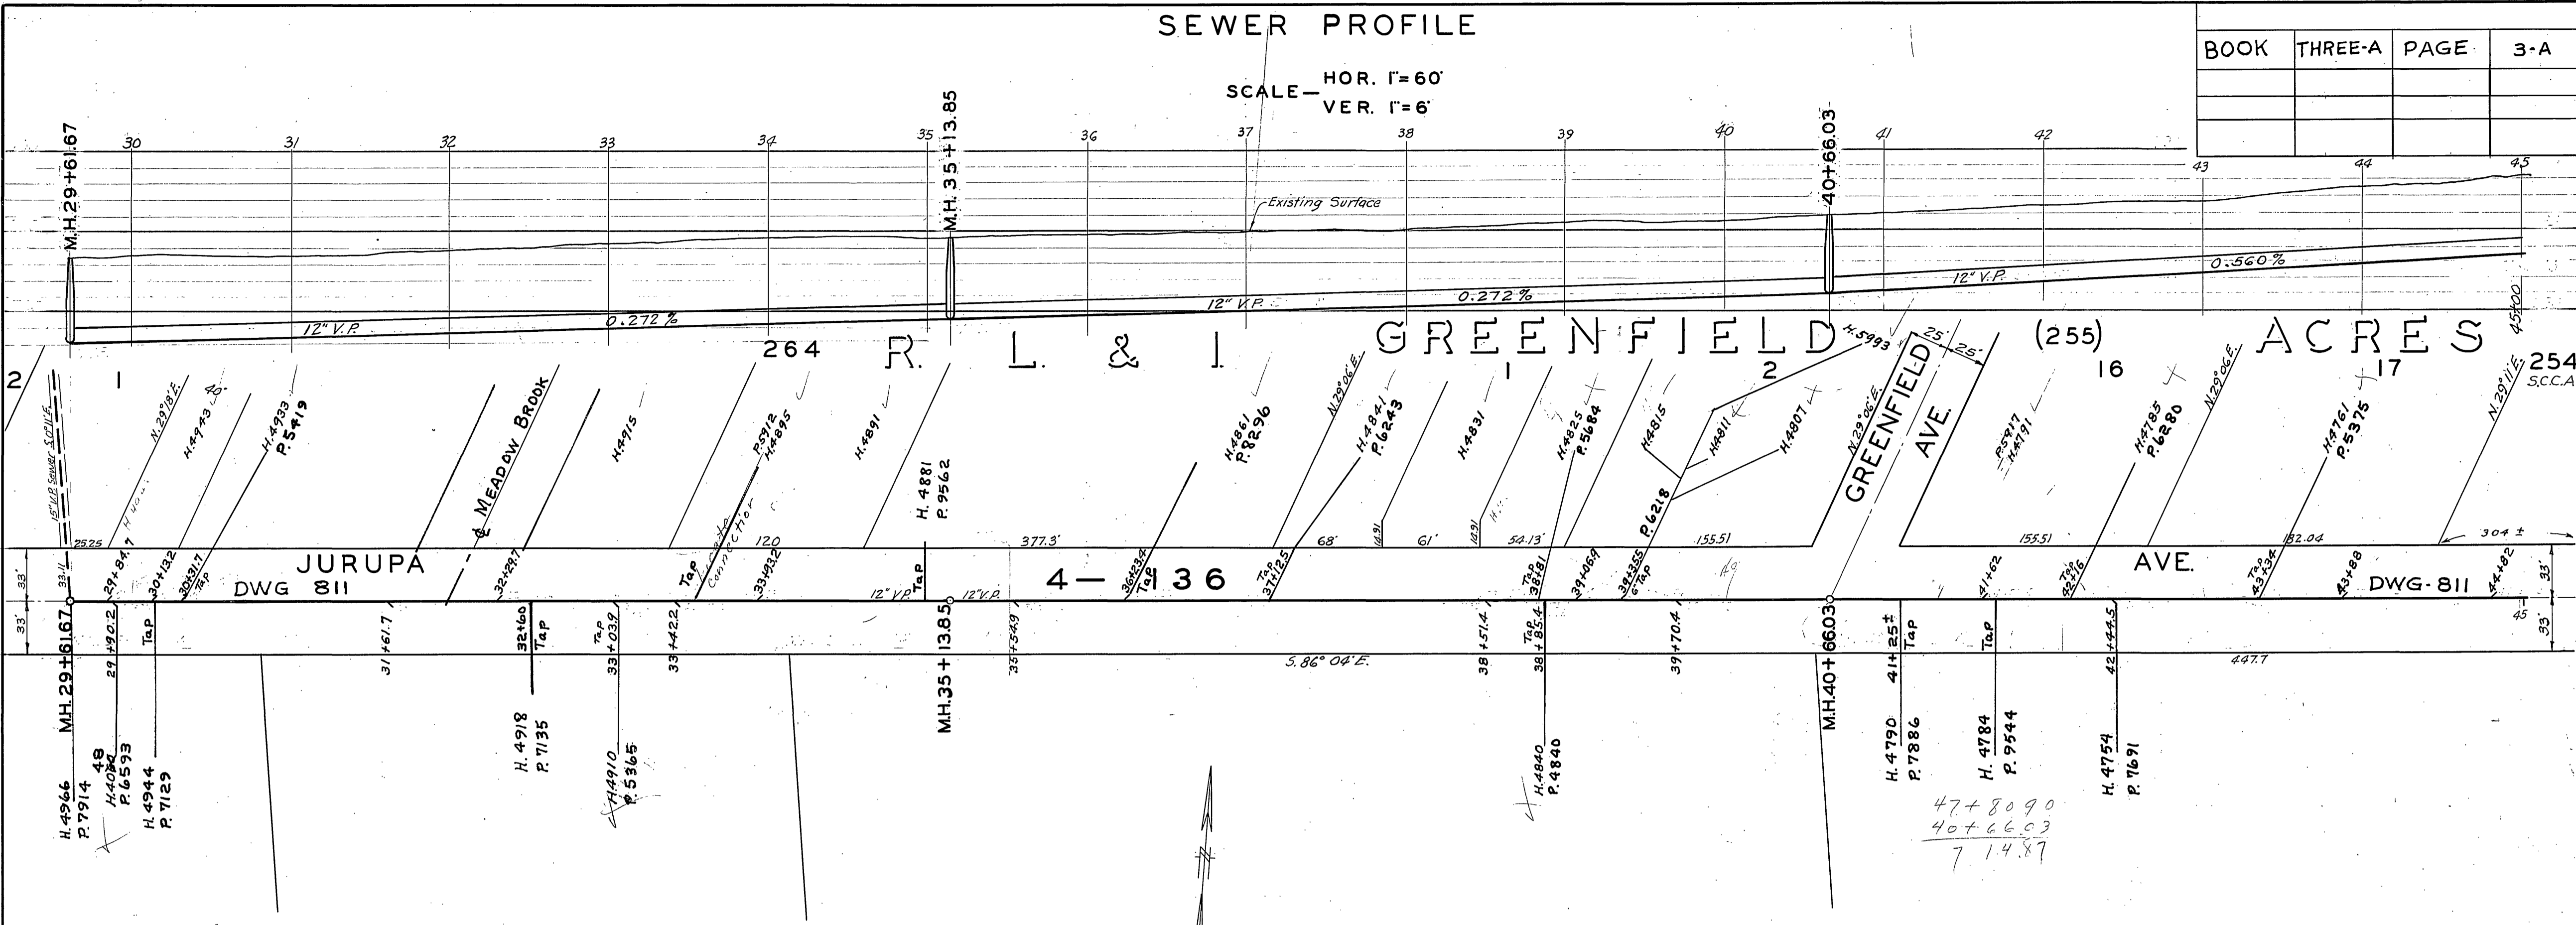

SEWER PROFILE

SCALE— HOR. 1"=60'
VER. 1"=6'

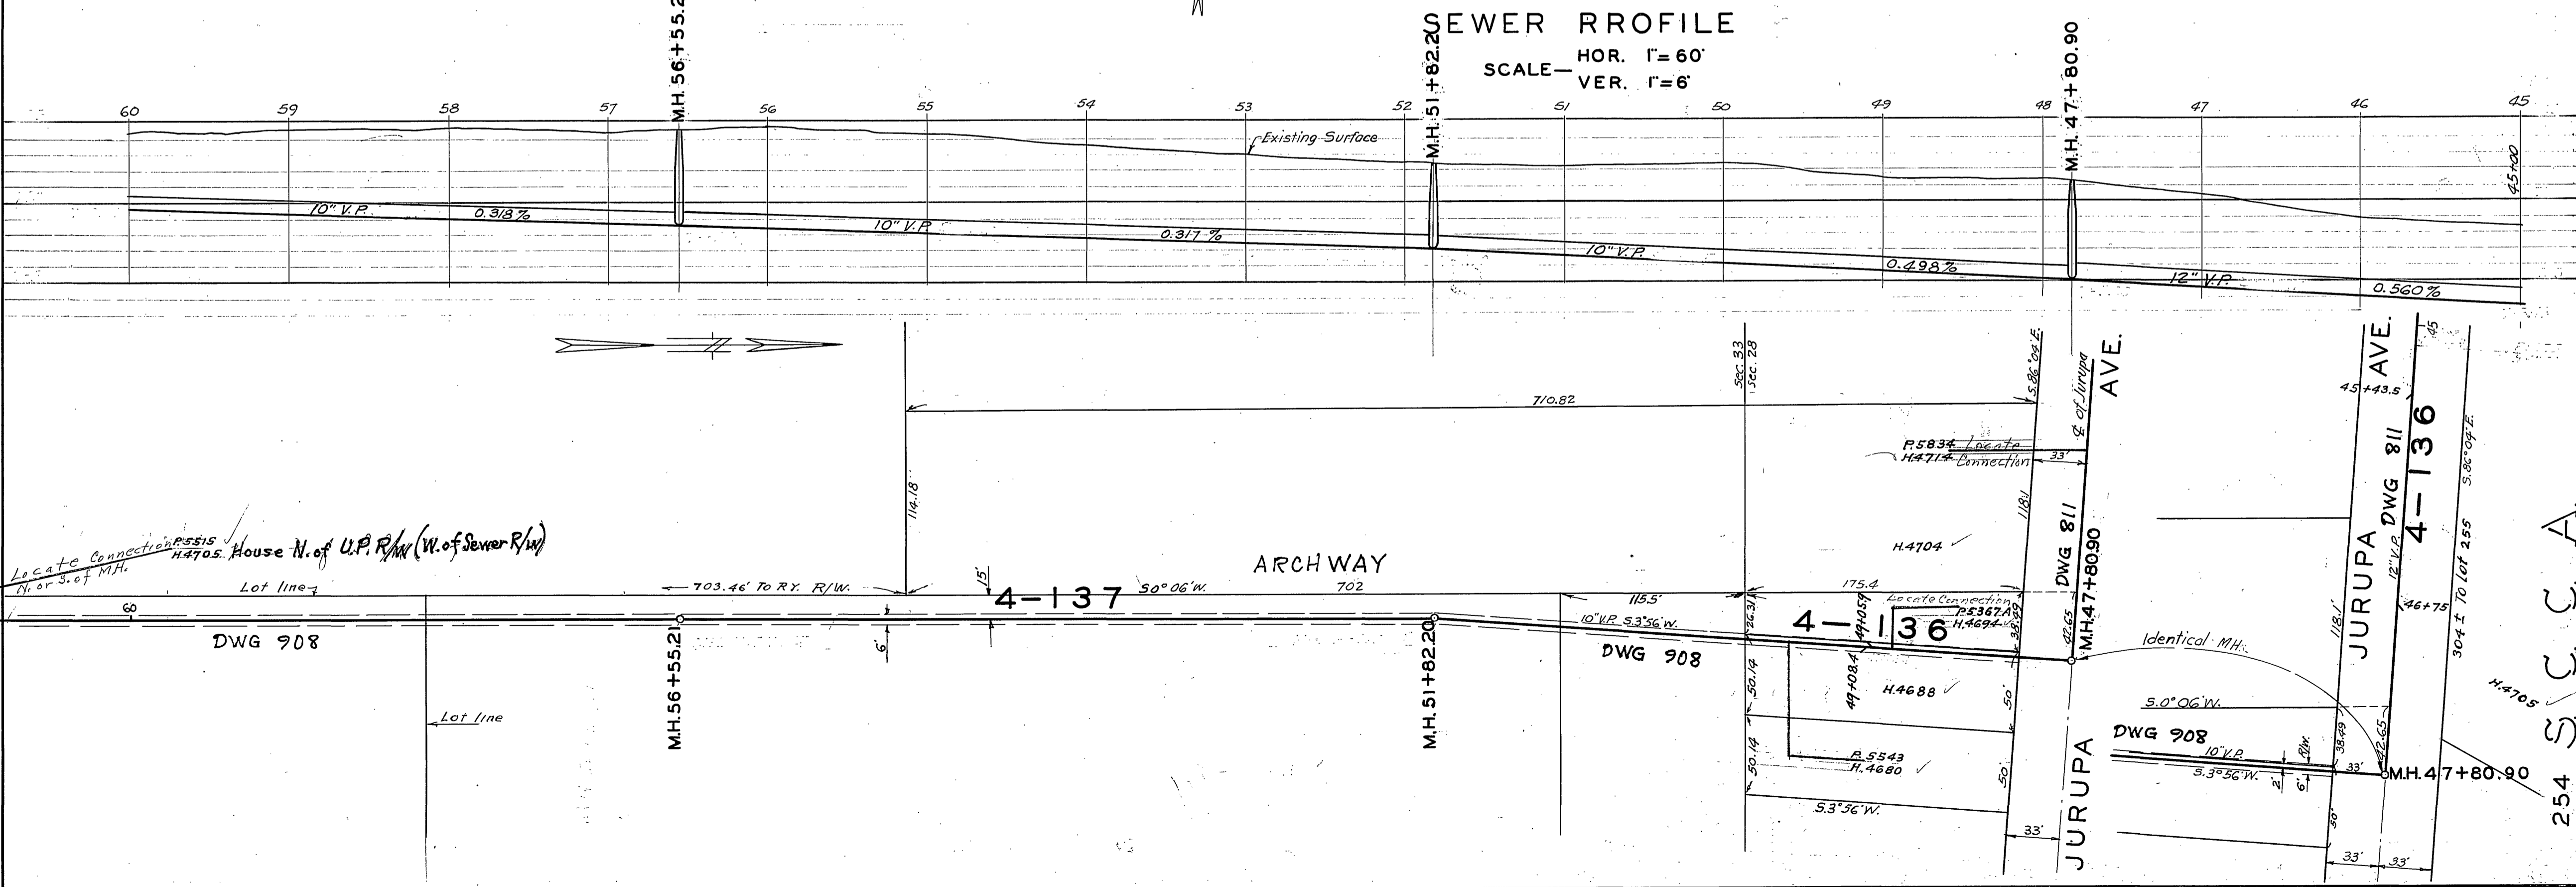

Print made