
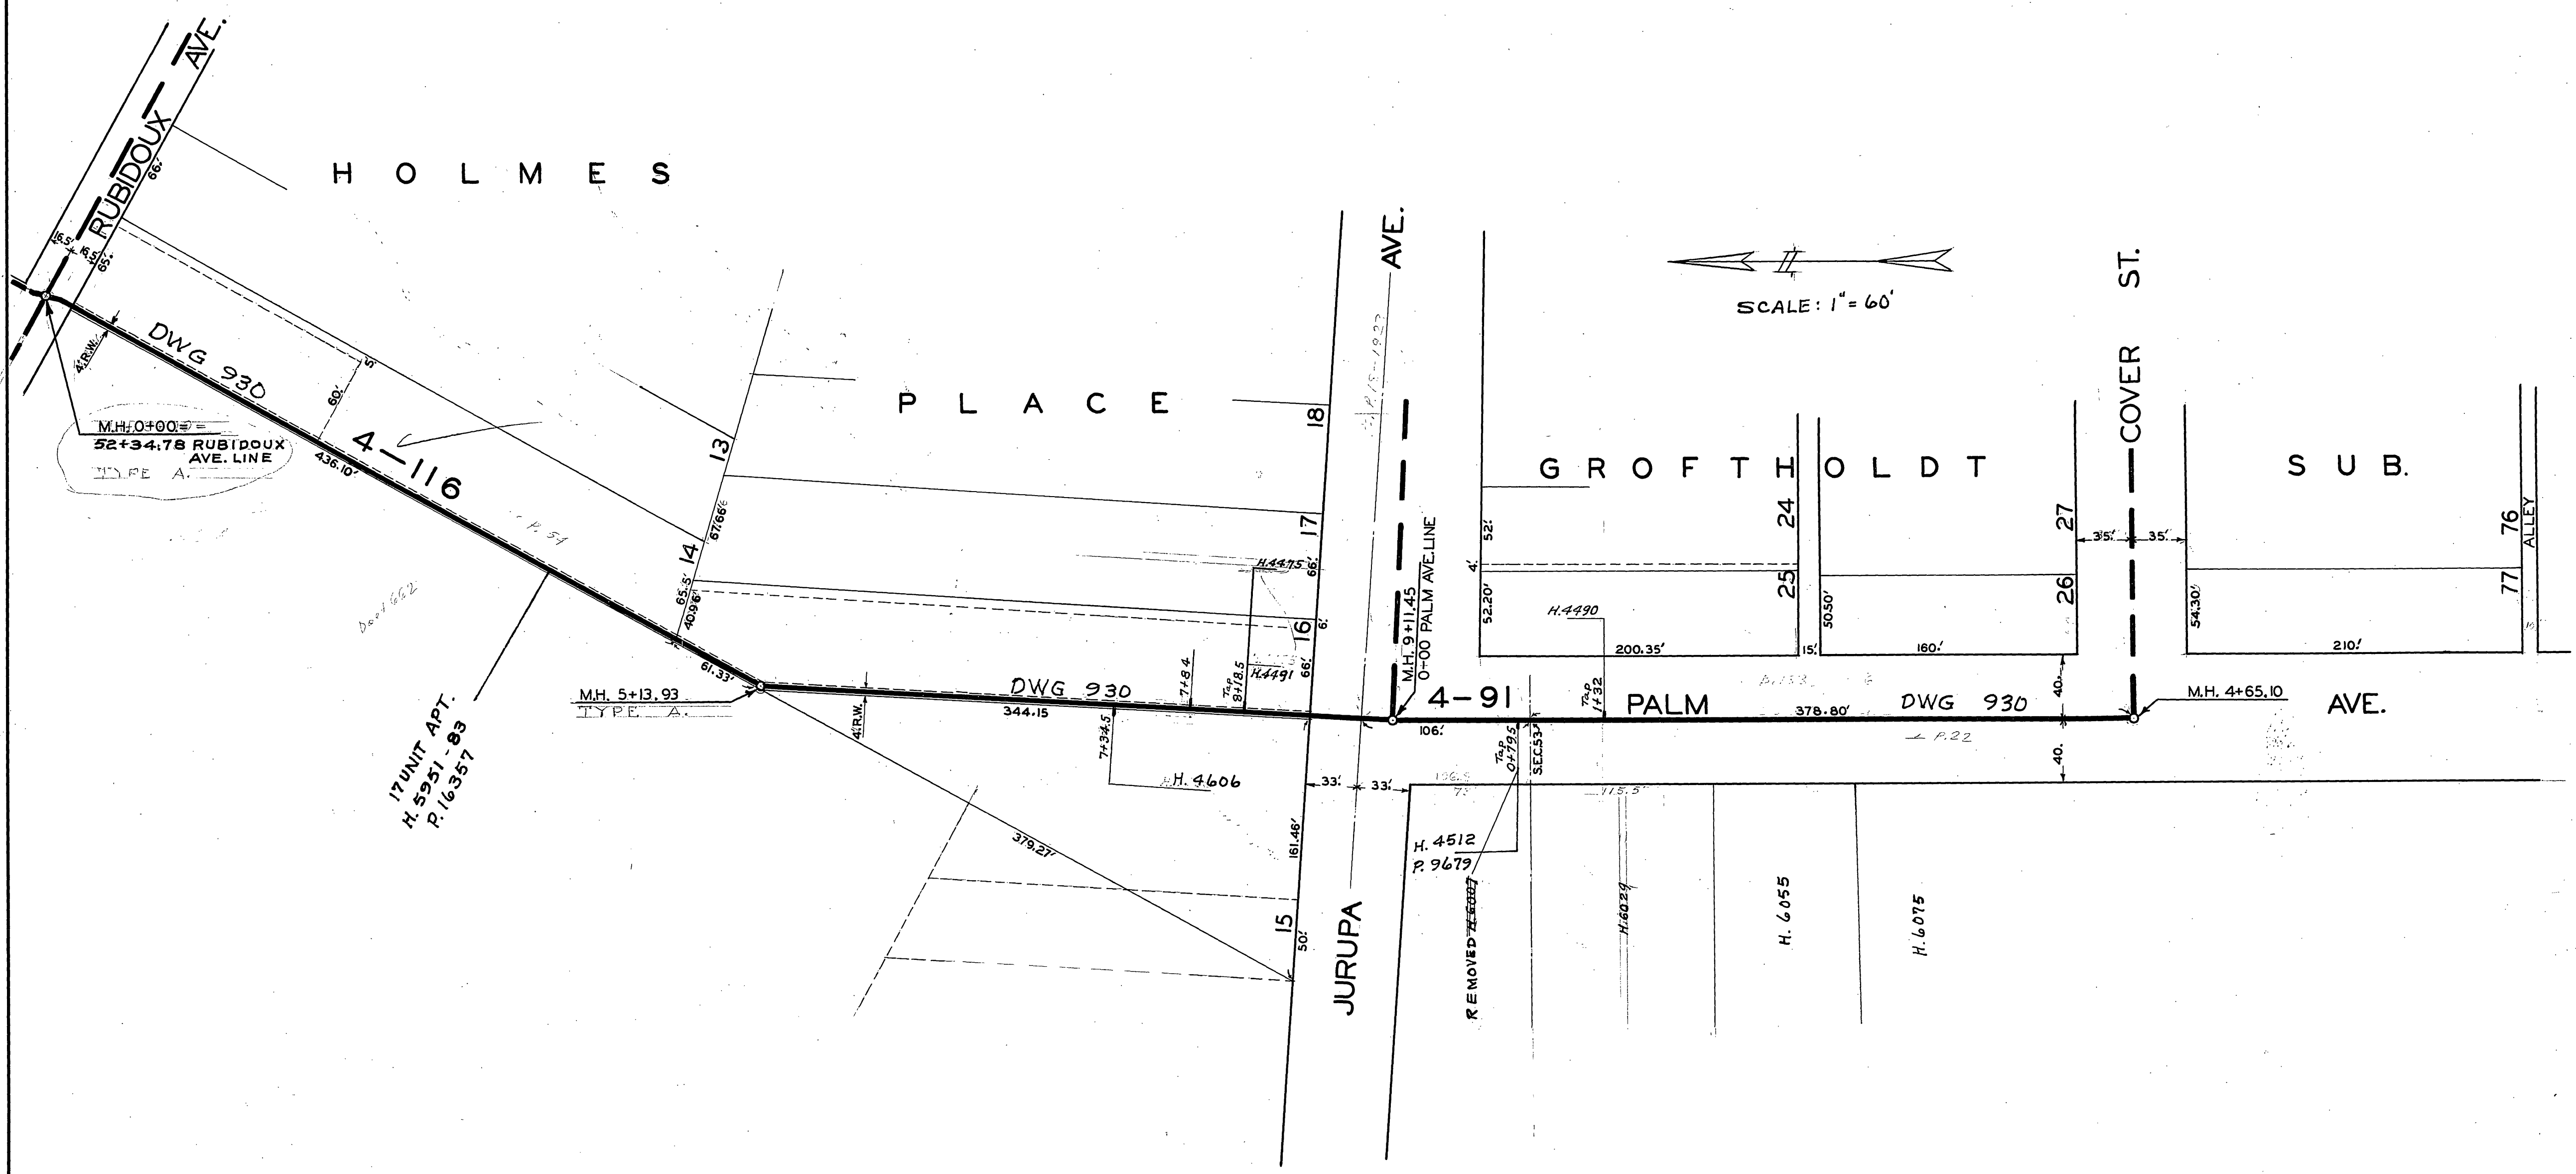


BOOK	THREE-A	PAGE	4-A

Levels B, 153 P. 26

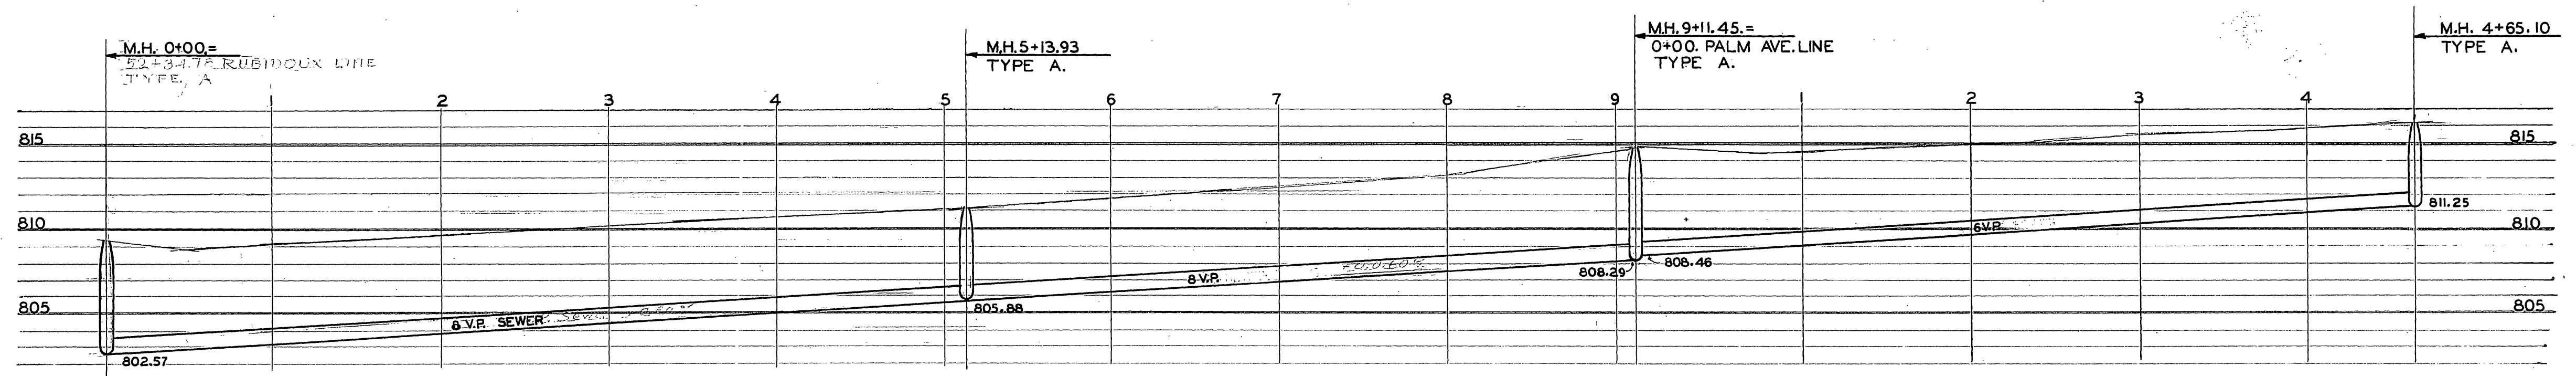

YS P. 54
" P. 22

Done 6/22

17 UNIT APT.
H. 5951-83
P. 16357