


13378
66
50
24978
64738
611230
246

BOOK	THREE-A	PAGE	9A
------	---------	------	----

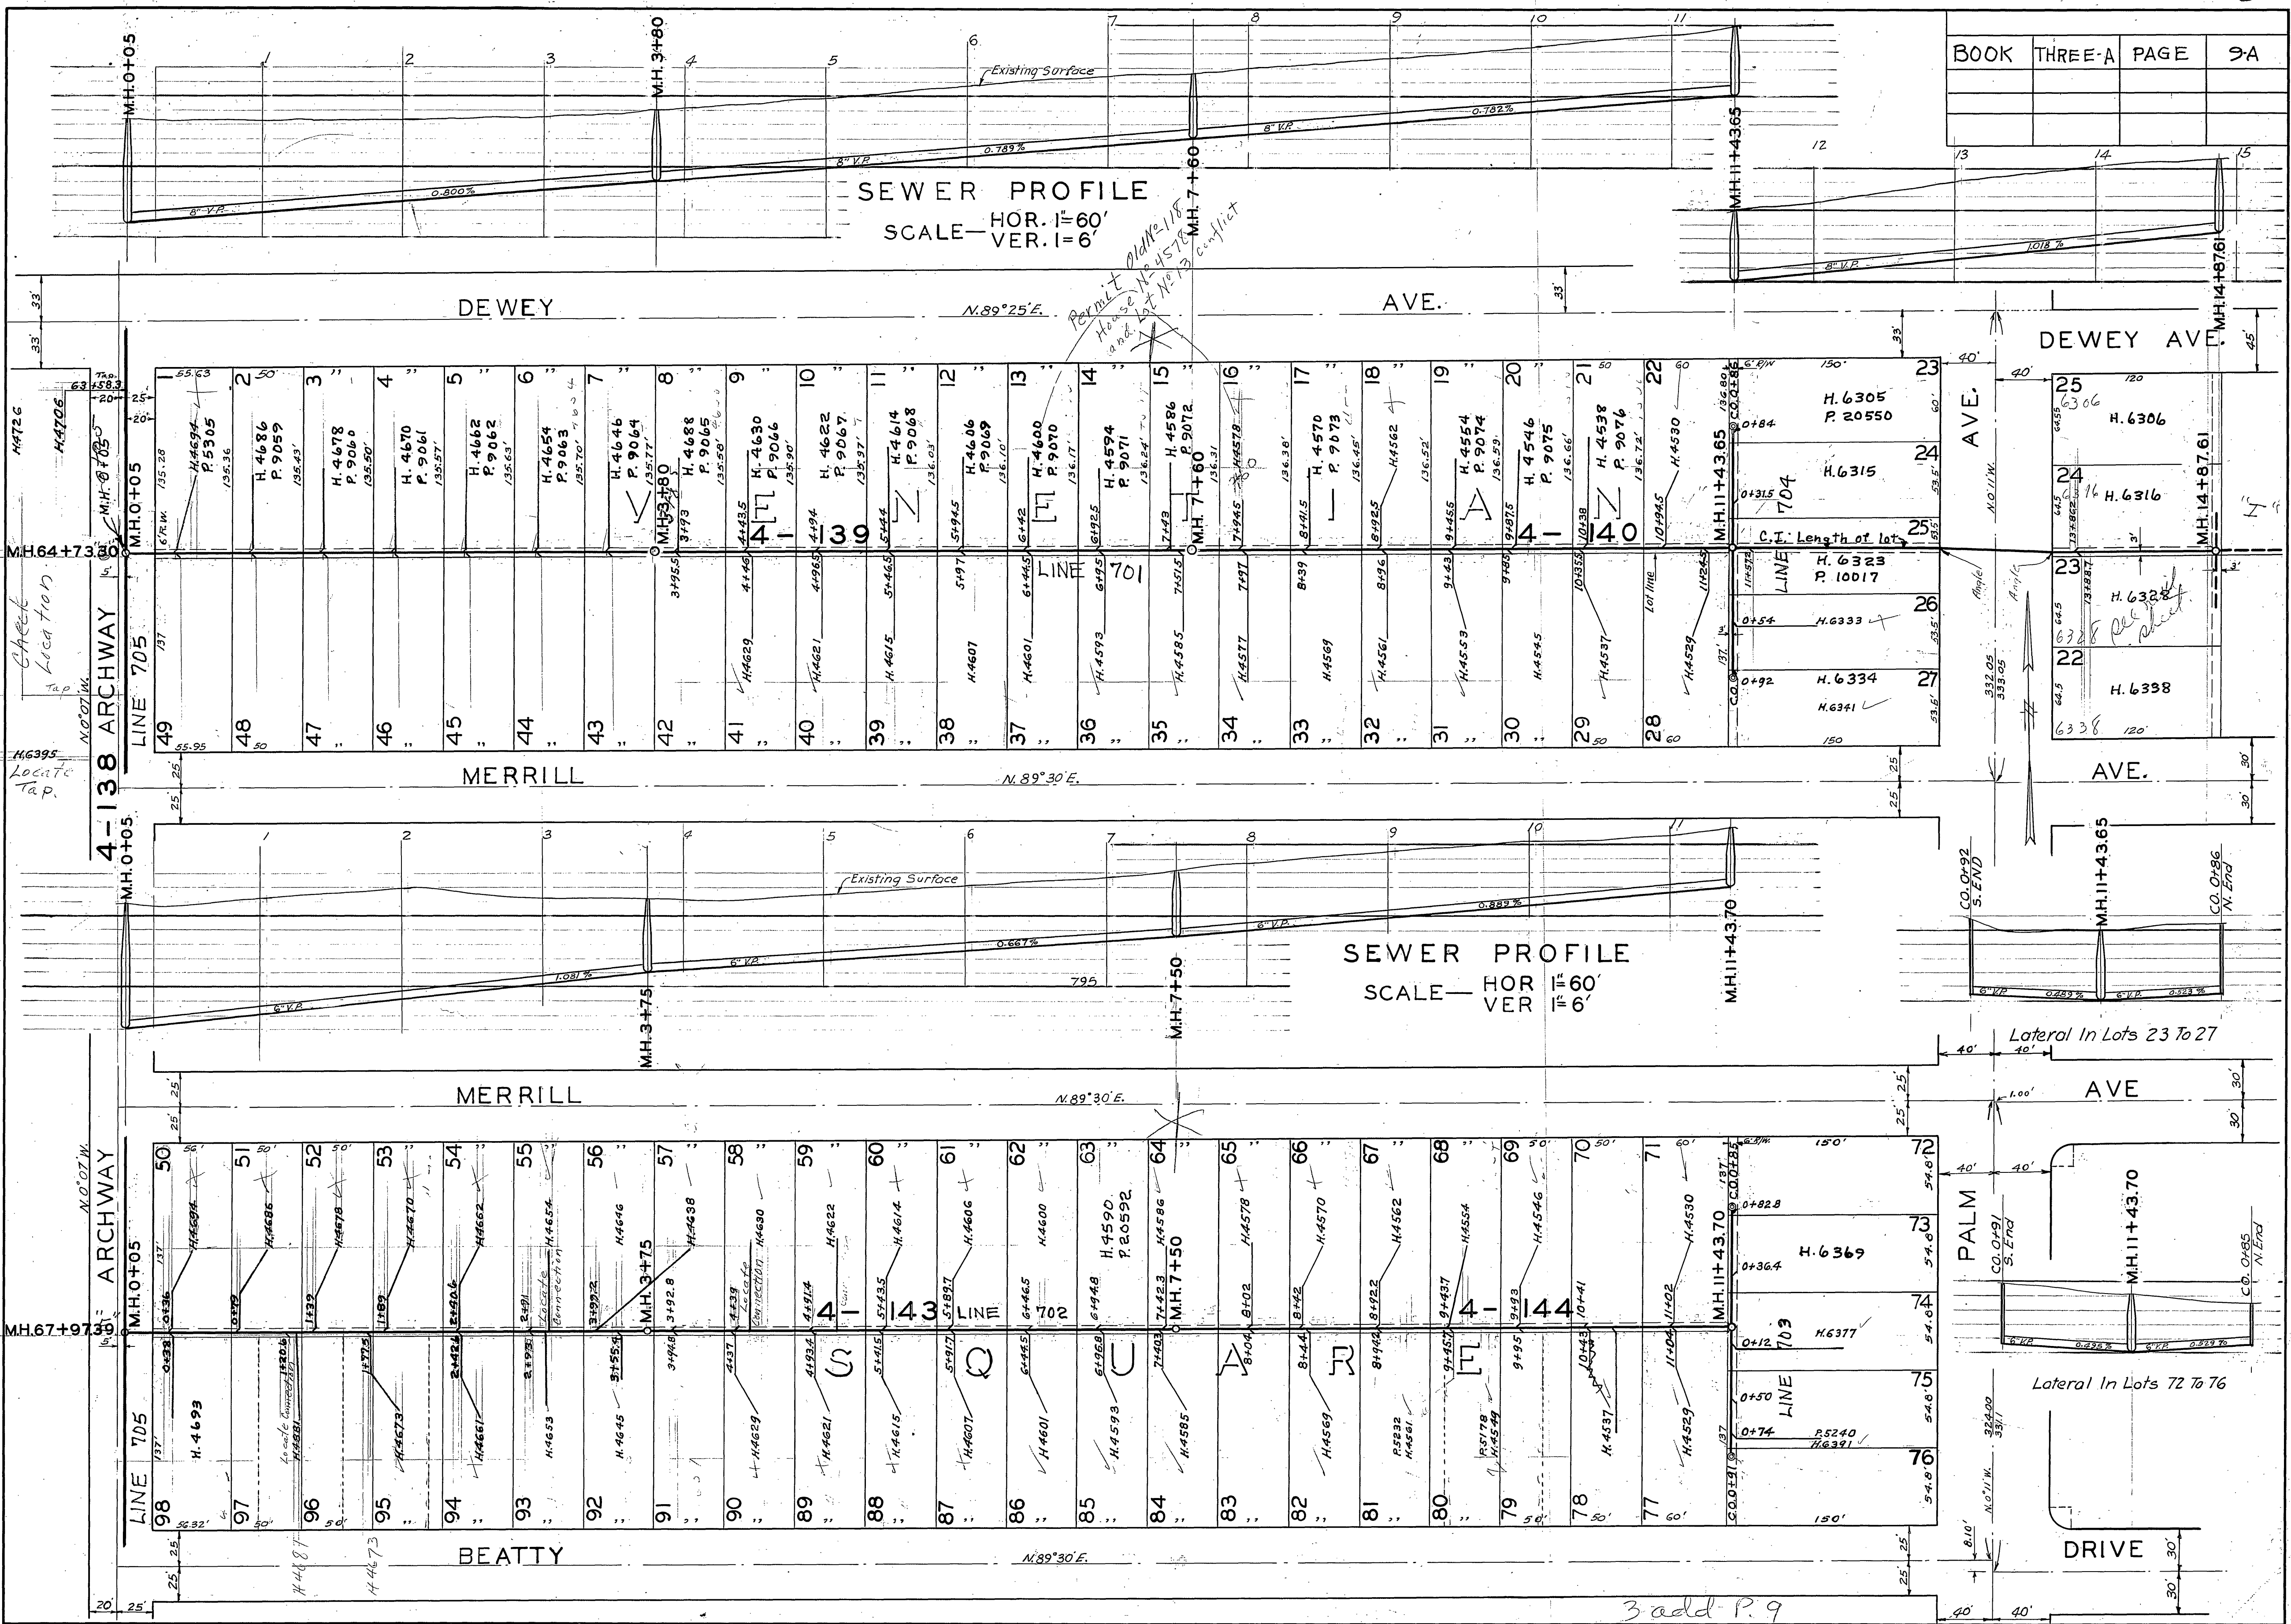

SEWER PROFILE
SCALE - HOR. 1"=60'
VER. 1"=6'

SEWER PROFILE
SCALE - HOR. 1"=60'
VER. 1"=6'

G-H

E-F

Permit Old No. 118
House No. 4578
a road lot No. 13 conflict

Check Location
Tap
Locate Tap

4-138 ARCHWAY
LINE 705
M.H. 0+05

ARCHWAY
LINE 705
M.H. 0+05

BEATTY

DEWEY

MERRILL

MERRILL

BEATTY

AVE.

DEWEY AVE

AVE.

AVE

DRIVE

3 add P. 9