
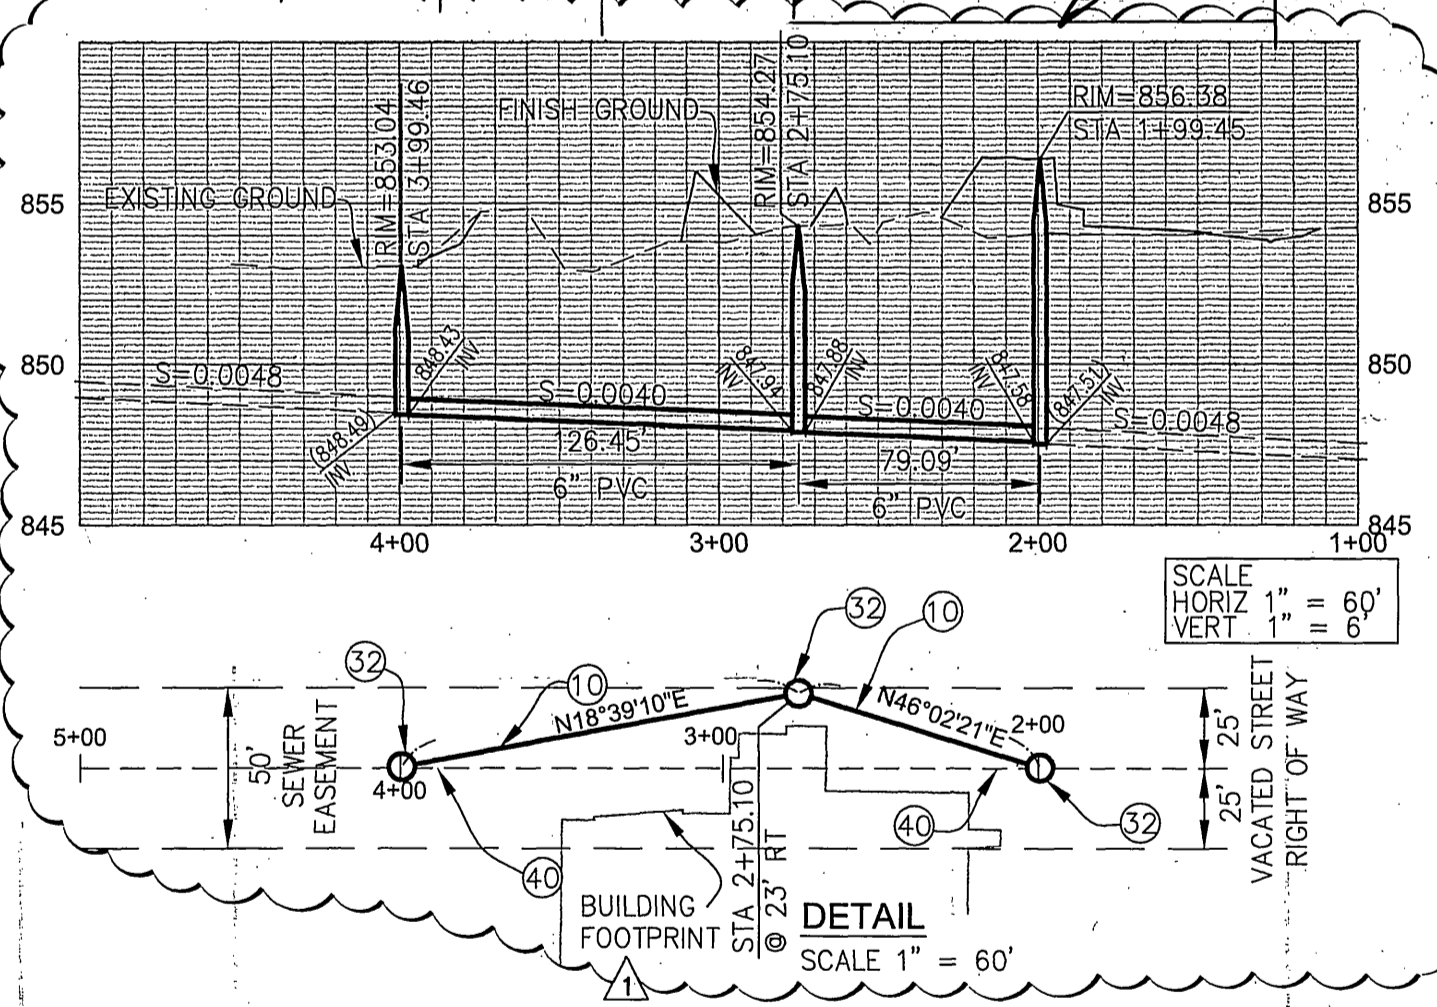


BOOK	THREE	PAGE	2
Δ			
R/S			
1-31-06			

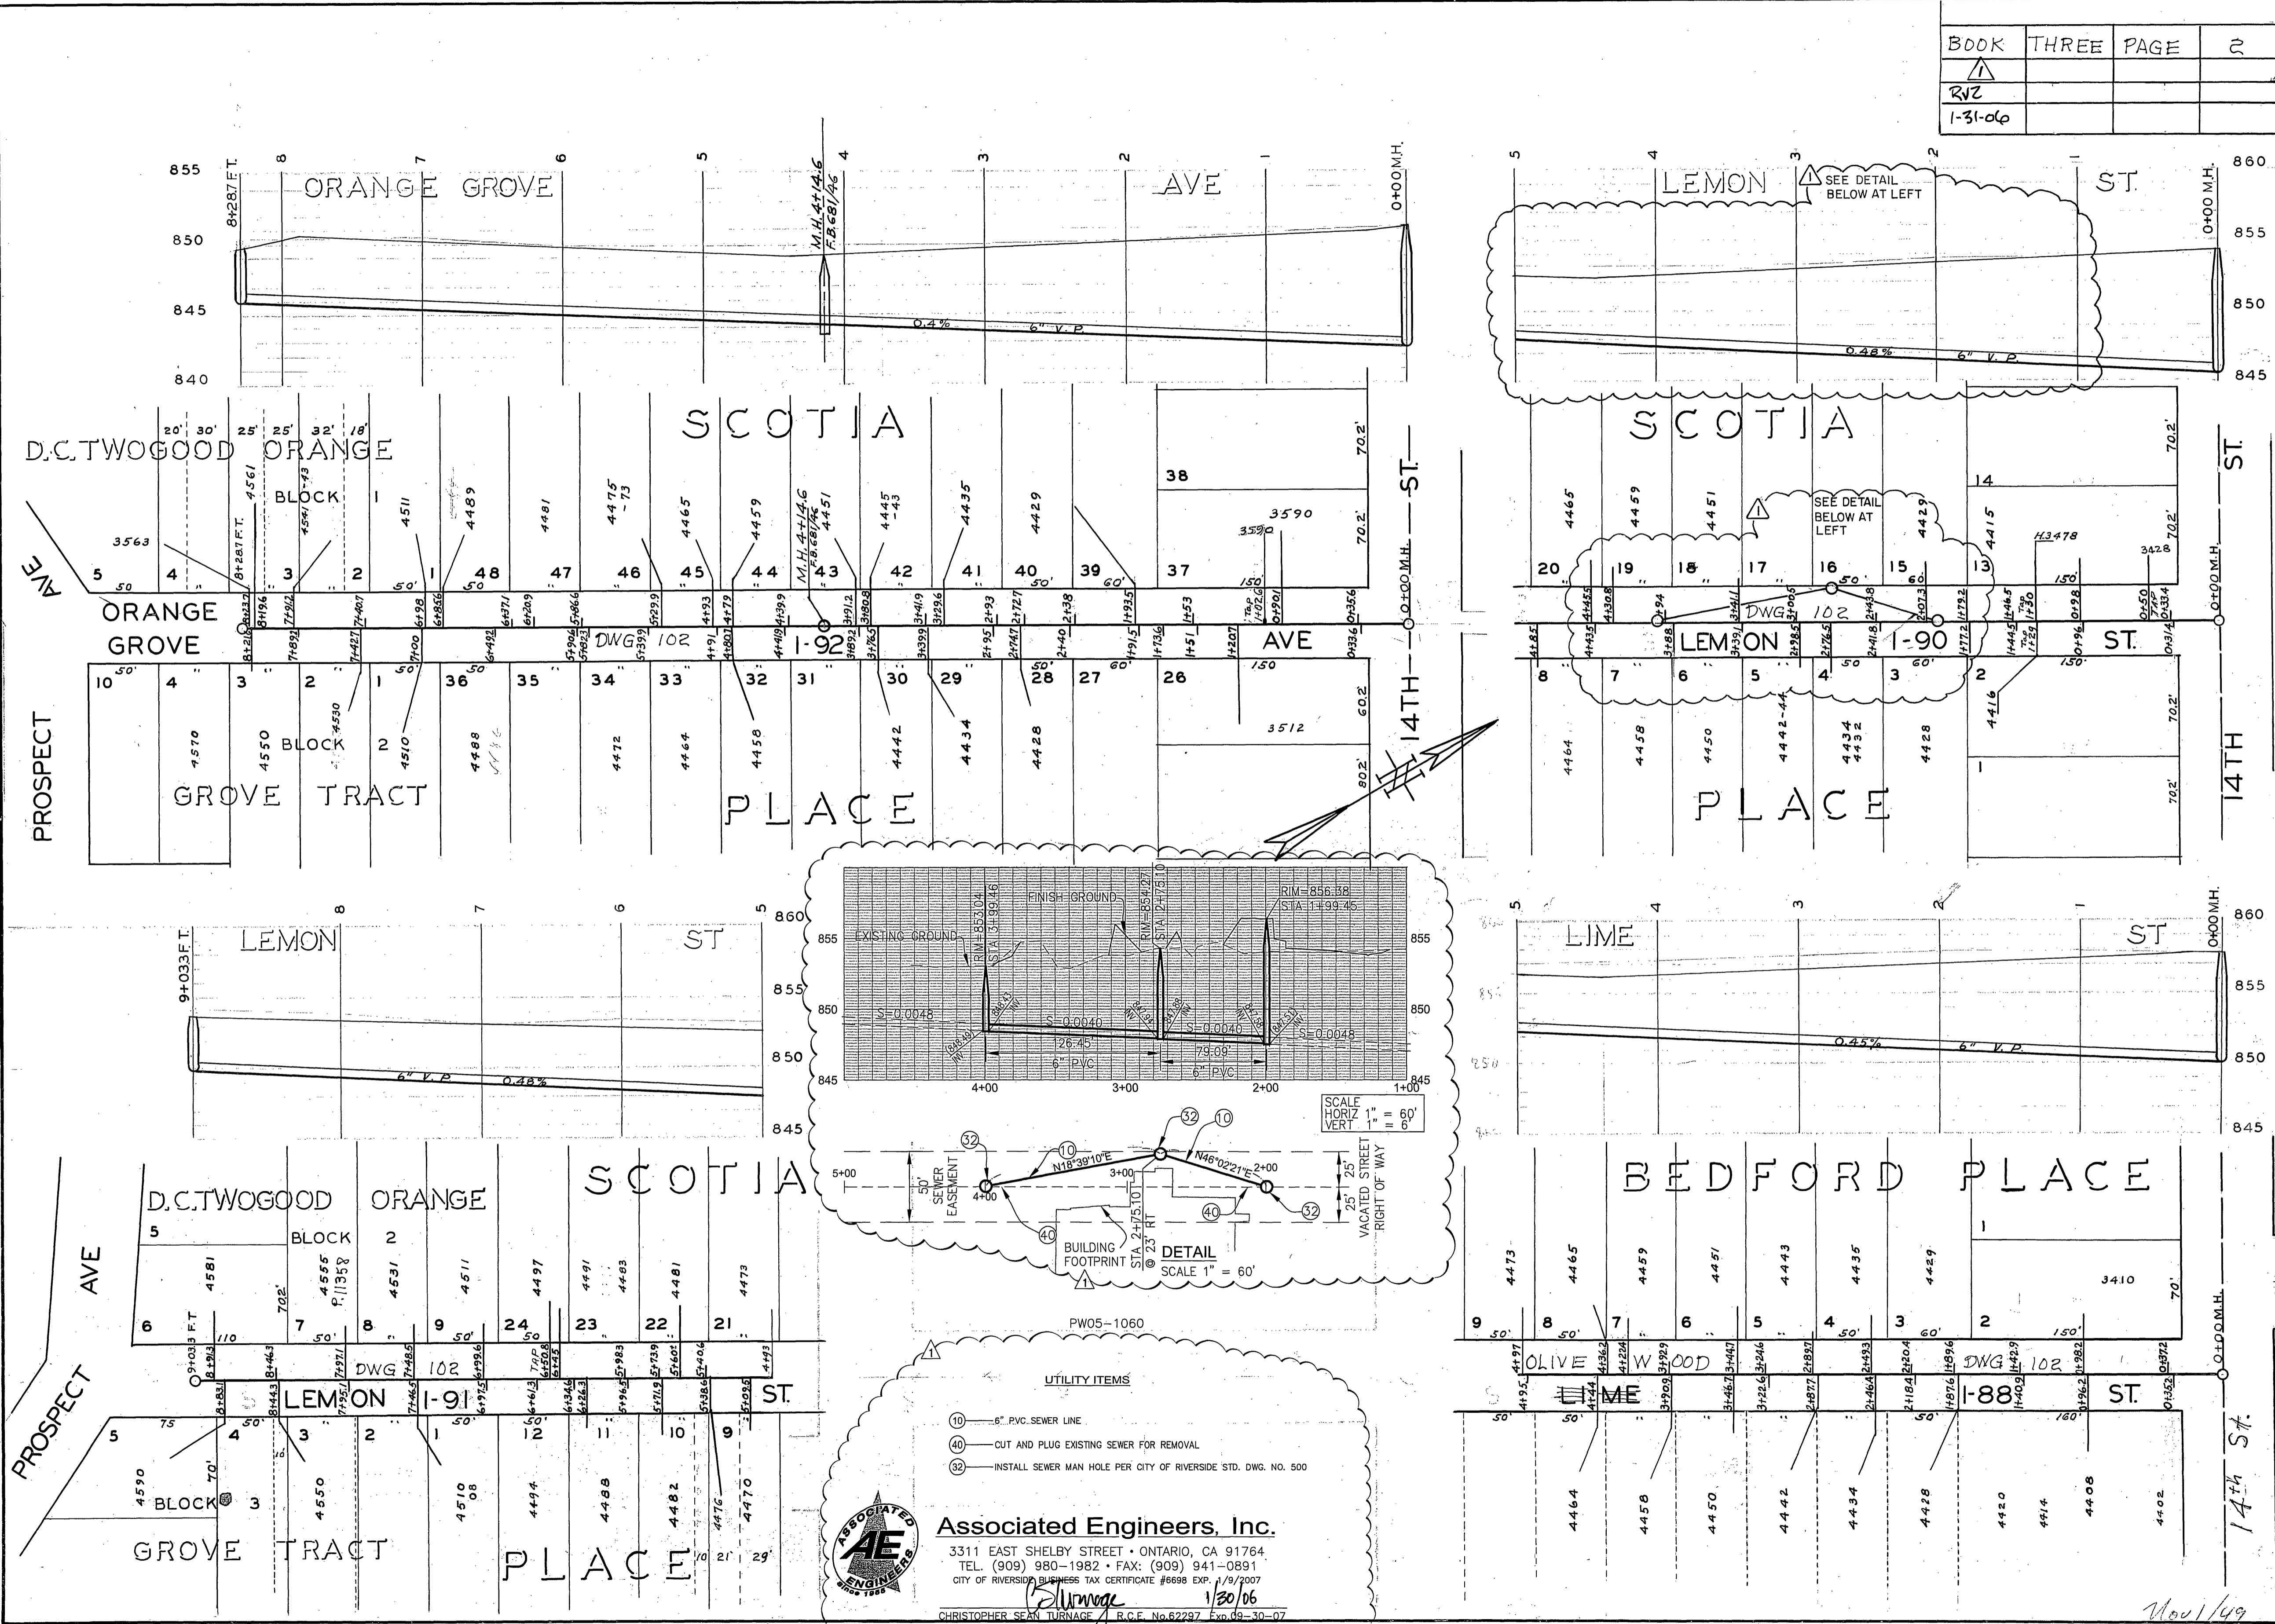

UTILITY ITEMS

- (10) 6" PVC SEWER LINE
- (40) CUT AND PLUG EXISTING SEWER FOR REMOVAL
- (32) INSTALL SEWER MAN HOLE PER CITY OF RIVERSIDE STD. DWG. NO. 500

Associated Engineers, Inc.
 3311 EAST SHELBY STREET • ONTARIO, CA 91764
 TEL. (909) 980-1982 • FAX: (909) 941-0891
 CITY OF RIVERSIDE BUSINESS TAX CERTIFICATE #6698 EXP. 1/9/2007

Signature: Christopher Sean Turnage
 1/20/06
 CHRISTOPHER SEAN TURNAGE, R.C.E. No. 62297 Exp. 09-30-07