
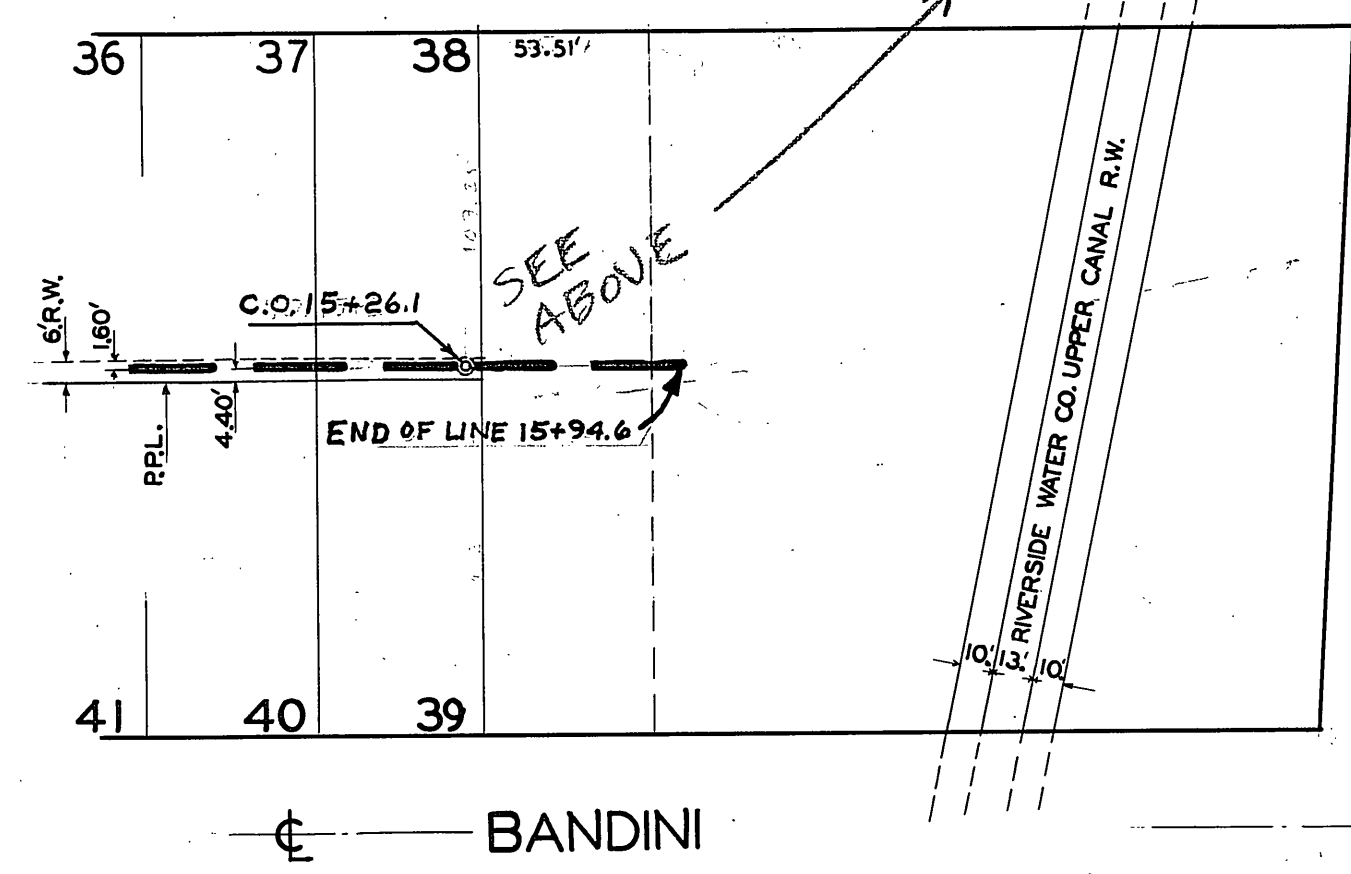


BOOK	THREE	PAGE	20

FLEX B. 203, P. 27

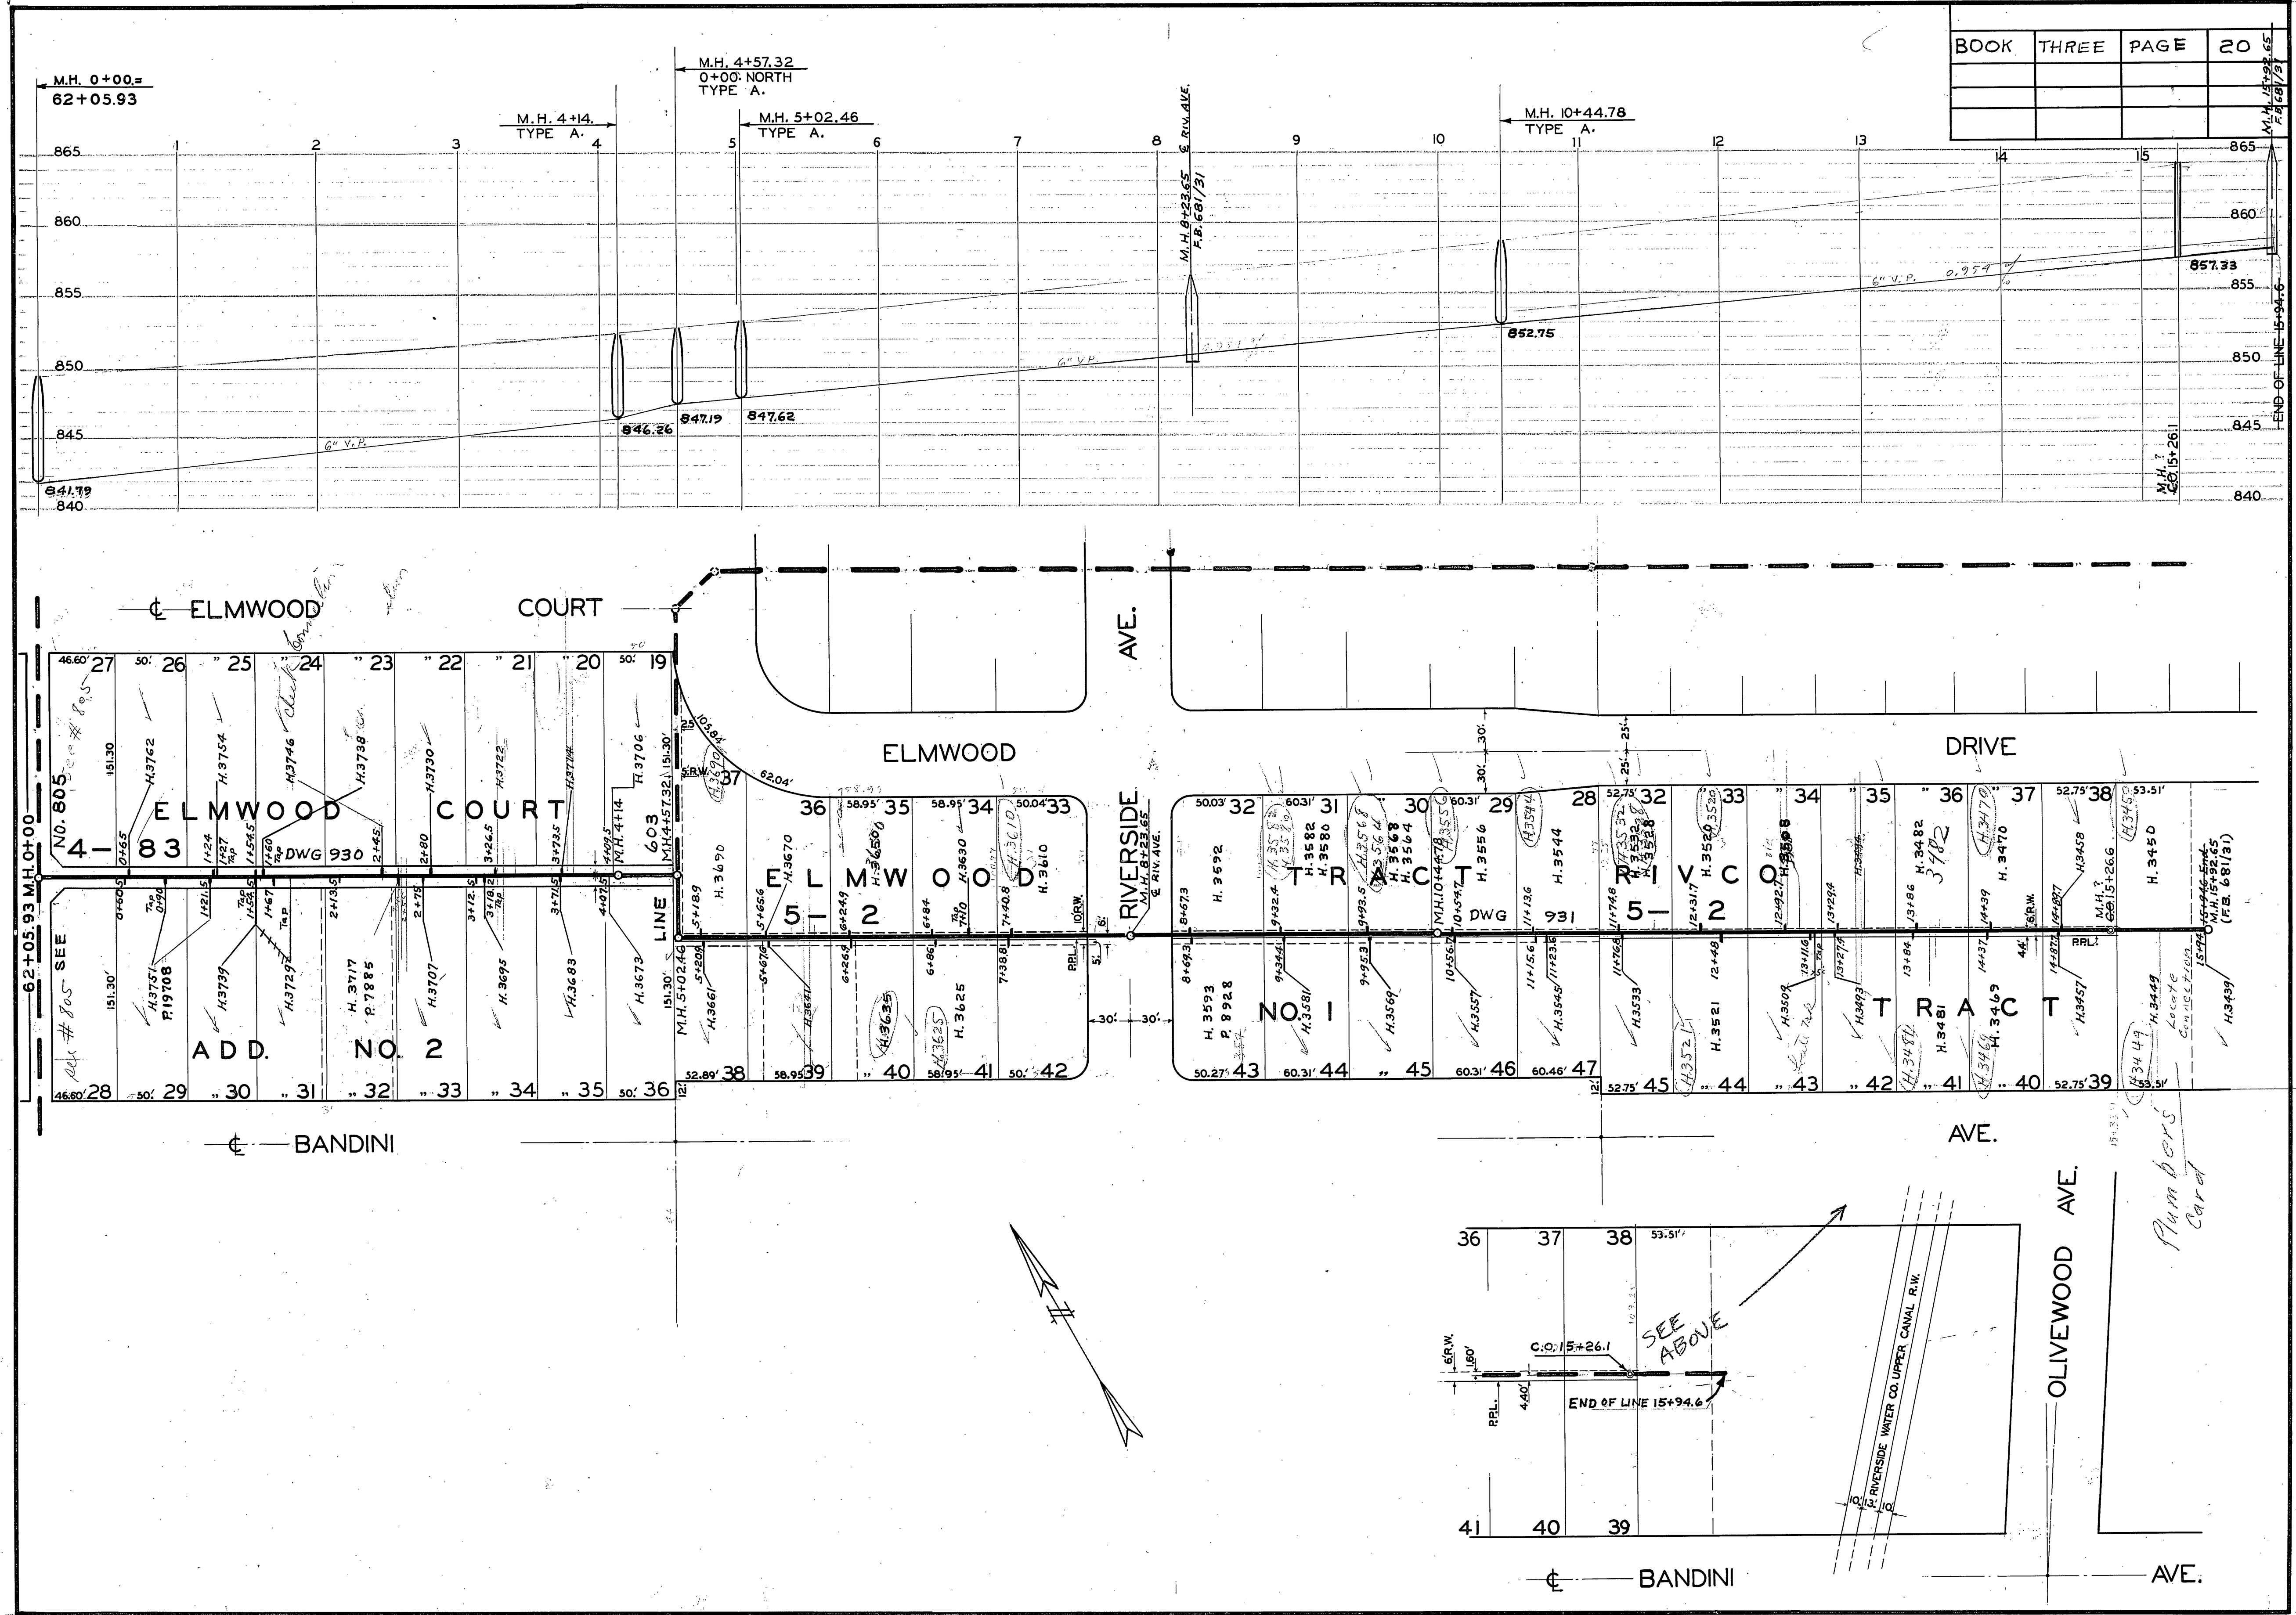

*Plumbers Card*