


133/19

BOOK 4-P-115
P.L. 133 P-19

Posted 9-20-44

000

BOOK	THREE	PAGE	36

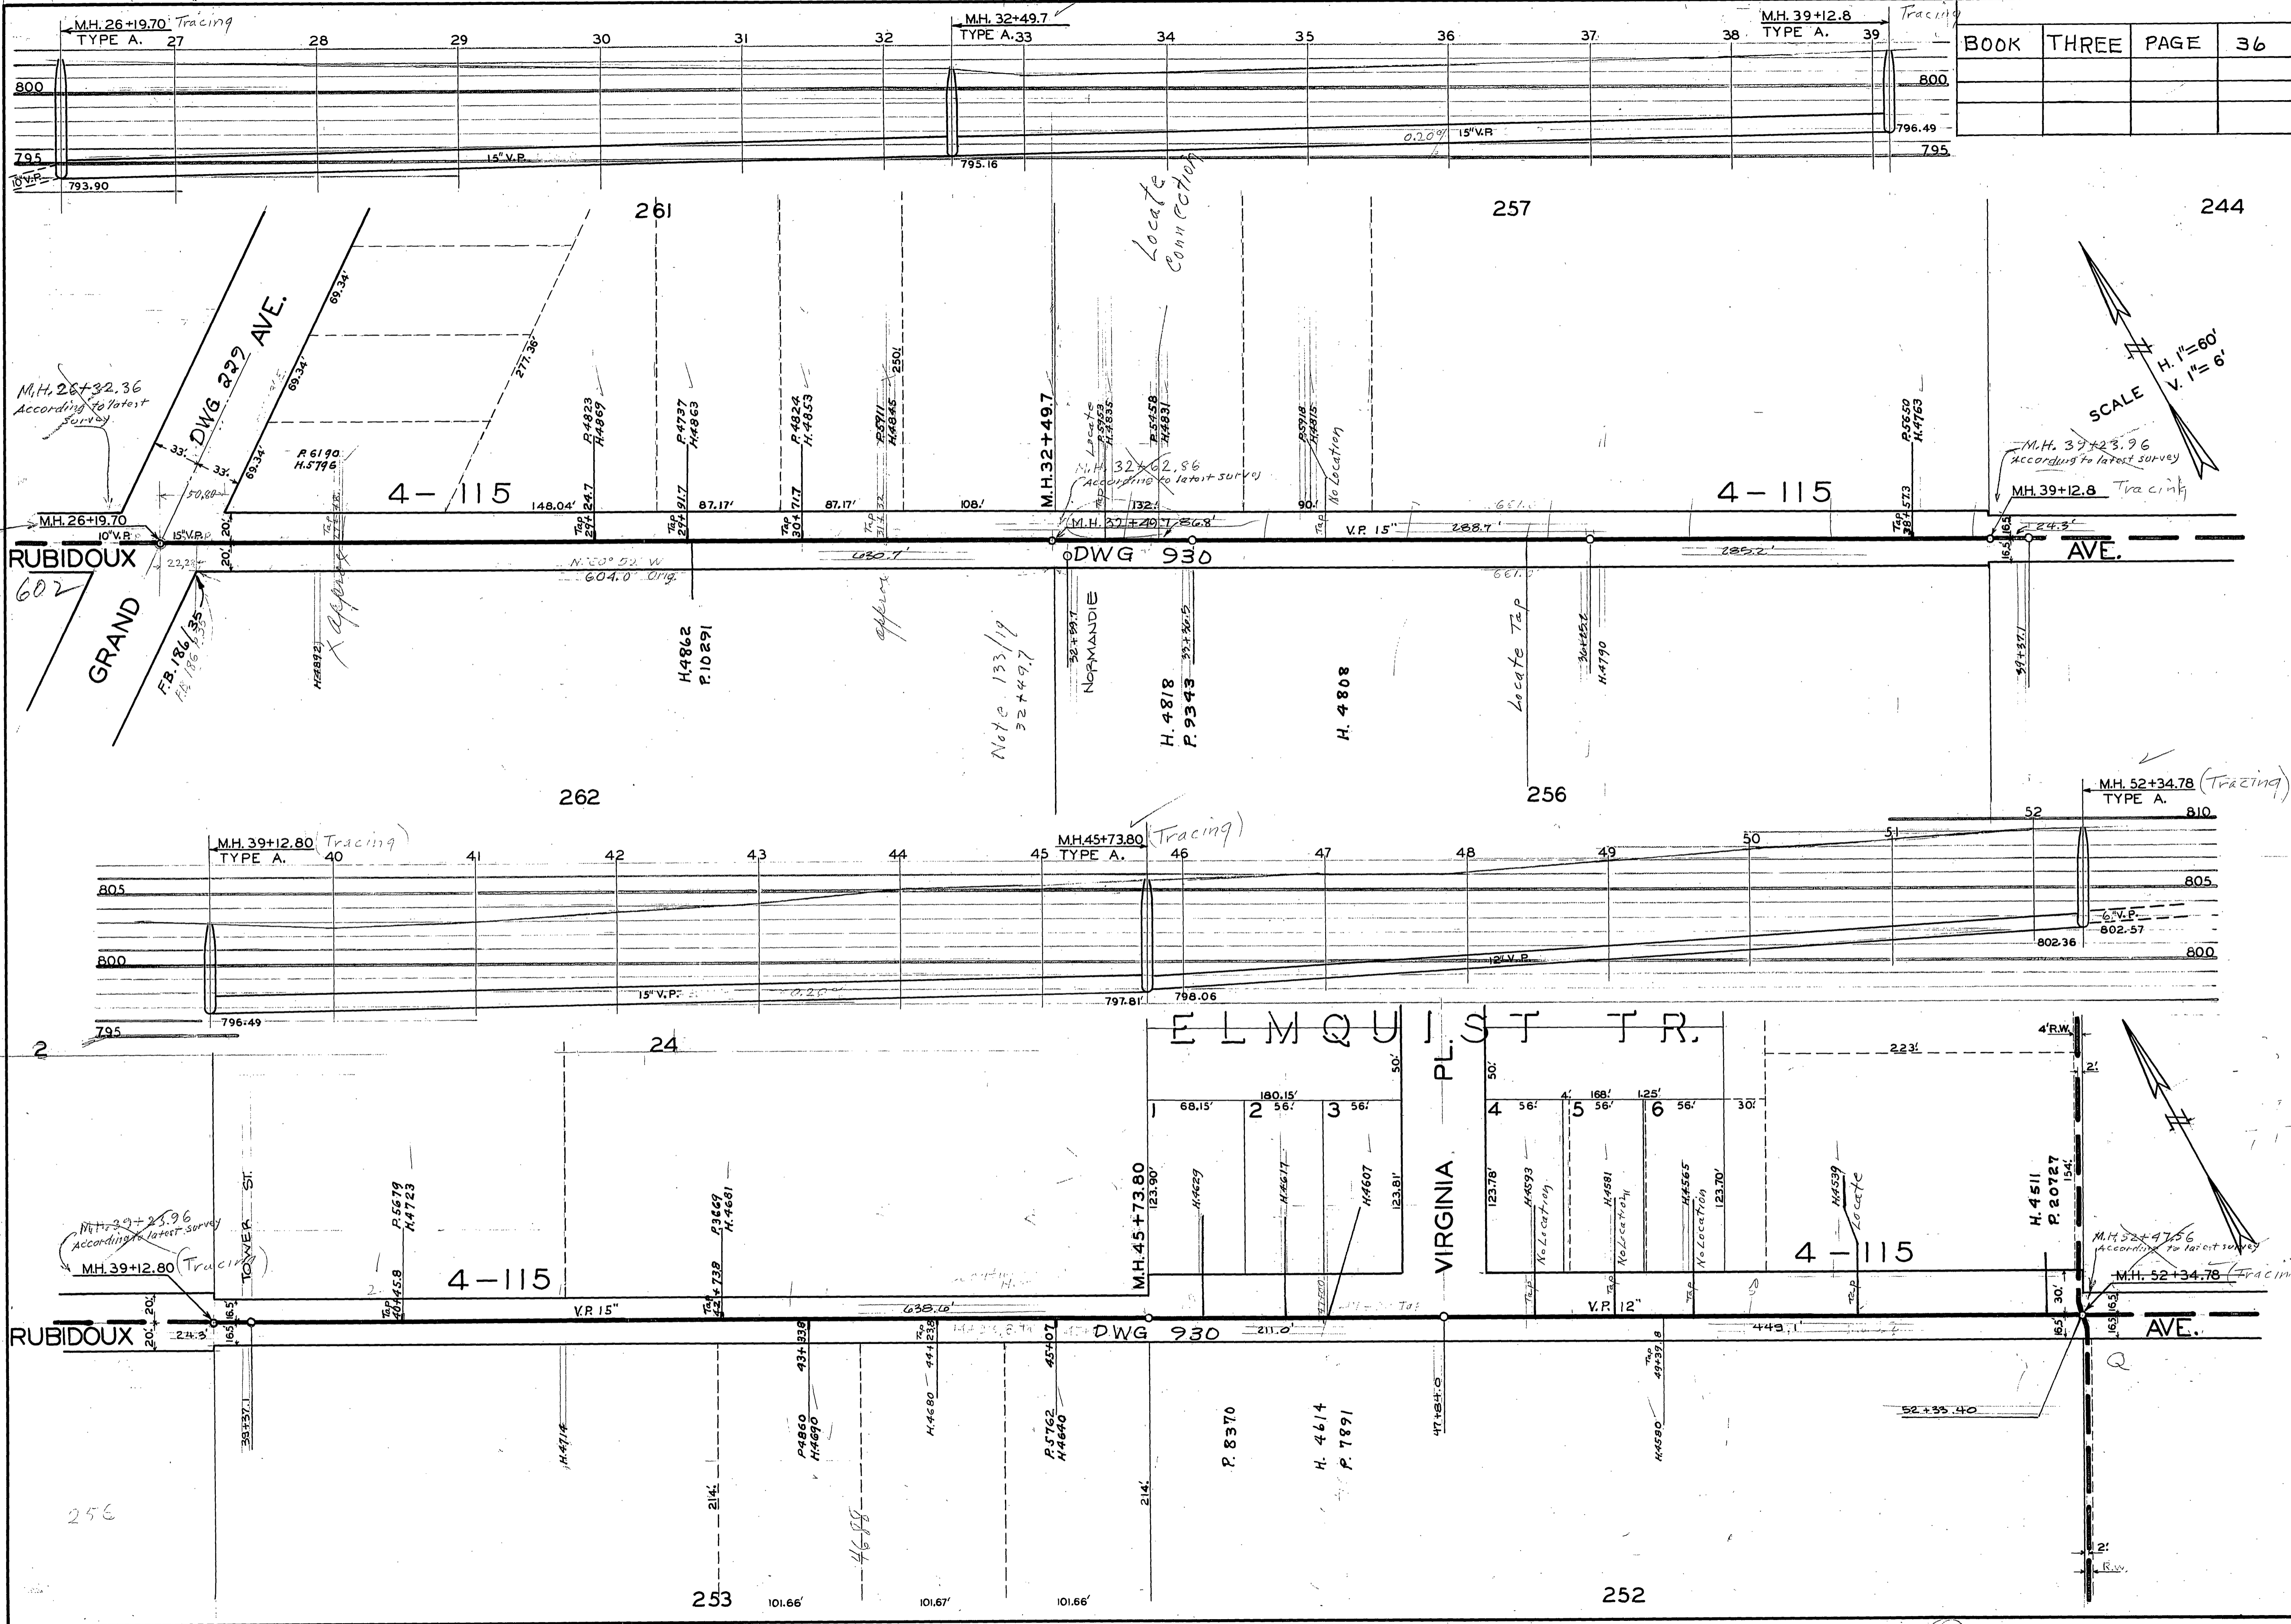

(Tracing)
M.H. 26+19.70 According to F.B. 133, P.19

Locate
Connection

M.H. 39+12.8
According to latest survey
M.H. 39+12.8 Tracing

SCALE
H. 1" = 60'
V. 1" = 6'

Note 133/19
32+49.7

M.H. 39+12.80
According to latest survey
M.H. 39+12.80 Tracing

M.H. 52+34.78
According to latest survey
M.H. 52+34.78 Tracing