
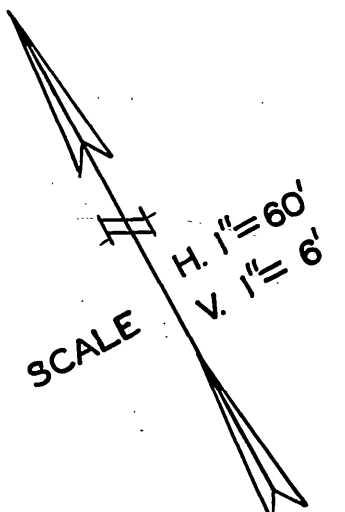


? Set location  
p.g. different  
70.38?

CA 2+86  
According to street survey

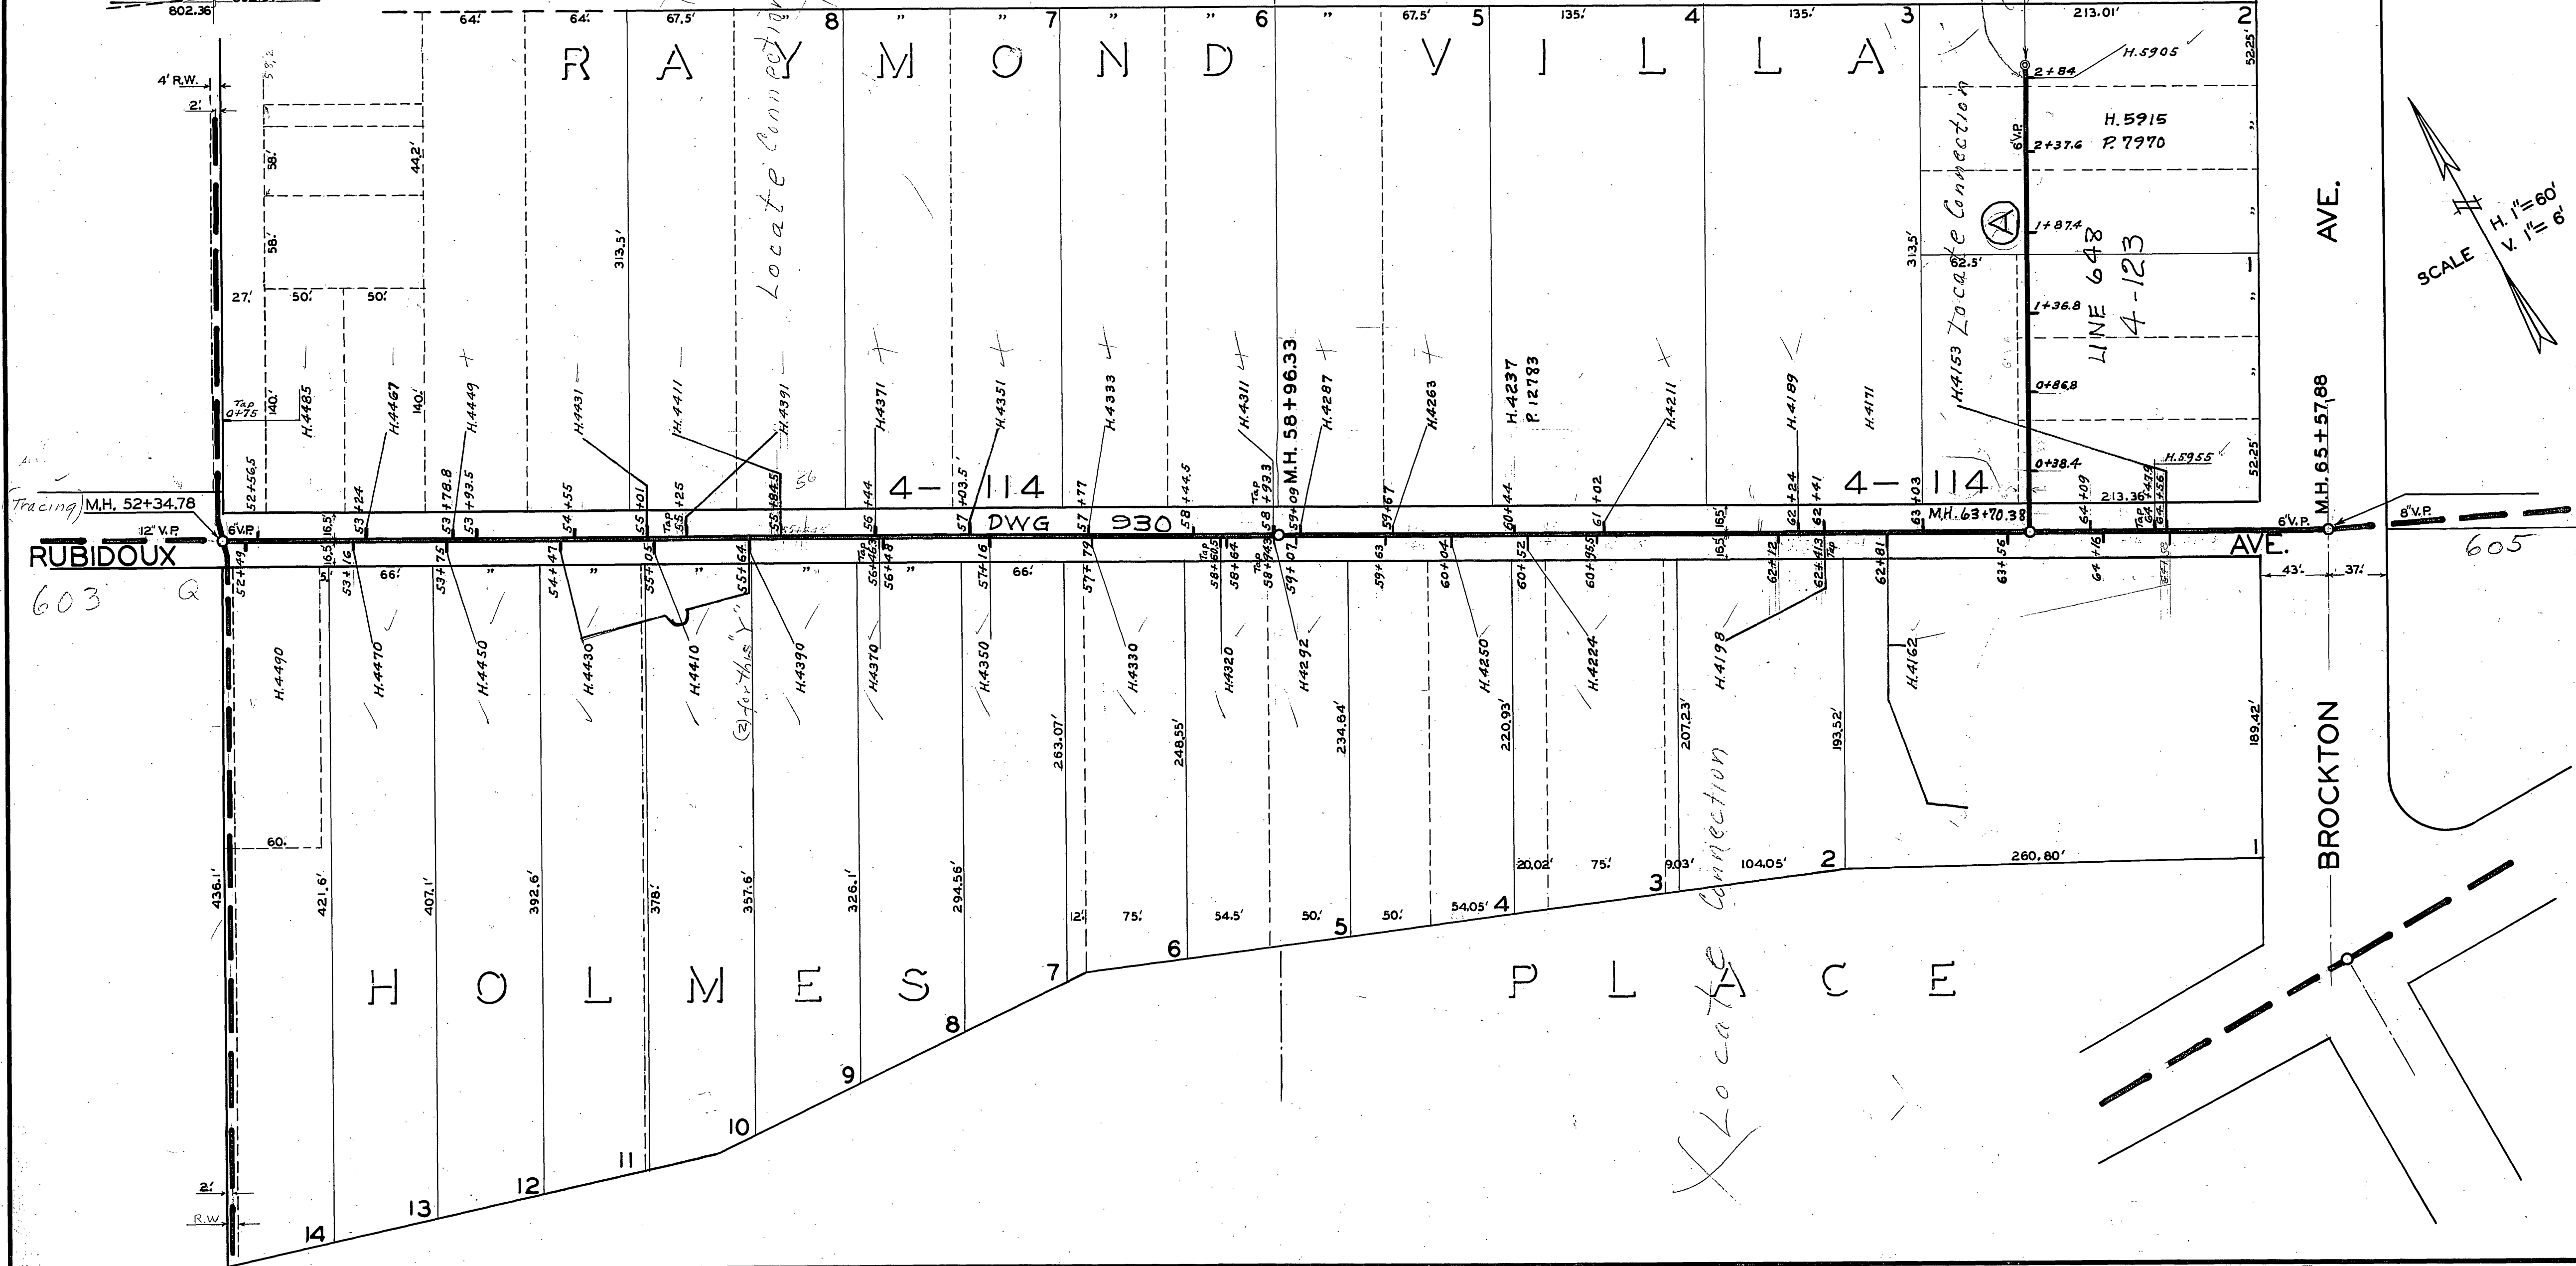

S.B.M.P. 114  
X-5 B.133 P.50

Locate Connection

Locate Connection

LINE 648  
4-123