



BOOK	THREE	PAGE	38

FE 133.P.30
15-5-48

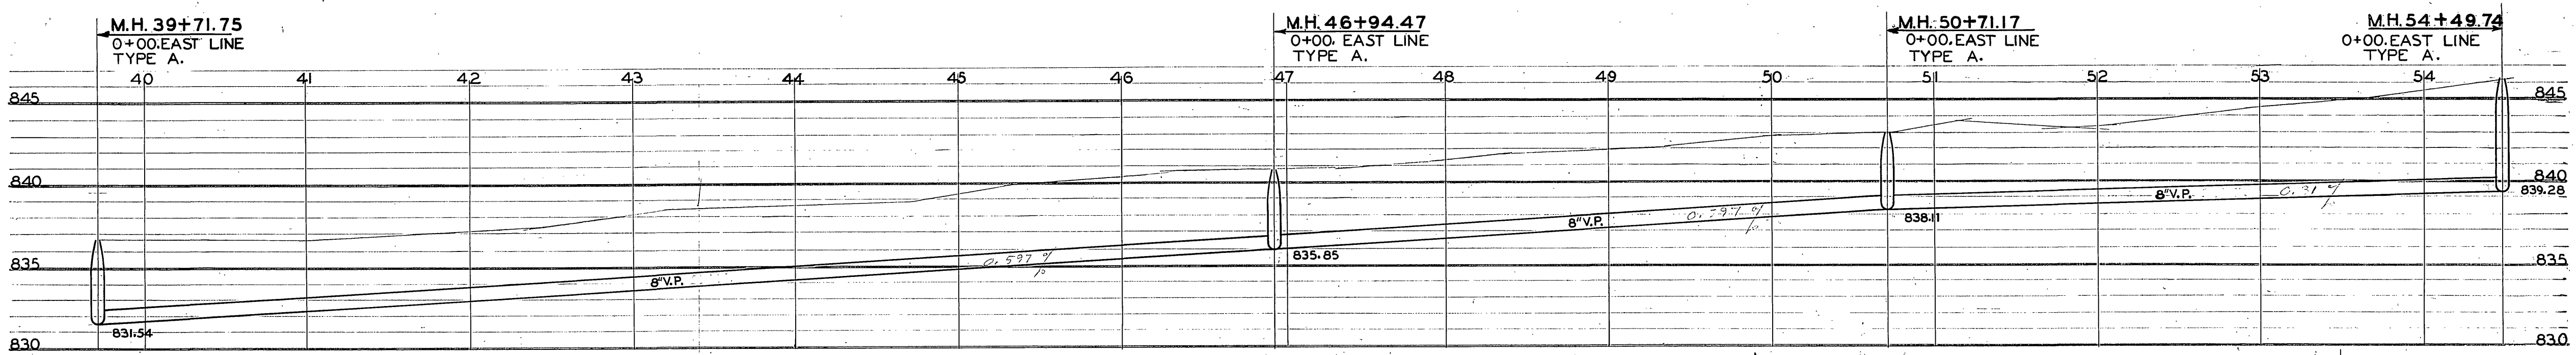

M.H. 30+60.3 =
11-39+71.75

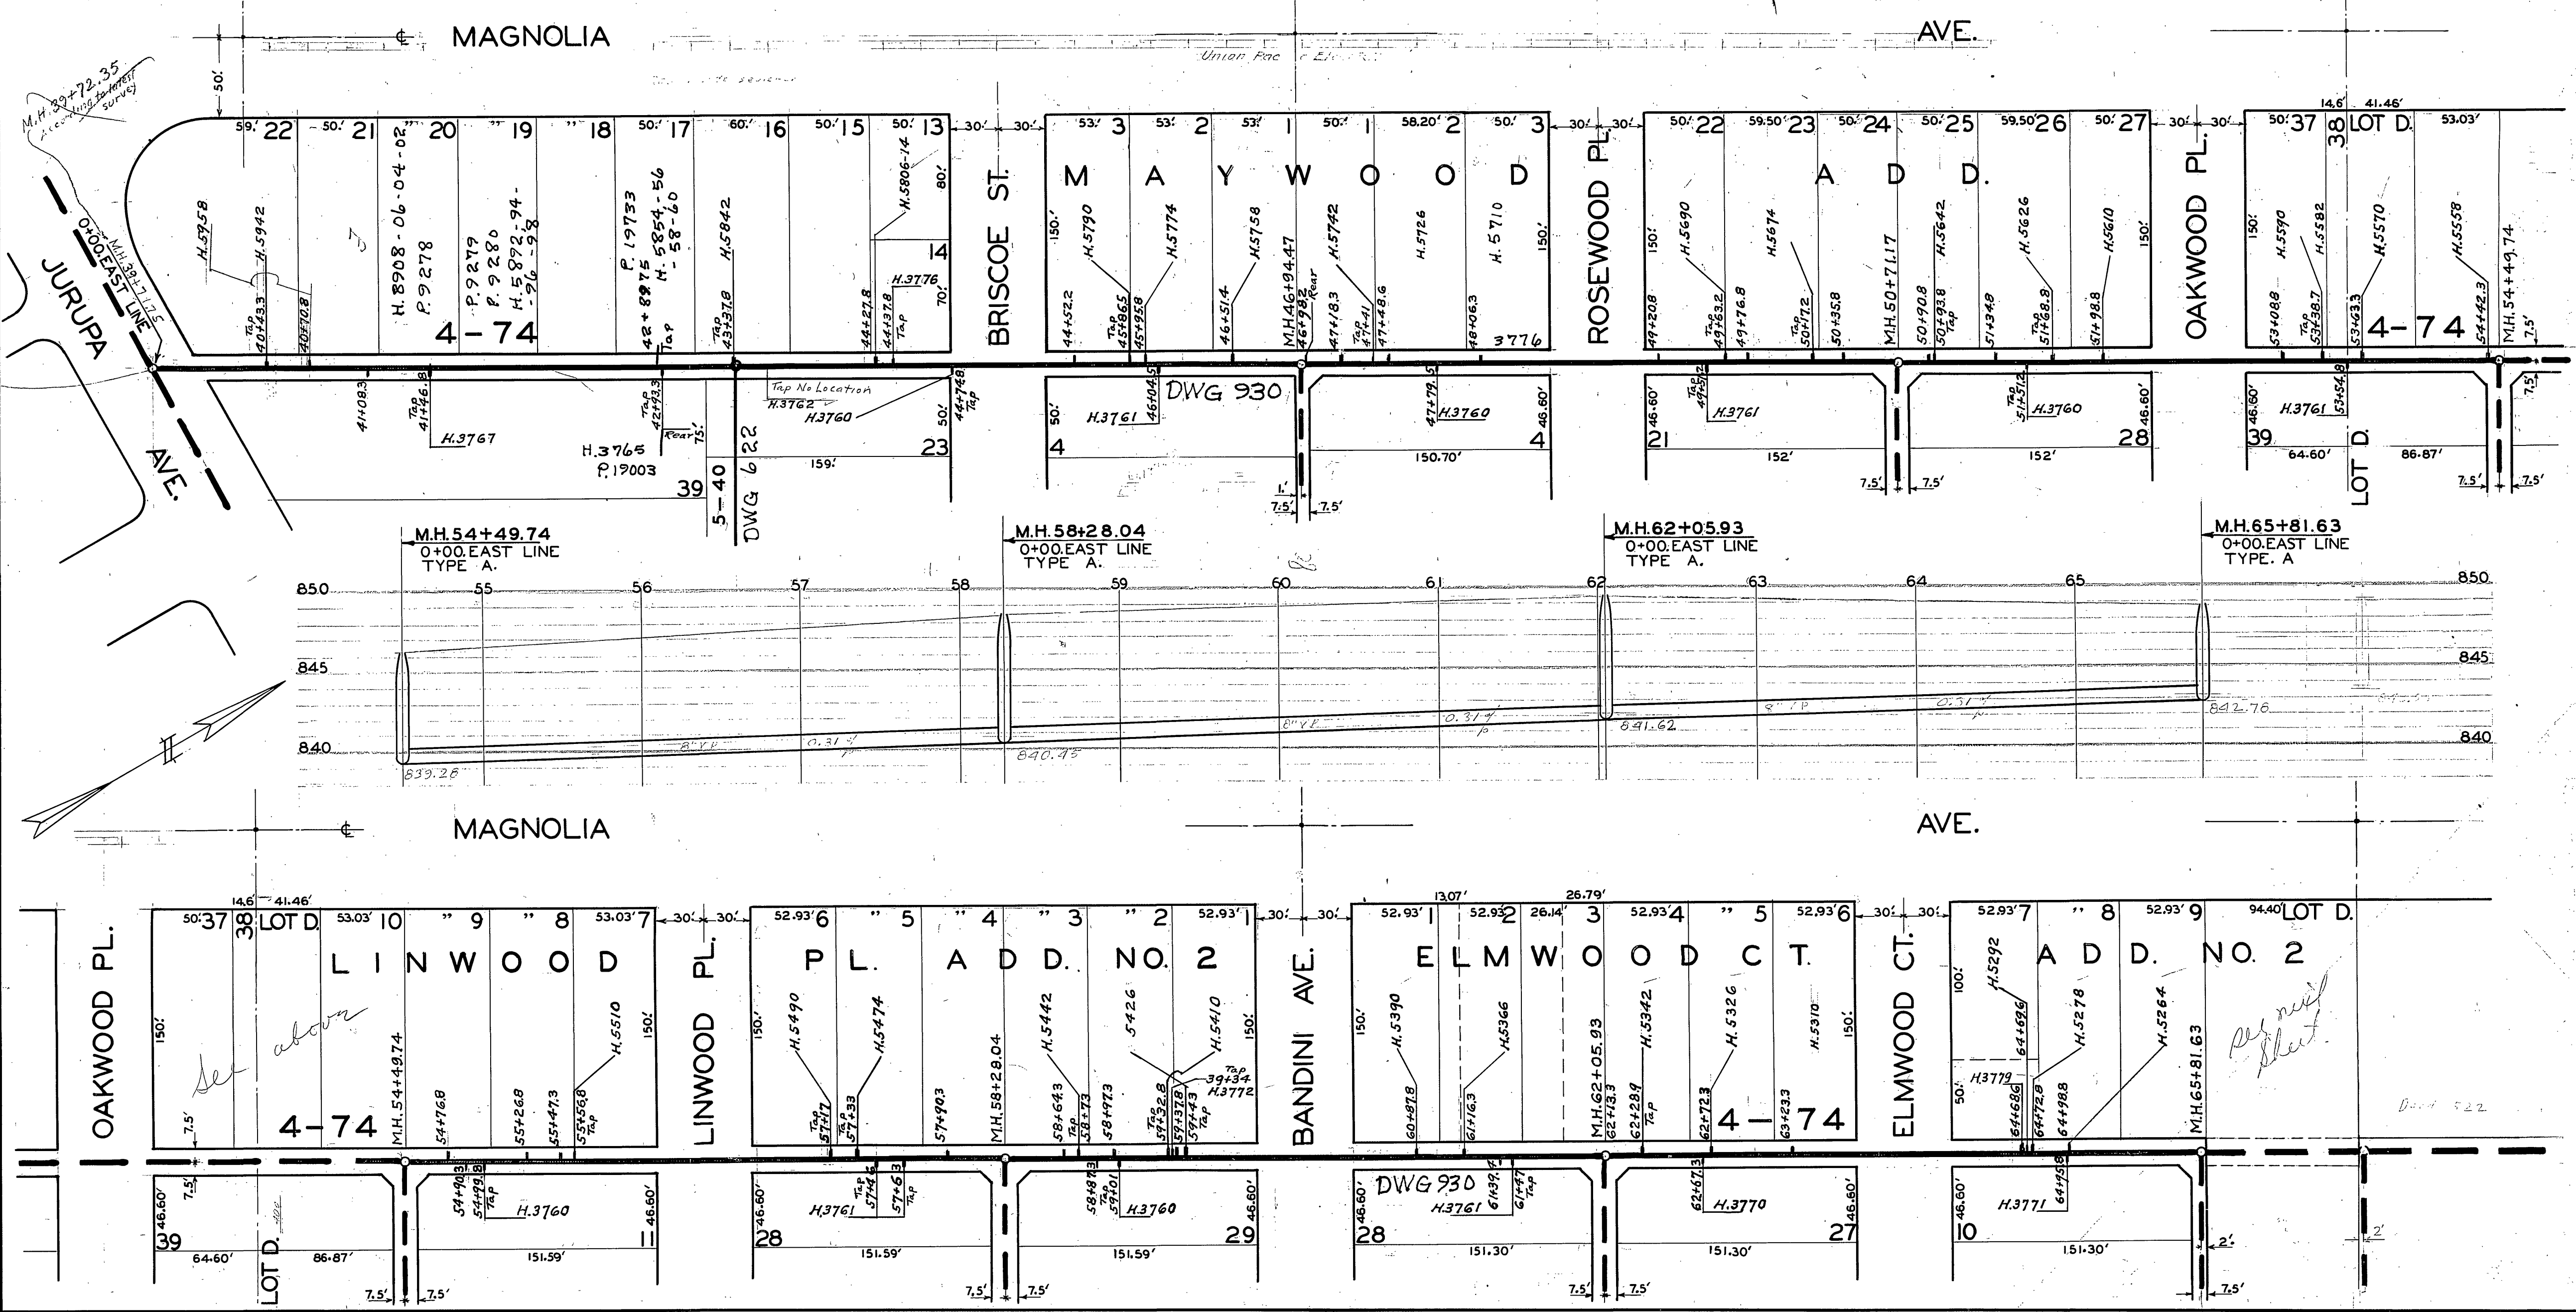

10-5-48
11-12-48