


BOOK	THREE	PAGE	46

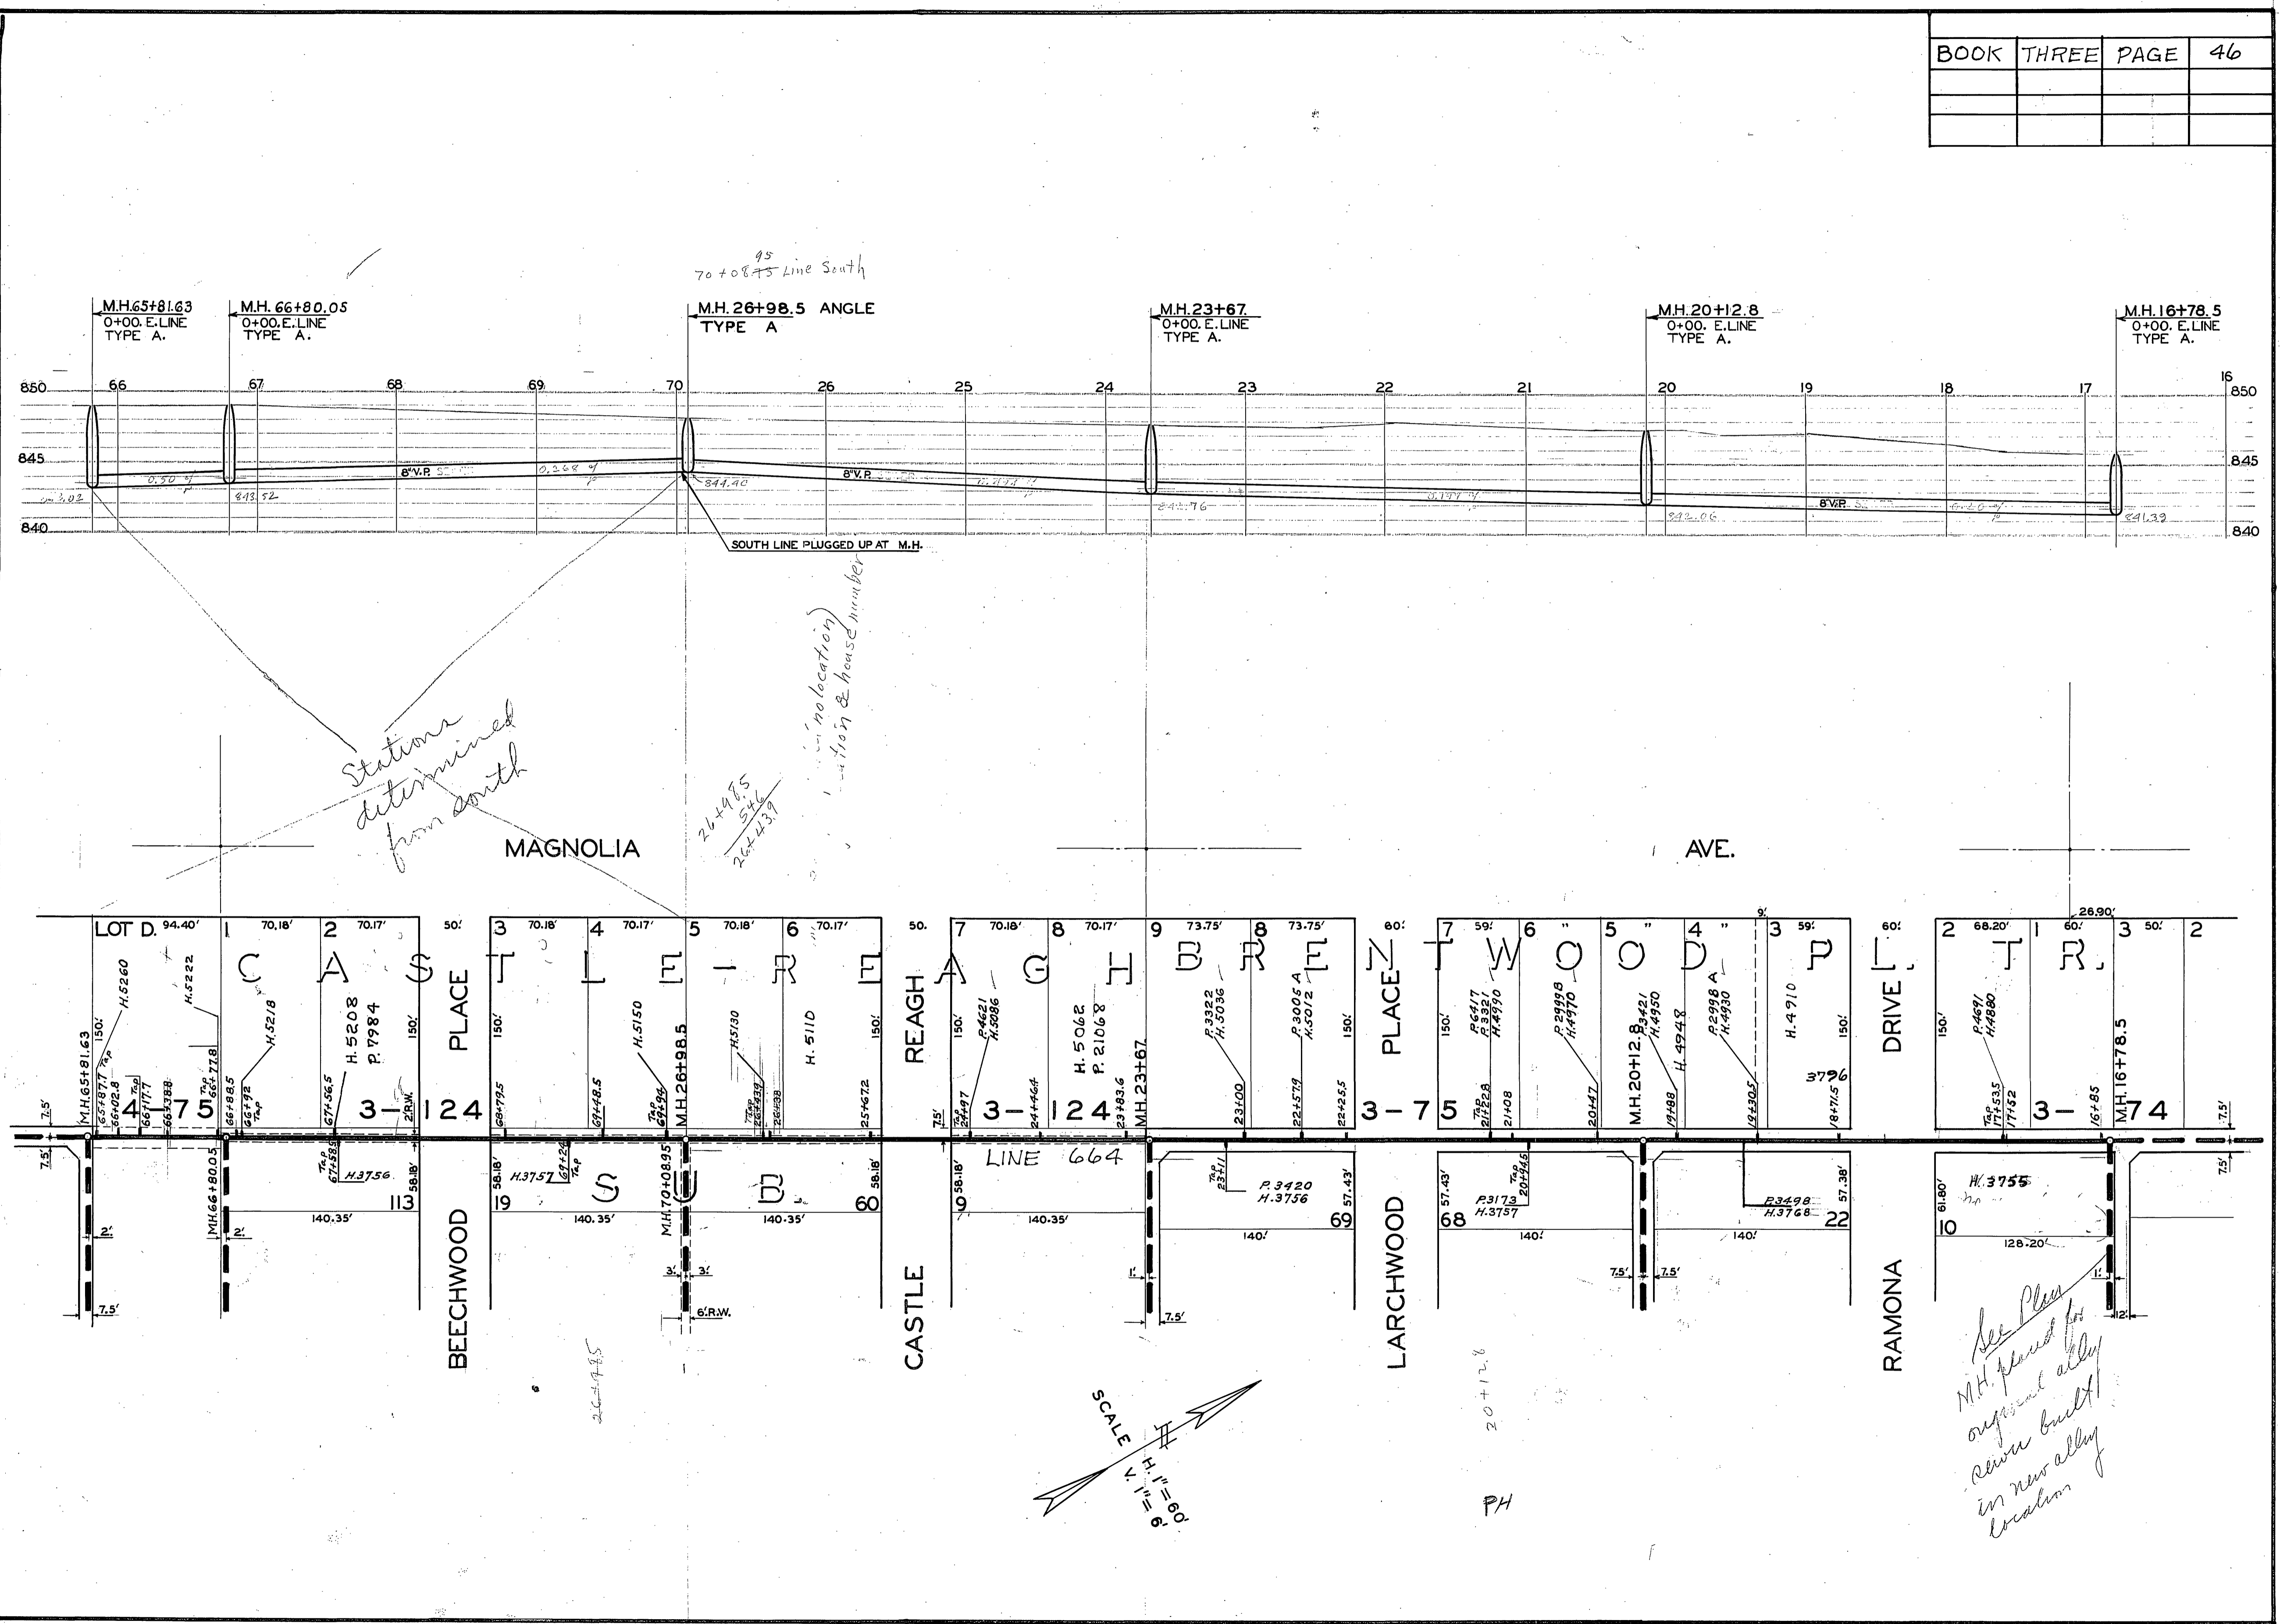

Stations determined from south

no location in 1917 & house number 26+98.5 546 26+437

See Plan M.H. found for original alley since built in new alley location

