


| | | | |
|------|-------|------|---|
| BOOK | THREE | PAGE | 5 |
| | | | |
| | | | |

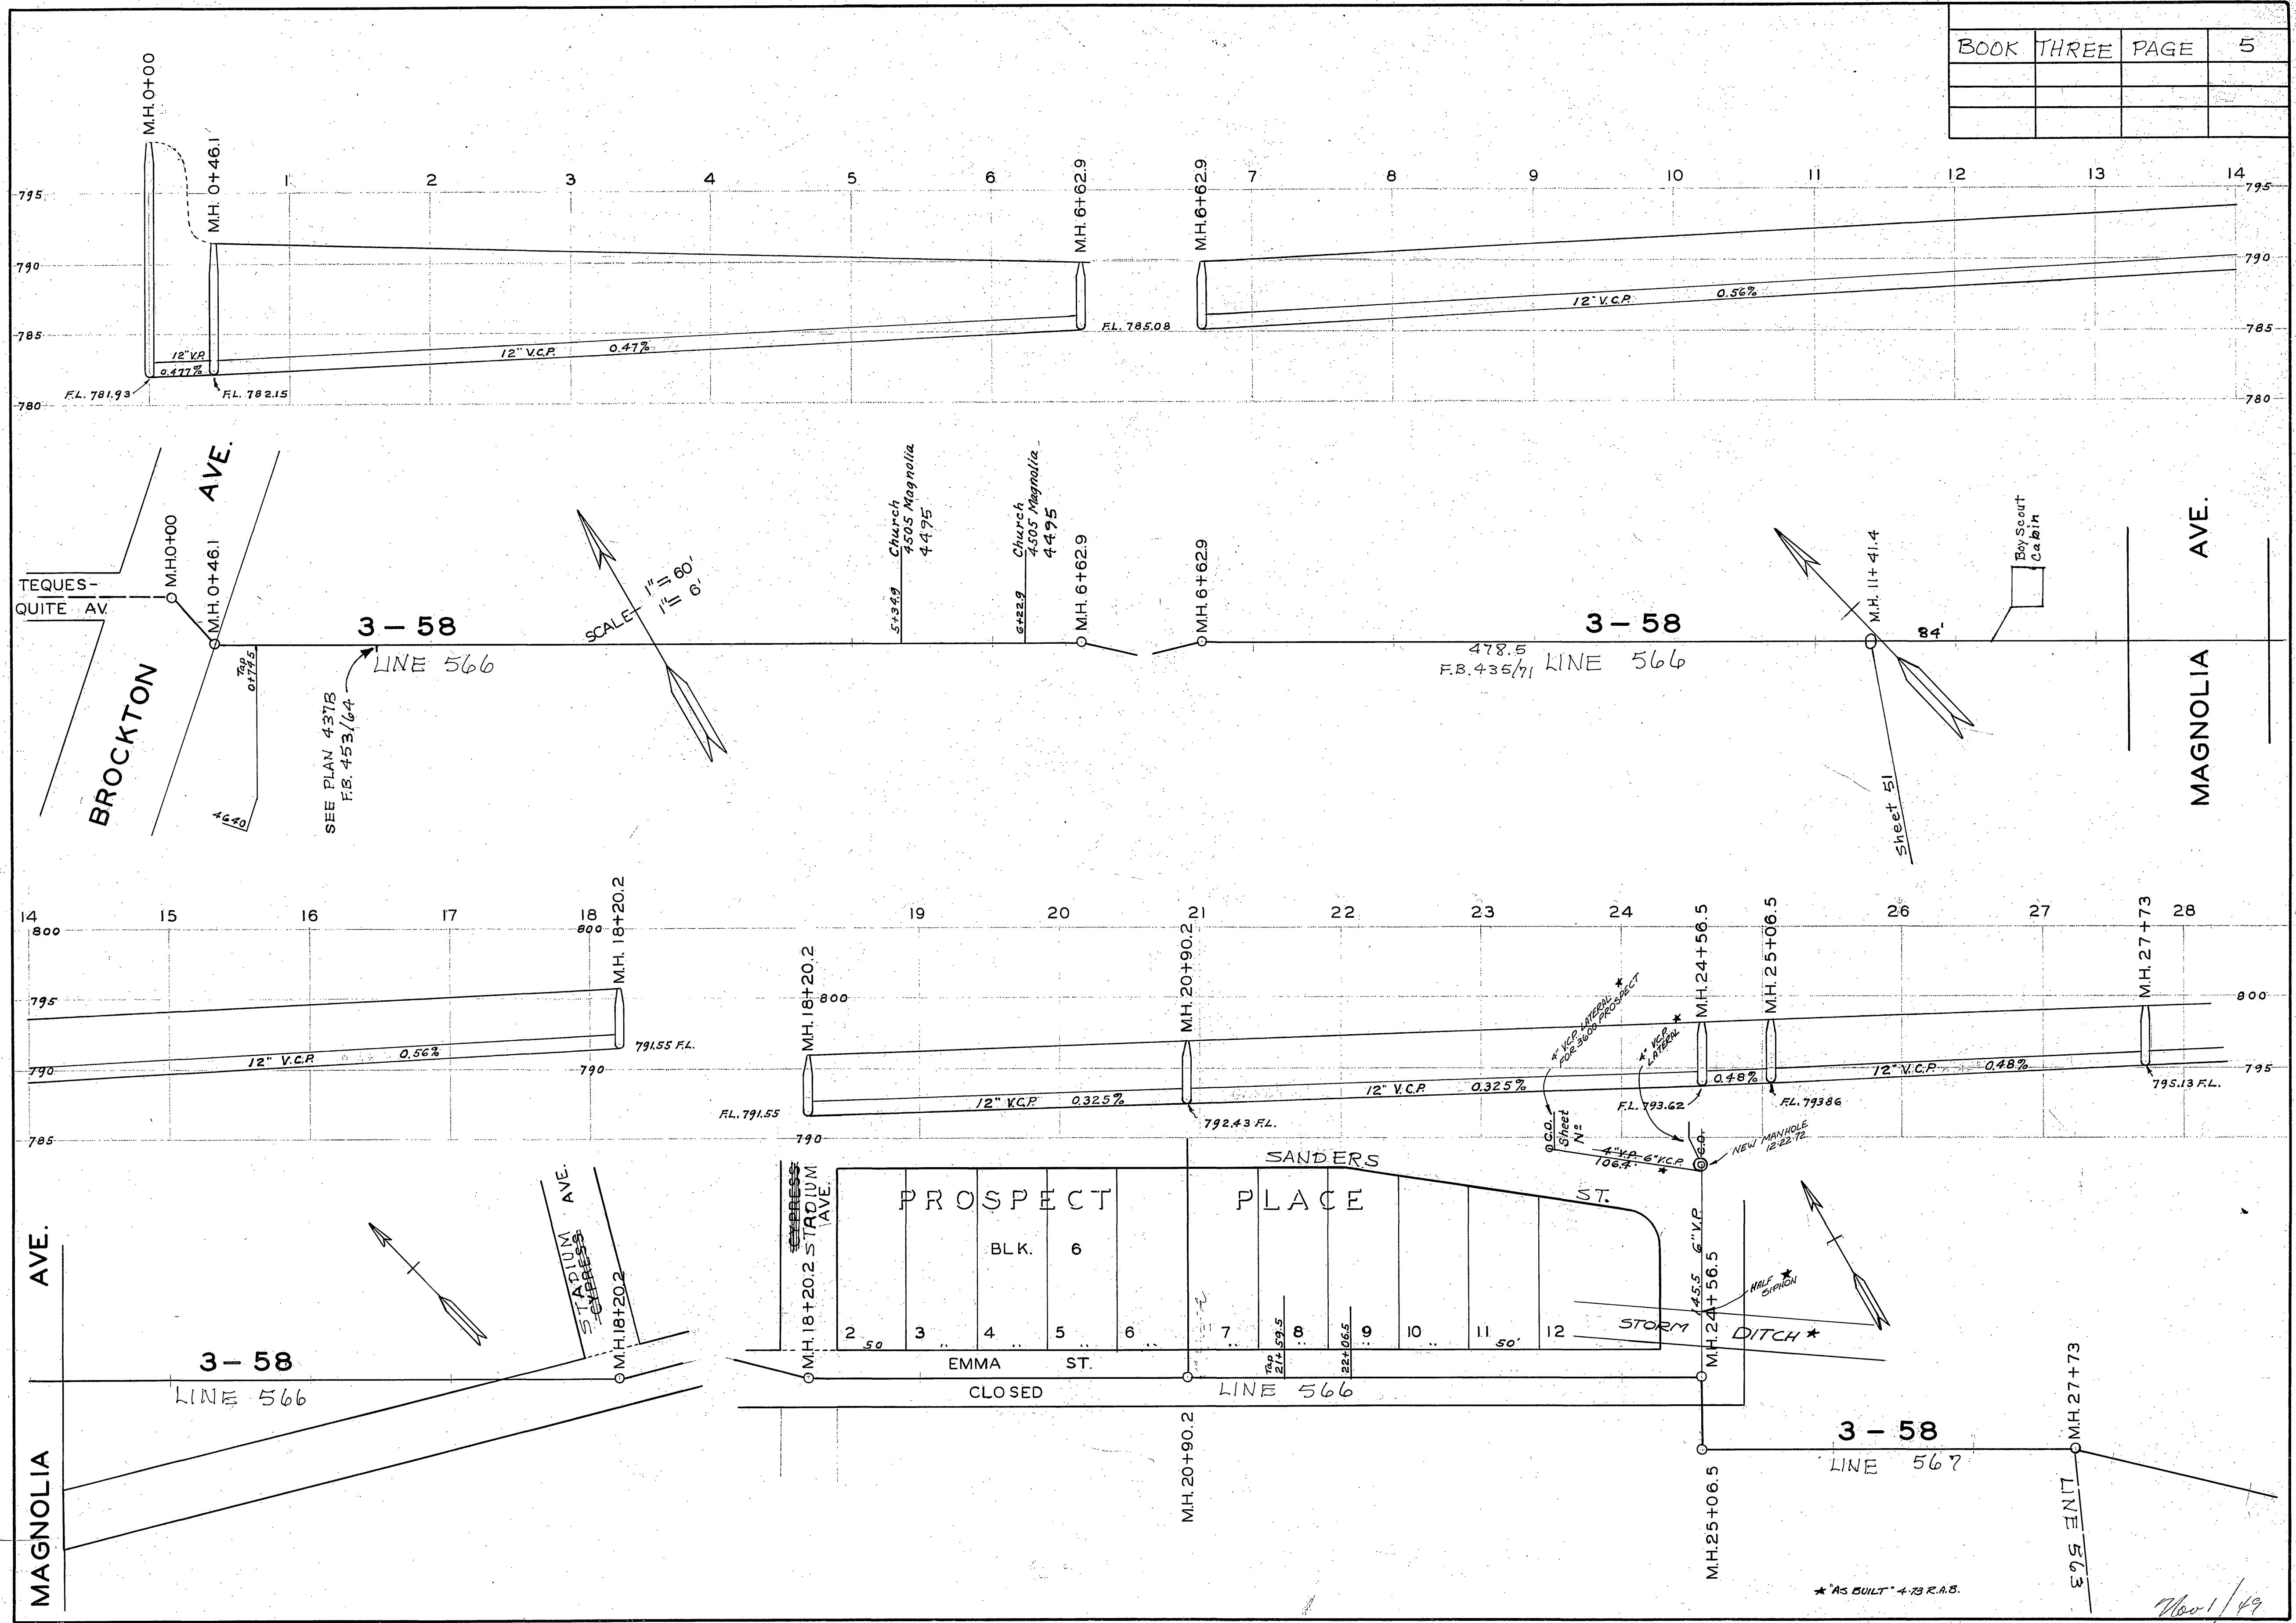

Nov 1/49
W.H.