
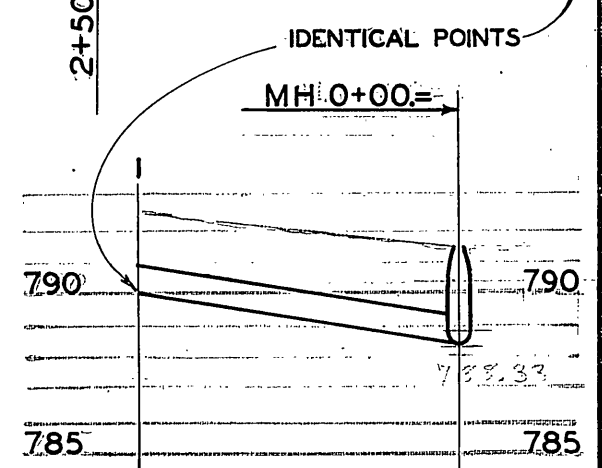


BOOK	THREE	PAGE	51

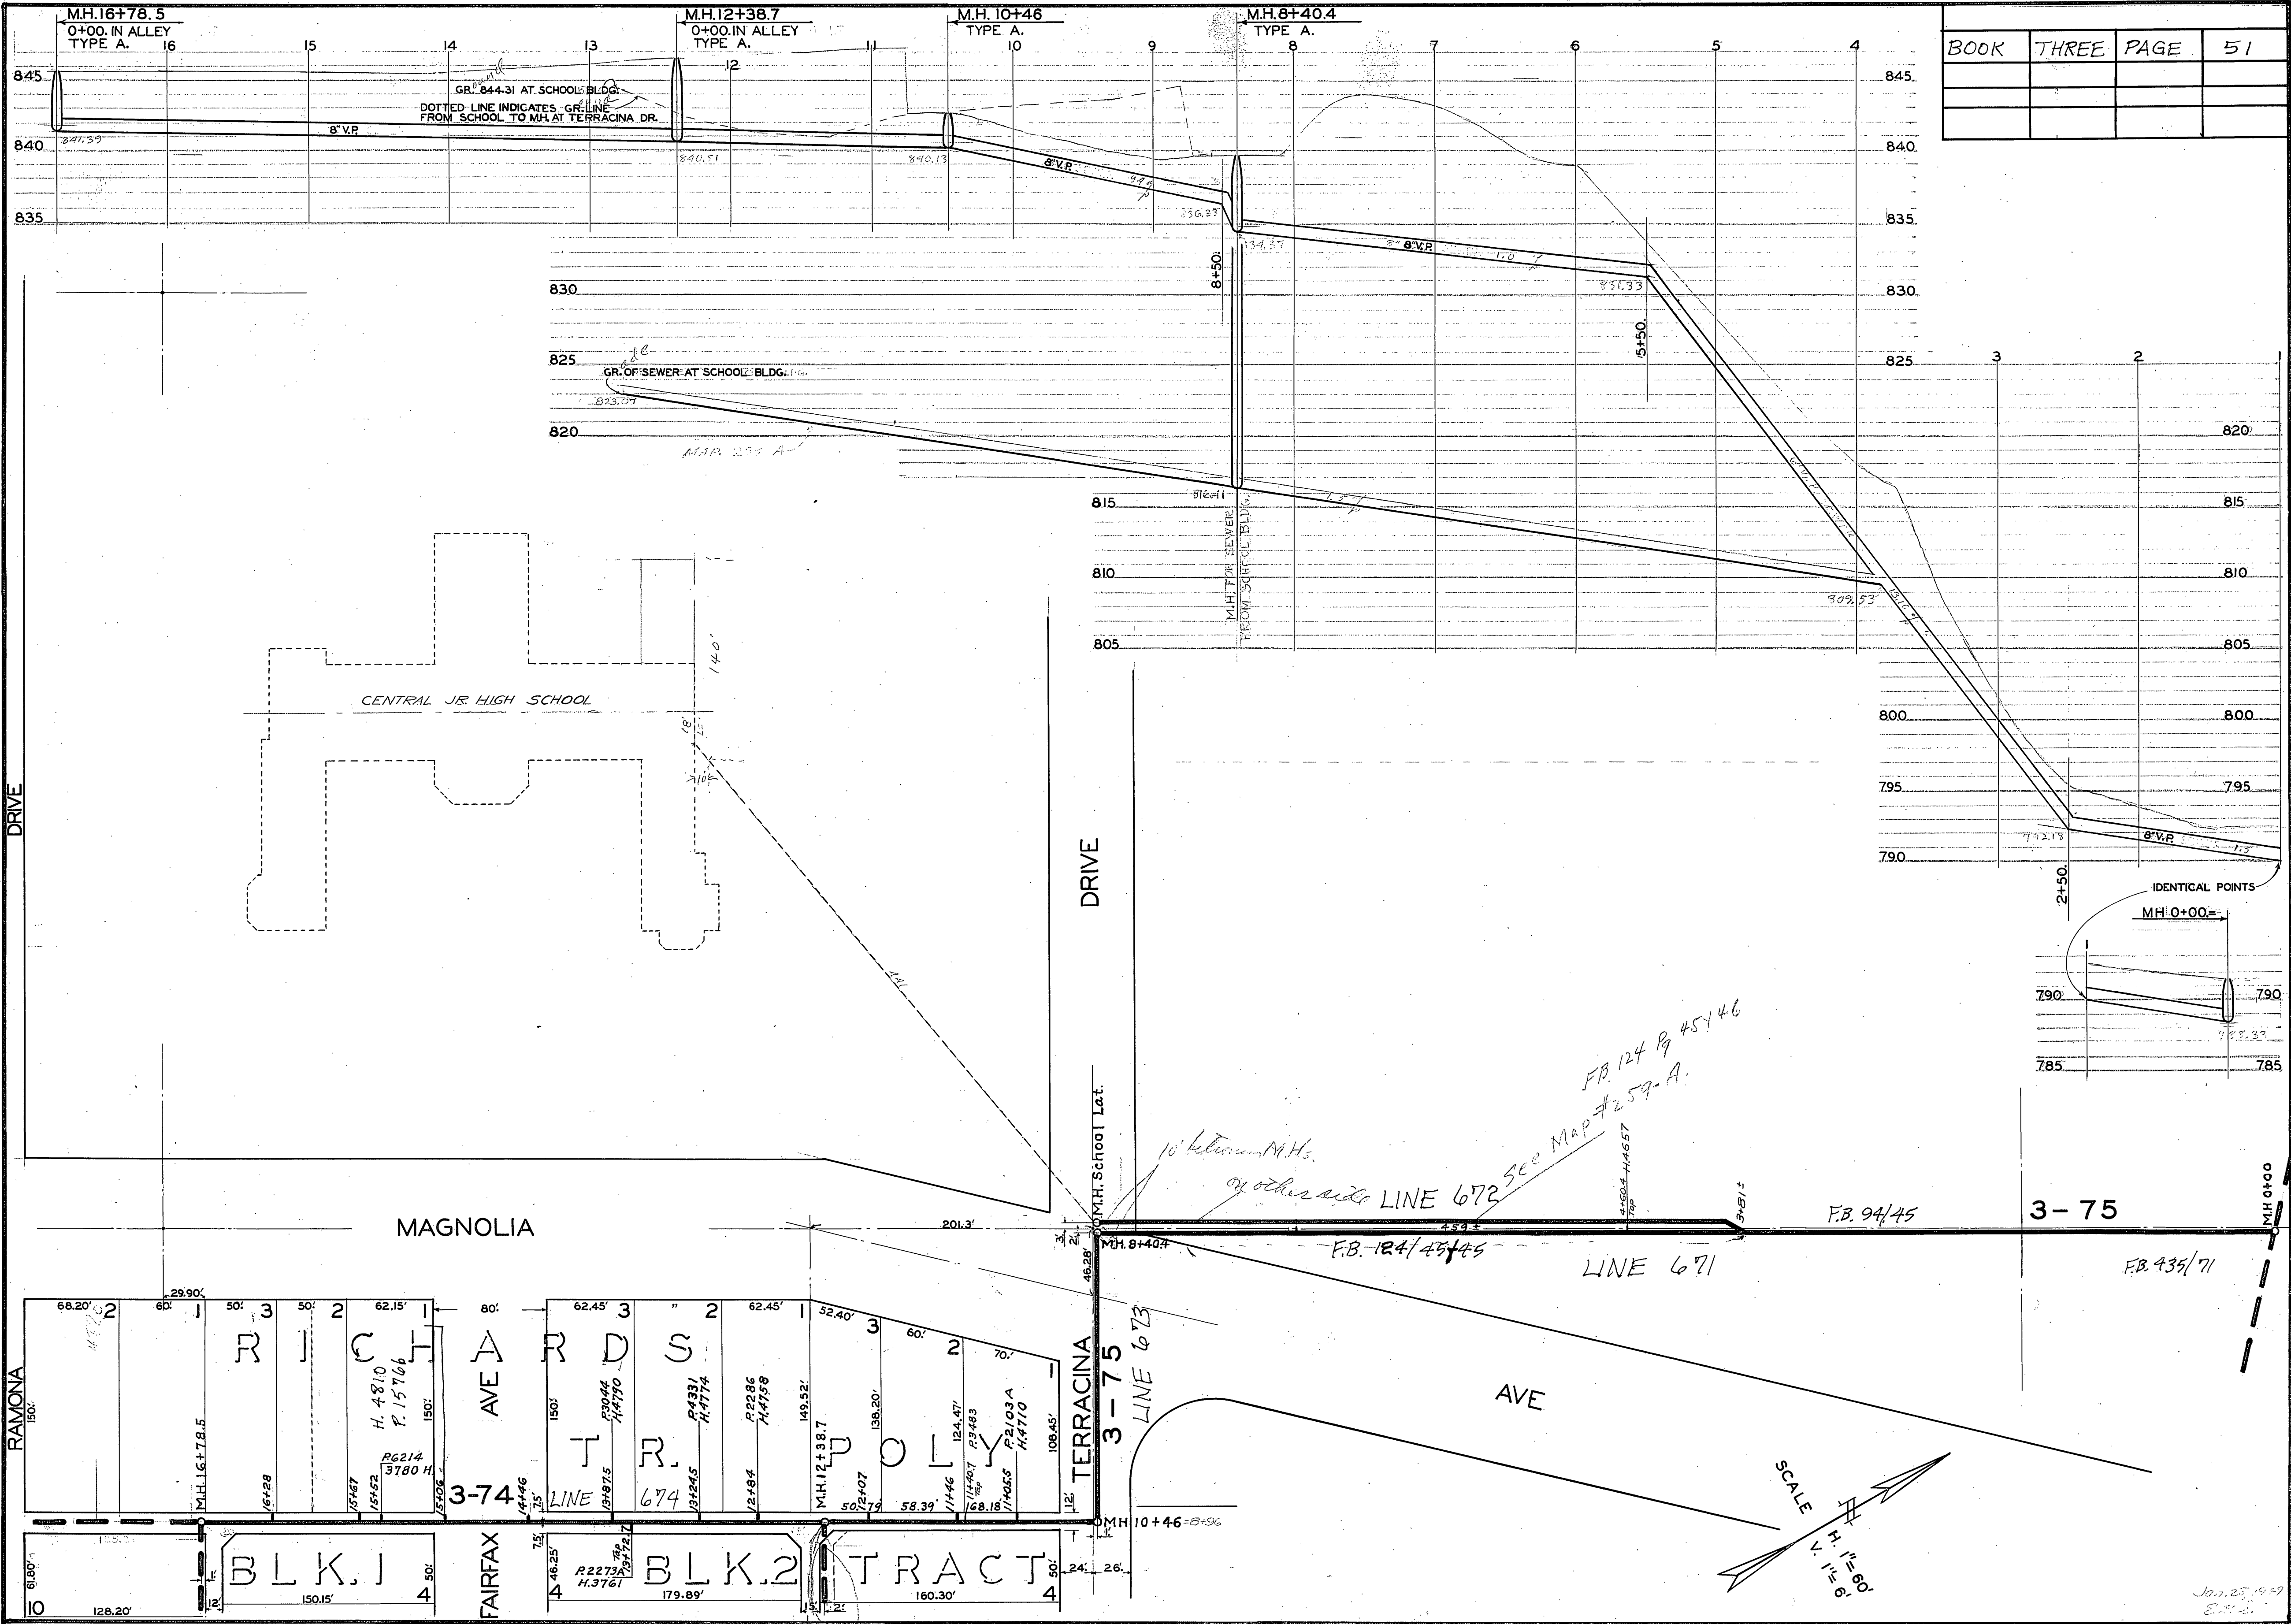

4406

Change