

West of this M.H. See Plans No 386 (3rd E. of Streeter)

H-5139
H-5127 P-9403
H-5109
SW 1/4 OF NW 1/4 SEC.33
T.2S. R.5W. S.B.B.M.

H-5095

H-5081
P-10356


H-5055
P-14628

H-5035
P-12038

S.E. 1/4 OF NW 1/4 SEC.33
T.2S. R.5W. S.B.B.M.

H-4993
P-9355

H-4993

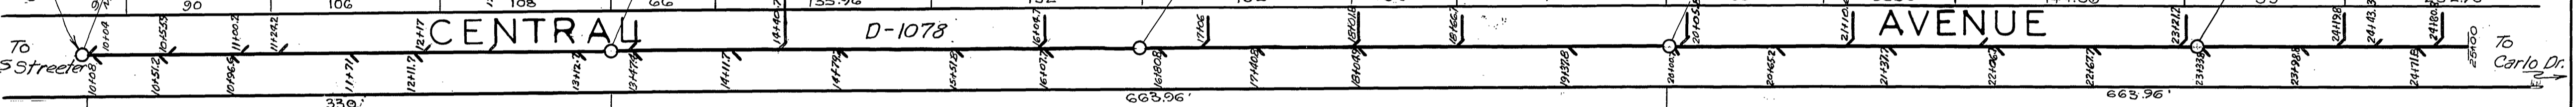

NW 1/4 OF SW 1/4 SEC.33
T.2S. R.5W. S.B.B.M.

NE 1/4 OF SW 1/4 SEC.33
T.2S. R.5W. S.B.B.M.

SCALES:
HORIZ. 1"=60'
VERT. 1"=6'

