


SCALES: HORIZ. 1"=60'  
VERT. 1"=6'

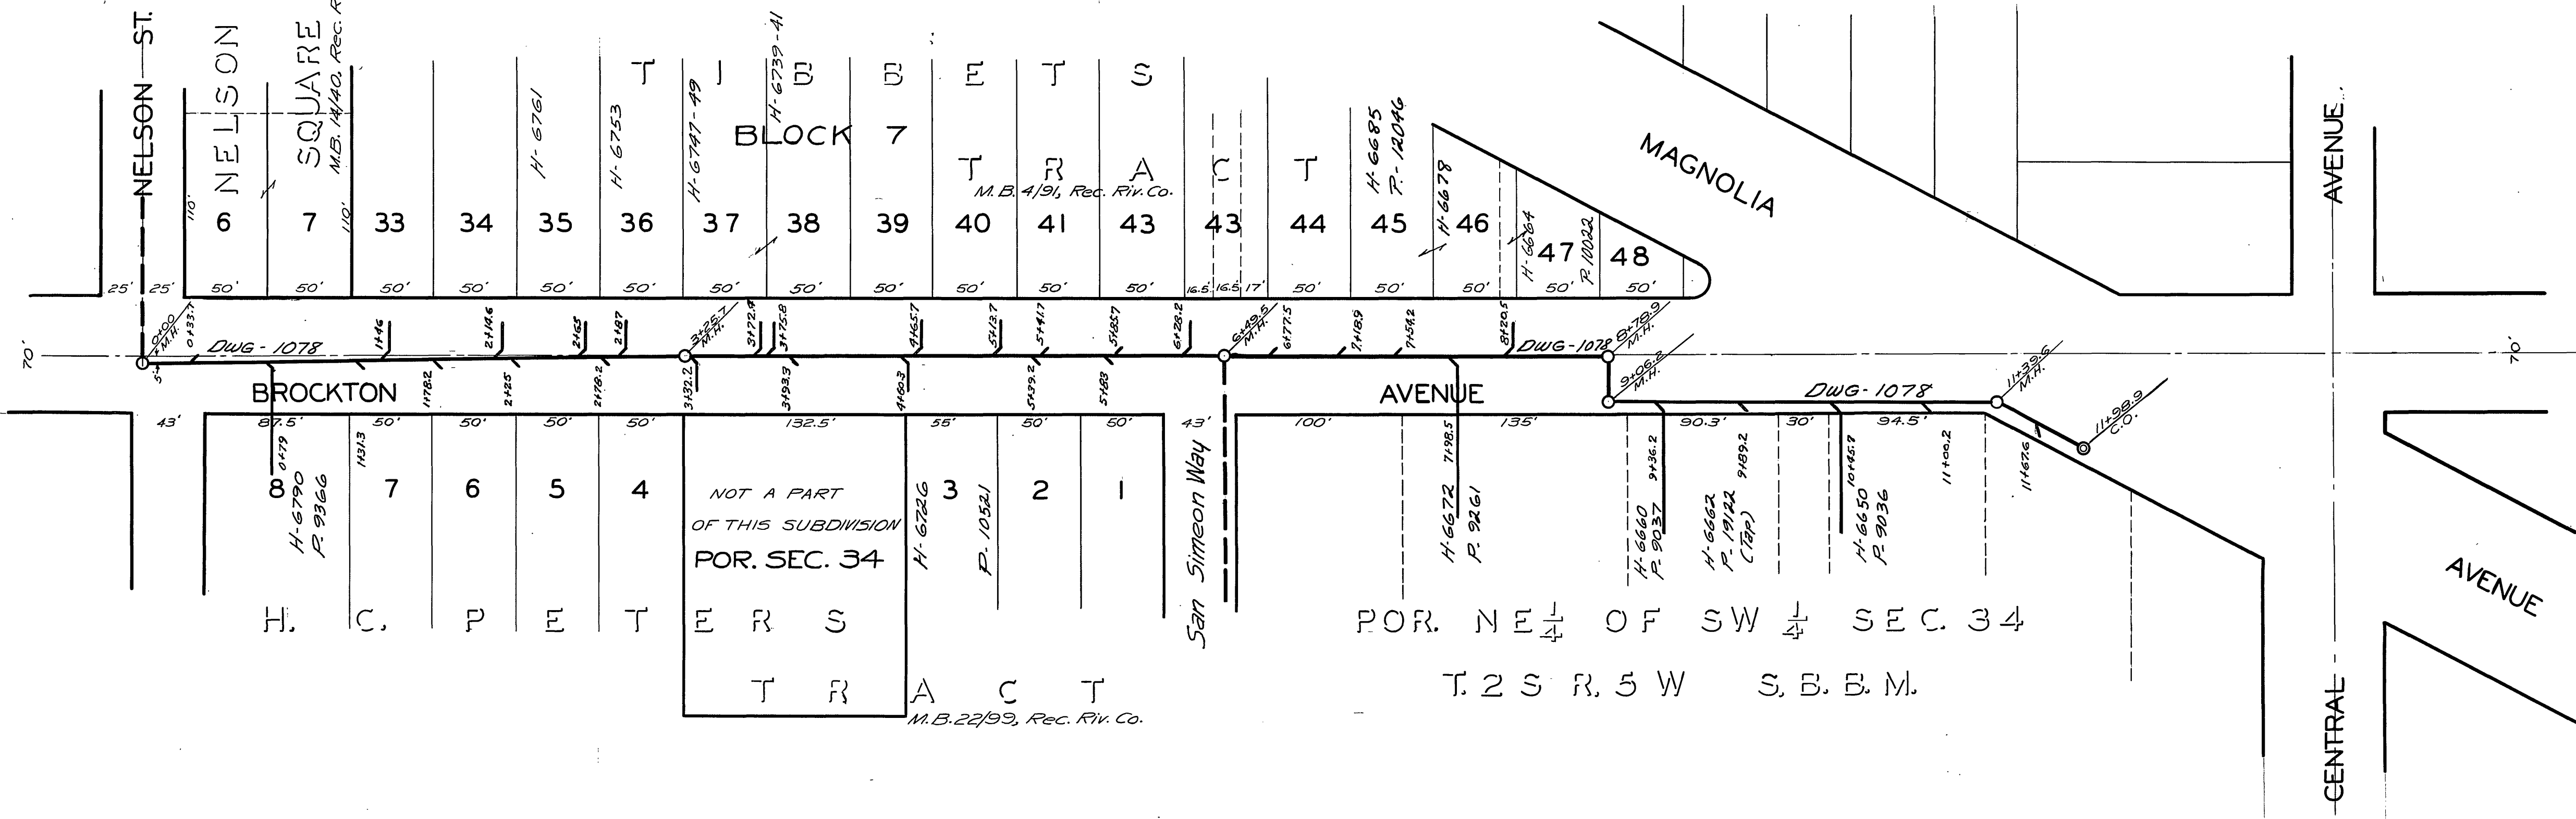

NELSON ST.

6 NELSON

7 SQUARE

M.B. 1440, REC. RIV. CO.

33

34

H-6761

H-6753

H-6747-49

H-6739-41

BLOCK 7 TRACT

M.B. 4191, REC. RIV. CO.

40

41

43

43

44

H-6685

F-12046

46

H-6684

F-12032

47

48

MAGNOLIA

AVENUE

BROCKTON

AVENUE

DWG-1078

H-6790

F-9366

7

6

5

4

NOT A PART OF THIS SUBDIVISION POR. SEC. 34

H-6726

F-10521

3

2

1

San Simeon Way

POR. NE 1/4 OF SW 1/4 SEC. 34

T.2 S. R. 5 W. S. B. B. M.

H. C. P. E. T. E. R. S.

TRACT

M.B. 22/99, REC. RIV. CO.

POR. NE 1/4 OF SW 1/4 SEC. 34

T.2 S. R. 5 W. S. B. B. M.

AVENUE

CENTRAL