


SCALE
HOR. 1" = 60'
VERT. 1" = 6'

ROSSMUIR ST.

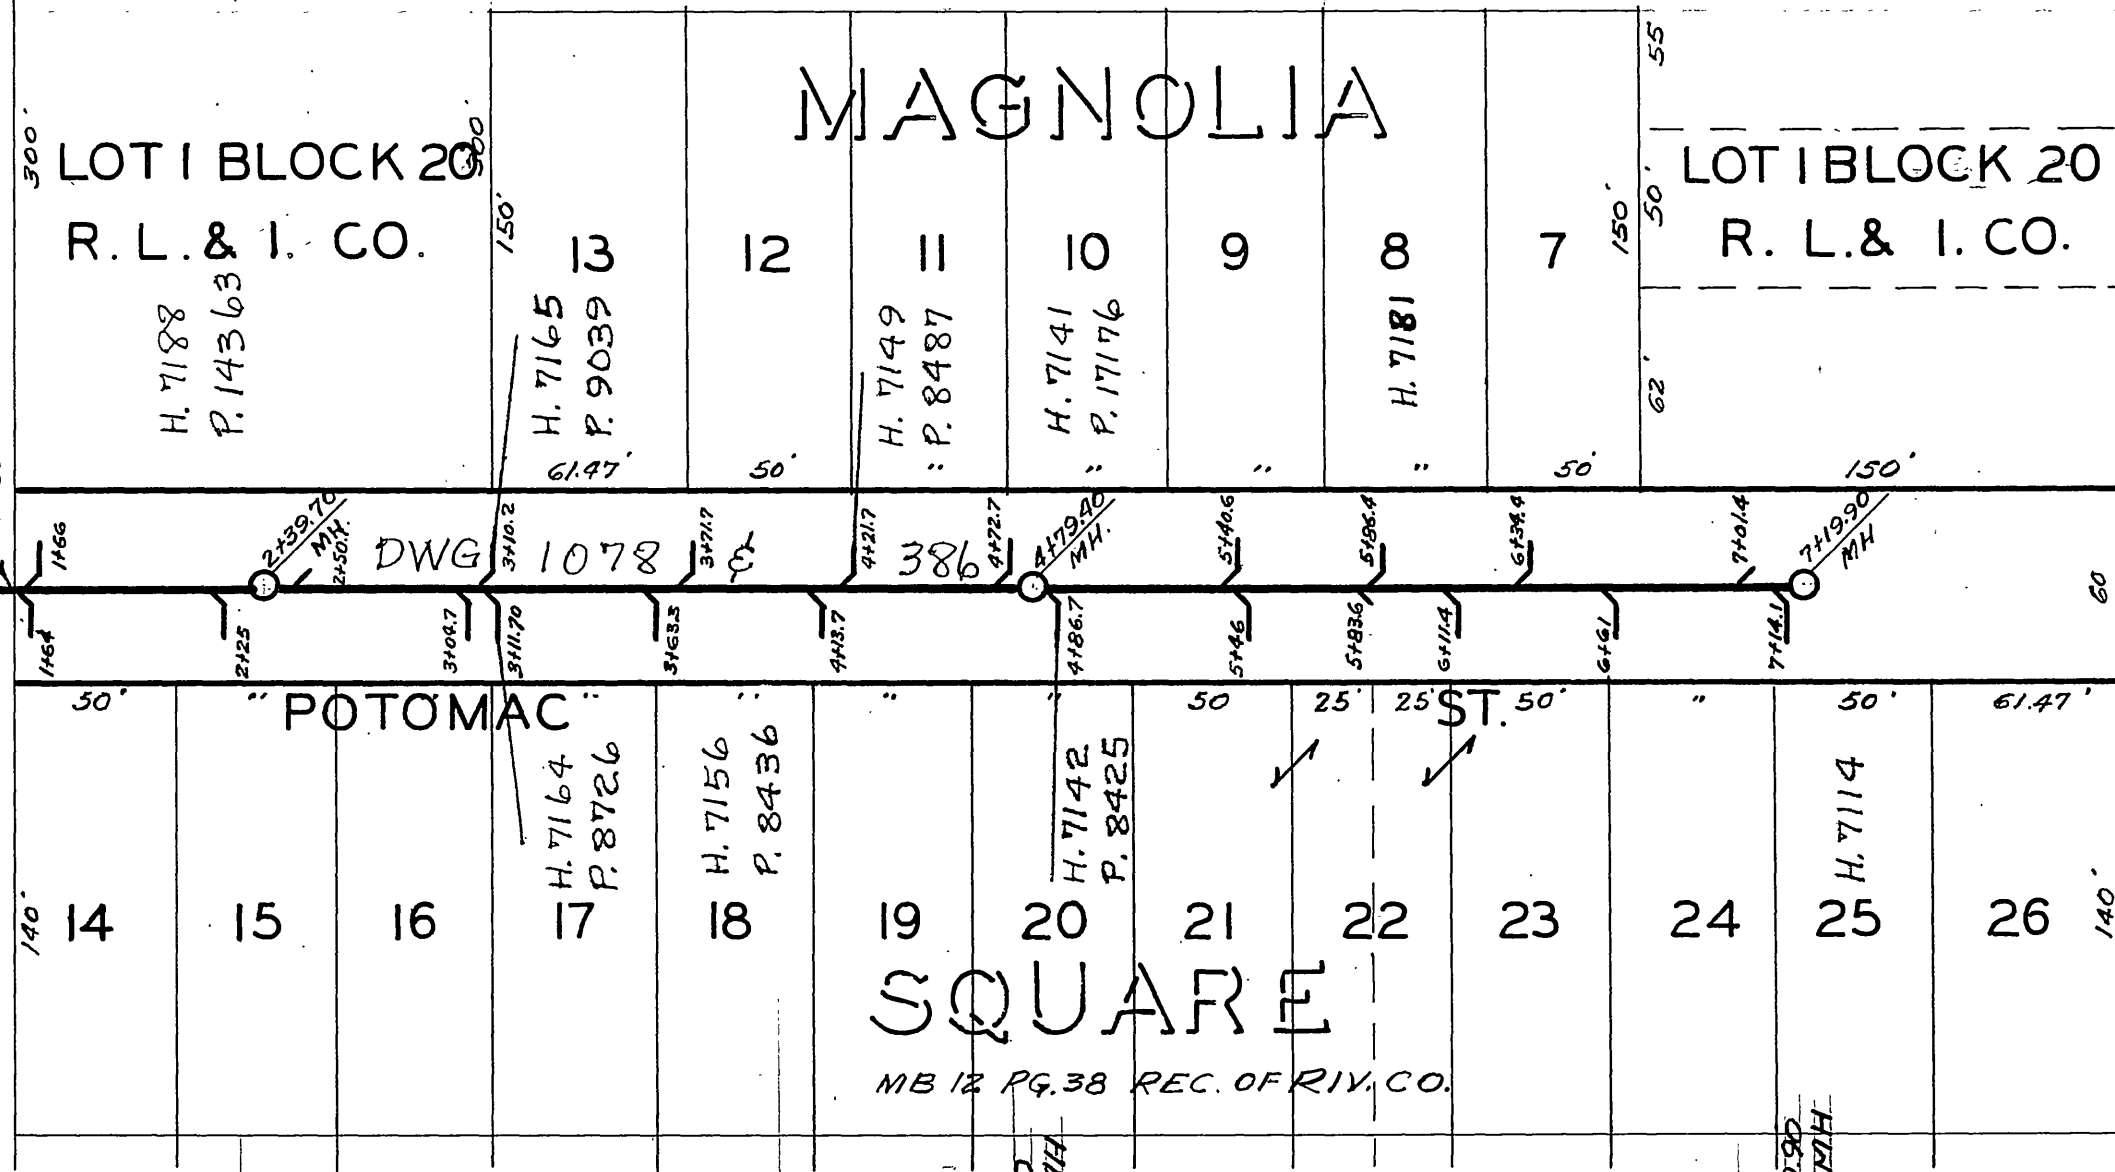

80'

WASHINGTON

