


FB 583-22
 BM 834.73 N&T IN SO. CURB ARLINGTON
 5'E. OF C.B. AT MAGNOLIA

VERT. SCALE 1 IN = 5 FT.

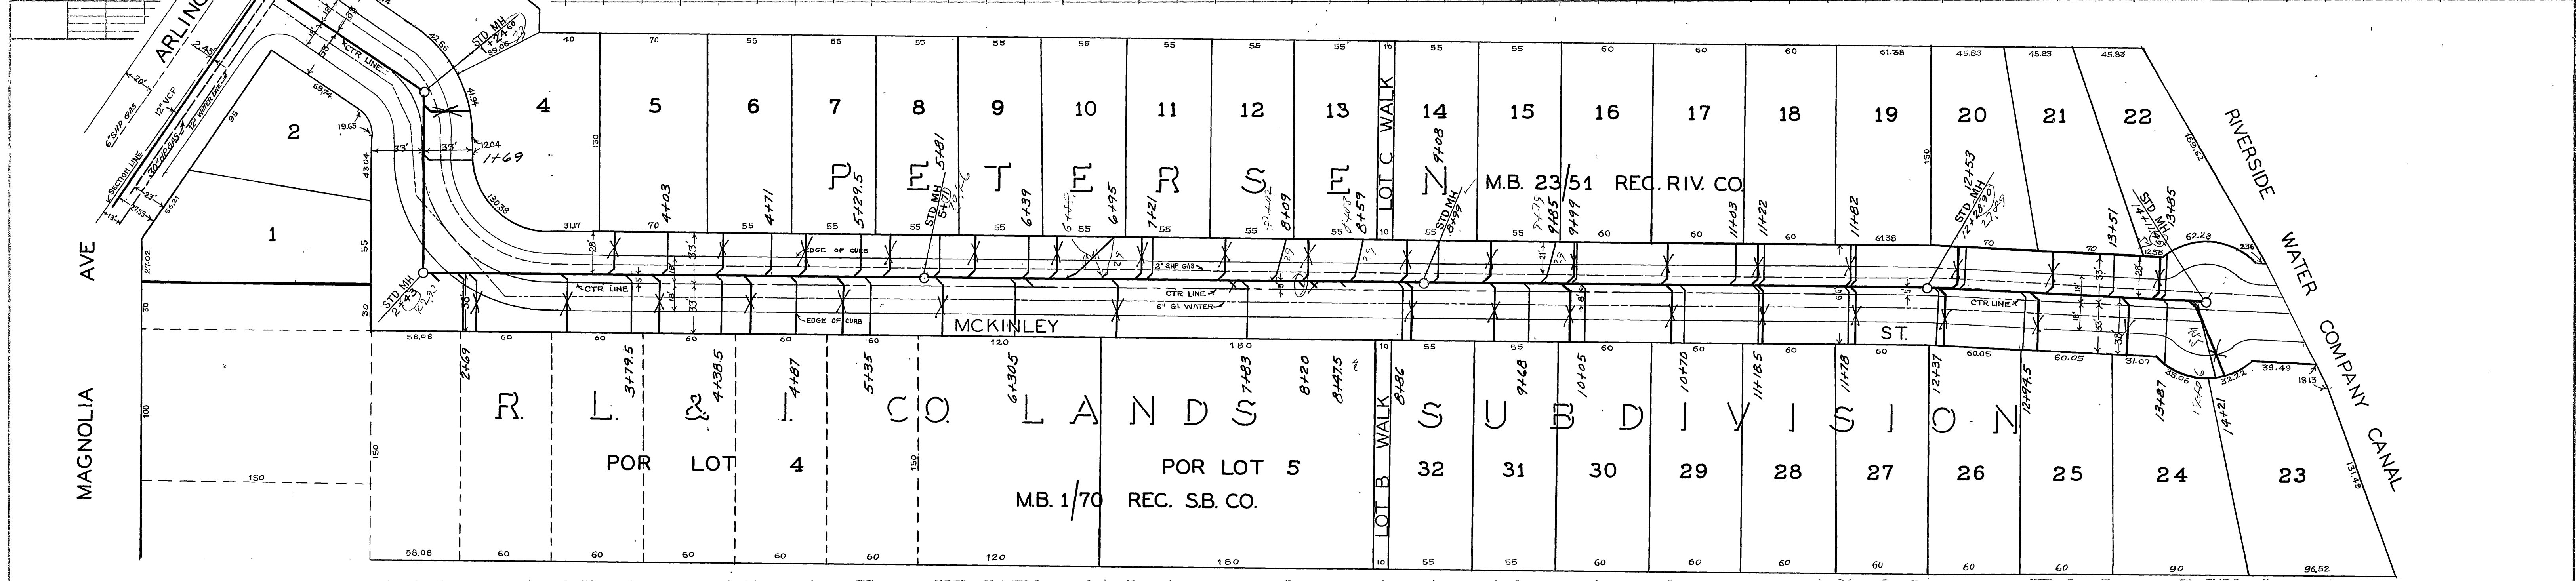

SCALE : 1" = 50'

216

CITY OF RIVERSIDE CALIFORNIA
 DEPARTMENT OF PUBLIC WORKS

MCKINLEY STREET
 SANITARY
 SEWER DISTRICT

APPROVED BY
 [Signature]
 DIRECTOR OF PUBLIC WORKS

ENGINEER
 [Signature]
 DATE Feb 8, 1956

S-10
 SHEET 1 OF 1

PROFILE	
NO.	DATE

PLAN	
NO.	DATE