
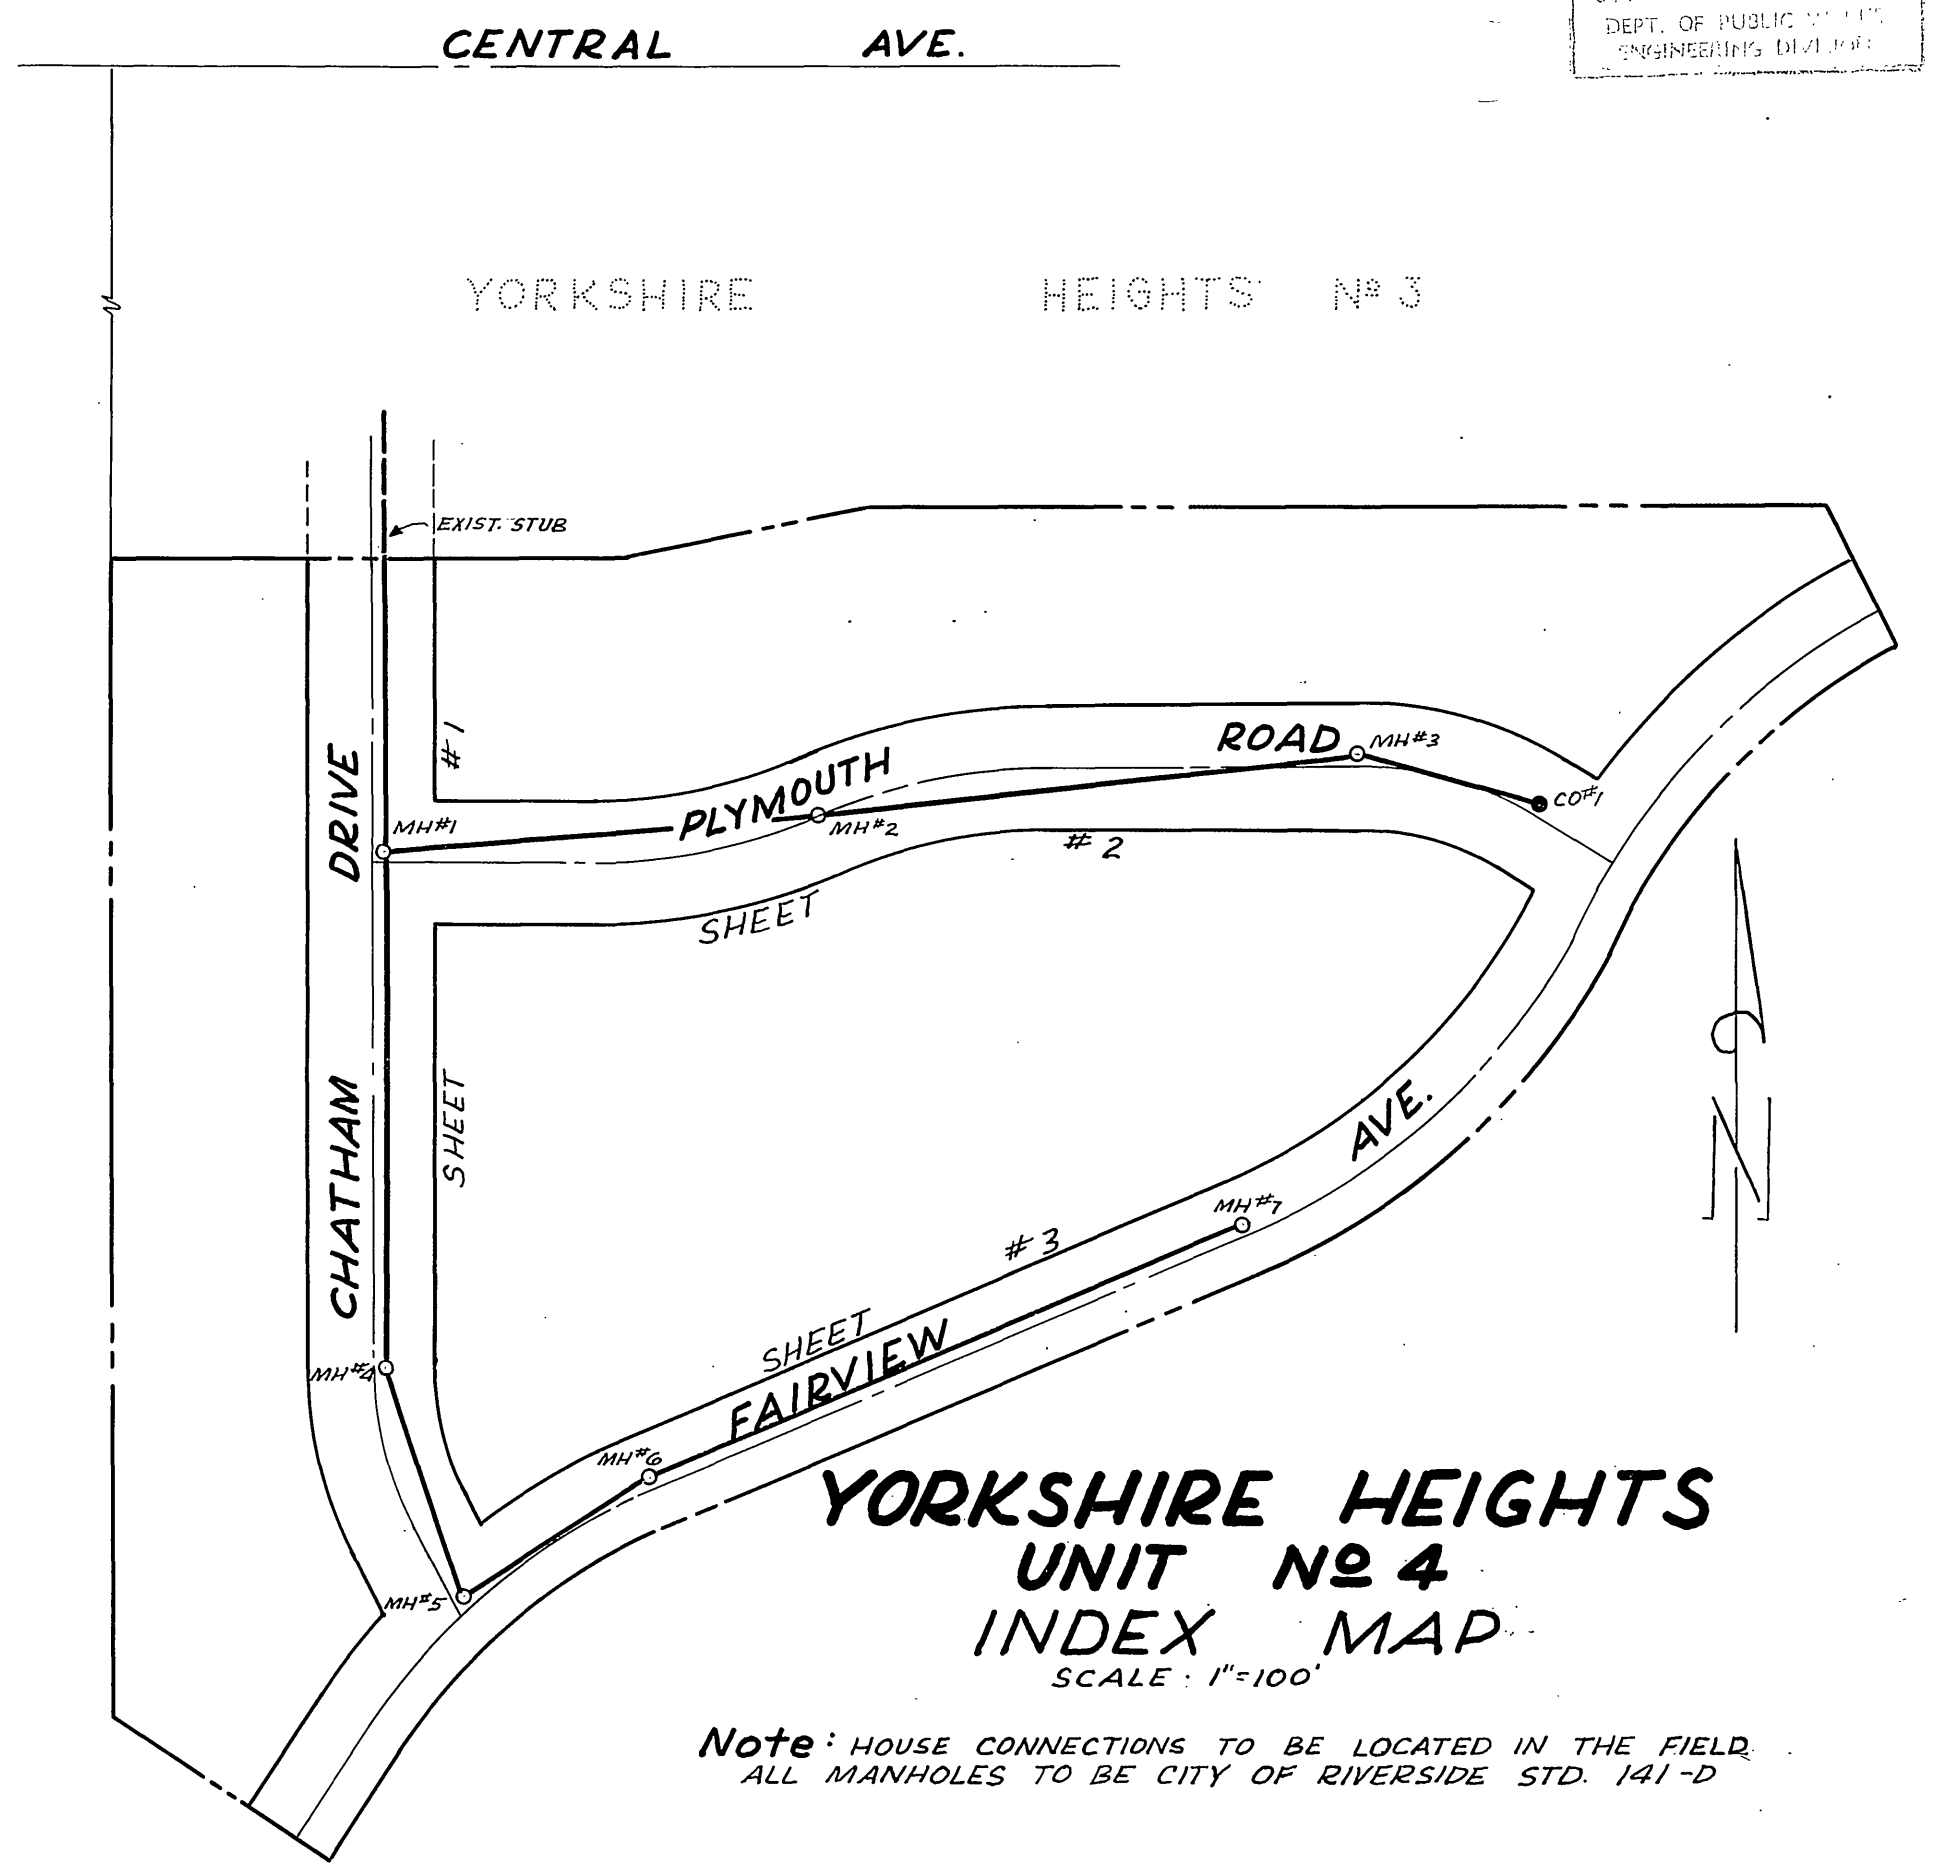


**CHATHAM DRIVE**

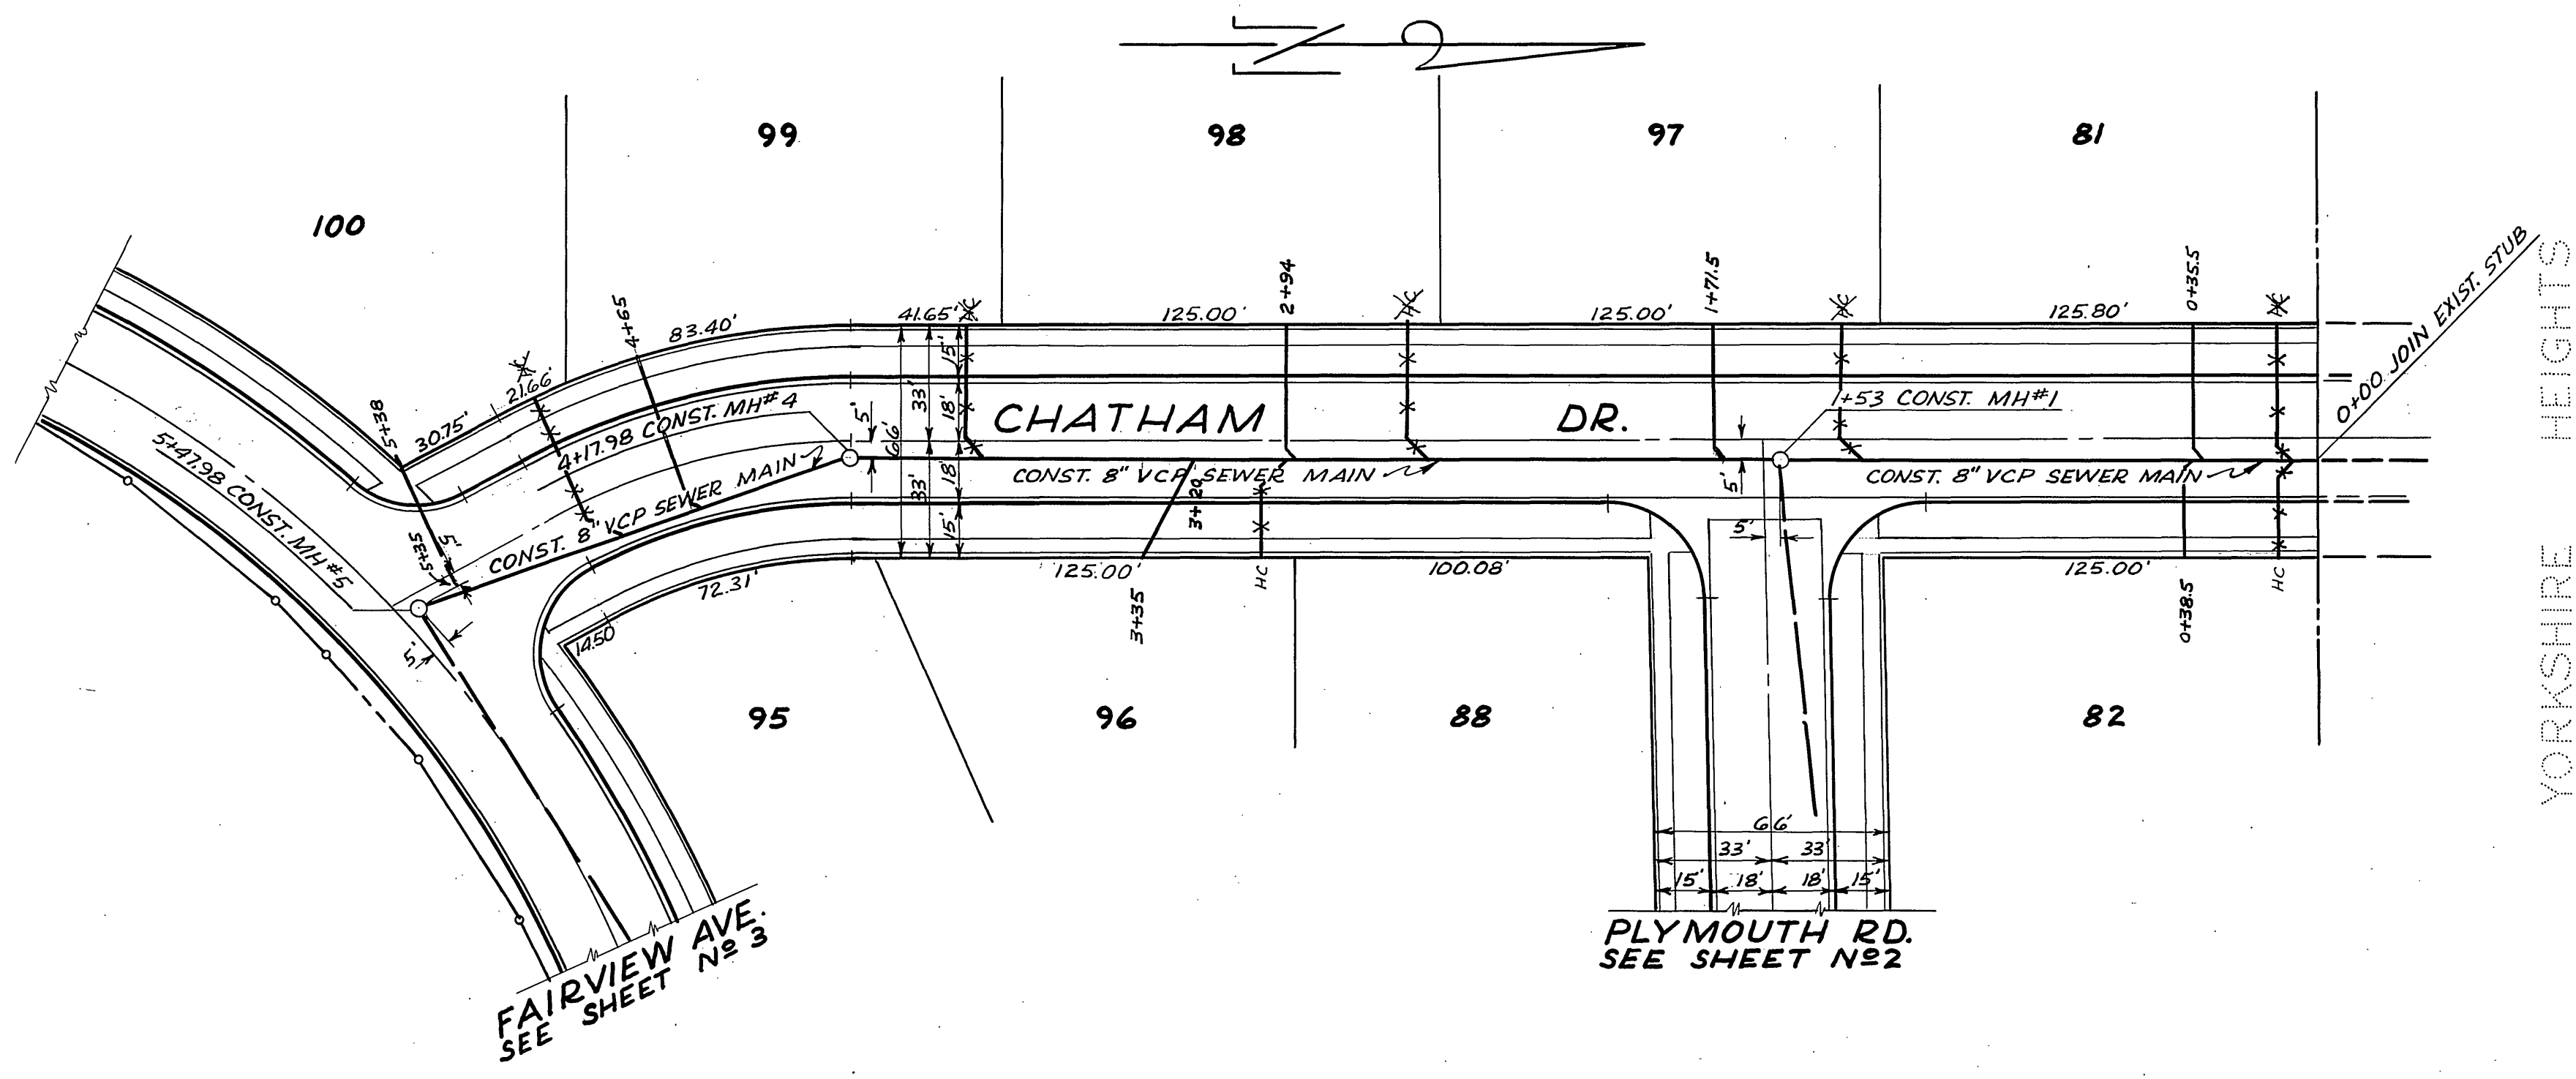

ESTIMATED SEWER QUANTITIES	
8" VCP	1583 L.F.
4" VCP	645 L.F.
MANHOLES	7 EA.
CLEANOUT	1 EA.

**BENCH MARK**  
 TOP OF 2" I.P. (CAPPED) AT & INT.  
 VICTORIA & CENTRAL, PER CITY F.B.  
 493/16. ELEV. 947.508


As Built H.C.S. Sept. 3, 58 H.Ball  
 GRADES Revised Aug. 11, 1958

RAYMOND L. QUIGLEY - REGISTERED ENGINEER 7191  
 BULOT, QUIGLEY & CLARK INC. SANTA ANA, CALIFORNIA  
 APPROVED BY: [Signature] DATE: SEPT. 17, 1957

CITY OF RIVERSIDE, CALIFORNIA  
 DEPARTMENT OF PUBLIC WORKS


**SEWER PLAN & PROFILE OF  
 YORKSHIRE HEIGHTS UNIT 4  
 CHATHAM DRIVE**

HORIZONTAL SCALE: 1"=40' VERTICAL SCALE: 1"=8'  
 APPROVED BY: [Signature] NO. S-100  
 DIRECTOR OF PUBLIC WORKS SHEET 1 OF 3  
 DATE: Sept. 15, 1957

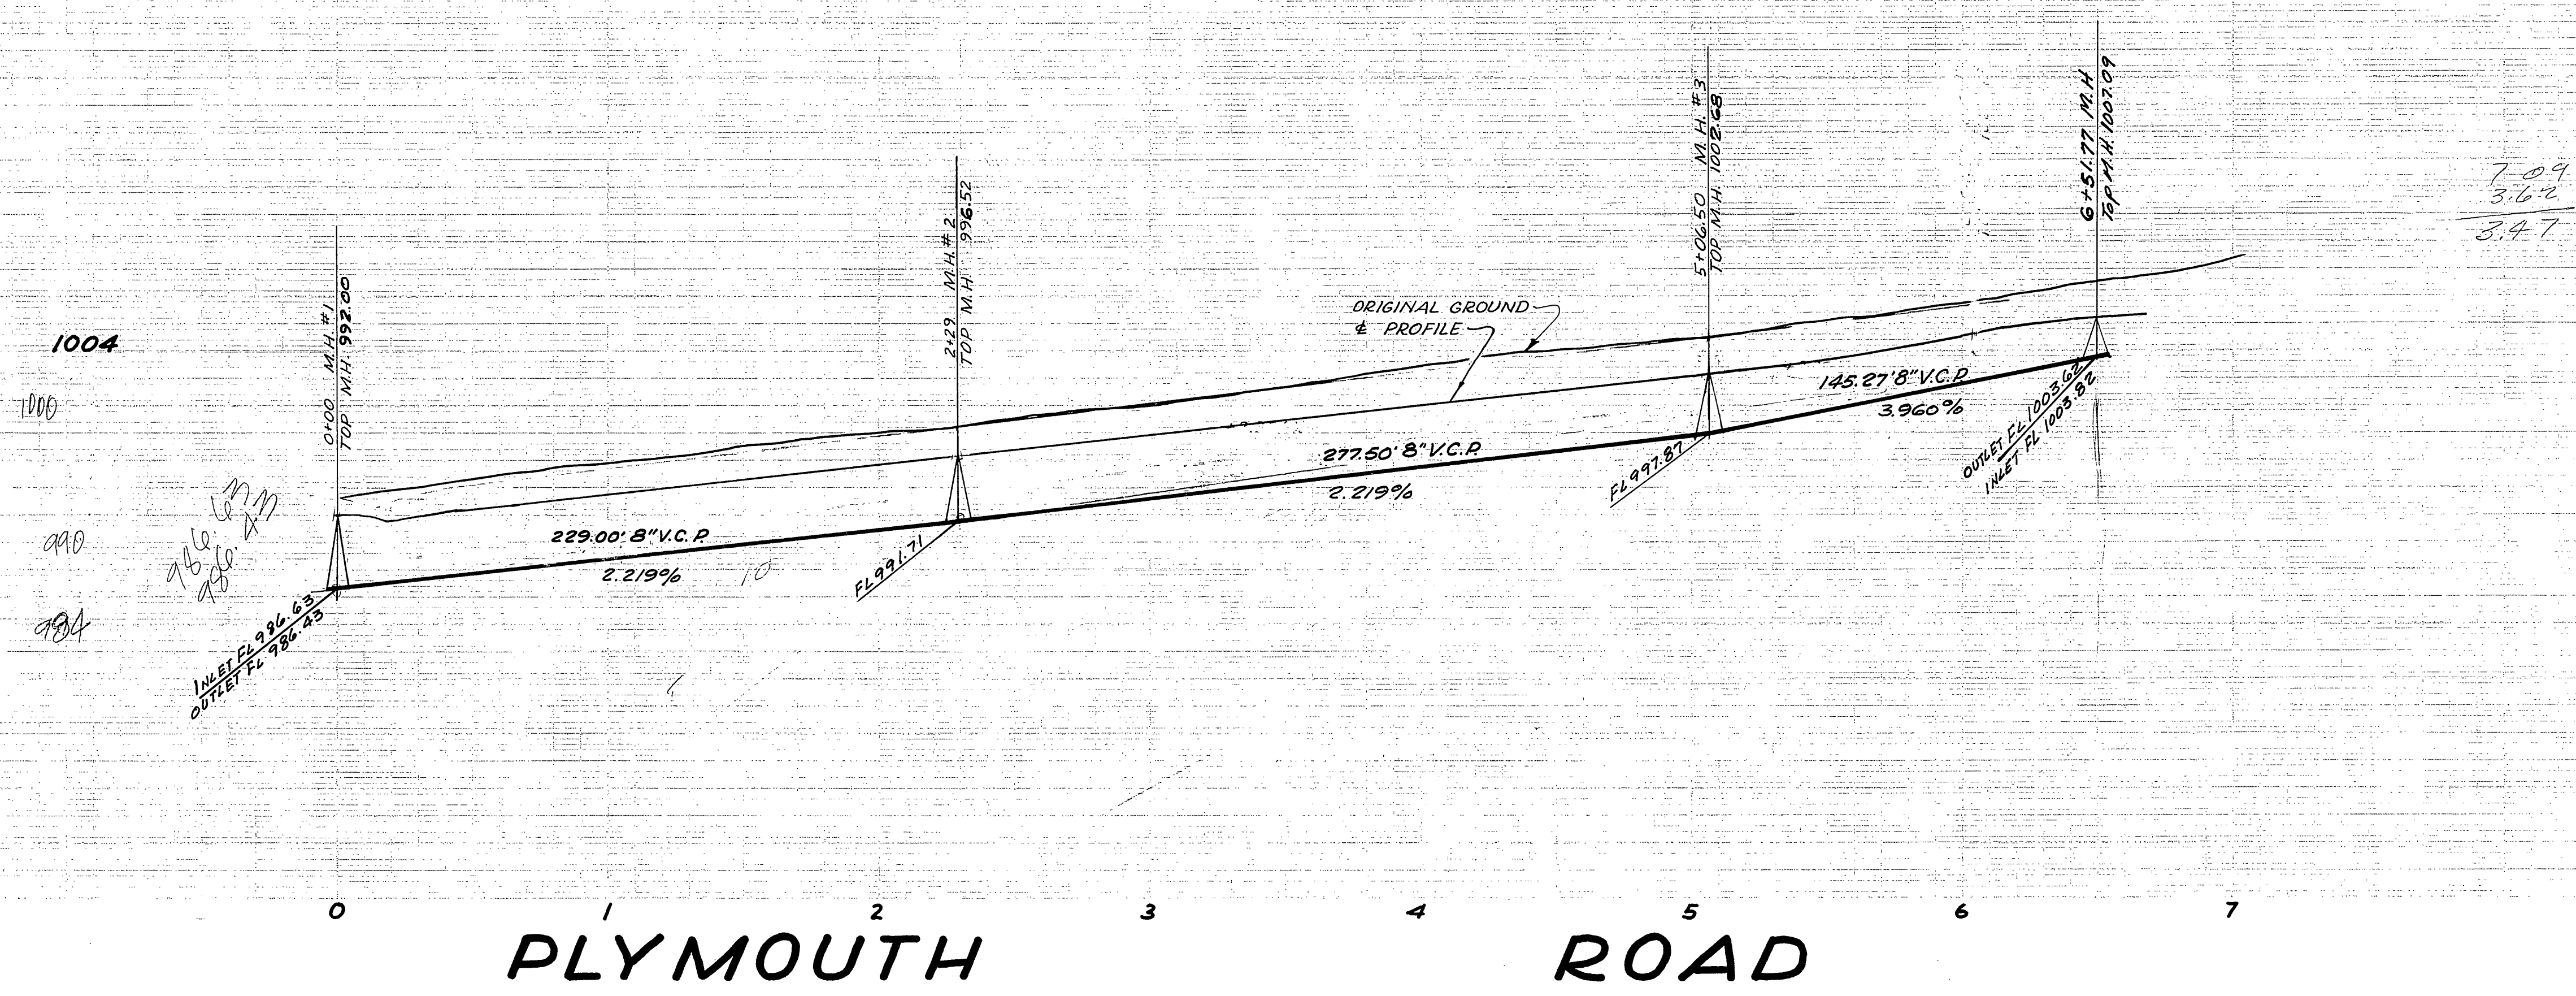


7.09  
3.62  
3.47

PLYMOUTH ROAD

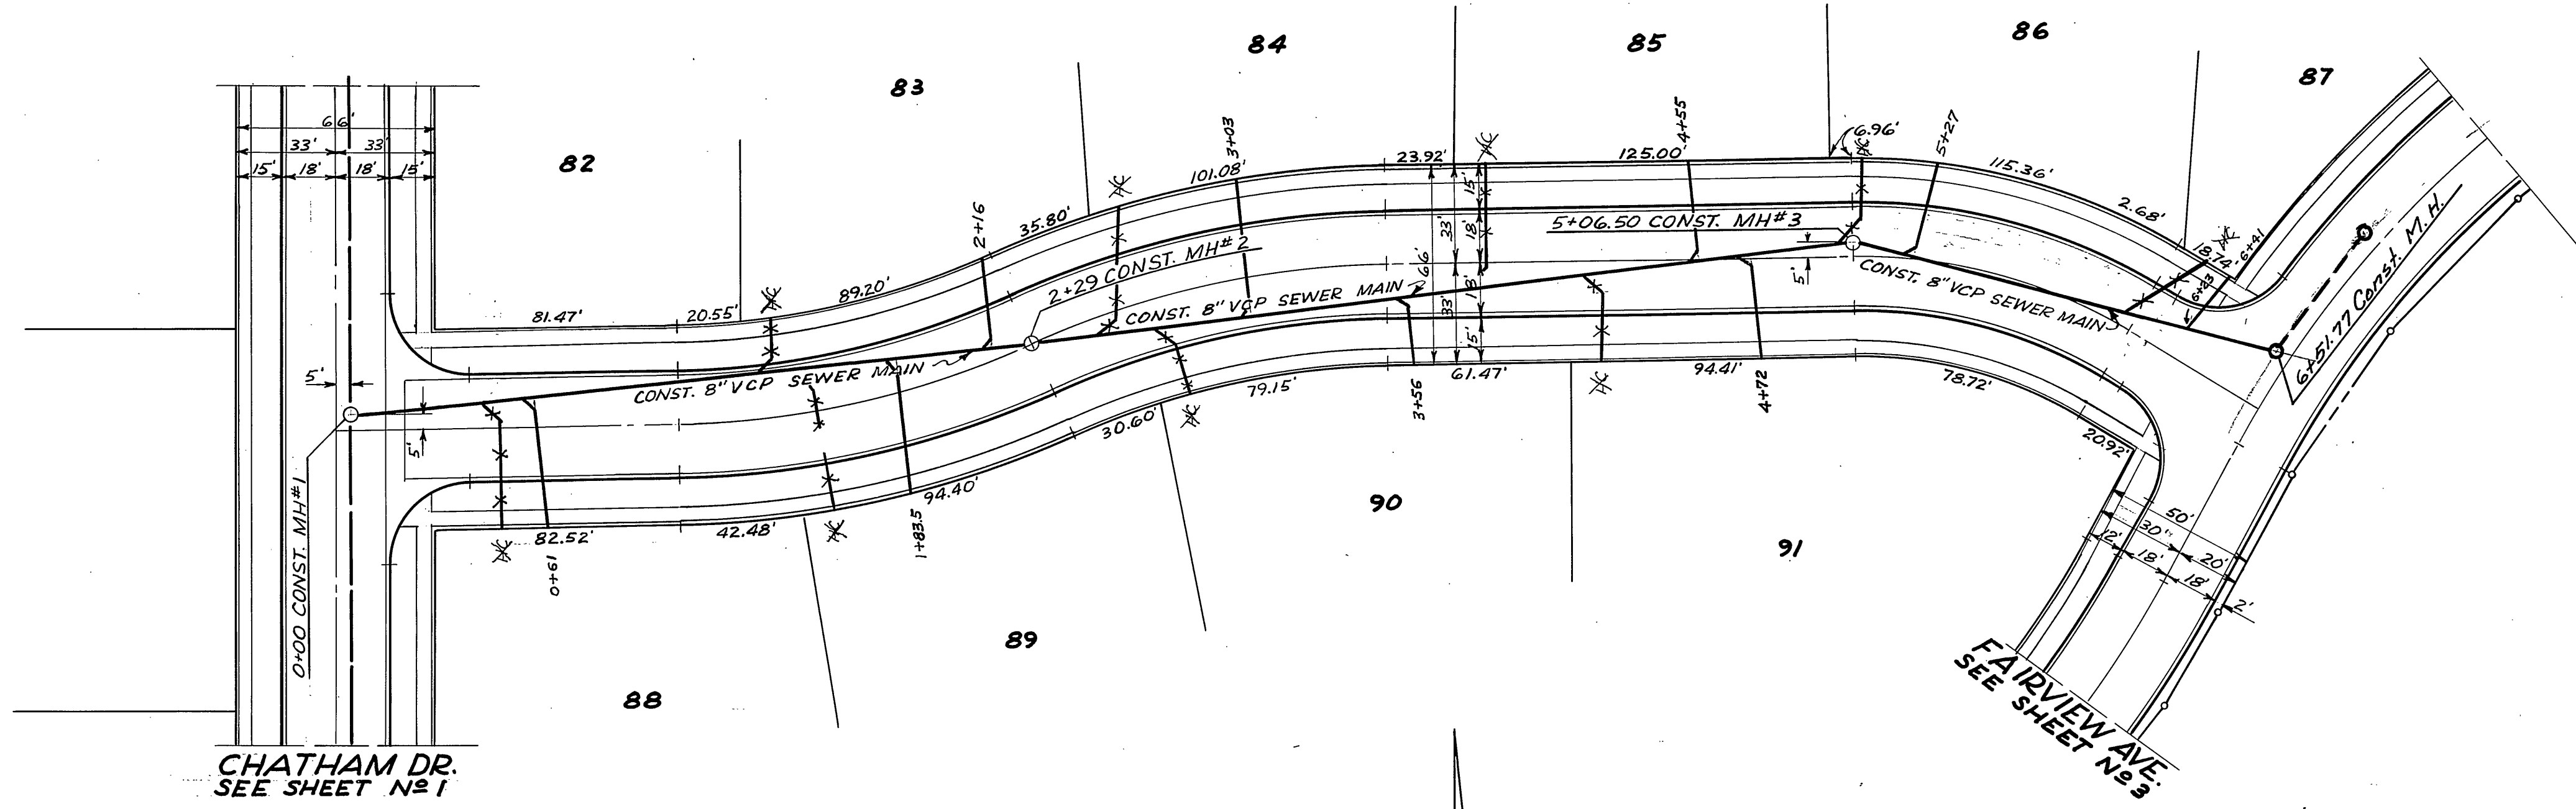

CHATHAM DR.  
SEE SHEET N<sup>o</sup> 1

FAIRVIEW AVE.  
SEE SHEET N<sup>o</sup> 3

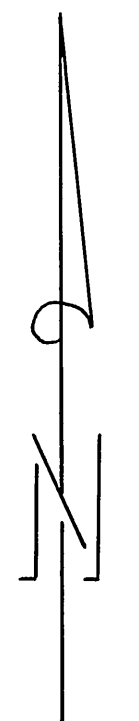

**BENCH MARK**  
TOP OF 2" I.P. (CAPED) AT & INT.  
VICTORIA & CENTRAL PER CITY RB.  
493/76. ELEV. 947.508

"As Built" H.C. & Sept. 3, '58 H. Ball  
Grades Revised Aug. 11, 1958

RAYMOND L. QUIGLEY - REGISTERED ENGINEER 7191  
BULOT, QUIGLEY & CLARK INC. - SANTA ANA, CALIFORNIA  
APPROVED BY: *Joseph A. Alvarado* REG. 10367 DATE: SEPT. 17, 1957


CITY OF RIVERSIDE, CALIFORNIA  
DEPARTMENT OF PUBLIC WORKS

**SEWER PLAN & PROFILE OF  
YORKSHIRE HEIGHTS - UNIT 4  
PLYMOUTH ROAD**


HORIZONTAL SCALE - 1"=40' VERTICAL SCALE - 1"=8'

APPROVED BY: *R. M. O'Connell*  
DIRECTOR OF PUBLIC WORKS  
DATE: 8-6-57 13, 1957

N<sup>o</sup> S-100  
SHEET 2 OF 3 SHEETS

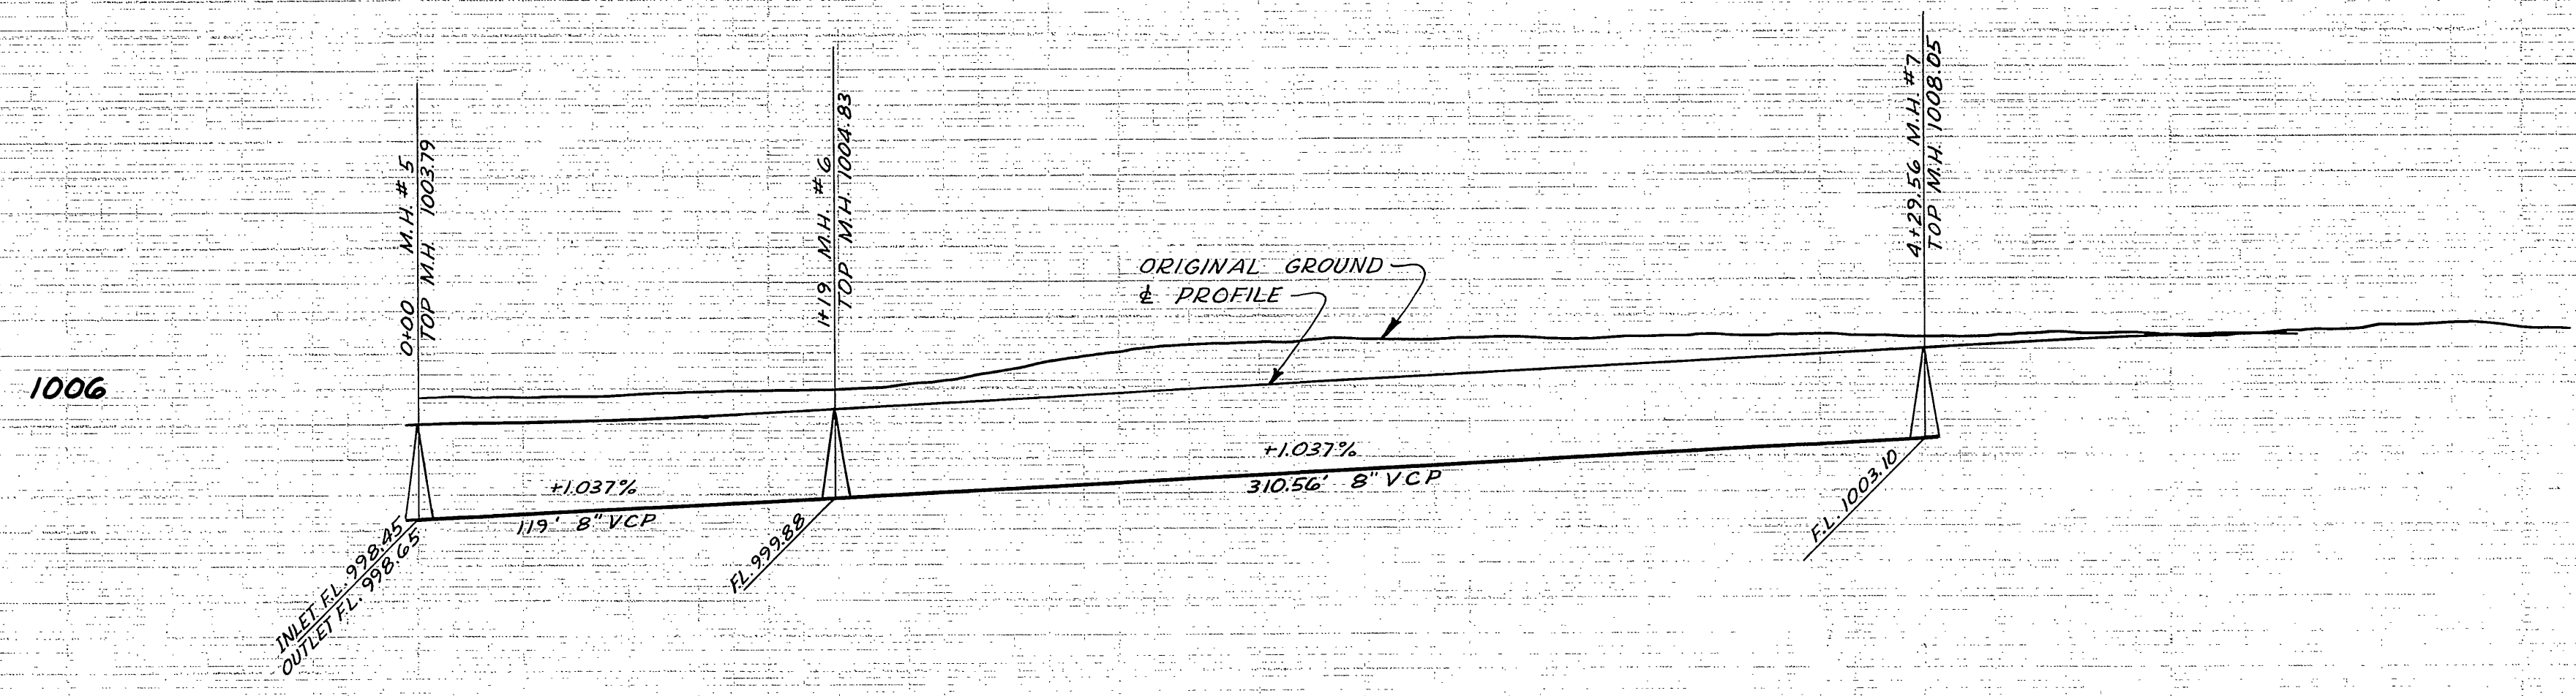

0 1 2 3 4 5  
**FAIRVIEW AVENUE**

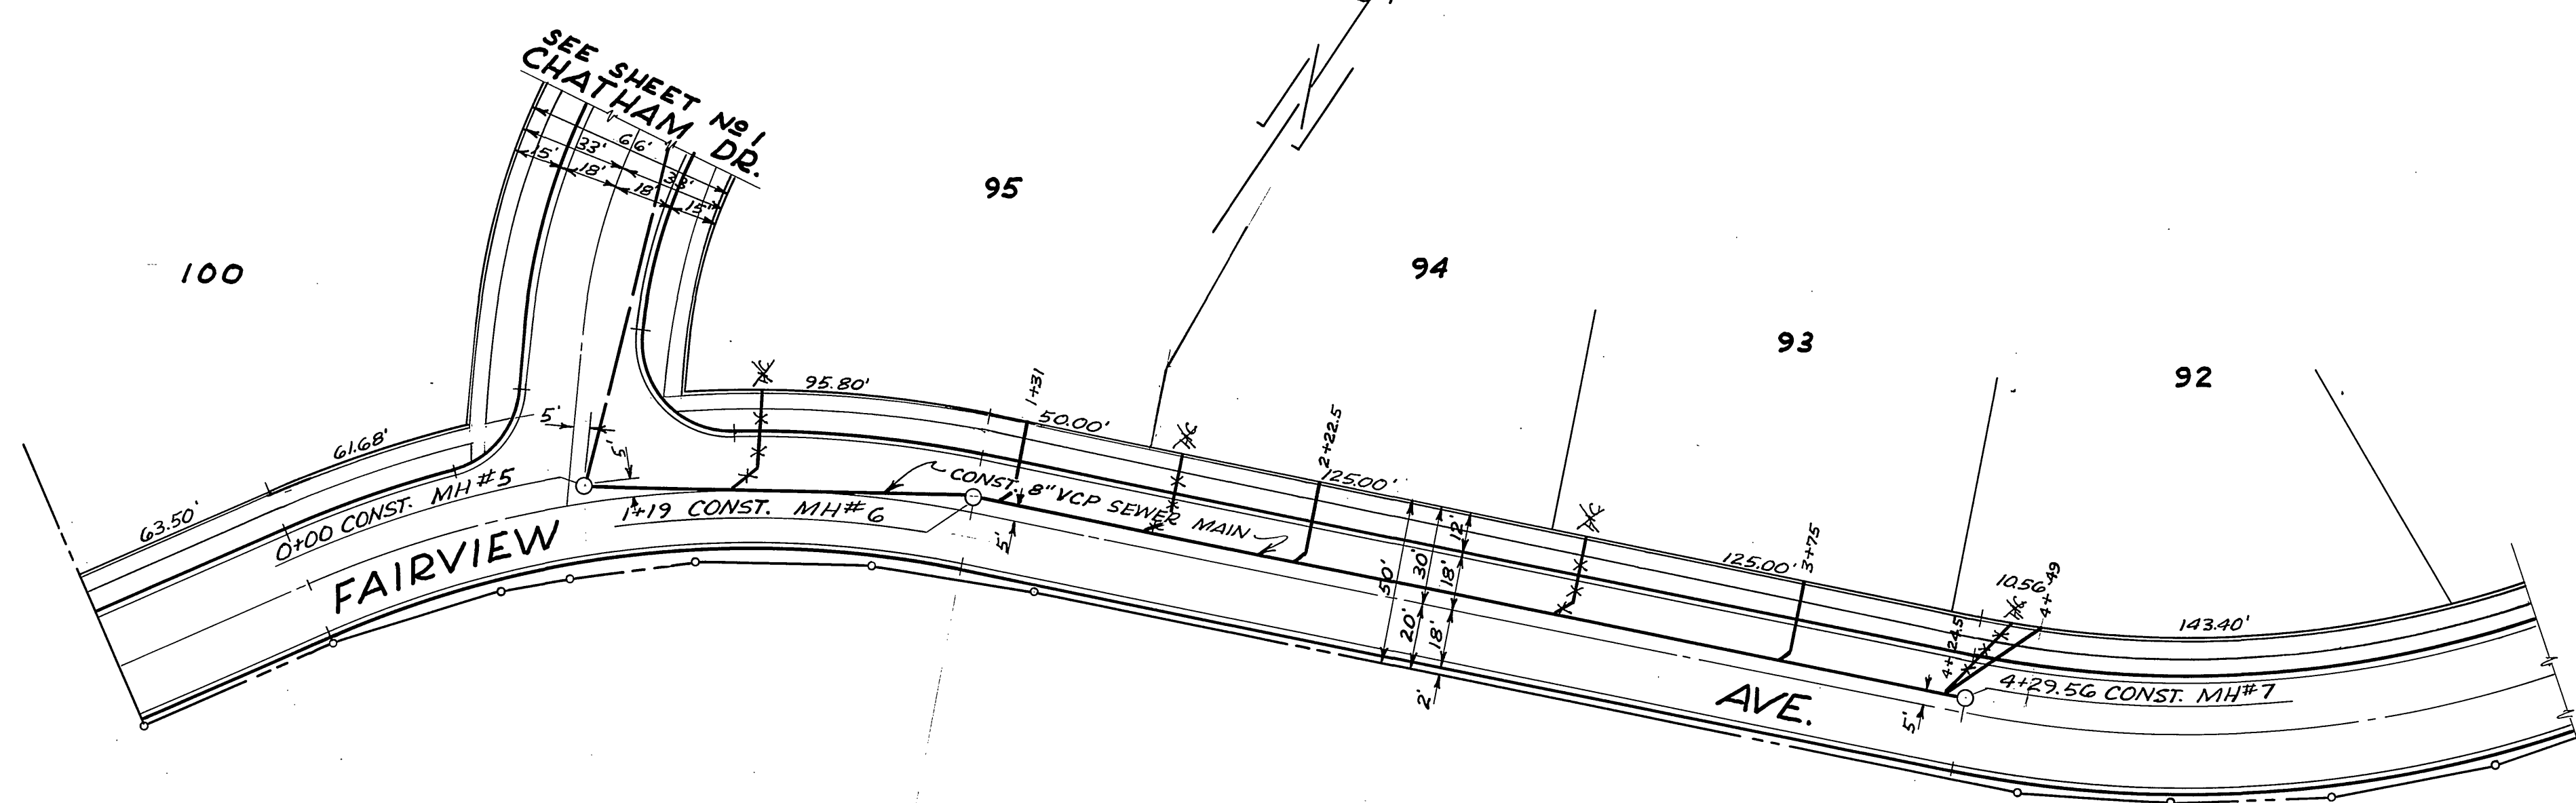

**BENCH MARK**  
TOP OF 2" I.P. (CAPPED) AT & INT.  
VICTORIA & CENTRAL, PER CITY F.B.  
493/76. ELEV. 947.508

As Built H.C. - Sept. 3, '58 - H. Ball  
Grades Revised Aug. 11, 1958

RAYMOND L. QUIGLEY - REGISTERED ENGINEER 7191  
BULOT, QUIGLEY & CLARK INC. SANTA ANA, CALIFORNIA  
APPROVED BY: [Signature] DATE: SEP 17, 1957

CITY OF RIVERSIDE, CALIFORNIA  
DEPARTMENT OF PUBLIC WORKS

**SEWER PLAN & PROFILE OF  
YORKSHIRE HEIGHTS - UNIT 4  
FAIRVIEW AVENUE**

HORIZONTAL SCALE: 1" = 40' VERTICAL SCALE: 1" = 8'

APPROVED BY: [Signature]  
DIRECTOR OF PUBLIC WORKS  
DATE: 2-17-18, 1957

No S-100  
SHEET 3 OF 3 SHEETS