


PROPERTY OF  
CITY OF ARLINGTON  
ENGINEERING DEPARTMENT


DATE  
DRAWN BY  
CHECKED BY

745  
740

745

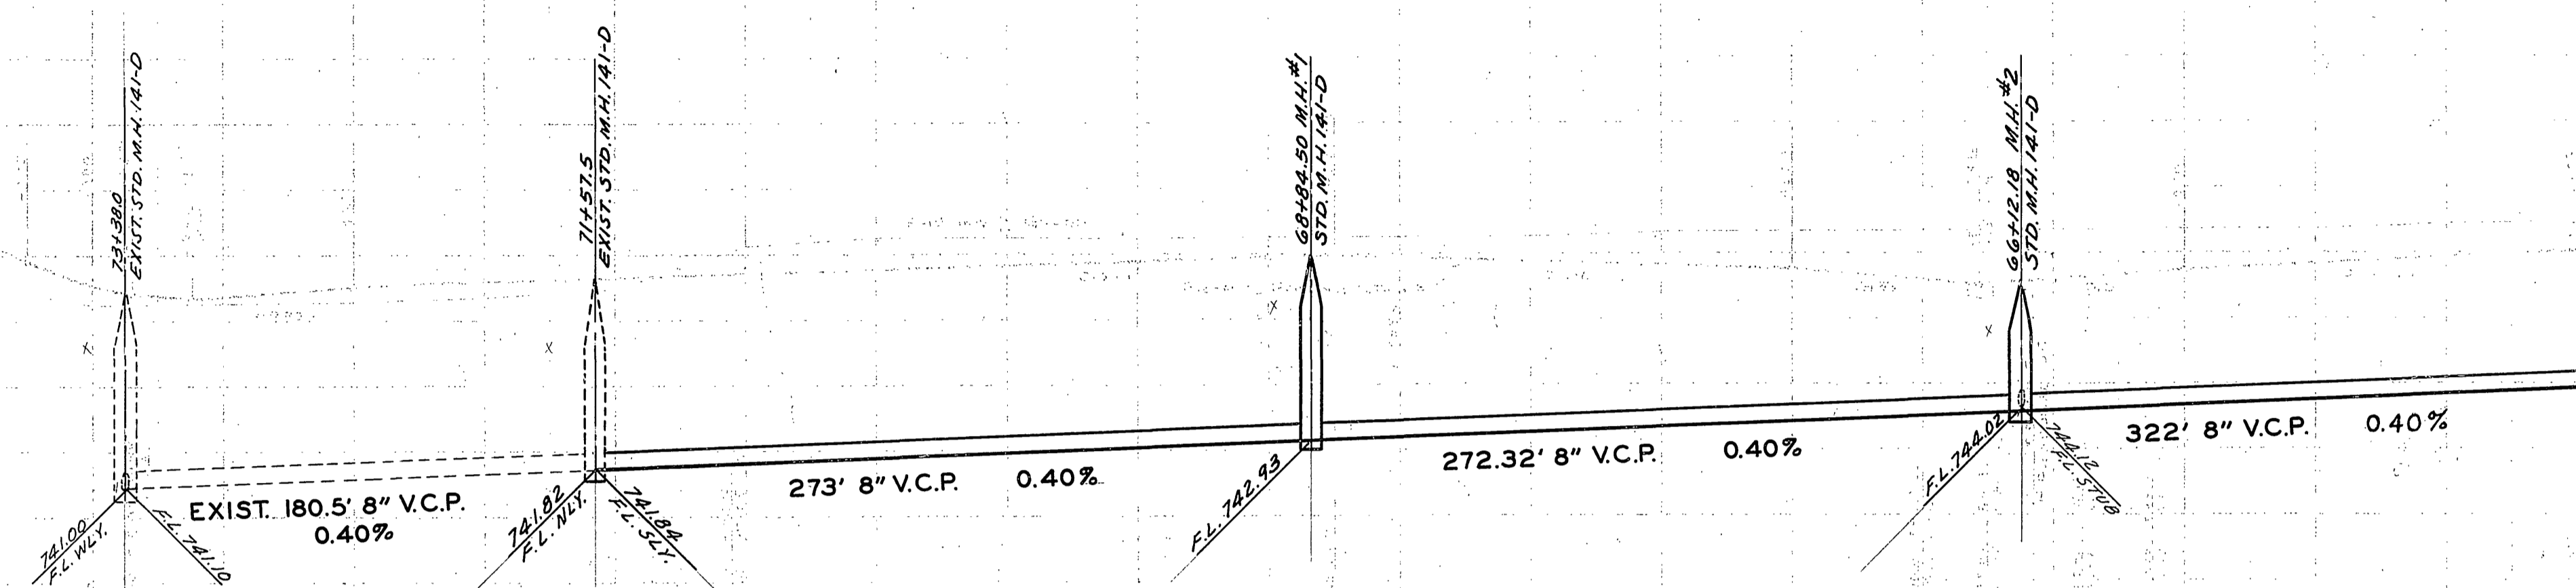

6/165 FOR SEWER

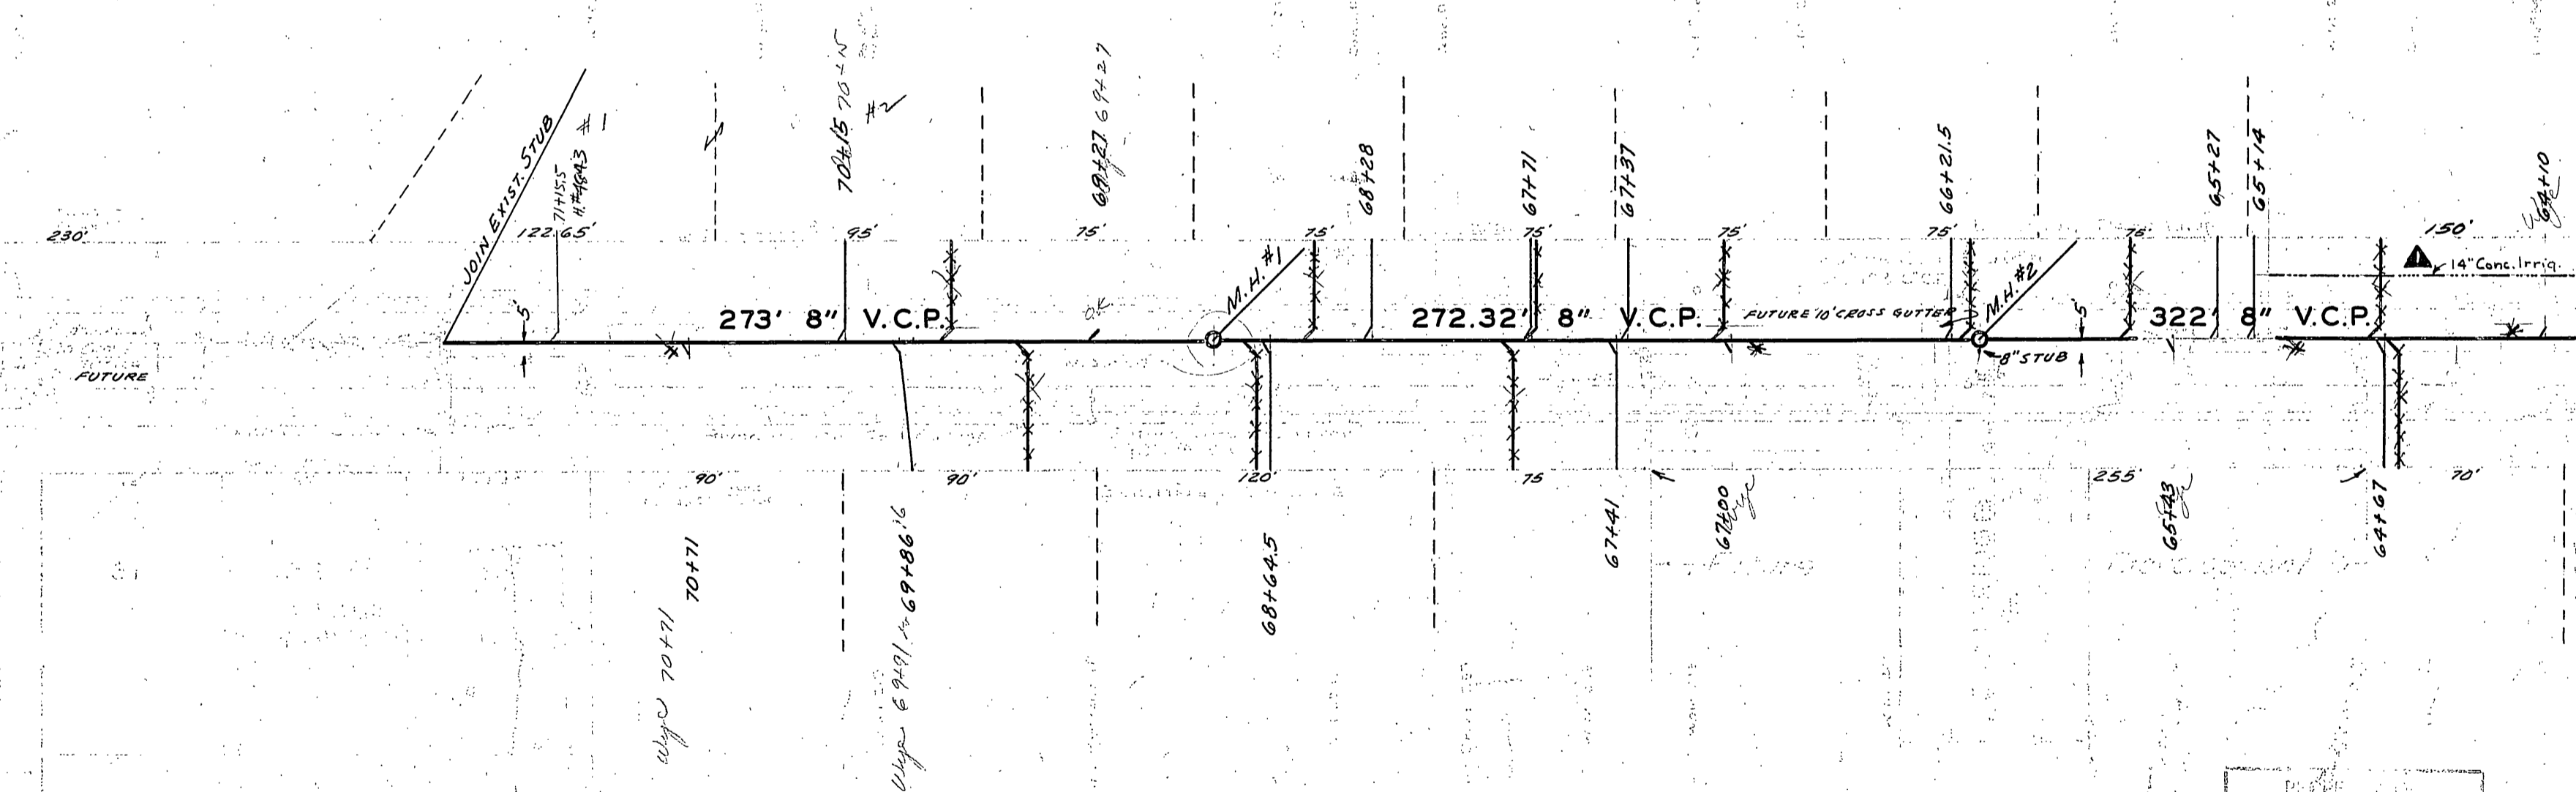

**NOTE:**

1. CONTRACTOR SHALL FURNISH MANHOLE CASTINGS AND LIDS.
2. CONTRACTOR SHALL CONSTRUCT MANHOLES TO 16" BELOW PAVING GRADE AND COVER WITH 2" PLANKING. MANHOLES WILL BE RAISED TO GRADE BY OTHERS.
3. LOCATE WYES AND LATERALS IN FIELD.
4. PAVEMENT WILL BE REPLACED BY OTHERS. CONTRACTOR SHALL PUT DUST CAP OVER BACK-FILLED TRENCH.
5. MONROE STREET HAS BEEN LOWERED AND SUB BASE HAS BEEN INSTALLED TO ROUGH PAVING GRADE.

2/7/58 Add note #5 on  
4-30-58 Added 14" CONC. IRRIG. LINE


MONROE STREET  
SANITARY SEWER DISTRICT  
BETWEEN  
ARLINGTON AVE. & COLORADO AVE.

D.R.B.  
C.N.  
J.L.B.  
Thomas J. Lofgren


Dec 10, 1957

S-106  
1 2

PROPERTY OF  
CITY OF ARLINGTON  
ENGINEERING DEPARTMENT

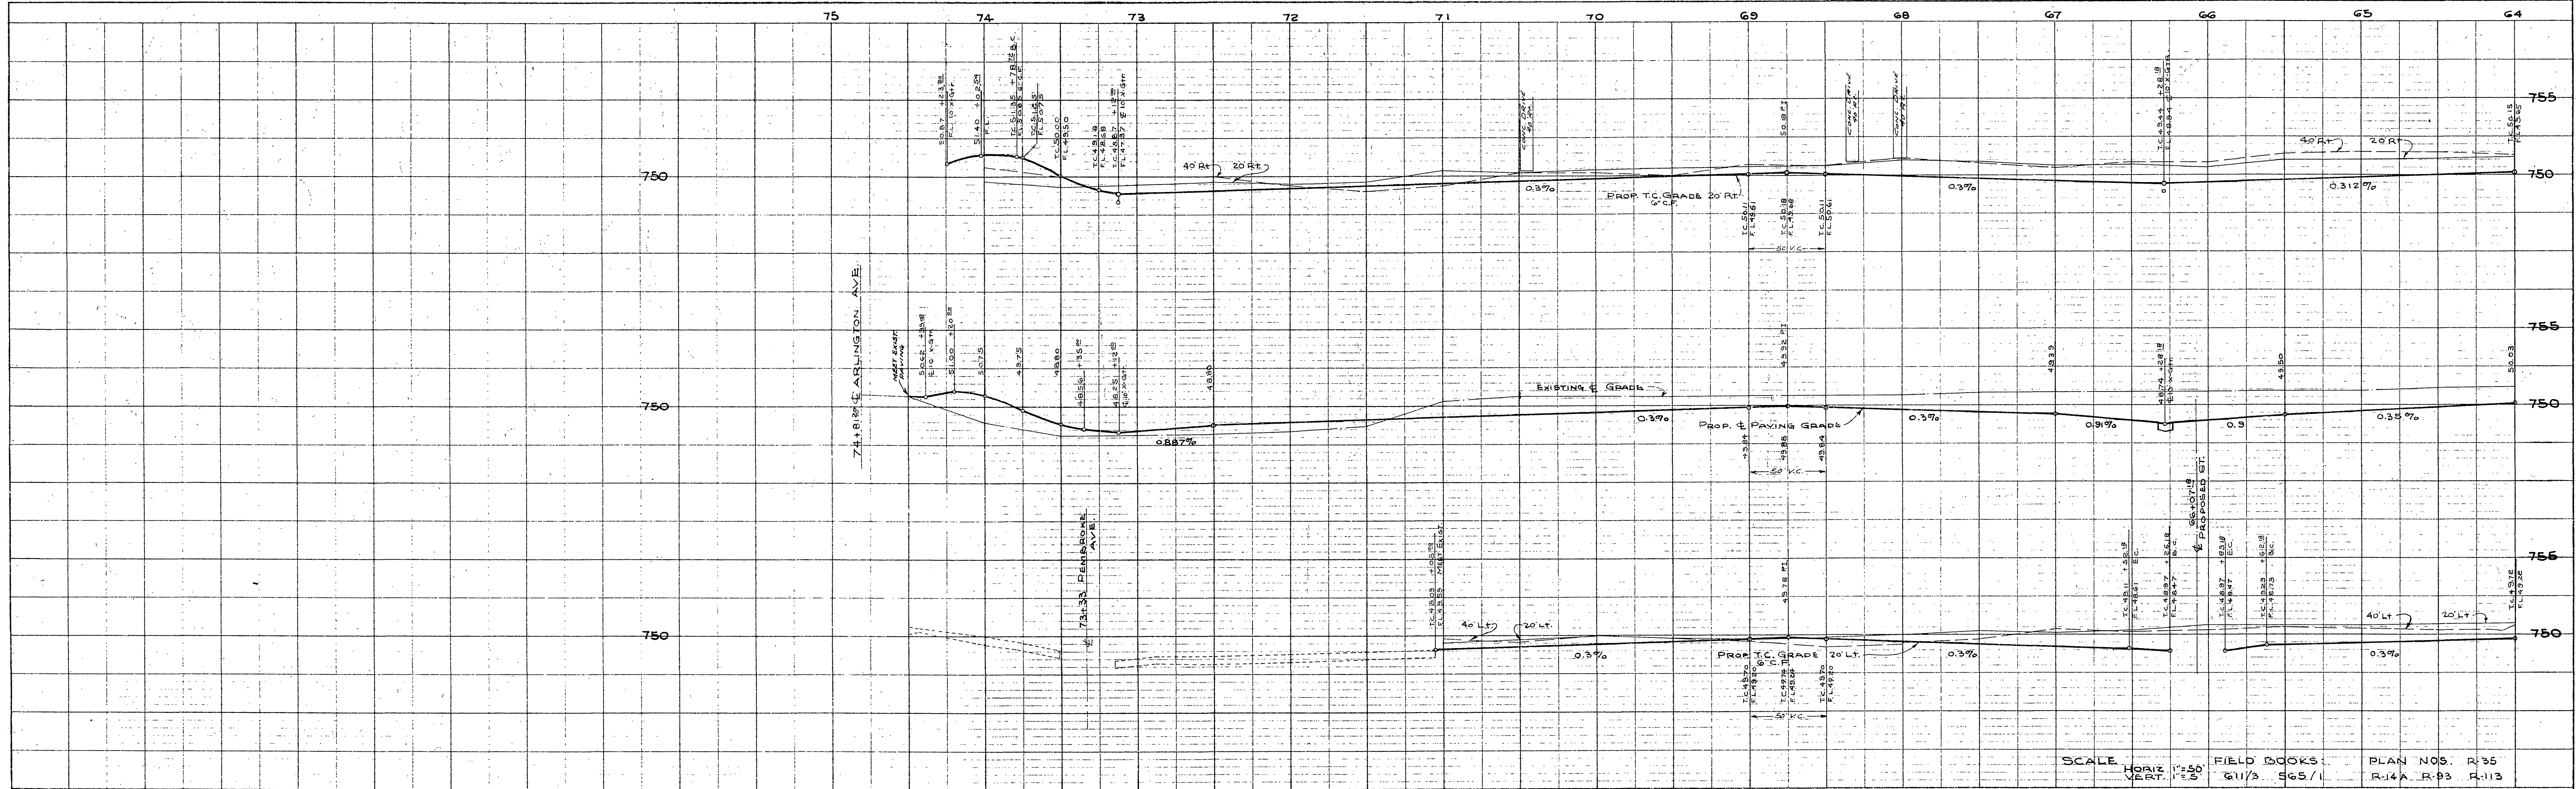

SCALE HORIZ. 1" = 50'  
 VERT. 1" = 5'  
 FIELD BOOKS: G11/3 S65/1  
 PLAN NOS. R-35  
 R-14 R-93 R-113



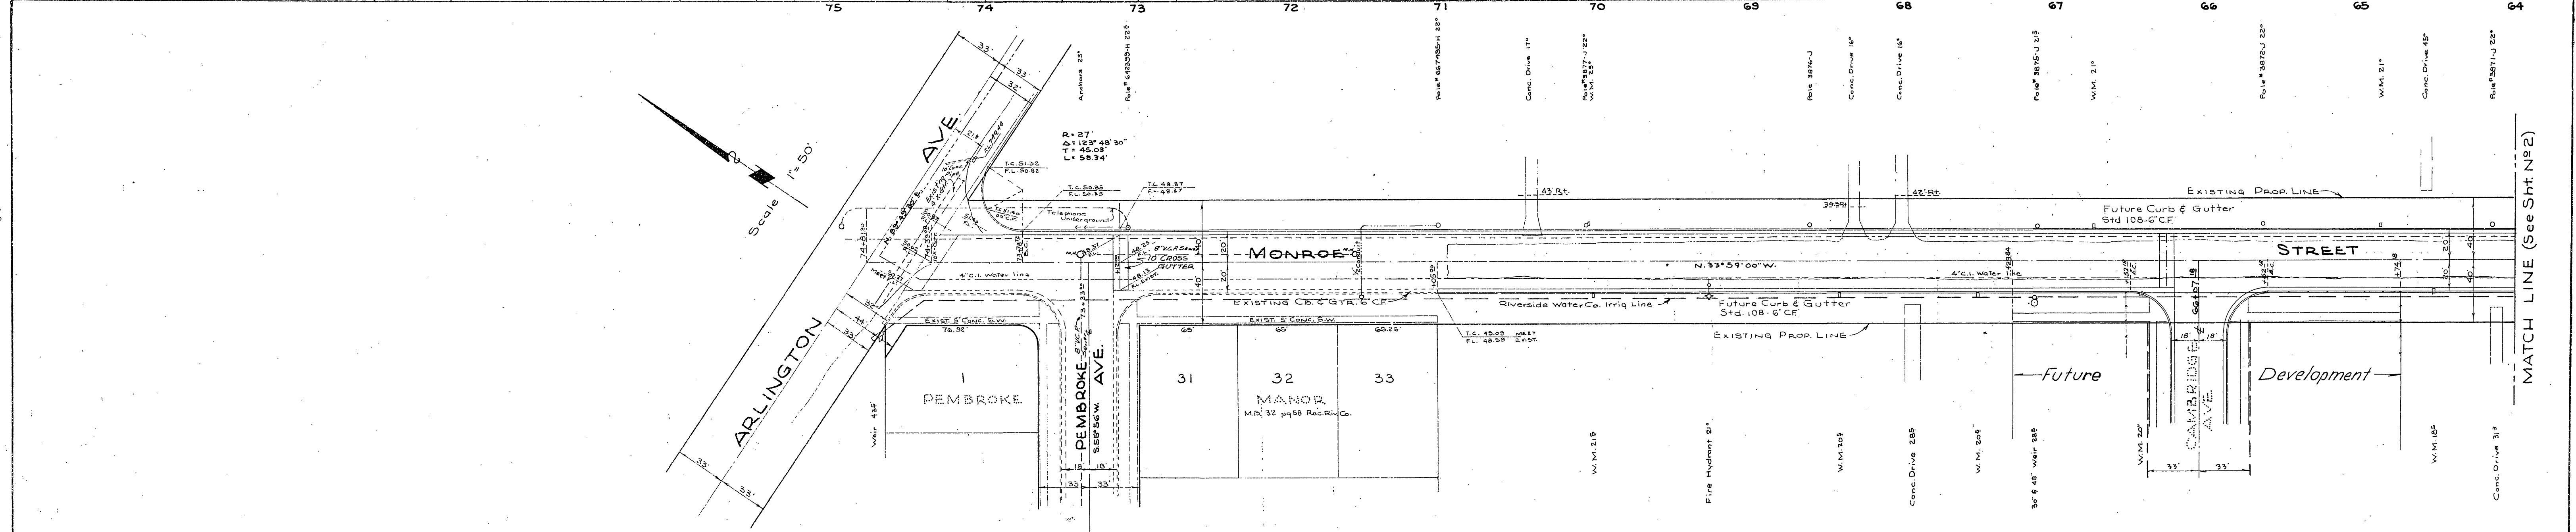


PROFILE	SURVEYED	BY	DATE
NOTE BOOK	PLOTTED		
BY	ALIGNED		
STRUCTURE NOTATION'S CH'G	CHECKED		

PLAN	SURVEYED	BY	DATE
NOTE BOOK	PLOTTED		
BY	ALIGNED		
STRUCTURE NOTATION'S CH'G	CHECKED		

REVISIONS		CITY OF RIVERSIDE CALIFORNIA DEPARTMENT OF PUBLIC WORKS	
MARK	DATE	DESCRIPTION	
DESIGNED BY	CHECKED BY	APPROVED BY	
DRAWN BY		DIRECTOR OF PUBLIC WORKS	
RECOMMENDED BY	ASSISTANT CITY ENGINEER	DATE	SHEET OF

PROPERTY OF  
CITY OF  
DENVER

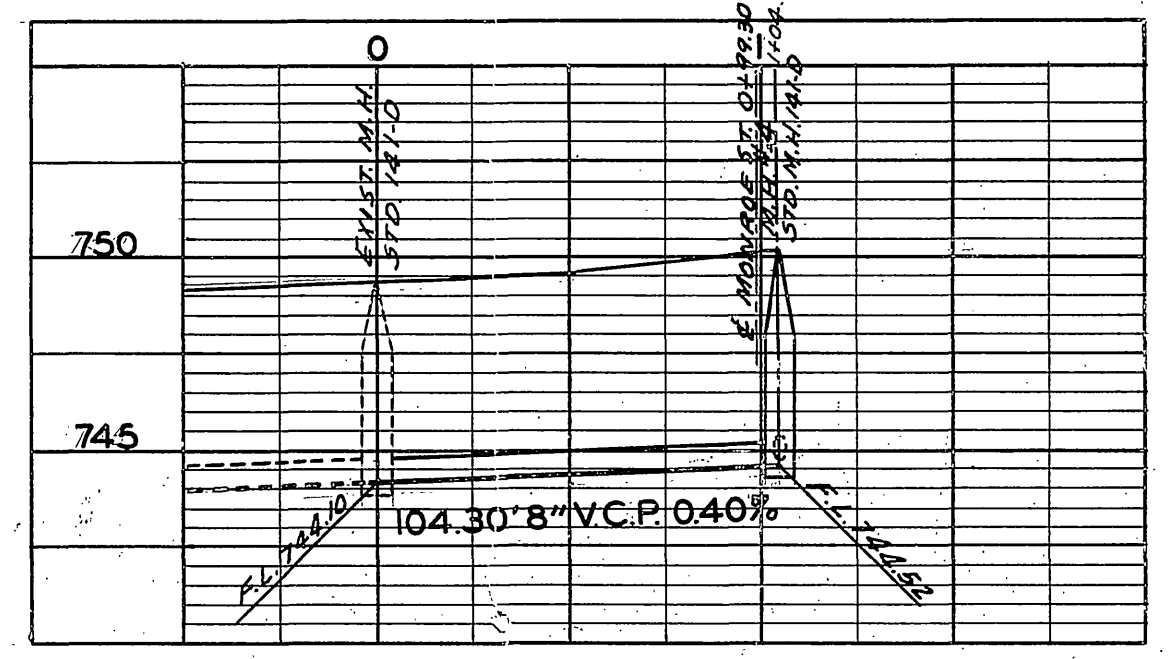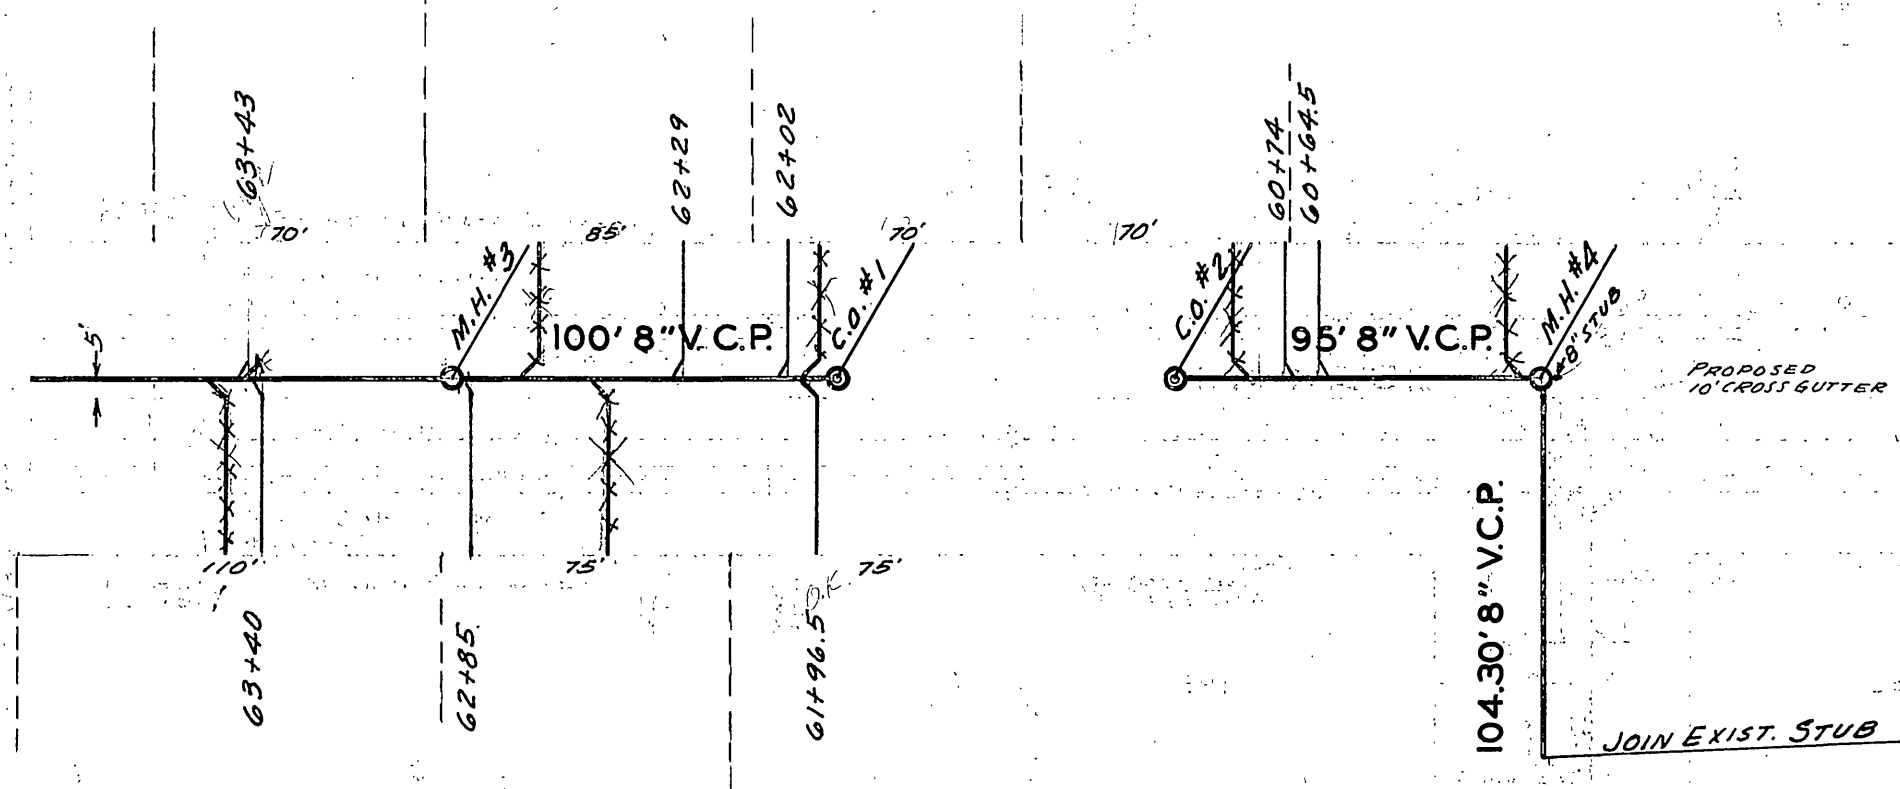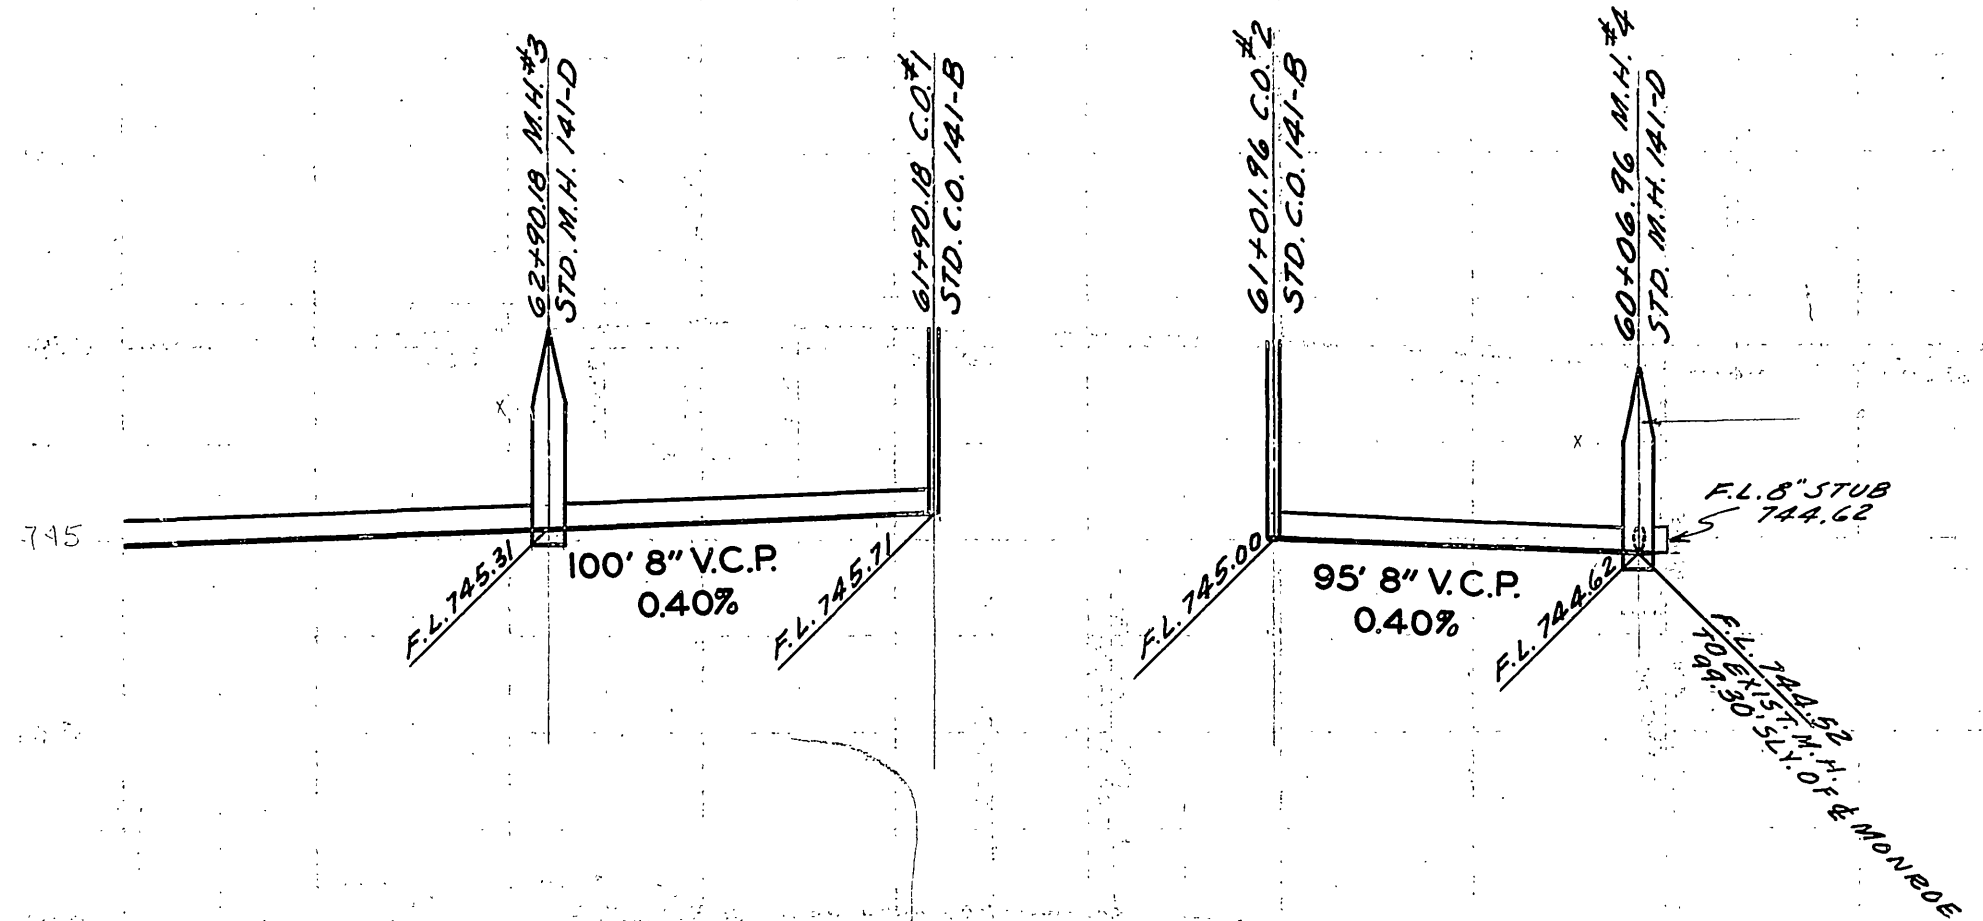


CONWAY DR. FROM EXIST. M.H. TO MONROE ST.

MONROE STREET  
SANITARY SEWER DISTRICT  
BETWEEN  
ARLINGTON AVE. & COLORADO AVE.


D.R.B. J.L.B.  
C.N. Francis J. Gibbs

Dec 10, 1957

S-106

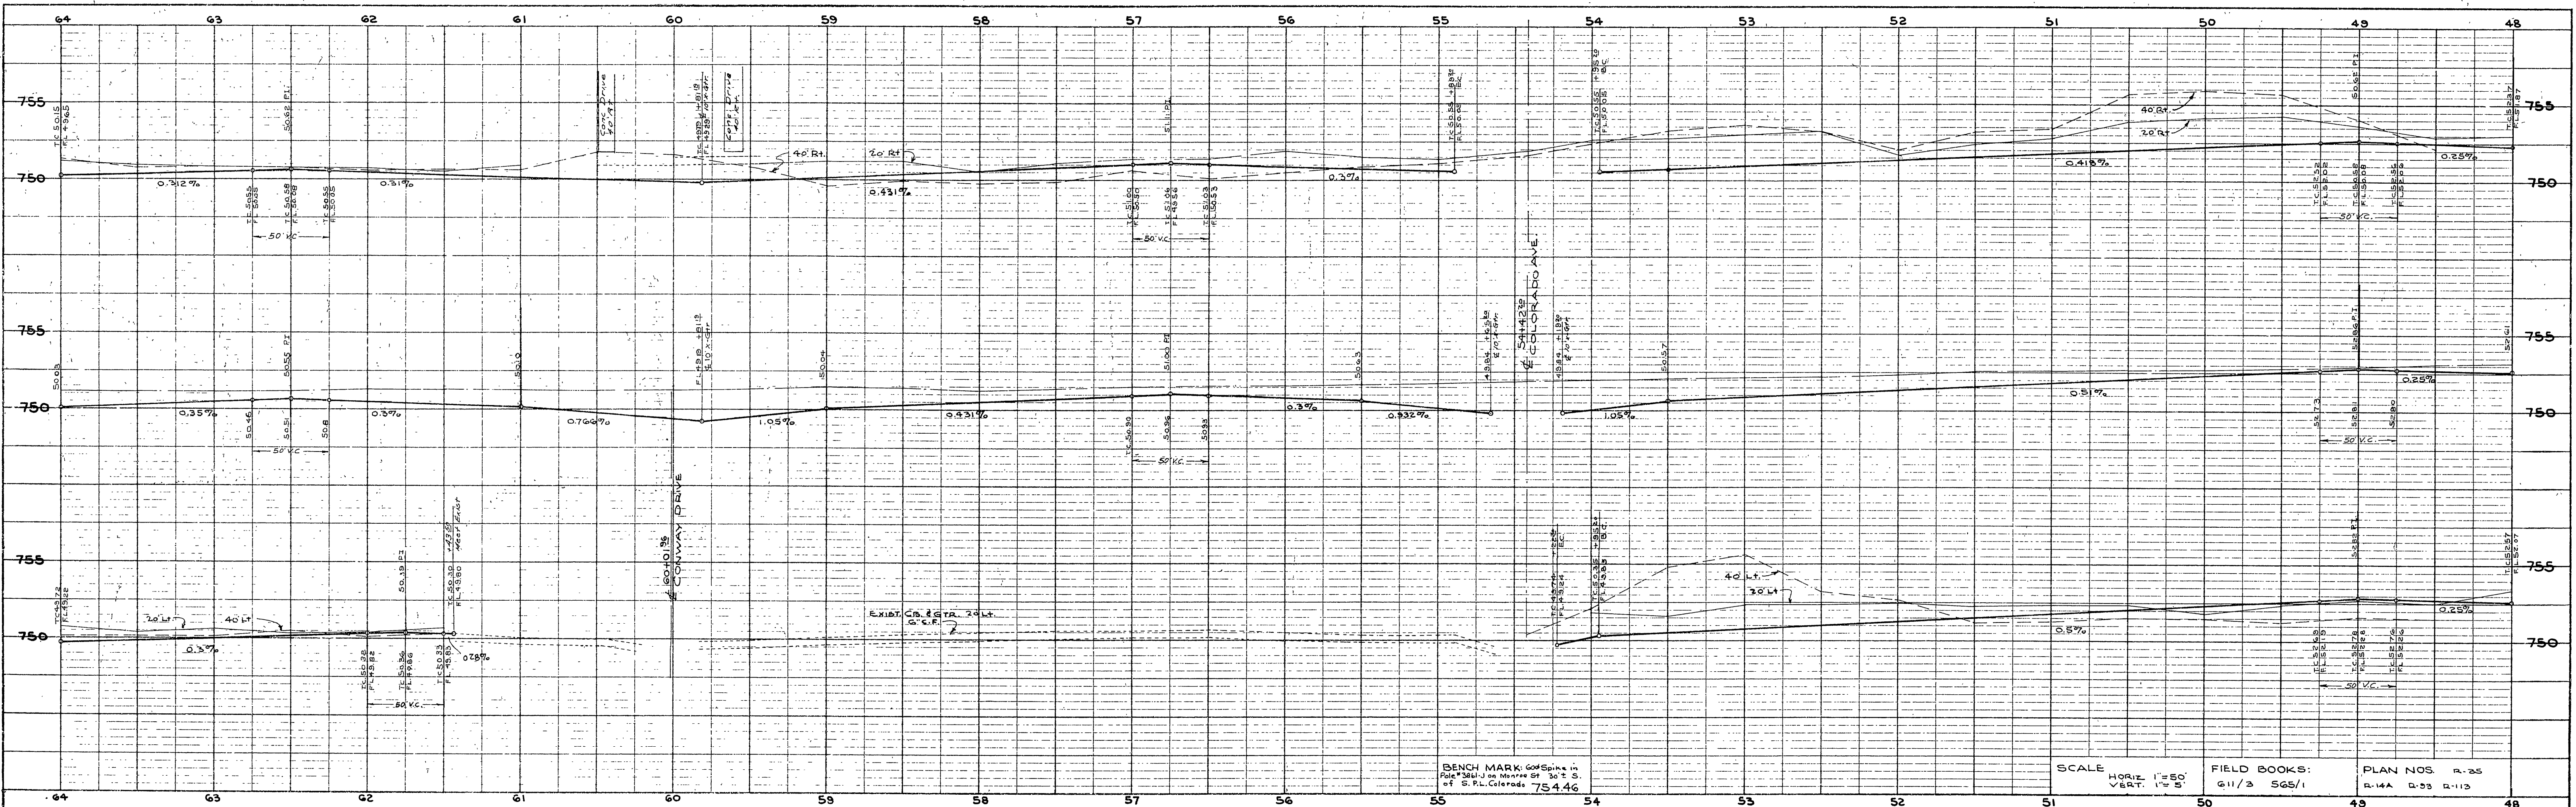

PROFILE	
SURVEYED	BY
PLOTTED	DATE
NOTE BOOK CHECKED	
STRUCTURE NOTATIONS CHECKED	

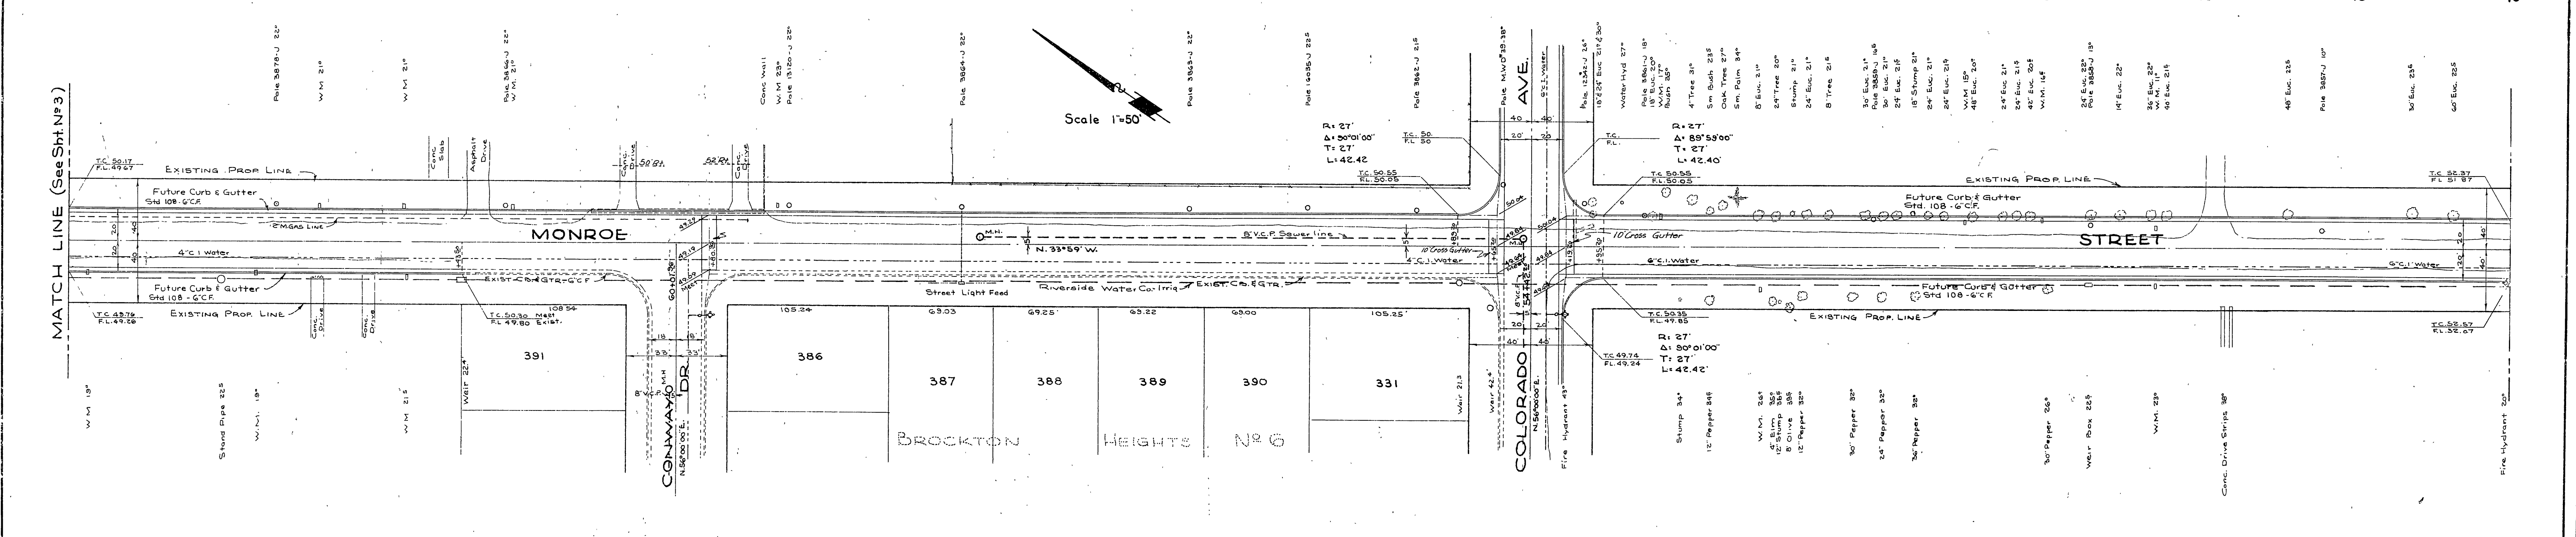

PLAN	
SURVEYED	BY
NOTE BOOK CHECKED	
ALIGNMENT CHECKED	
RT OF WAY CHECKED	

REVISIONS			CITY OF RIVERSIDE CALIFORNIA DEPARTMENT OF PUBLIC WORKS	
MARK	DATE	DESCRIPTION		

DESIGNED BY	CHECKED BY	APPROVED BY	
DRAWN BY		DIRECTOR OF PUBLIC WORKS	
RECOMMENDED BY	ASSISTANT CITY ENGINEER	DATE	SHEET OF