
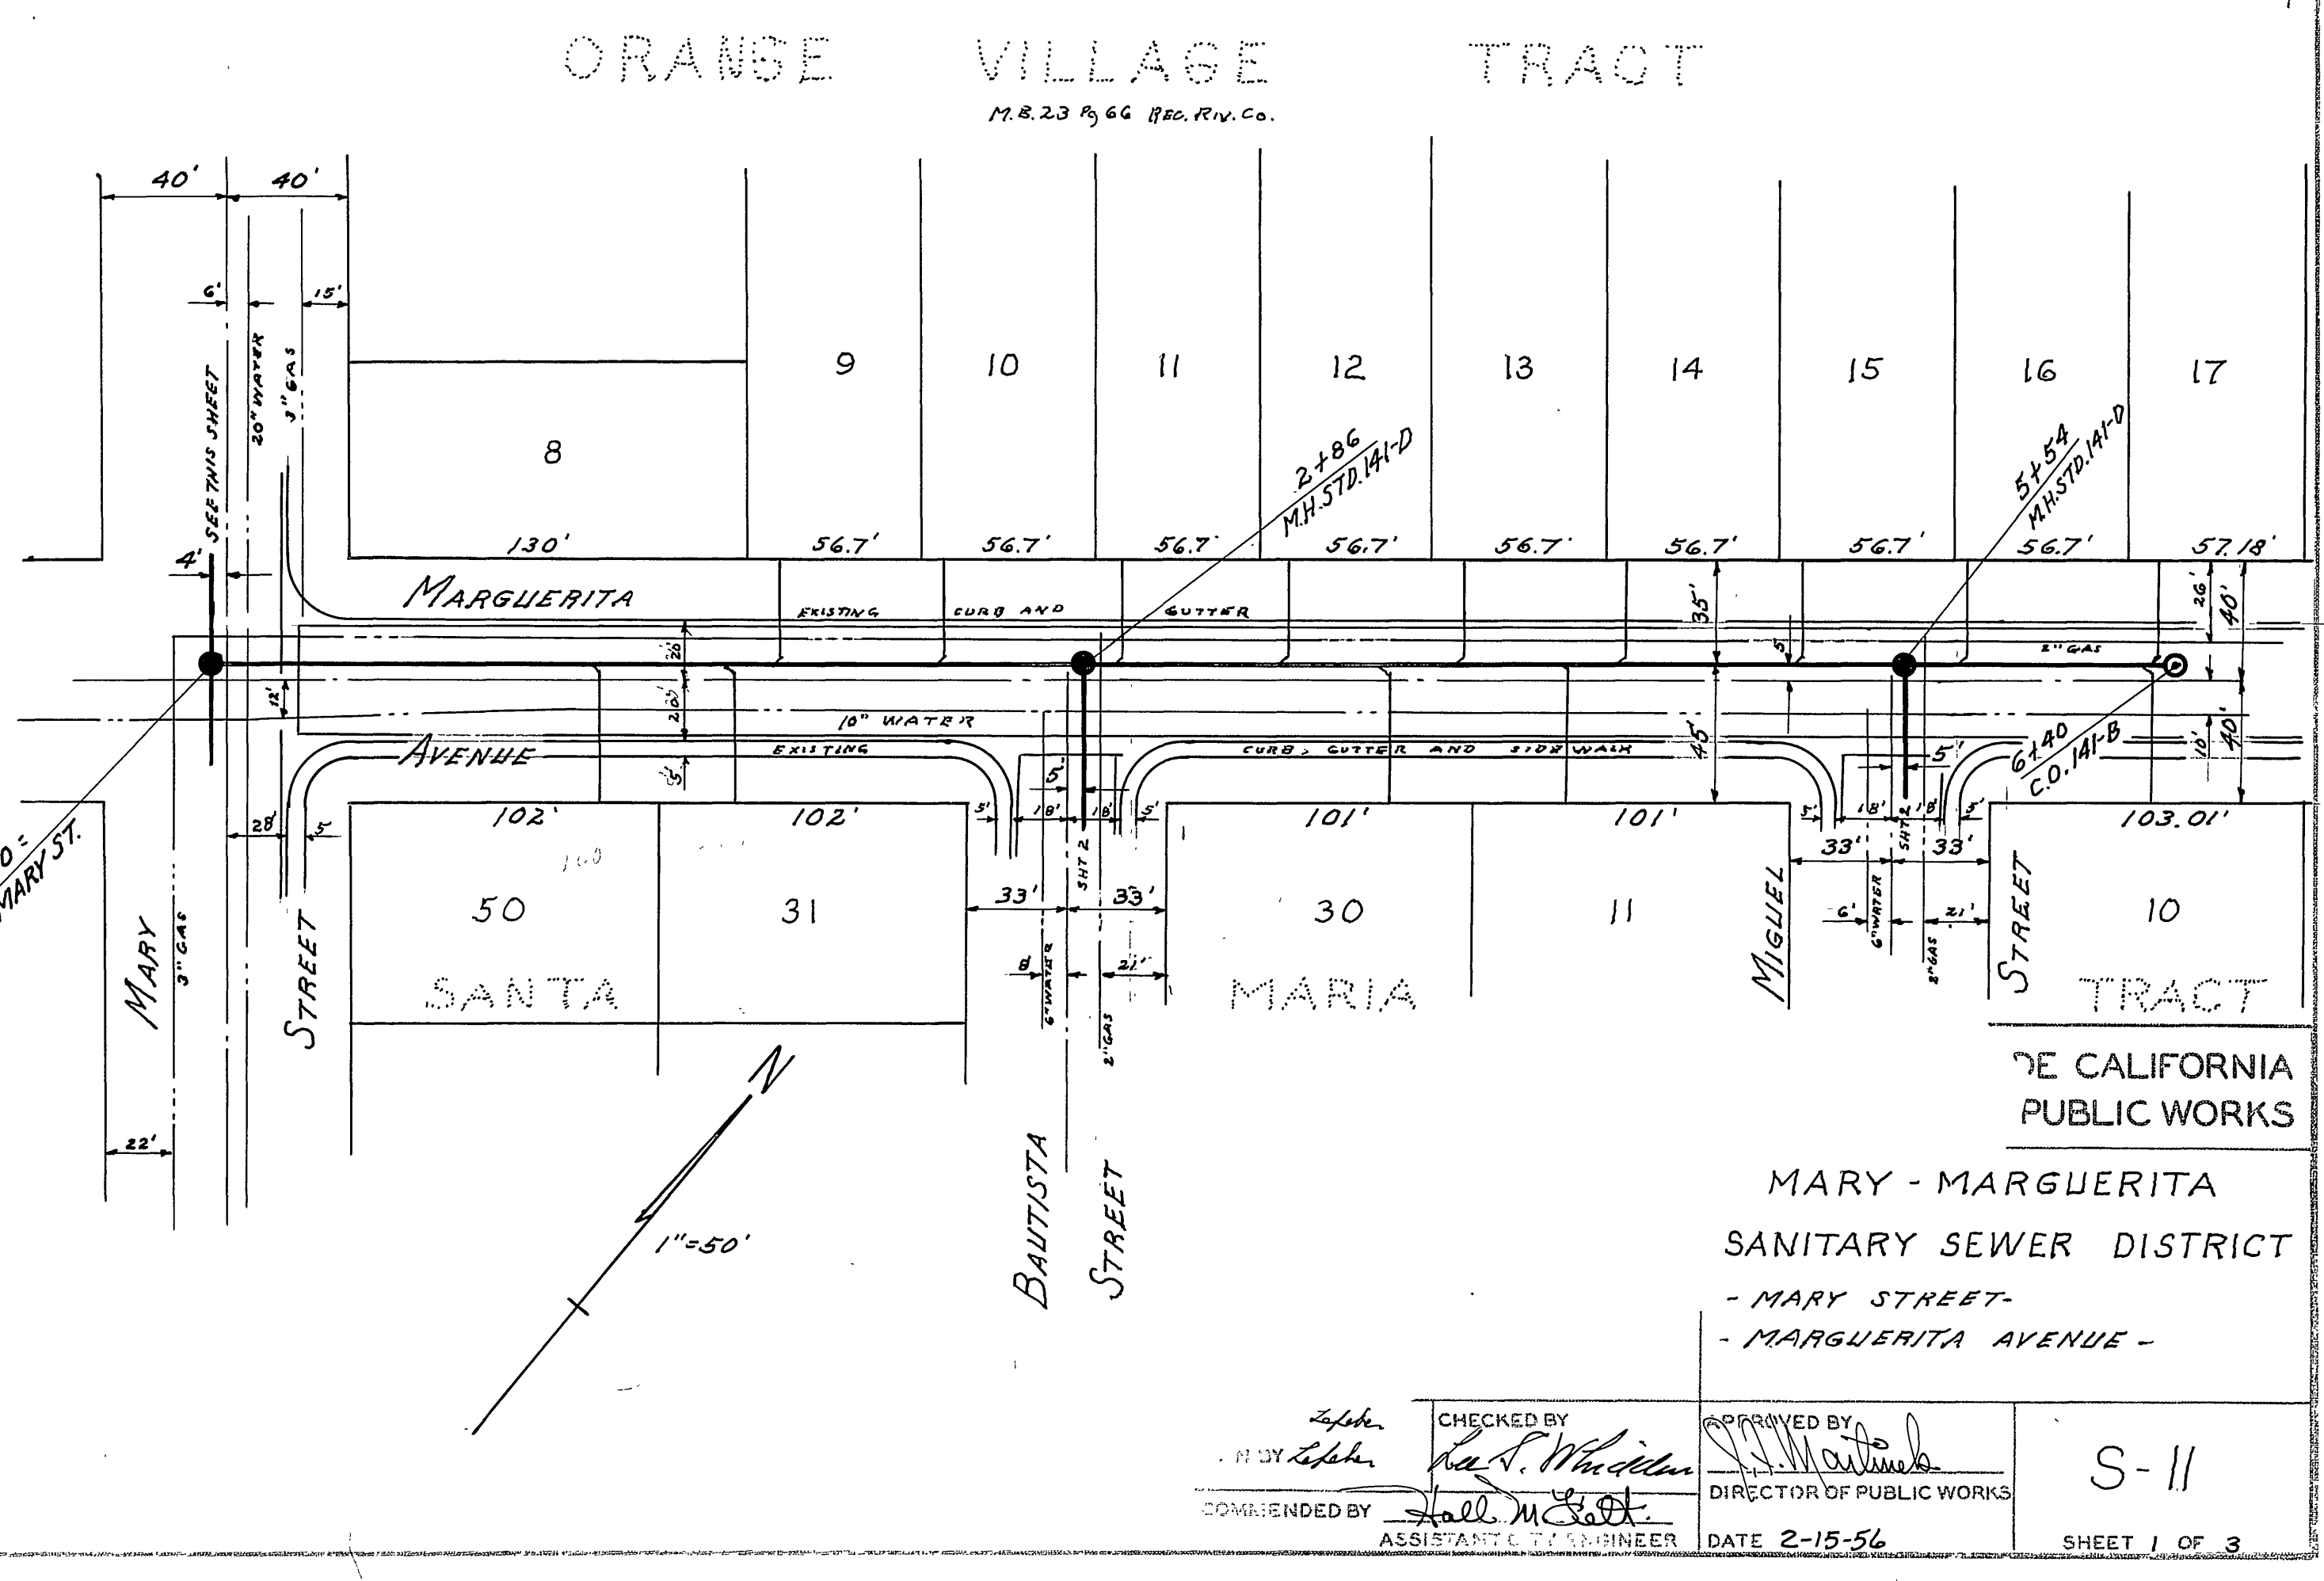


PROFILE	
NO.	DATE
PROJECTED	
PLOTTED	
CHECKED	
BY	

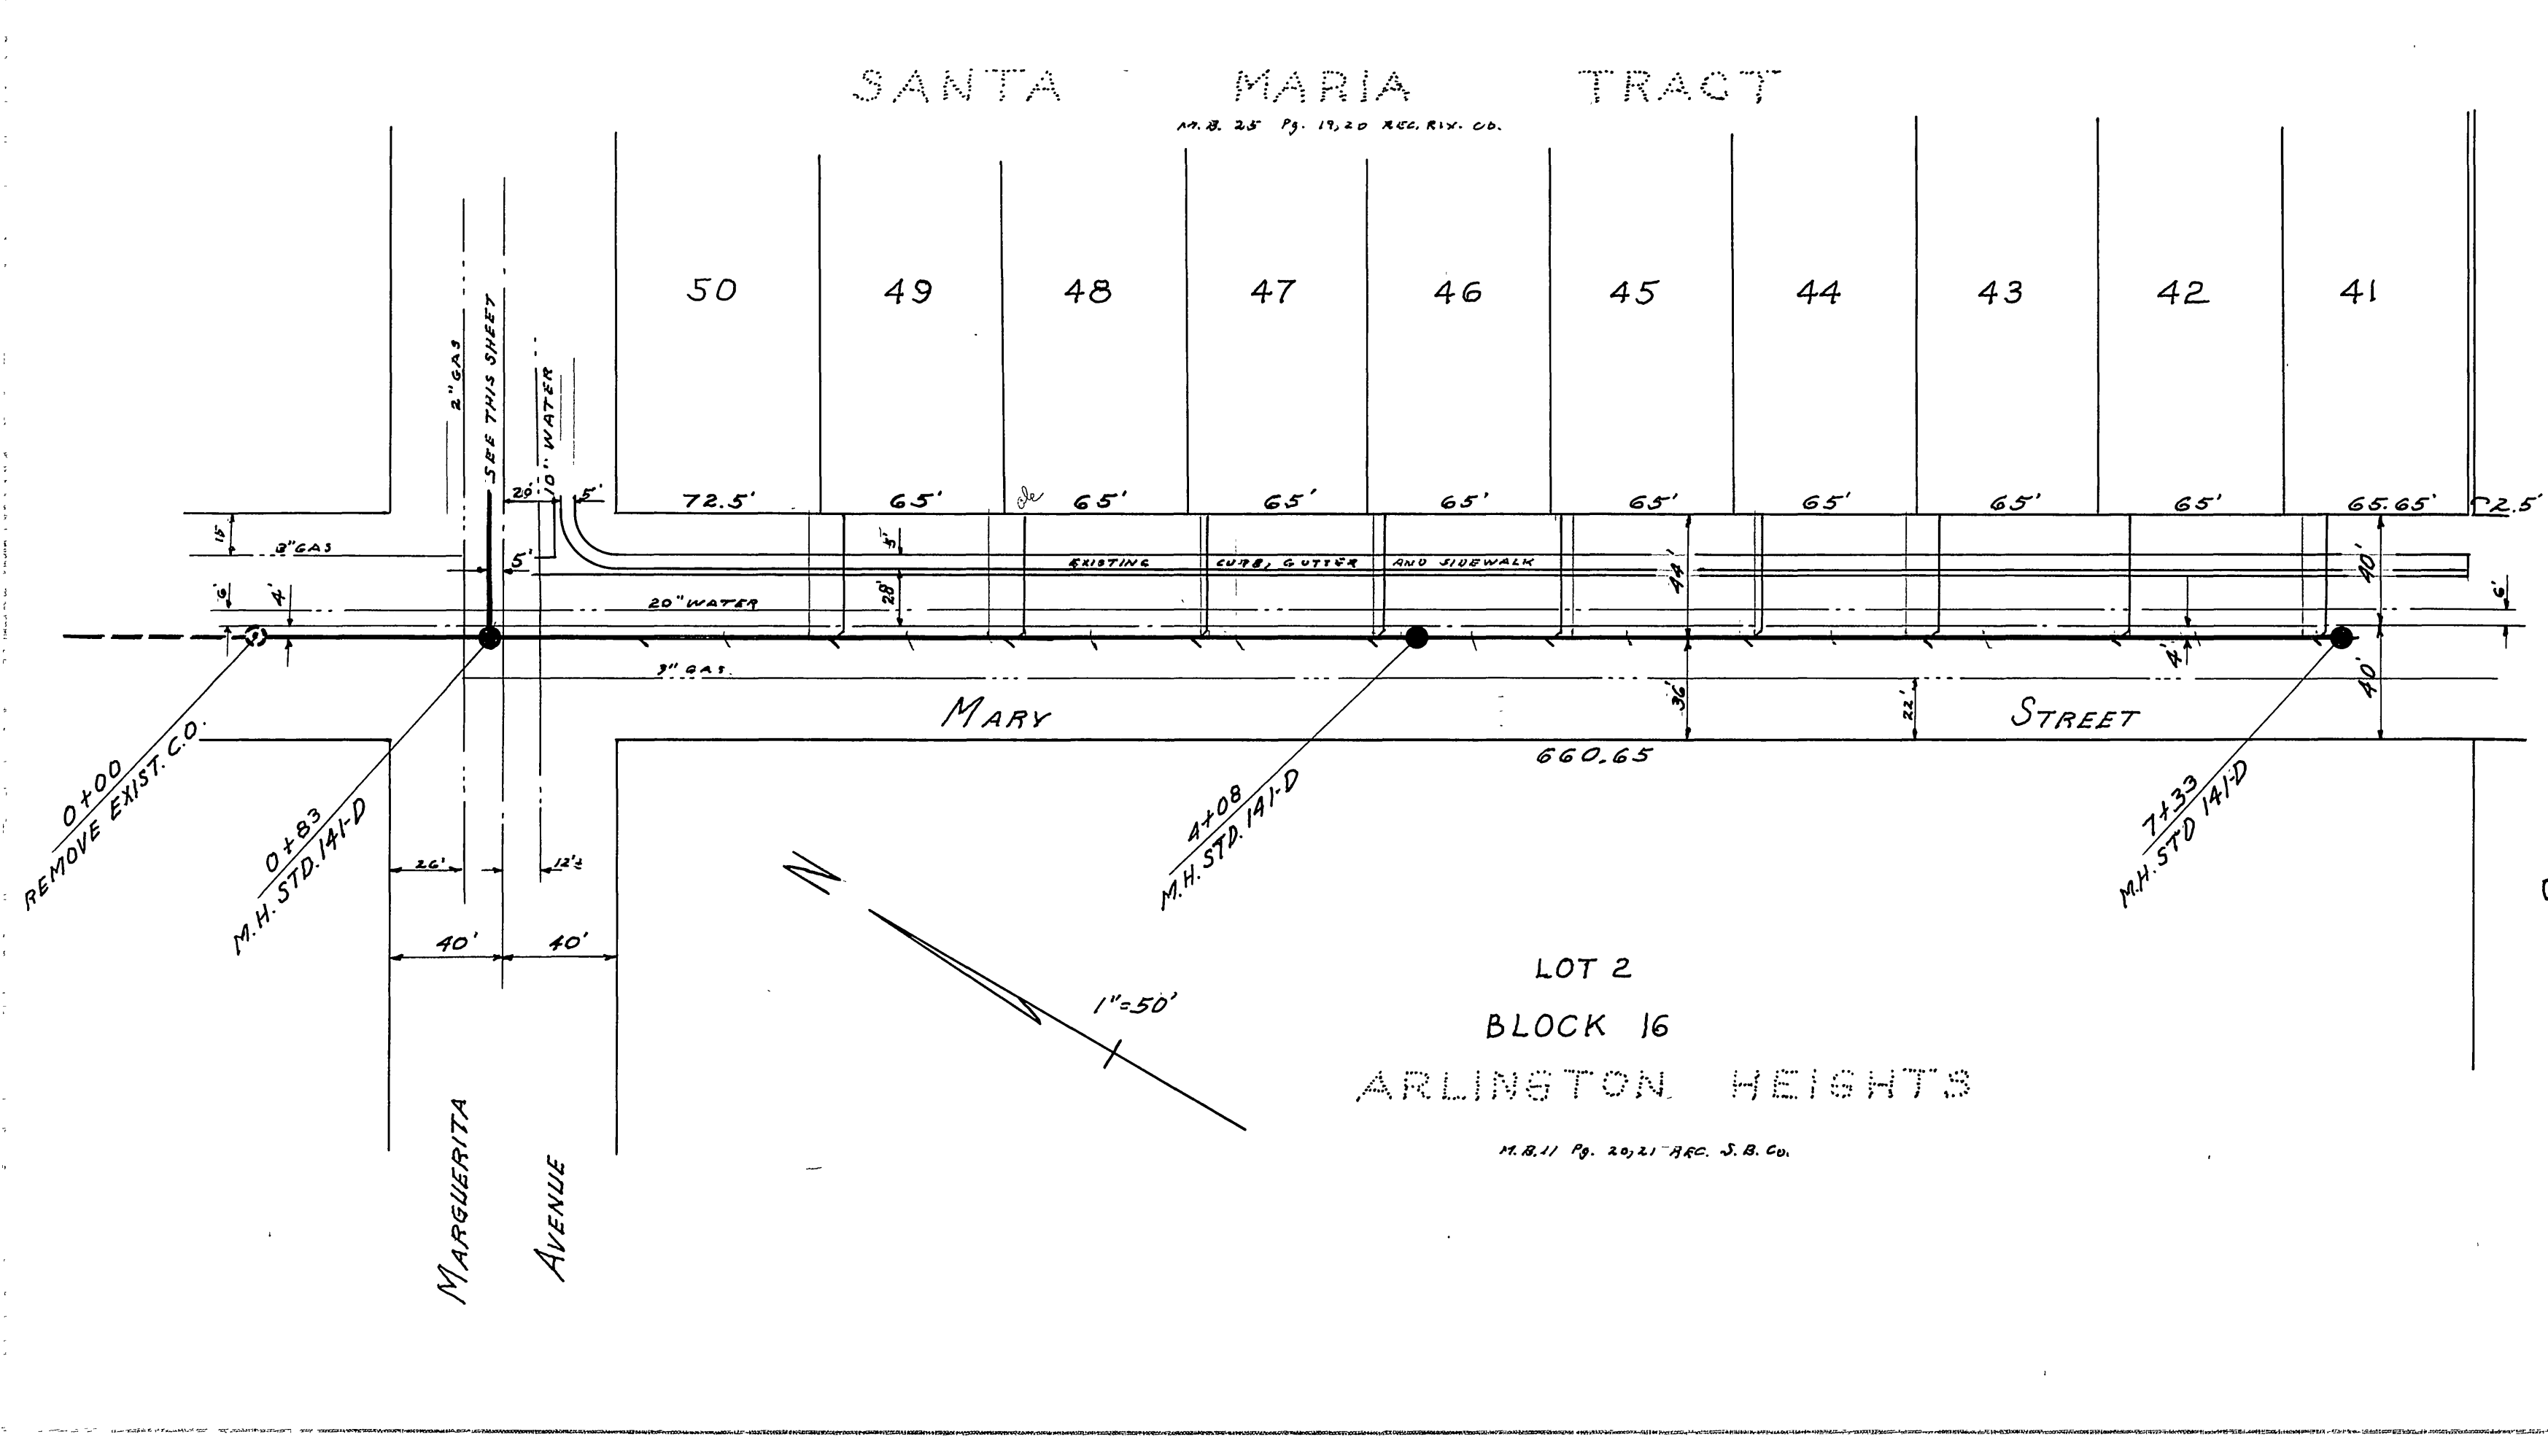



PLAN	
NO.	DATE
PROJECTED	
PLOTTED	
CHECKED	
BY	

APPROVED BY: *[Signature]*
 DIRECTOR OF PUBLIC WORKS

CHECKED BY: *[Signature]*
 ASSISTANT ENGINEER

DATE 2-15-56

S-11 SHEET 1 OF 3

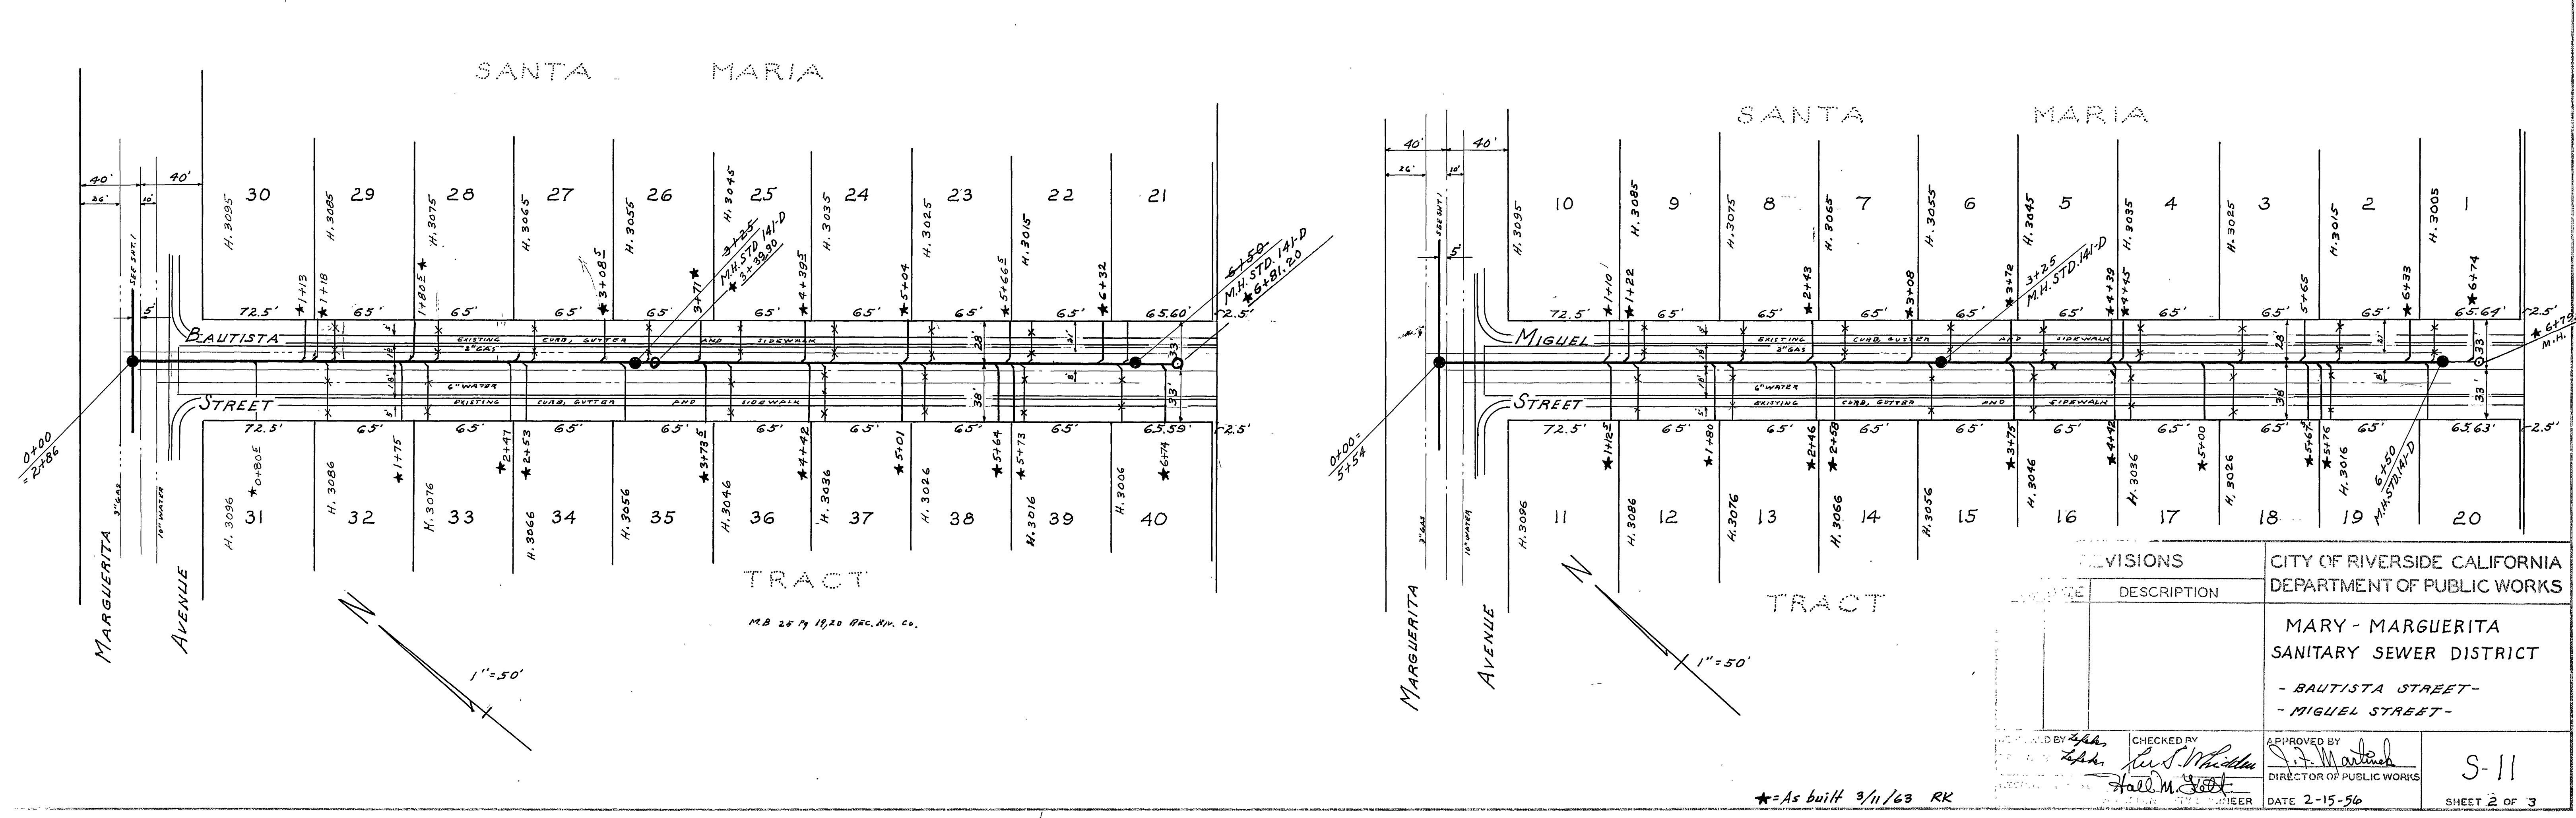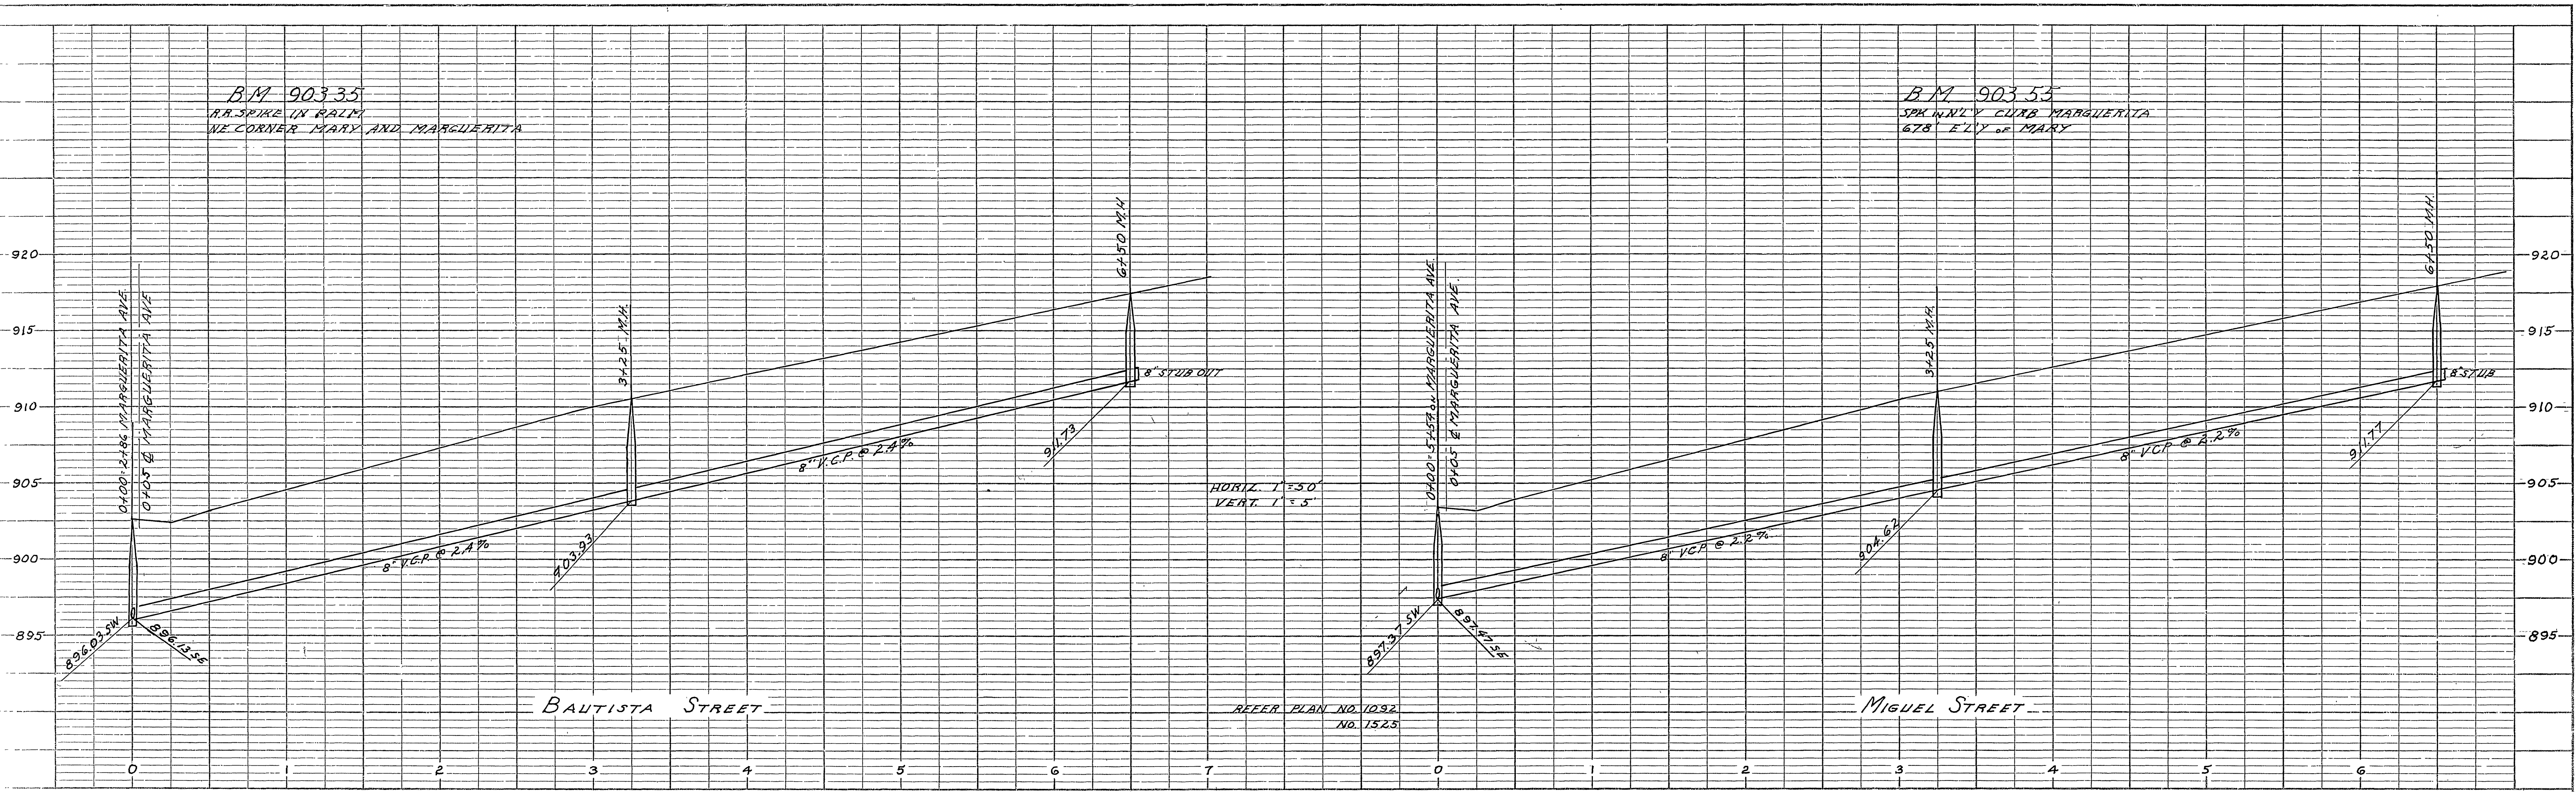

PROFILE	SURVEYED	BY	DATE
NOTE BOOK NO.	PLOTTED		
NO.	BY		
	STRUCTURE NOTATIONS CHECKED		


PLAN	SURVEYED	BY	DATE
NOTE BOOK NO.	PLOTTED		
NO.	BY		
	ALIGNMENT CHECKED		
	PLAN CHECKED		

REVISIONS		CITY OF RIVERSIDE CALIFORNIA DEPARTMENT OF PUBLIC WORKS
NO.	DESCRIPTION	
		MARY - MARGUERITA SANITARY SEWER DISTRICT - BAUTISTA STREET - - MIGUEL STREET -

APPROVED BY: <i>[Signature]</i>	CHECKED BY: <i>[Signature]</i>	APPROVED BY: <i>[Signature]</i>
		DIRECTOR OF PUBLIC WORKS
		DATE 2-15-56


S-11
SHEET 2 OF 3

*As built 3/11/63 RK

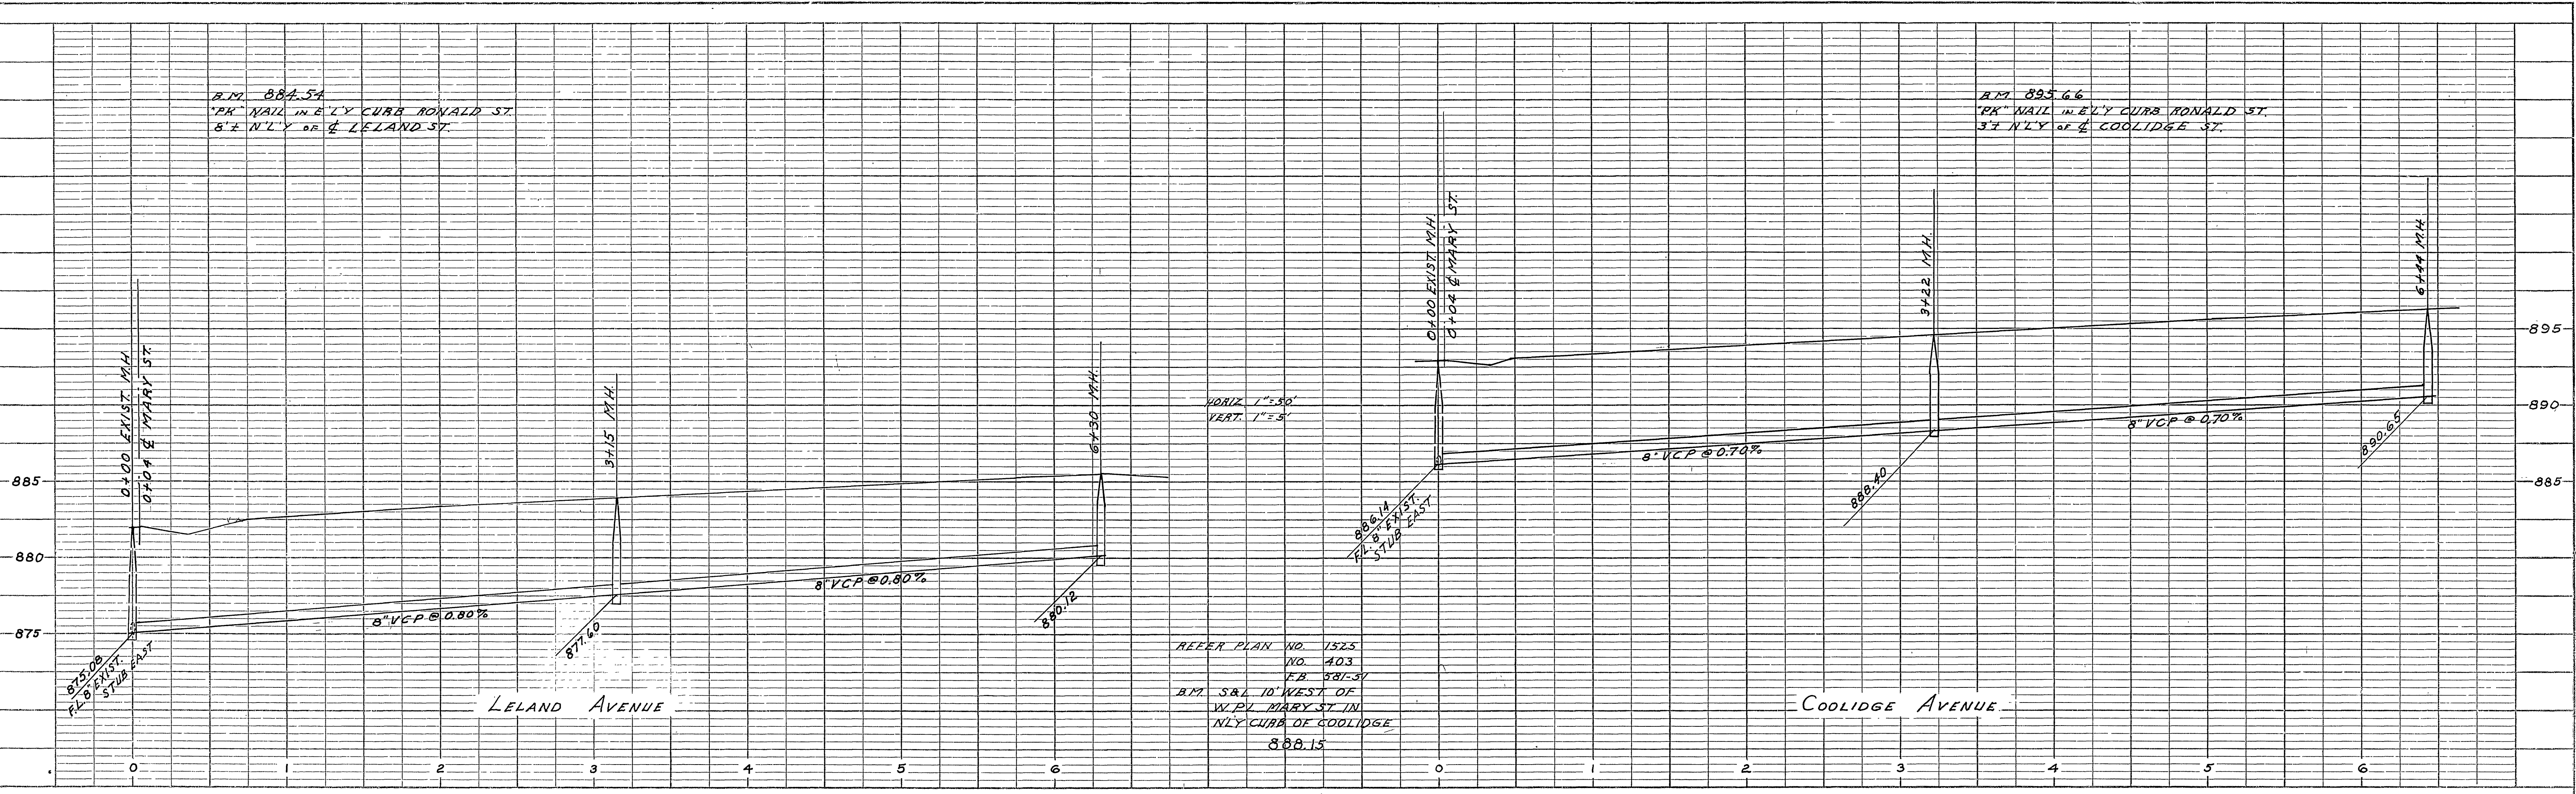

PROFILE	
NO. _____	DATE _____
BY _____	DATE _____
STRUCTURE NOTING CHECKS.	

ORANGE ACRES

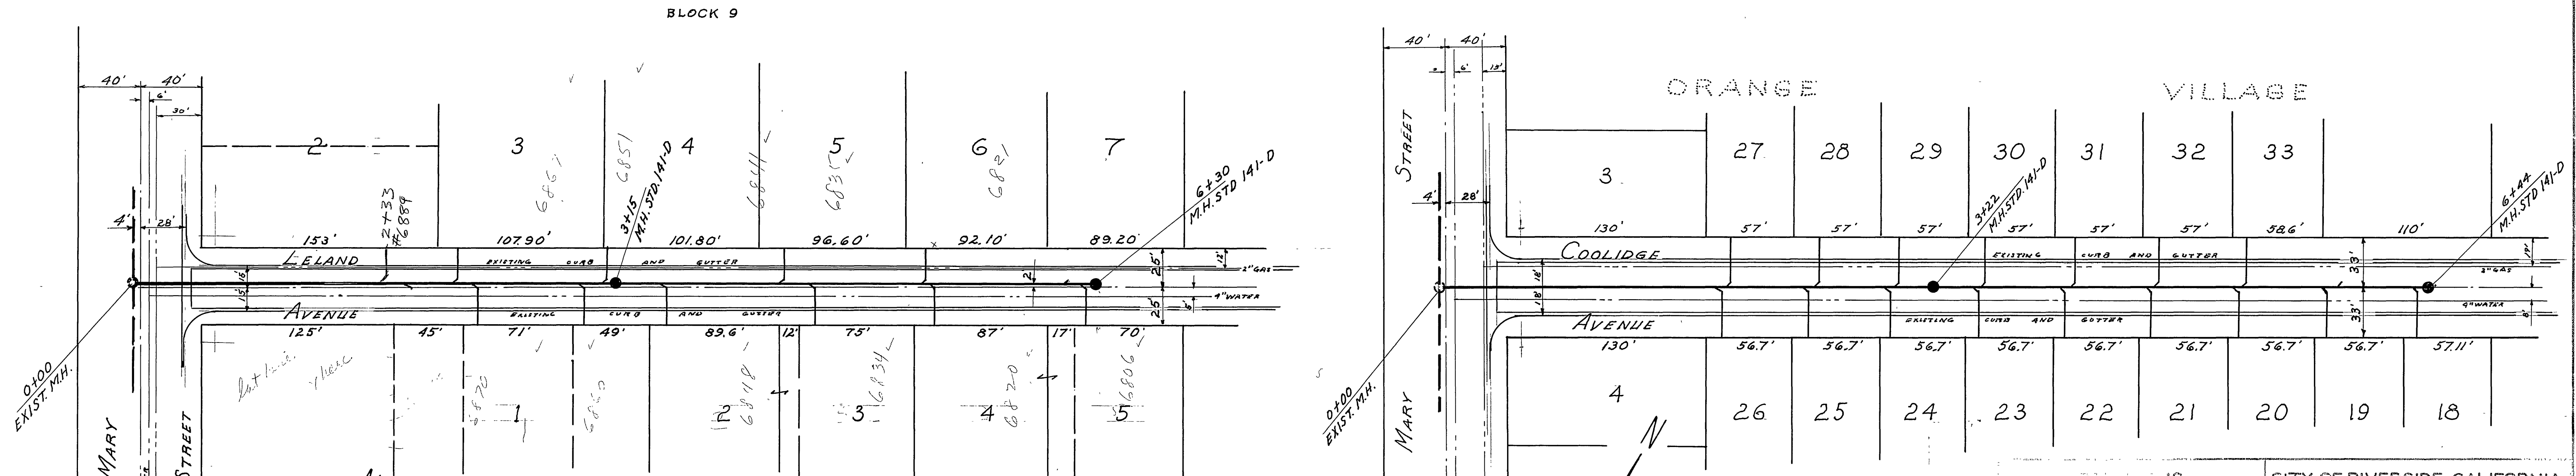

PLAN	
NO. _____	DATE _____
BY _____	DATE _____
STRUCTURE NOTING CHECKS.	

CITY OF RIVERSIDE CALIFORNIA DEPARTMENT OF PUBLIC WORKS	
MARY - MARGUERITA SANITARY SEWER DISTRICT	
-LELAND AVENUE- -COOLIDGE AVENUE-	
DESIGNED BY <i>[Signature]</i>	CHECKED BY <i>[Signature]</i>
APPROVED BY <i>[Signature]</i> DIRECTOR OF PUBLIC WORKS	DATE 2-15-56
S-11	
SHEET 3 OF 3	