
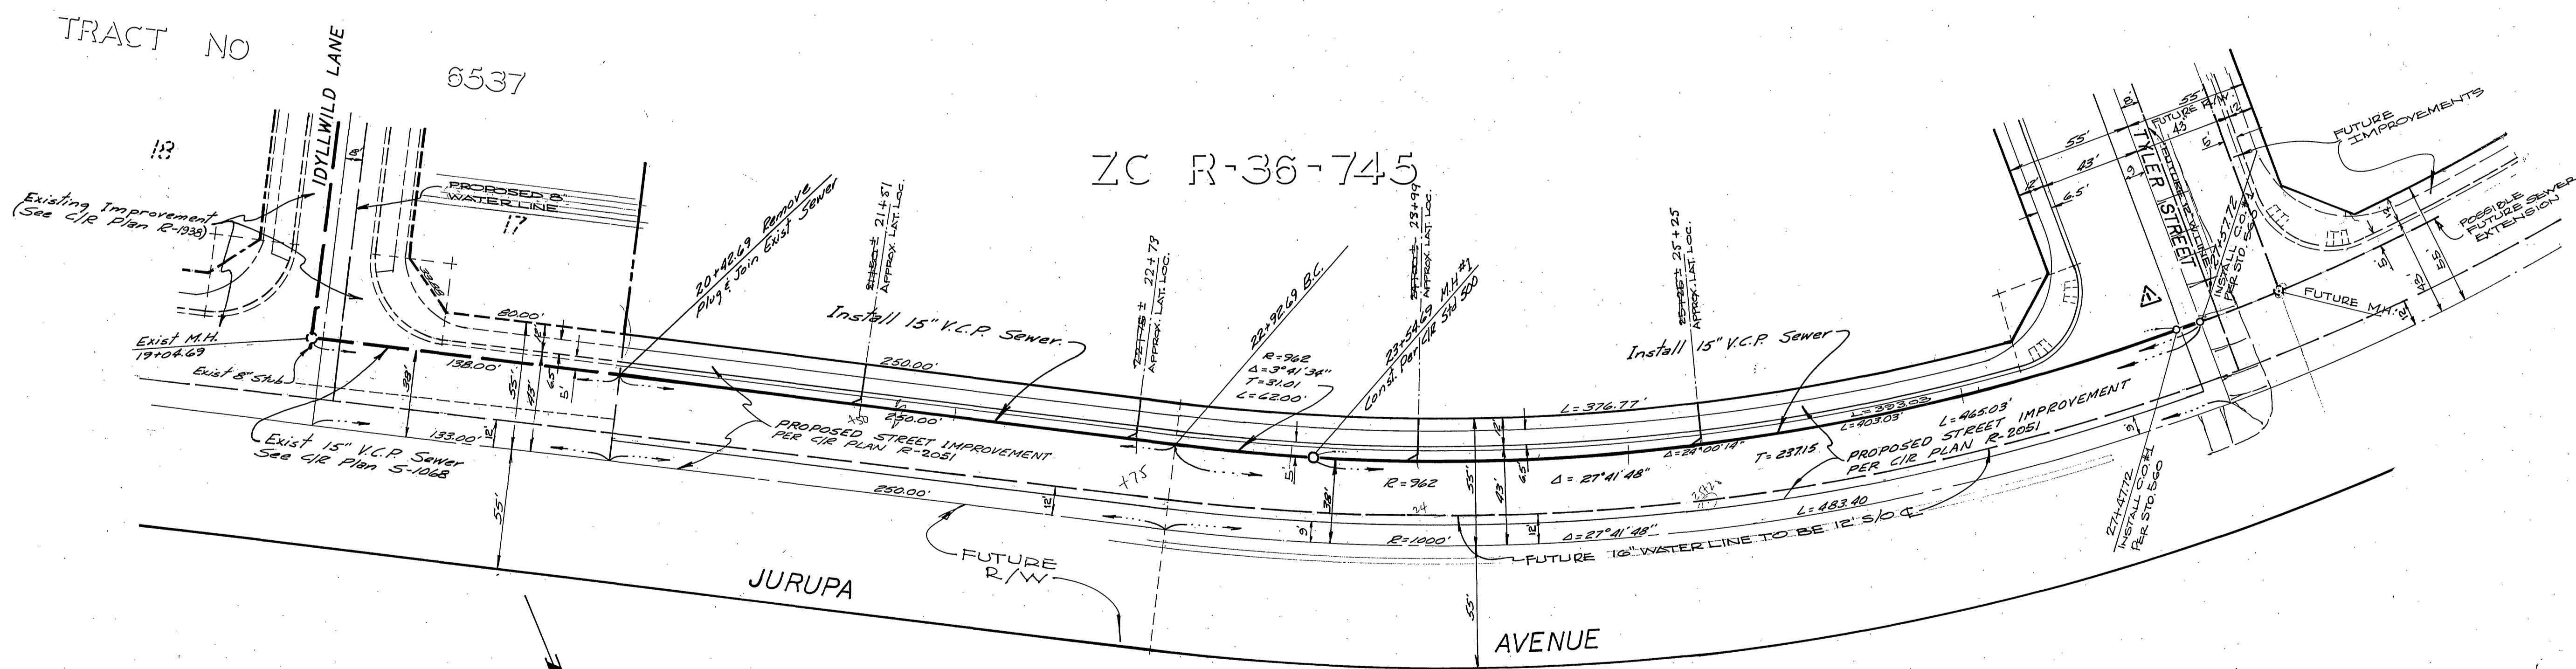


GENERAL NOTES:

1. The private engineer signing these plans is responsible for the accuracy and acceptability of the work hereon. In the event of discrepancies arising during construction, the private engineer shall be responsible for determining an acceptable solution and revising the plans for approval by the City.
2. It shall be the responsibility of the contractor to clear the right of way in accordance with the provisions of law as it affects each utility including irrigation lines and appurtenances and at no cost to the City.
3. Construction shall be in accordance with the City of Riverside Department of Public Works Standard Drawings, and the Standard Specifications for Public Works Construction, 1976 Edition.
4. Contractor is to verify existing sewer elevation prior to construction.
5. The sewer contractor shall adjust manholes to final grade after paving is complete.
6. A plug shall be installed and will remain in place where the new sewer connects with the existing sewer until the new sewer is accepted by the City.
7. THE PRIVATE ENGINEER SIGNING THESE PLANS IS RESPONSIBLE FOR THE ACCURACY AND ACCEPTABILITY OF THE WORK HEREON. IN THE EVENT OF DISCREPANCIES ARISING DURING CONSTRUCTION THE PRIVATE ENGINEER SHALL BE RESPONSIBLE FOR DETERMINING AN ACCEPTABLE SOLUTION AND REVISING THE PLANS FOR APPROVAL BY THE CITY.

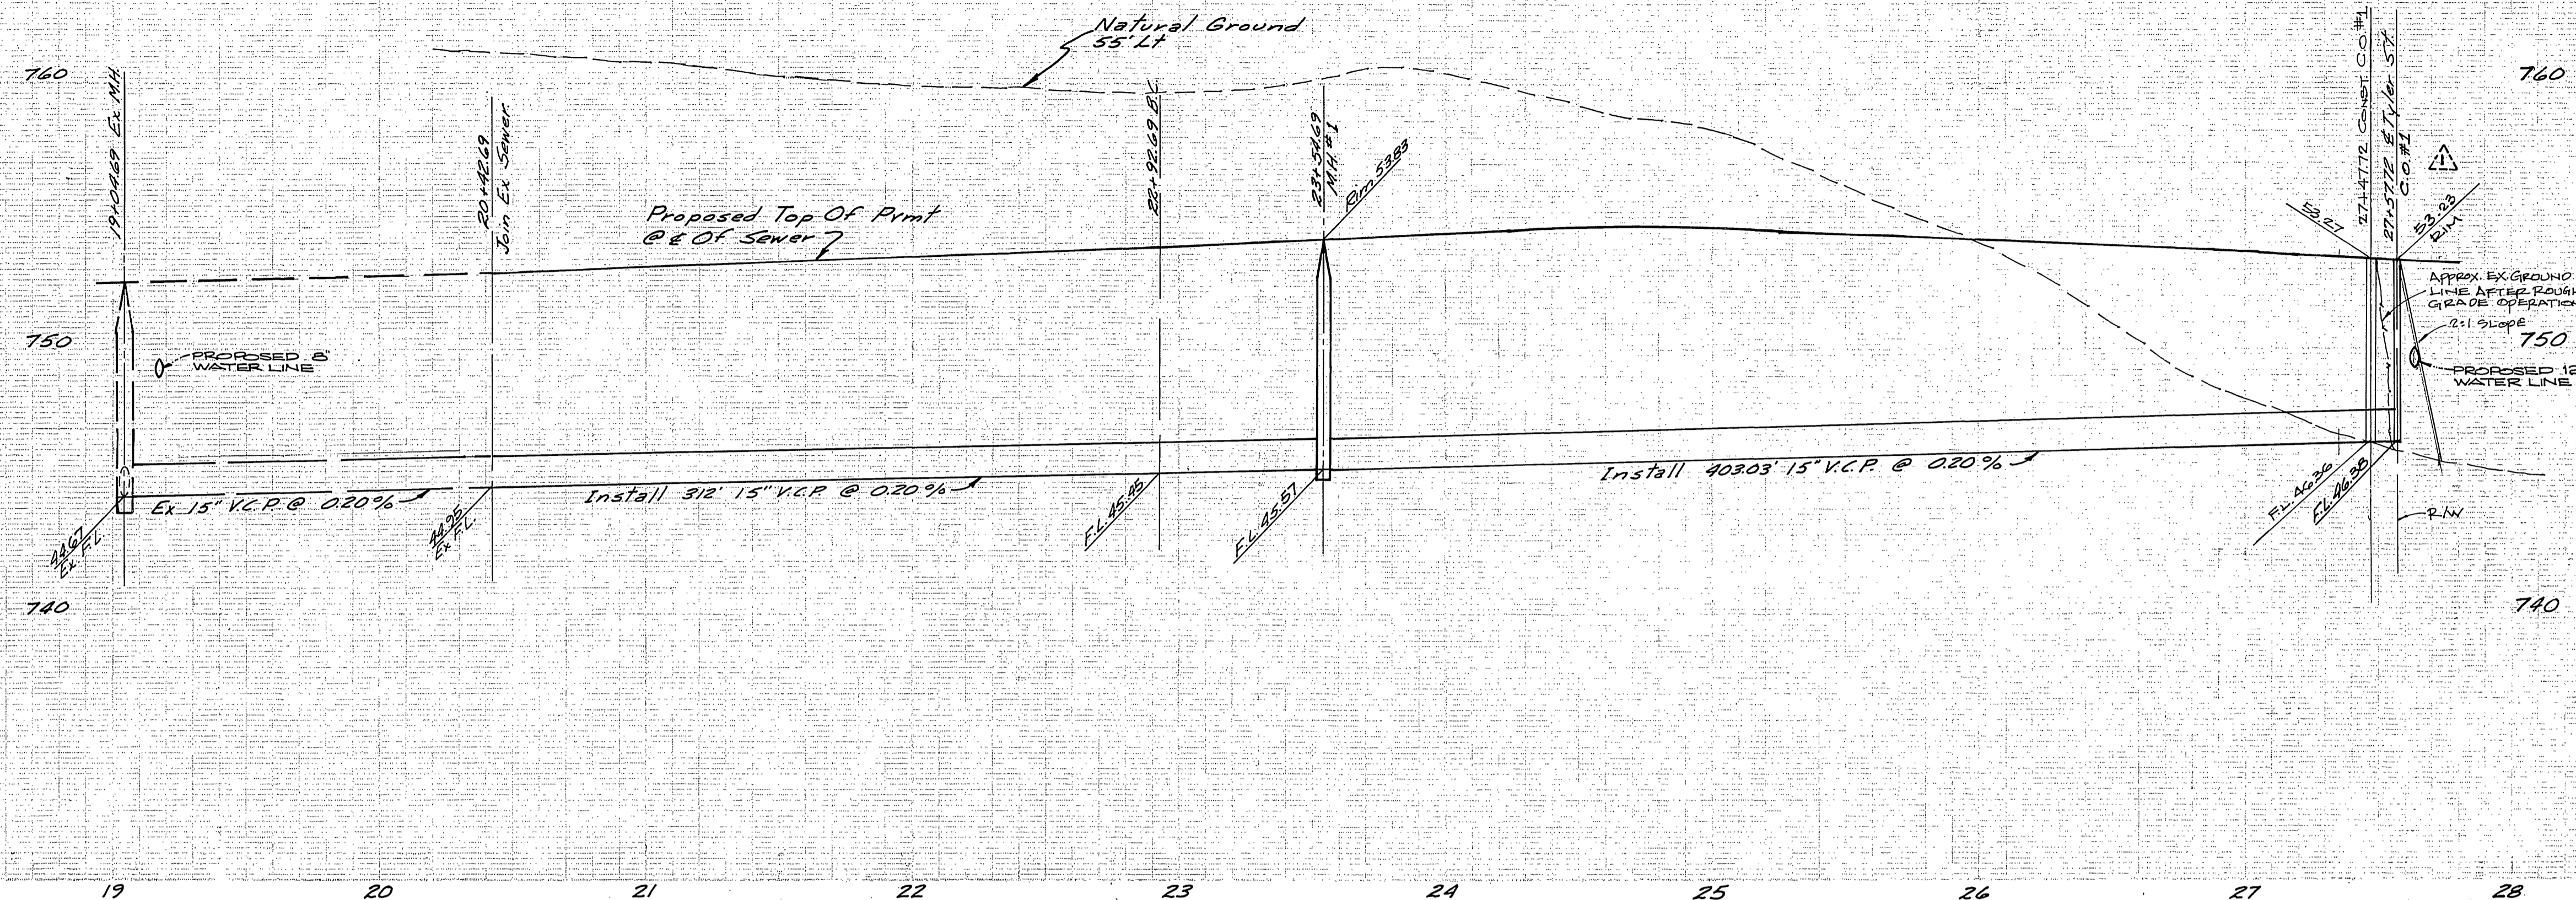

BENCH MARK
 PK nail in east curb on Tyler street on E Gaylord Avenue
 Produced per City of Riverside
 F.B. 7041 Elev 778.21 (Adjusted to C.R. Datum Elev 778.09 in September 1973)

APPROVED FOR LINE & GRADE ONLY

 PUBLIC WORKS DIRECTOR 11-17-77
 DATE

CITY OF RIVERSIDE DOMESTIC SYSTEM CHIEF UTILITIES ENGINEER, WATER	ALBERT A. WEBB ASSOCIATES CIVIL ENGINEERS RIVERSIDE, CALIFORNIA APPROVED BY R.E. No. 2816 DATE 3/10/77	CITY OF RIVERSIDE, CALIFORNIA PUBLIC WORKS DEPARTMENT APPROVED BY DIRECTOR OF PUBLIC WORKS DATE 3/28/78	SEWER PLAN & PROFILE JURUPA AVENUE IDYLLWILD LANE TO TYLER ST ZC R-36-745	ACCOUNT NO. DRAWING NUMBER S-1143 SHEET 1 OF 1
			"AS BUILT" 10-25-79 BR	SCALE: Horiz 1"=40' Vert 1"=4'