

NOTE: CONTRACTOR TO VERIFY ELEVATION OF EXISTING SEWER BEFORE CONST.

NOTE: CONTRACTOR NOT REQUIRED TO REPLACE PAVING FROM STA. 9+30.07 TO STA. 10+58

NOTE: SEWER LATERALS AND WATER SERVICE TO BE INSTALLED BY CONTRACTOR PER SERVICES CONNECTION DRAWING

NOTE: CONTRACTOR TO CO-ORDINATE WITH CITY FOR TIE-IN AND METER TO BE INSTALLED BY CITY FORCES

NOTE: DID NOT ENCOUNTER THIS LATERAL DURING THE PROPOSED CONST. LEFT AS IS.

NOTE: CONTRACTOR TO CO-ORDINATE WITH CITY FOR TIE-IN AND METER TO BE INSTALLED BY CITY FORCES

NOTE: CONTRACTOR TO CO-ORDINATE WITH CITY FOR TIE-IN AND METER TO BE INSTALLED BY CITY FORCES

NOTE: CONTRACTOR TO CO-ORDINATE WITH CITY FOR TIE-IN AND METER TO BE INSTALLED BY CITY FORCES

NOTE: CONTRACTOR TO CO-ORDINATE WITH CITY FOR TIE-IN AND METER TO BE INSTALLED BY CITY FORCES


NOTE: CONTRACTOR TO CO-ORDINATE WITH CITY FOR TIE-IN AND METER TO BE INSTALLED BY CITY FORCES

NOTE: CONTRACTOR TO CO-ORDINATE WITH CITY FOR TIE-IN AND METER TO BE INSTALLED BY CITY FORCES

NOTE: CONTRACTOR TO CO-ORDINATE WITH CITY FOR TIE-IN AND METER TO BE INSTALLED BY CITY FORCES

GENERAL NOTES

1. THE PRIVATE ENGINEER SIGNING THESE PLANS IS RESPONSIBLE FOR THE ACCURACY AND ACCEPTABILITY OF THE WORK HEREON. IN THE EVENT OF DISCREPANCIES ARISING DURING CONSTRUCTION, THE PRIVATE ENGINEER SHALL BE RESPONSIBLE FOR DETERMINING AN ACCEPTABLE SOLUTION, AND REVISING THE PLANS FOR APPROVAL BY THE CITY.
2. CONSTRUCTION SHALL BE IN ACCORDANCE WITH "STANDARD SPECIFICATIONS FOR PUBLIC WORKS CONSTRUCTION", 1976 EDITION AND THE CITY OF RIVERSIDE STANDARD DRAWINGS.
3. IT SHALL BE THE RESPONSIBILITY OF THE CONTRACTOR TO CLEAR THE RIGHT OF WAY IN ACCORDANCE WITH THE PROVISIONS OF THE LAW AS IT AFFECTS EACH UTILITY INCLUDING IRRIGATION LINES AND APPURTENANCES AND AT NO COST TO THE CITY.
4. PIPE SHALL BE BEDDED PER CASE 1, STANDARD DRAWING NE#82, UNLESS OTHERWISE SPECIFIED ON THE PLANS.
5. LOCATION OF WYES AND LATERALS TO BE DETERMINED IN THE FIELD AT THE DIRECTION OF THE OWNER.
6. ALL LATERALS TO BE CONSTRUCTED IN ACCORDANCE WITH STANDARD DRAWING NE#82.
7. MANHOLE FRAMES AND COVERS TO BE SET AS NOTED IN PROFILE BY SEWER CONTRACTOR, AFTER FINAL PAVING OF STREETS.
8. LATERALS ARE TO BE 4" V.C.P.
9. PRIOR TO CONSTRUCTION OF SEWER, CONTRACTOR IS TO EXPOSE THE EXISTING SEWER AND CONTACT THE ENGINEER FOR VERIFICATION OF EXISTING LOCATION AND ELEVATION.
10. PLUG SHALL BE INSTALLED AND REMAIN IN PLACE WHERE THE NEW SEWER CONNECTS WITH THE EXISTING SEWER UNTIL SUCH TIME AS THE NEW SEWER IS ACCEPTED BY THE CITY.
11. WATERLINE TIE-IN TO MAIN AND INSTALLATION OF WATER METER TO BE DONE BY CITY FORCES.

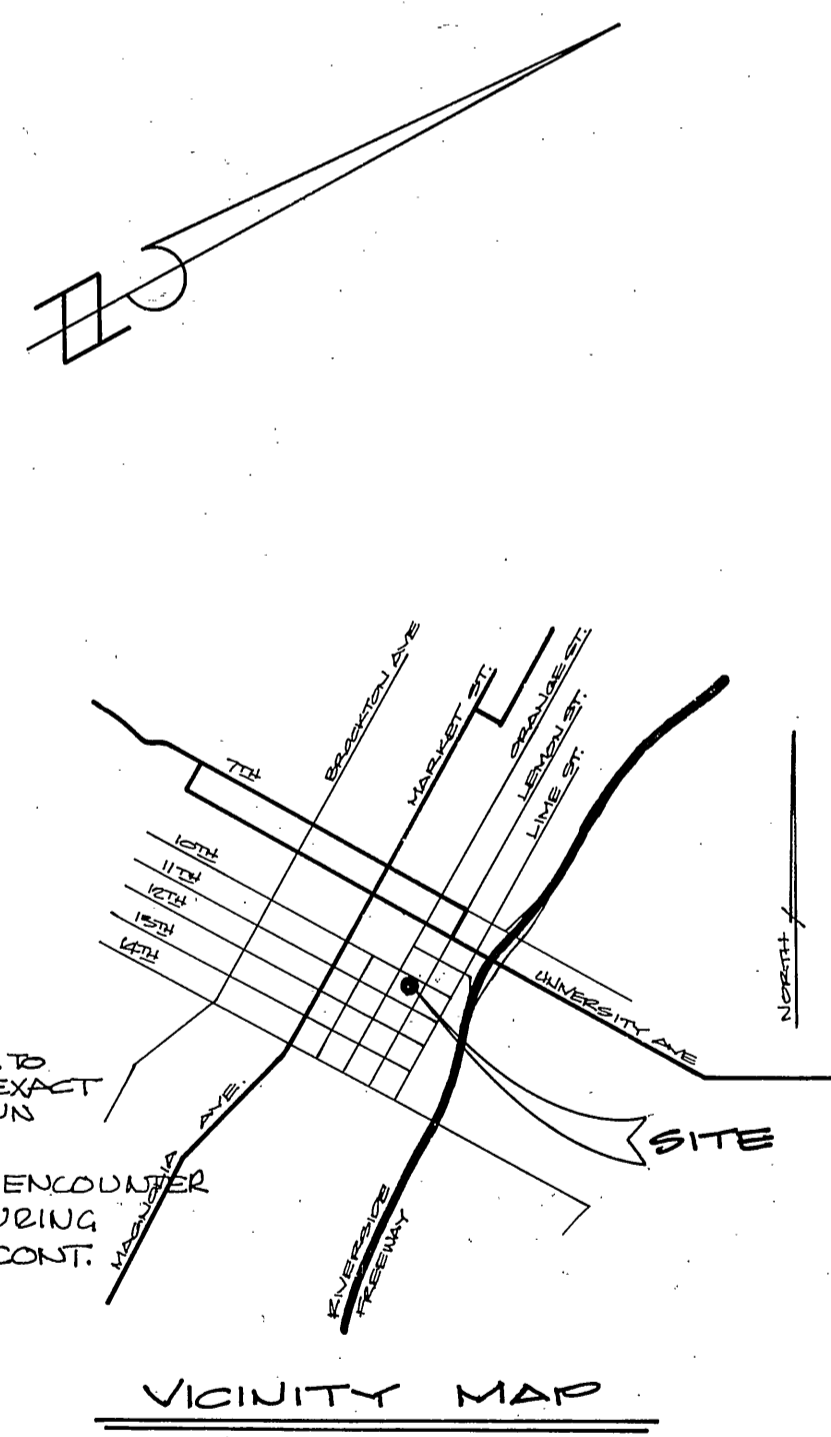

NOTICE TO CONTRACTOR

THE EXISTENCE AND LOCATION OF UNDERGROUND UTILITY PIPES OR STRUCTURES SHOWN ON THESE PLANS ARE OBTAINED BY A SEARCH OF THE AVAILABLE RECORDS TO THE BEST OF OUR KNOWLEDGE THERE ARE NO EXISTING UTILITIES EXCEPT AS SHOWN ON THESE PLANS. THE CONTRACTOR IS REQUIRED TO TAKE THE PRECAUTIONARY MEASURES TO PROTECT THE UTILITY LINES SHOWN AND ANY OTHER LINES NOT OF RECORD OR NOT SHOWN ON THESE PLANS.

BENCH MARK  
NAIL 4" TAG @ INTERSECTION OF TENTH STREET AND ORANGE STREET. ELEV. = 849.05

CITY OF RIVERSIDE  
DOMESTIC SERVICES  
12/13/78

CAUTION - PACIFIC TELEPHONE  
CABLES UNDERGROUND  
BEFORE EXCAVATING  
CALL COLLECT

ALBERT W. WEBB ASSOCIATES  
CIVIL ENGINEERS  
RIVERSIDE, CALIFORNIA  
APPROVED BY: [Signature] DATE: 11/23/78  
R.E. No. 9876

CITY OF RIVERSIDE, CALIFORNIA  
DEPARTMENT OF PUBLIC WORKS  
APPROVED BY: [Signature] DATE: 12/15/78

"AS BUILT" 10-26-79 B.P.  
SEWER PLAN AND PROFILE  
TENTH STREET SEWER  
RELOCATION BETWEEN  
LEMON ST. AND ORANGE ST.  
5-1191  
SHEET 1 OF 1  
16-11A-B