


**GENERAL NOTES**

1. THE PRIVATE ENGINEER SIGNING THESE PLANS IS RESPONSIBLE FOR THE ACCURACY AND ACCEPTABILITY OF THE WORK HEREON. IN THE EVENT OF DISCREPANCIES ARISING DURING CONSTRUCTION, THE PRIVATE ENGINEER SIGNING THESE PLANS SHALL BE RESPONSIBLE FOR DETERMINING AN ACCEPTABLE SOLUTION AND REVISING THE PLANS FOR APPROVAL BY THE CITY.
2. IT SHALL BE THE RESPONSIBILITY OF THE CONTRACTOR TO CLEAR THE RIGHT OF WAY IN ACCORDANCE WITH PROVISIONS OF LAW AS IT AFFECTS EACH UTILITY INCLUDING IRRIGATION LINES AND APPURTENANCES AND AT NO COST TO THE CITY.
3. CONSTRUCTION SHALL BE IN ACCORDANCE WITH THE CITY OF RIVERSIDE, DEPARTMENT OF PUBLIC WORKS, STANDARD DRAWINGS, AND THE STANDARD SPECIFICATIONS FOR PUBLIC WORKS CONSTRUCTION, 1979 EDITION.
4. BACKFILL SHALL BE IN ACCORDANCE WITH THE CITY OF RIVERSIDE STD. DWG. NO. 453.
5. PIPE SHALL BE BEDDED PER CASE I, CITY OF RIVERSIDE STD. DWG. NO. 452.
6. LOCATION OF LATERALS TO BE DETERMINED IN THE FIELD AT THE DIRECTION OF THE OWNER. AVOID CONFLICT WITH PROPOSED AND/OR EXISTING FACILITIES.
7. CONTRACTOR IS TO VERIFY EXISTING SEWER ELEVATIONS PRIOR TO CONSTRUCTION.
8. ALL STATIONING ON SEWER CENTERLINE.
9. THE CONTRACTOR SHALL BE RESPONSIBLE TO REPAIR OR REPLACE IN KIND AT HIS OWN EXPENSE ANY IMPROVEMENTS DAMAGED BY HIS OPERATION DURING CONSTRUCTION.
10. A PLUG SHALL BE INSTALLED AND WILL REMAIN IN PLACE WHERE THE NEW SEWER CONNECTS WITH THE EXISTING SEWER UNTIL THE NEW SEWER IS ACCEPTED BY THE CITY.
11. THE SEWER CONTRACTOR SHALL ADJUST MANHOLES TO FINAL GRADE AFTER PAVING IS COMPLETED.
12. THE CONTRACTOR SHALL CALL IN A LOCATION REQUEST TO UNDERGROUND SERVICE ALERT (U.S.A.) PHONE NO. 1-800-422-4133, TWO WORKING DAYS BEFORE DIGGING. NO CONSTRUCTION PERMIT WILL BE ISSUED BY THE PUBLIC WORKS DEPARTMENT INVOLVING EXCAVATION FOR UNDERGROUND FACILITIES UNLESS THE APPLICANT HAS BEEN PROVIDED AN INQUIRY IDENTIFICATION NUMBER BY U.S.A.

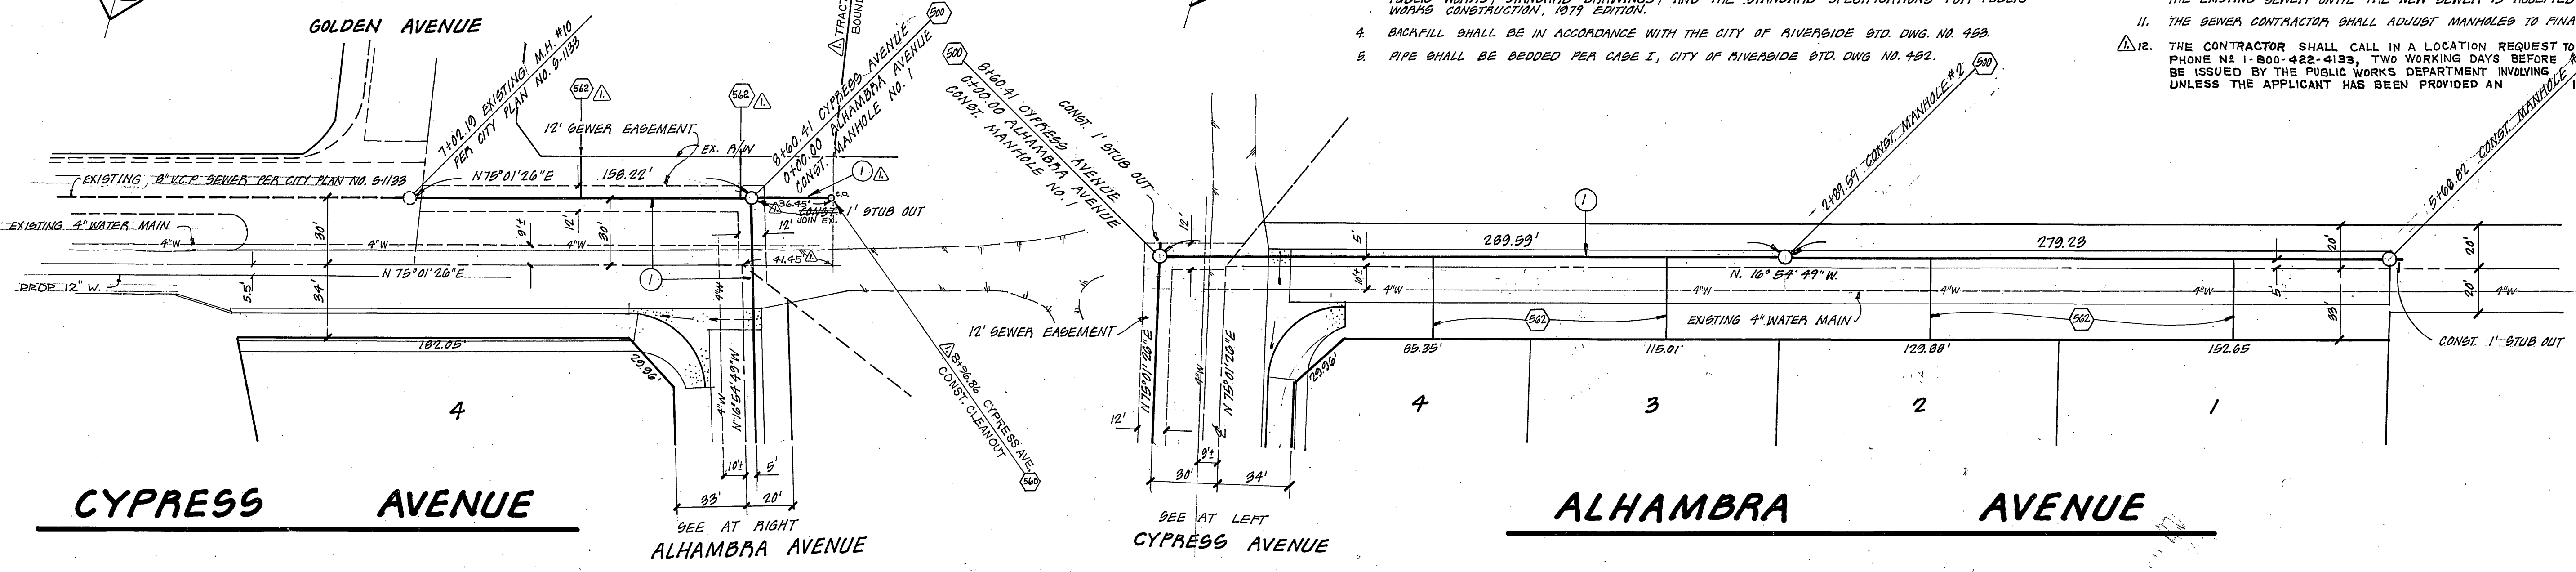

**CONSTRUCTION NOTES**

- 500 - CONST. MANHOLE PER CITY OF RIVERSIDE STD. DWG. NO. 500
- 562 - CONST. SEWER LATERAL PER CITY OF RIVERSIDE STD. DWG. NO. 562
- 564 - CONST. SEWER CLEANOUT PER CITY OF RIVERSIDE STD. DWG. 564
- 1 - CONST. 8" V.C.P. SEWER MAIN.

**NOTICE TO CONTRACTOR**

THE EXISTENCE AND LOCATION OF ANY UNDERGROUND UTILITY PIPES OR STRUCTURES SHOWN ON THIS PLAN ARE OBTAINED BY A SEARCH OF THE AVAILABLE RECORDS TO THE BEST OF OUR KNOWLEDGE THERE ARE NO EXISTING UTILITIES EXCEPT AS SHOWN ON THESE PLANS. THE CONTRACTOR IS REQUIRED TO TAKE DUE PRECAUTIONARY MEASURES TO PROTECT THE UTILITY LINES SHOWN AND ANY OTHER LINES NOT OF RECORD OR NOT SHOWN ON THIS PLAN.

**CITY OF RIVERSIDE DOMESTIC SYSTEM**

APPROVED BY: *Fred Rant*  
 DATE: 9/25/80  
 CHIEF UTILITIES ENGINEER, WATER

PLANS CHECKED AND FOUND TO COMPLY WITH CITY OF RIVERSIDE REQUIREMENTS:  
 BY: *Max Sloan* RCE 1035A 1-3-80  
 BERRYMAN & STEPHENSON INC. DATE

REVISIONS:	APPROVED:

W. J. McKEEVER, INC.  
 CIVIL ENGINEERING  
*William J. McKeever* 12/10/77  
 3564 CENTRAL AVENUE, RIVERSIDE, CALIFORNIA

APPROVED BY: *Thad A. Miller*  
 DIRECTOR OF PUBLIC WORKS  
 DATE: 3/1/80

APPROVED BY: *[Signature]*  
 BY: *[Signature]* DATE: 8-9-80  
 CITY OF RIVERSIDE CALIFORNIA  
 DEPARTMENT OF PUBLIC WORKS

SCALE: HORIZ. 1"=40'  
 VERT. 1"=4'  
 DATE DEC. 1977  
 BENCH MARK: T.P. NAIL IN CENTER OF 3"X 3" CUPS RETURN AT CAMPBELL AVE. AND LA BRENDA AVE., CITY OF RIVERSIDE PRECISE DATUM 62.8 ELEV. 771.134

THESE PLANS ARE FOR SEWER CONSTRUCTION ONLY.  
 \* AS BUILT 6-19-81  
 INDEXED R/C

PARCEL MAP NO. 10467  
 SEWER PLAN AND PROFILE  
 CYPRESS AVENUE  
 ALHAMBRA AVENUE

5-1220  
 OF 1 SHEETS  
 FILE NO. -