


NOTE: THIS SEWER MAY NOT EXIST AT THE TIME OF CONSTRUCTION. IF SEWER DOES NOT EXIST, PLUG BOTH ENDS OF 8" V.C.P. (SEE S-1252)

NOTE: TRENCH RESURFACING STRUCTURAL SECTION SHALL BE: 0.85 FULL DEPTH AC OR 0.38 AC OVER 1.15" BASE MATERIAL.

FB 1029/44
ELEV 716.814
BM 60121-68
BRASS DISC SET IN CONCRETE
86' SW OF E POLK ST.
9' SE OF E MAGNOLIA

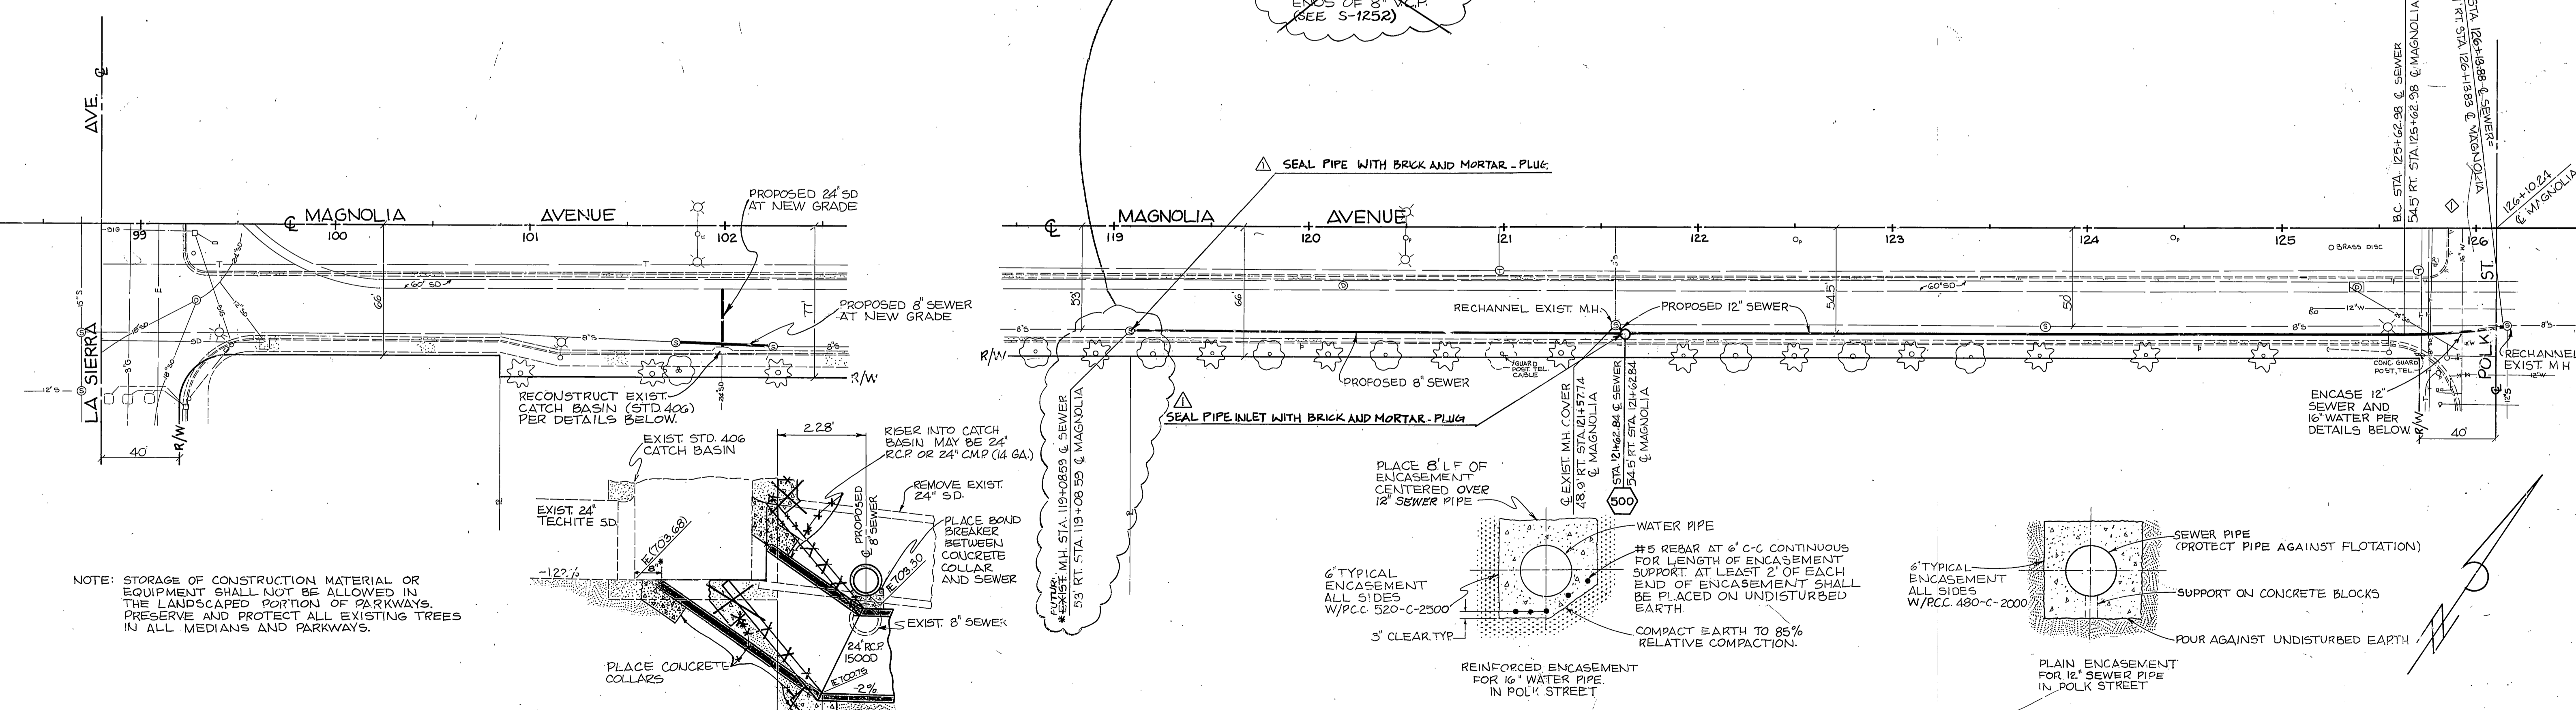

NOTE: STORAGE OF CONSTRUCTION MATERIAL OR EQUIPMENT SHALL NOT BE ALLOWED IN THE LANDSCAPED PORTION OF PARKWAYS. PRESERVE AND PROTECT ALL EXISTING TREES IN ALL MEDIANS AND PARKWAYS.

NOTE: AN EPOXY BONDING AGENT SHALL BE PLACED TO BOND NEW CONCRETE TO OLD CONCRETE

CURVE	Δ	R	T	L
◇	6° 56' 39"	420'	25.48'	50.90'

CITY OF RIVERSIDE
PUBLIC WORKS DEPARTMENT

APPROVED BY: [Signature]
DATE: 8/24/13

DESIGNED BY: [Signature] DRAWN BY: CR CHECKED BY: [Signature]

MAGNOLIA AVE. RELIEF SEWER
LA SIERRA AVE. TO POLK ST. (PORTIONS)

APPROVED BY: [Signature]
DATE: 8/21/13

INDEXED BLD
ACCOUNT NO. 32-577-534
S-1248
SHEET 1 OF 1

HORIZ. SCALE: 1" = 40' VERT. SCALE: 1" = 4'