


PROPERTY OF
CITY OF OMAHA
DEPT. OF PUBLIC WORKS
ENGINEERING DIVISION



PROFILE		BY	DATE
SURVEYED			
PLOTTED			
GLASSES CHECKED			
3H - NOTED			
STRUCTURE BEARING CHART			
NO.			

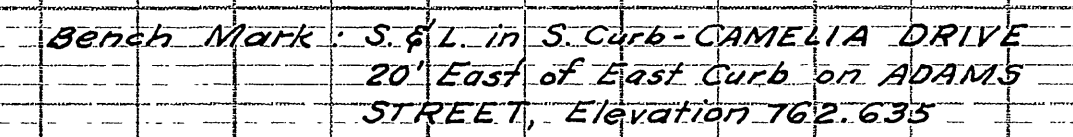

PROPERTY OF
CITY OF RIVERSIDE
DEPT. OF PUBLIC WORKS
ENGINEERING DIVISION

CITY OF RIVERSIDE, CALIFORNIA
DEPARTMENT OF PUBLIC WORKS

CAMELIA DRIVE
SEWER PLAN AND PROFILE

MUELLER TRACT
Horiz. Scale 1"=50' Vert. Scale 1"=5'

Approved by Tom Martinez FILE NO. **S-125**
Director of Public Works
B. Date June 27, 1958 Sheet 1 of 1

PROPERTY OF
CITY OF RIVERSIDE
DEPT. OF PUBLIC WORKS
ENGINEERING DIVISION

- "As Built" House Connections, 10/27/58 H. Ball

13. Date June 27, 1958 Sheet 1 of 1