
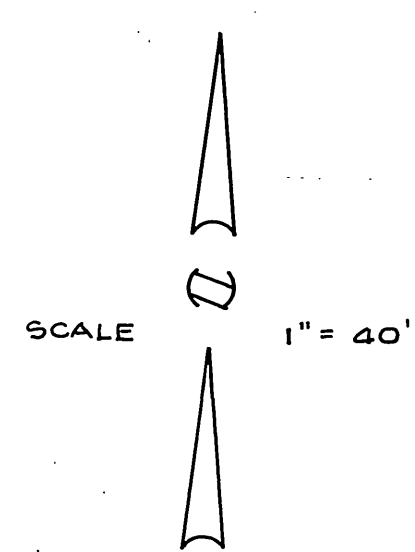


PROFILE
 HORIZ. 1" = 40'
 VERT. 1" = 4'

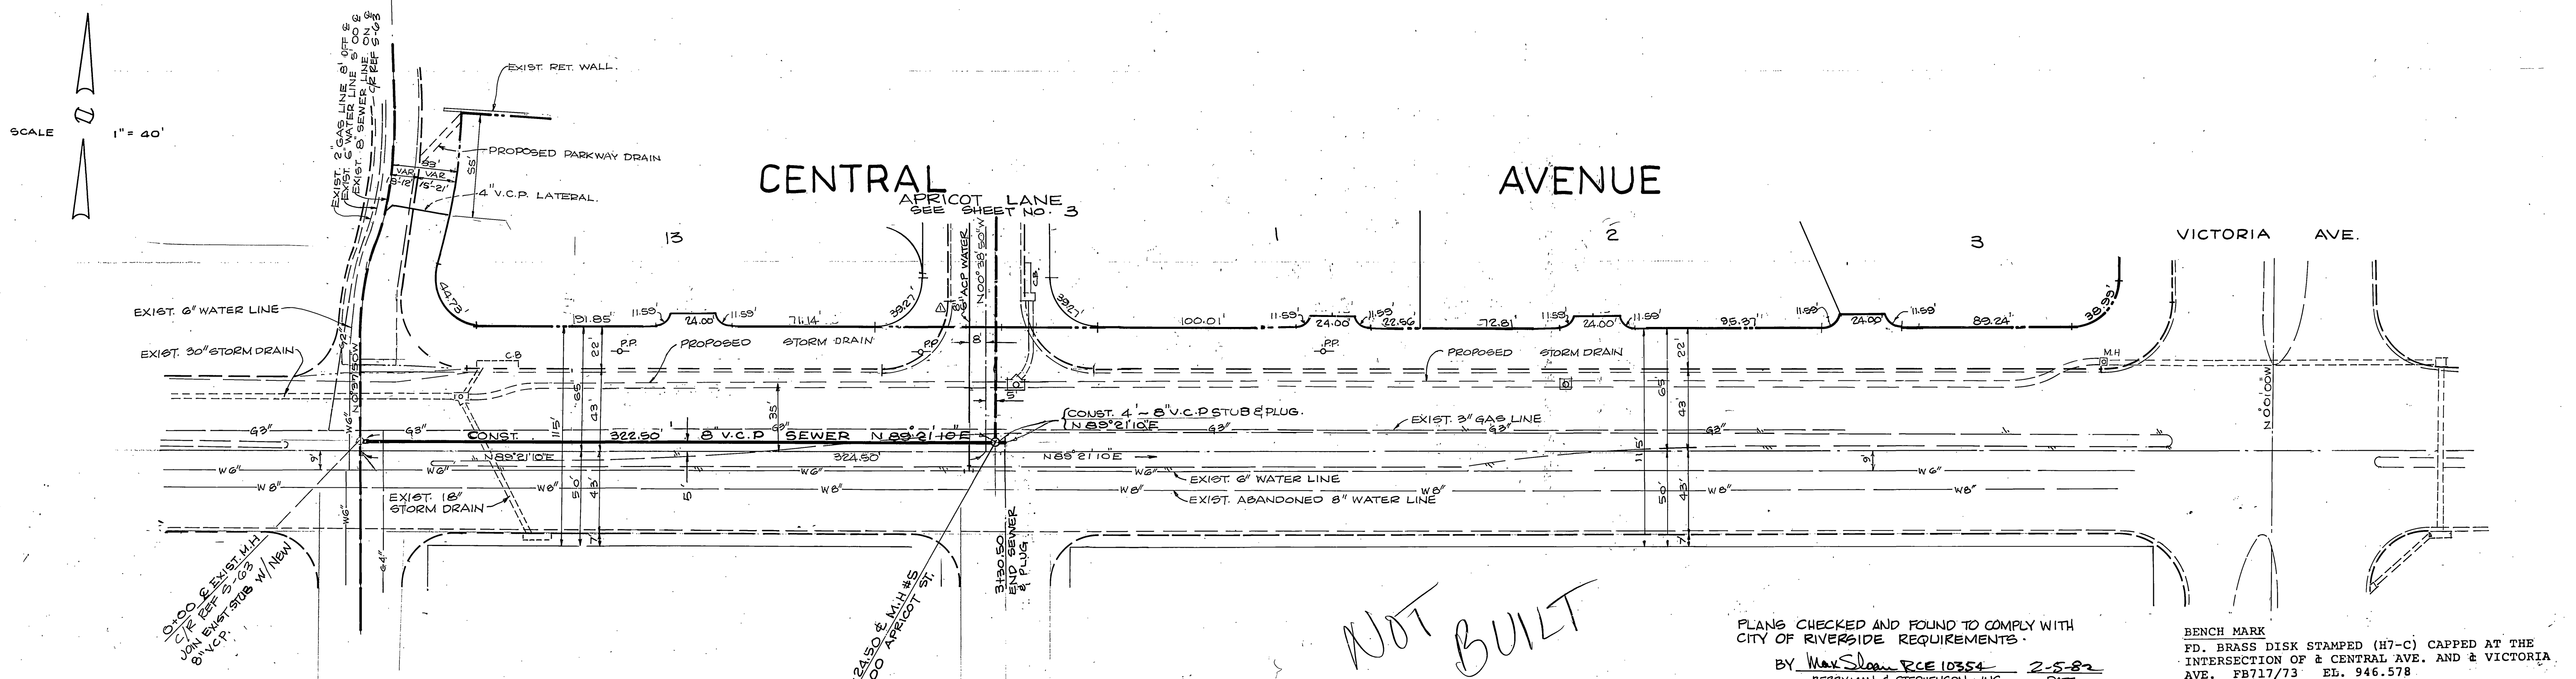

NOT BUILT

PLANS CHECKED AND FOUND TO COMPLY WITH
 CITY OF RIVERSIDE REQUIREMENTS.
 BY Max Sloan PCE 10354 2-5-82
 BERRYMAN & STEPHENSON, INC. DATE

BENCH MARK
 FD. BRASS DISK STAMPED (H7-C) CAPPED AT THE
 INTERSECTION OF CENTRAL AVE. AND VICTORIA
 AVE. FB717/73 EL. 946.578

APPROVED BY:
Ered Rant
 CHIEF UTILITIES ENGINEER, WATER 1/29/80


MADOLE & ASSOCIATES, INC.
 CONSULTING CIVIL ENGINEERING
 1820 E. 16TH STREET
 SANTA ANA CALIFORNIA 92701
 DESIGNED BY D.M. DRAWN BY R.S. CHECKED BY
 DATE 2-13-79

MARK	REVISIONS	DATE
Δ	REMOVED SIZE OF WATER LINE	3/10/82

CITY OF RIVERSIDE, CALIFORNIA
PUBLIC WORKS DEPARTMENT
 APPROVED BY
 PRINCIPAL ENGINEER
 PARK DEPARTMENT
 TRAFFIC DIVISION
 CHIEF PUBLIC WORKS ENGR.
 BY [Signature] DATE 3/12/82


SEWER PLAN & PROFILE
TRACT NO. 9790
CENTRAL AVENUE
 SCALE: HORIZ. 1" = 40' VERT. 1" = 4'

INDEX
 ACCOUNT No.
 DRAWING NUMBER
5-1264
 SHEET 2 OF 4

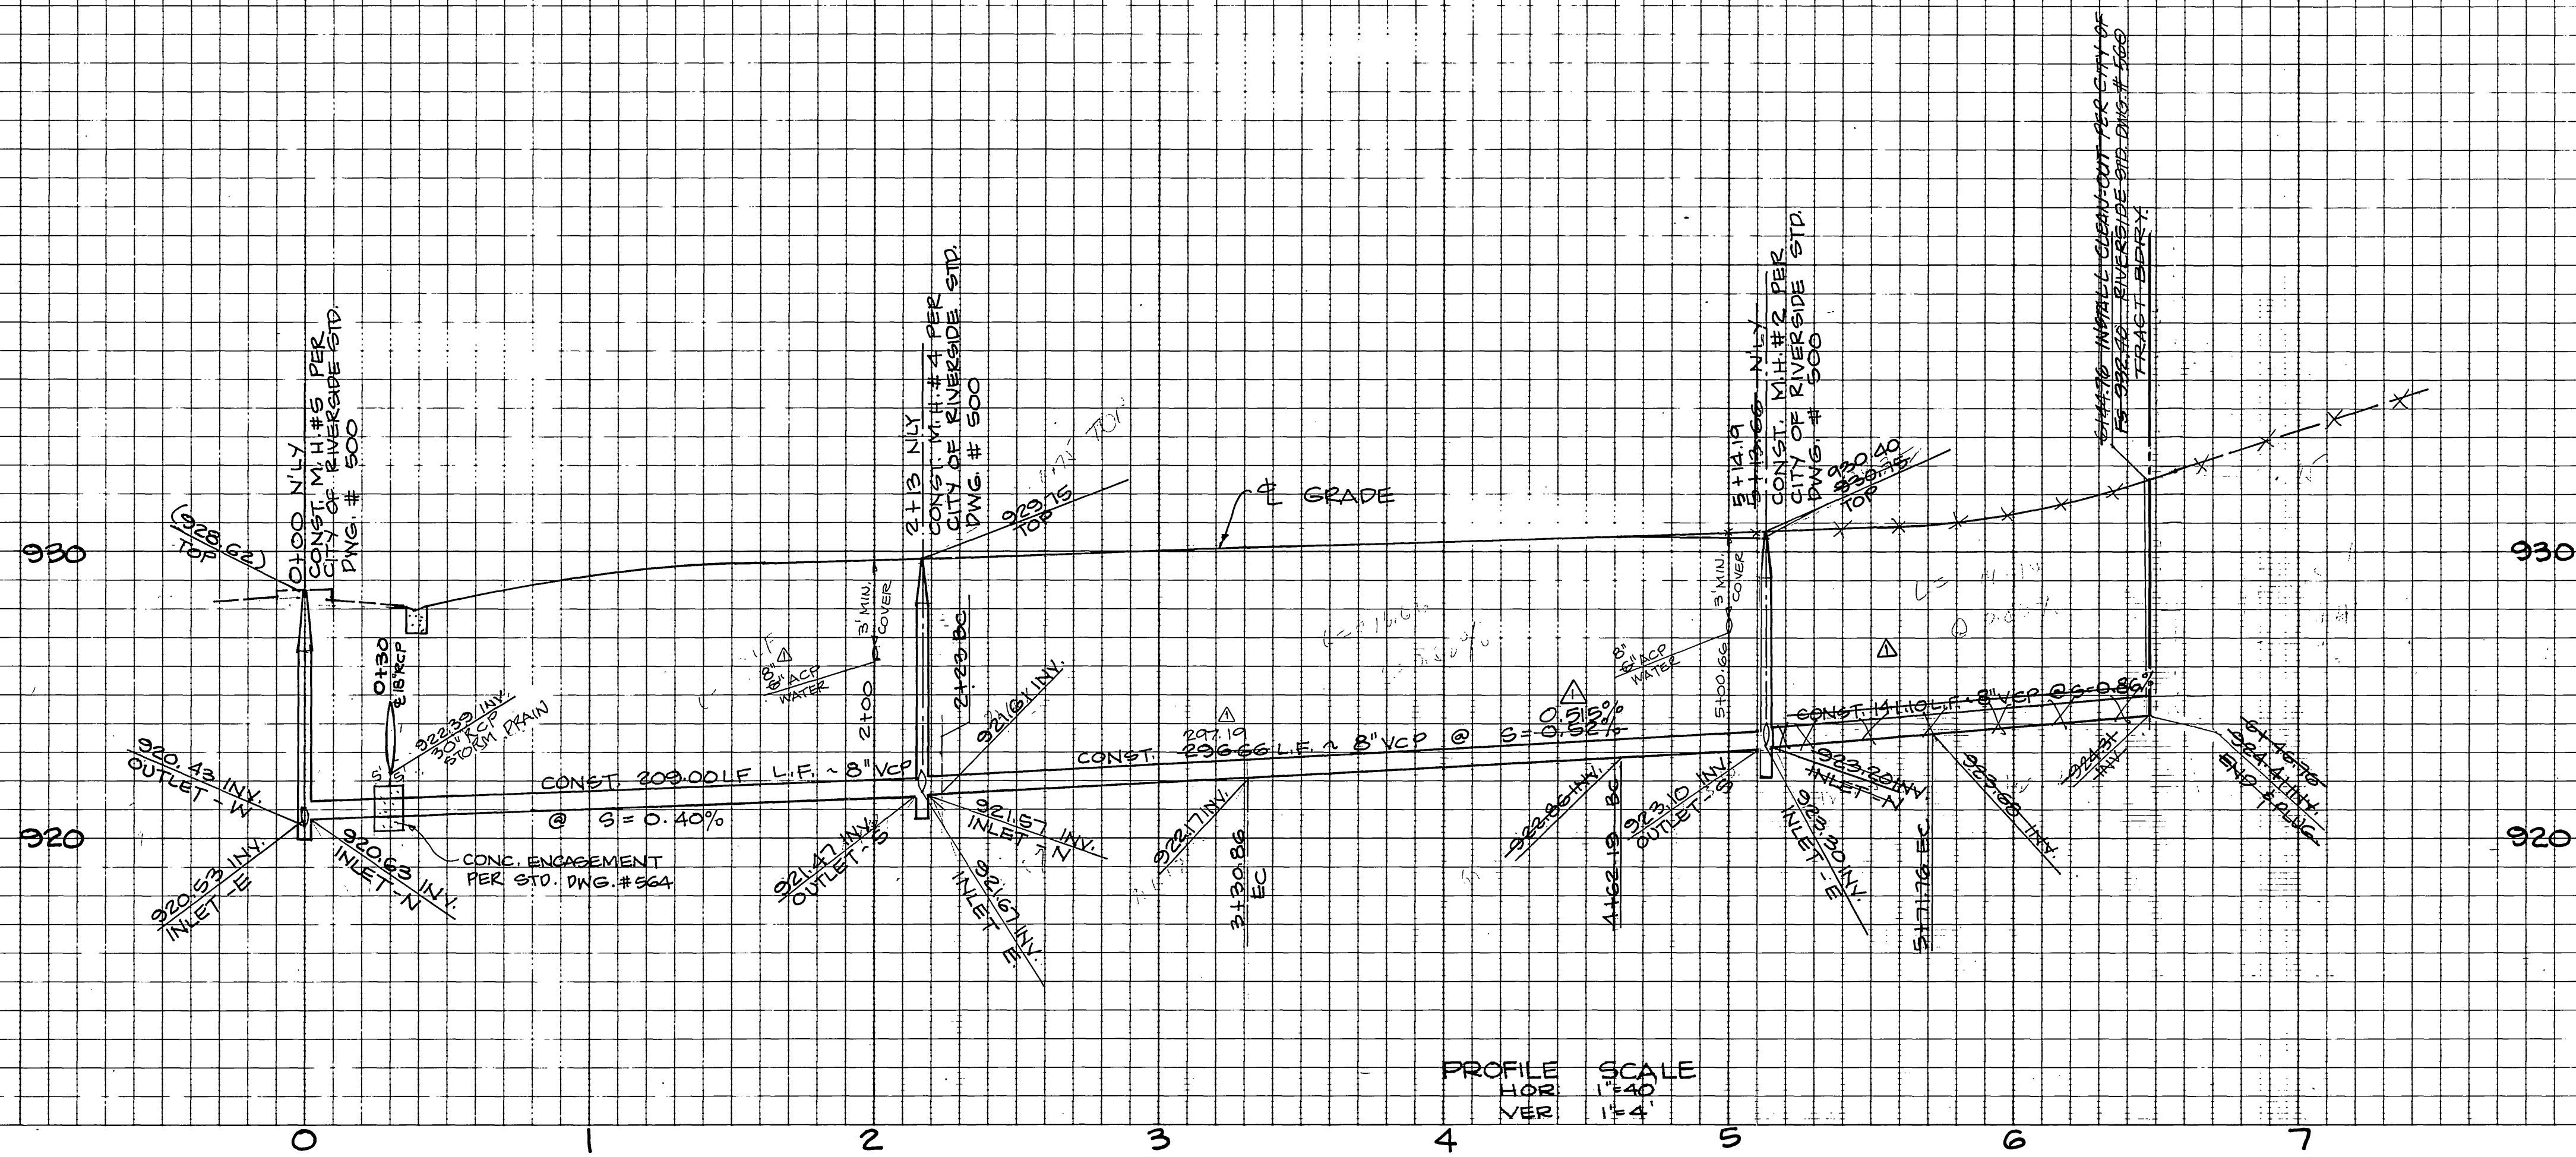

PROFILE SCALE
HORIZ. 1"=40'
VERT. 1"=4'


SCALE: 1"=40'

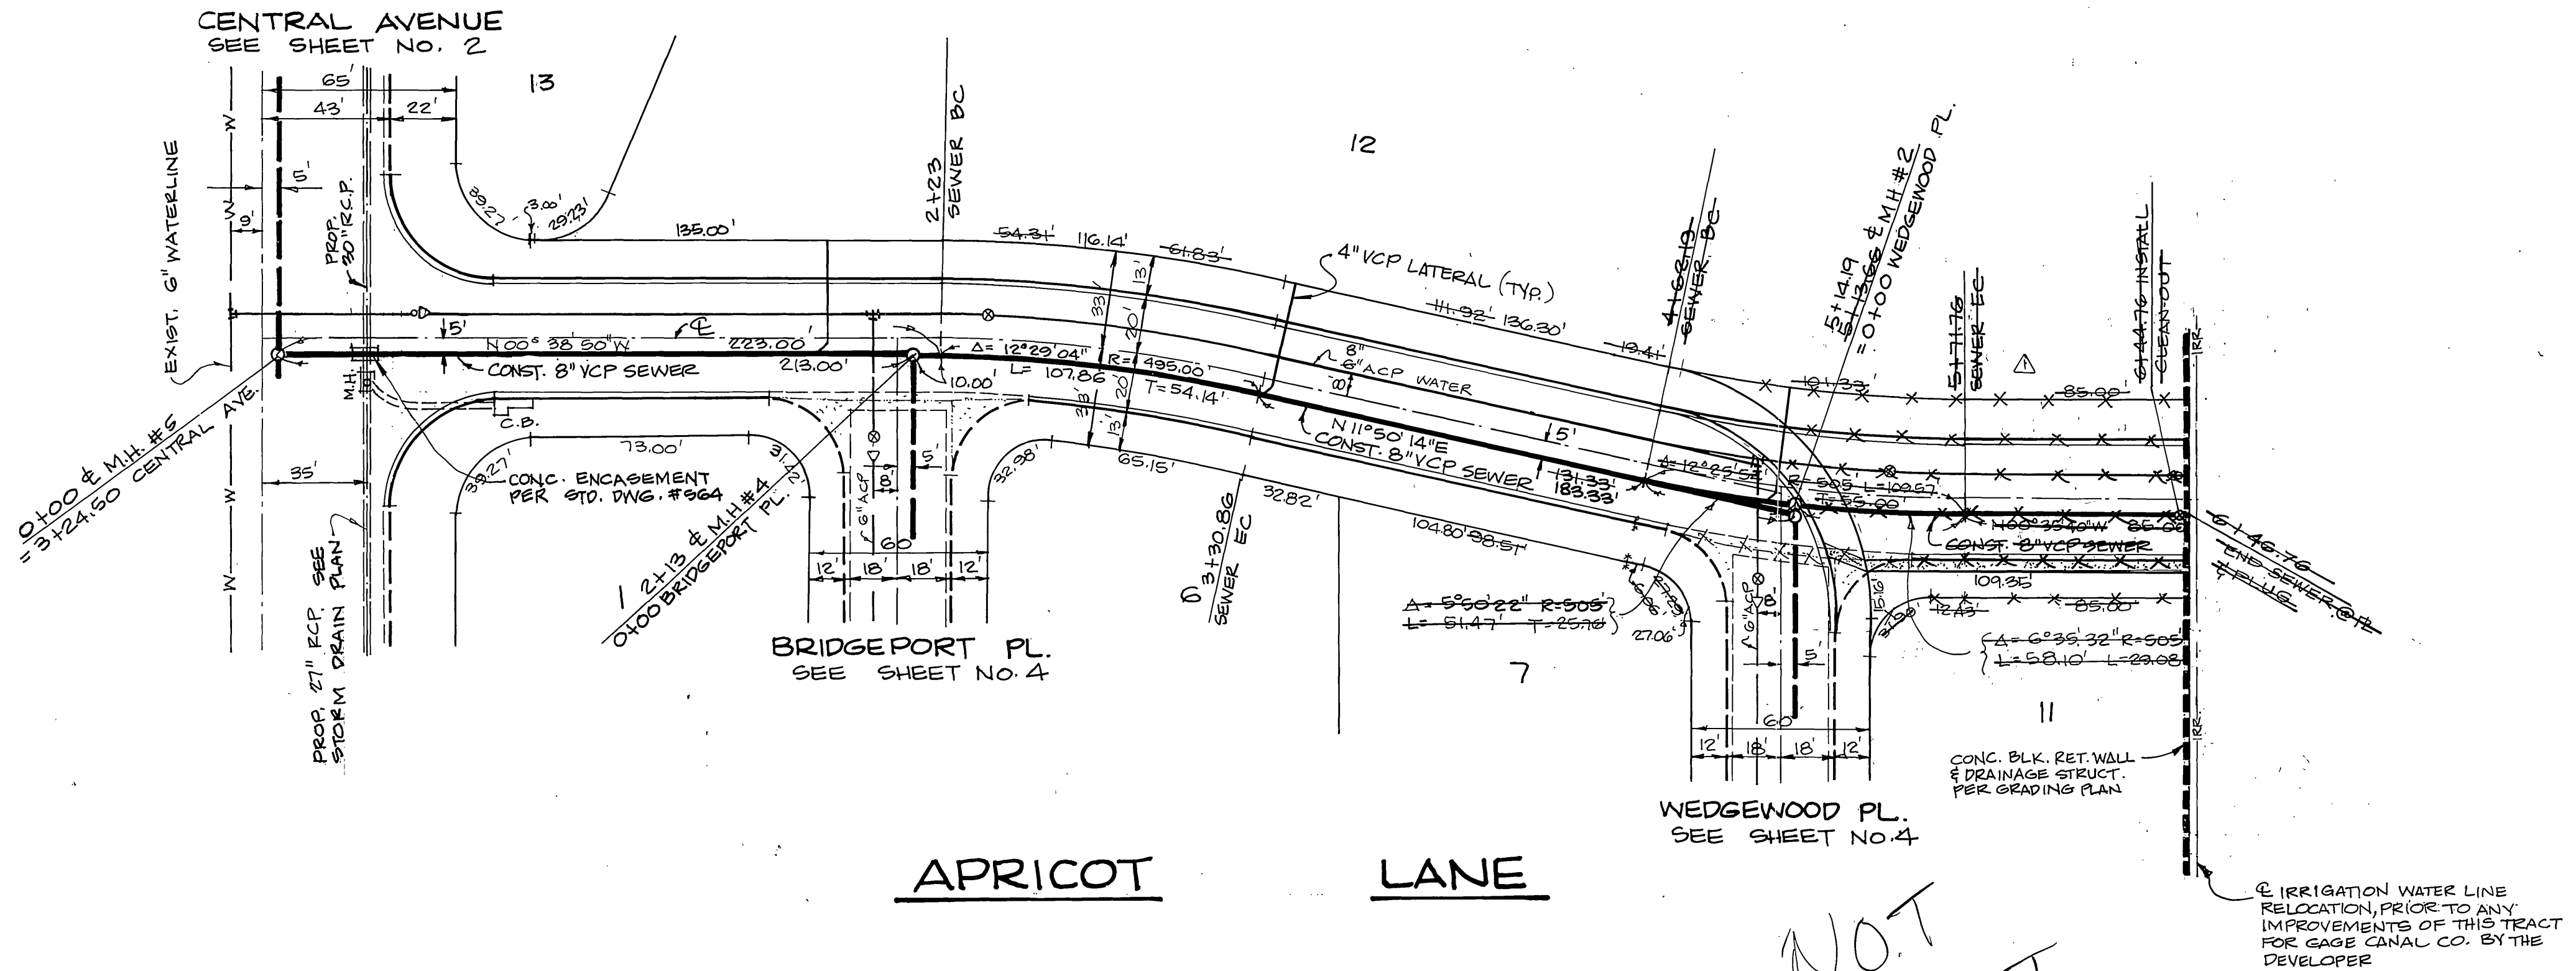

PLANS CHECKED AND FOUND TO COMPLY WITH
CITY OF RIVERSIDE REQUIREMENTS.
BY Max Sloan RCE 10354 2-5-82
BERRYMAN & STEPHENSON, INC. DATE

BENCH MARK
FD. BRASS DISK STAMPED (H7-C) CAPPED AT THE
INTERSECTION OF CENTRAL AVE. AND VICTORIA
AVE. FB717/73 EL. 946.578


CITY OF RIVERSIDE DOMESTIC SYSTEM <i>Fred Lent</i> 1/23/80 CHIEF UTILITIES ENGINEER-WATER	MADOLE AND ASSOCIATES, INC. CONSULTING CIVIL ENGINEERS AND LAND PLANNERS 1820 E. 16TH STREET SANTA ANA, CALIFORNIA 92701 PHONE 714-835-2548 <i>J.M. Madole</i> J.M. MADOLE, RCE 14814 DATE 8-13-79 FOR: DAINWA HOUSE CORP. OF CALIF.	REVISED ALIGNMENT OF APRICOT LN. & WATER LINE SIZE REVISIONS DESIGNED BY D.M. DRAWN BY R.B. CHECKED BY	CITY OF RIVERSIDE, CALIFORNIA PUBLIC WORKS DEPARTMENT APPROVED BY PRINCIPAL ENGINEER PARK DEPARTMENT TRAFFIC DIVISION CHIEF PUBLIC WORKS ENGINEER DATE 3/12/82	APPROVED BY DIRECTOR OF PUBLIC WORKS DATE 3/12/82	SEWER PLAN & PROFILE TRACT NO. 9790 APRICOT LANE SCALE: HORIZ. 1"=40' VERT. 1"=4'	ACCOUNT NO. DRAWING NUMBER S-1264 SHEET 3 OF 4
					INDEX	JN 185-495

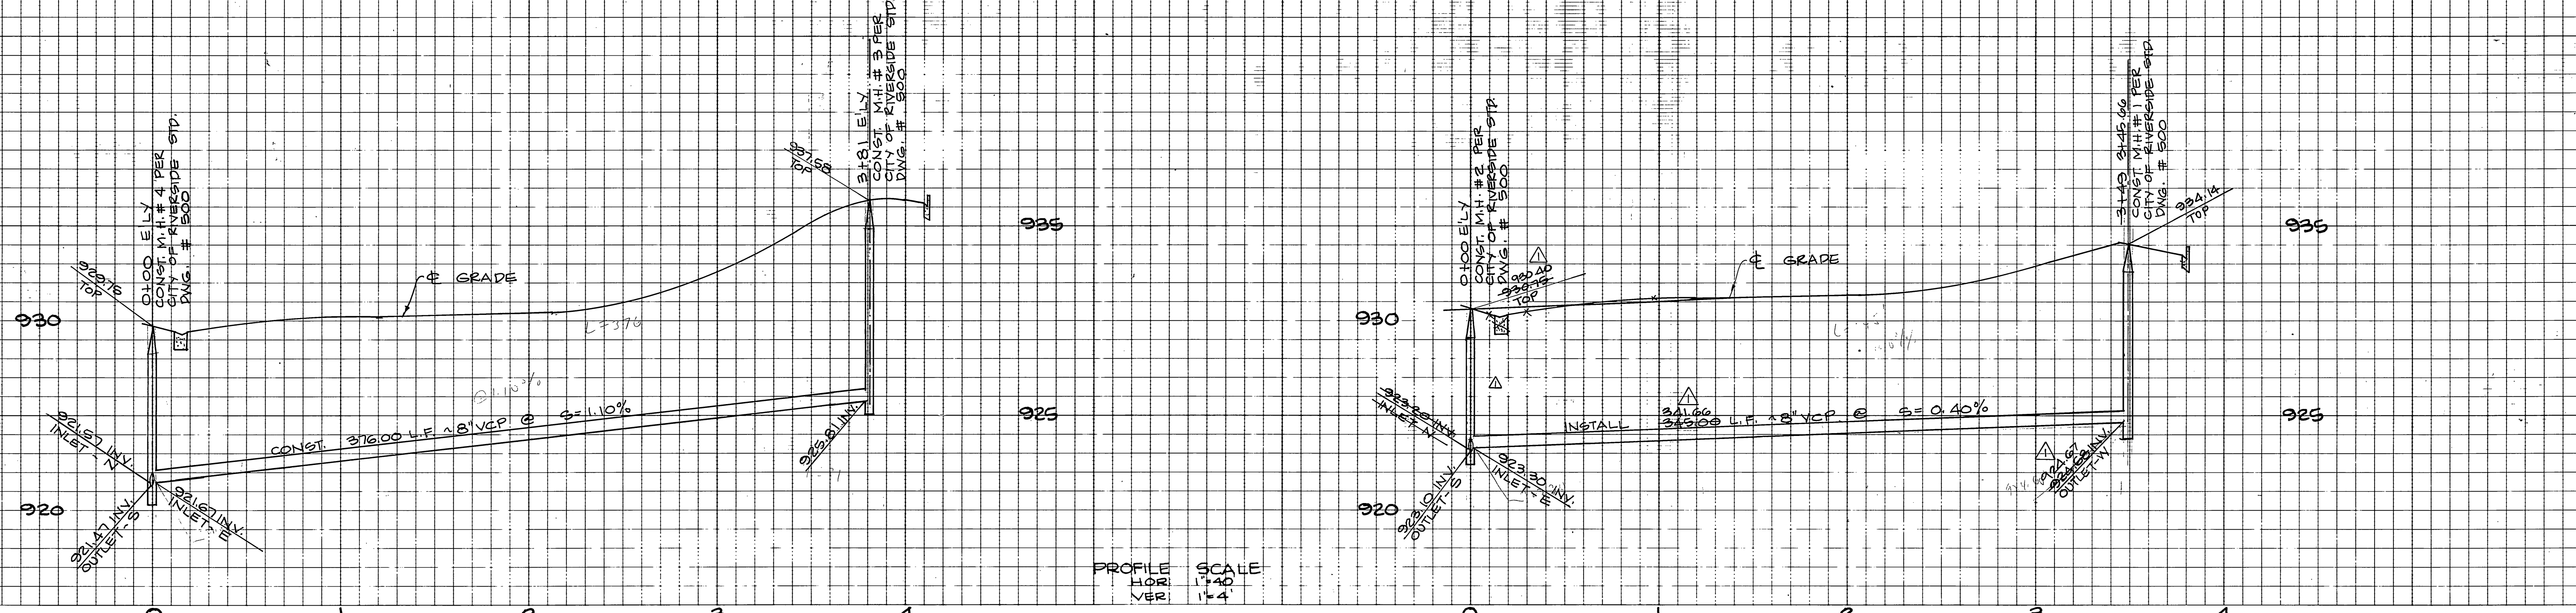


PROFILE SCALE
 HORI. 1"=40'
 VERT. 1"=4'

SCALE: 1"=40'

SCALE: 1"=40'

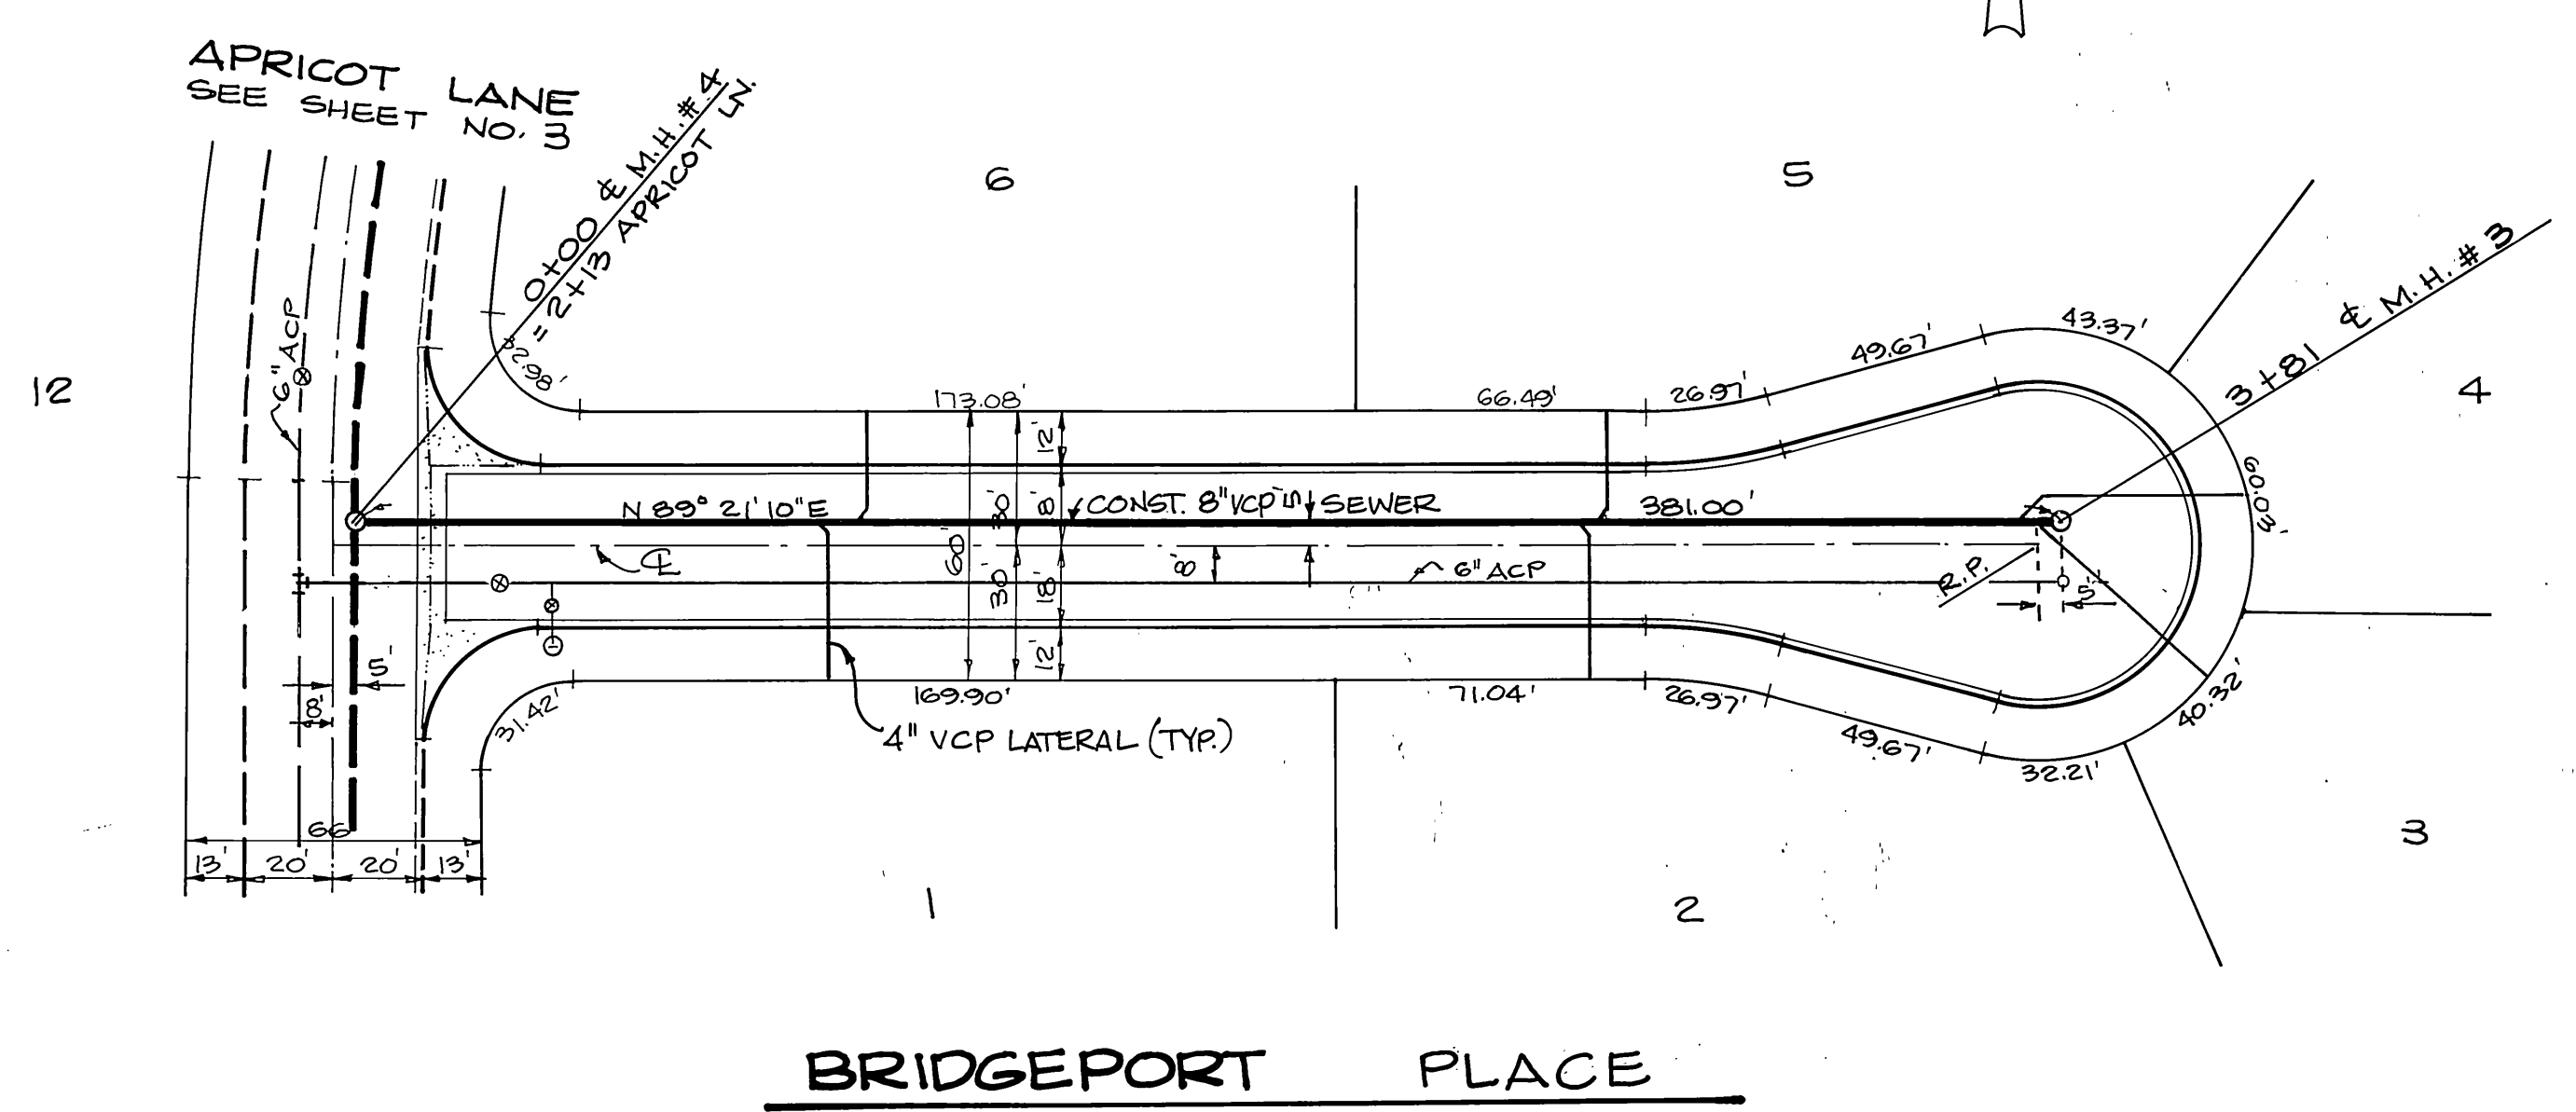

BRIDGEPORT PLACE

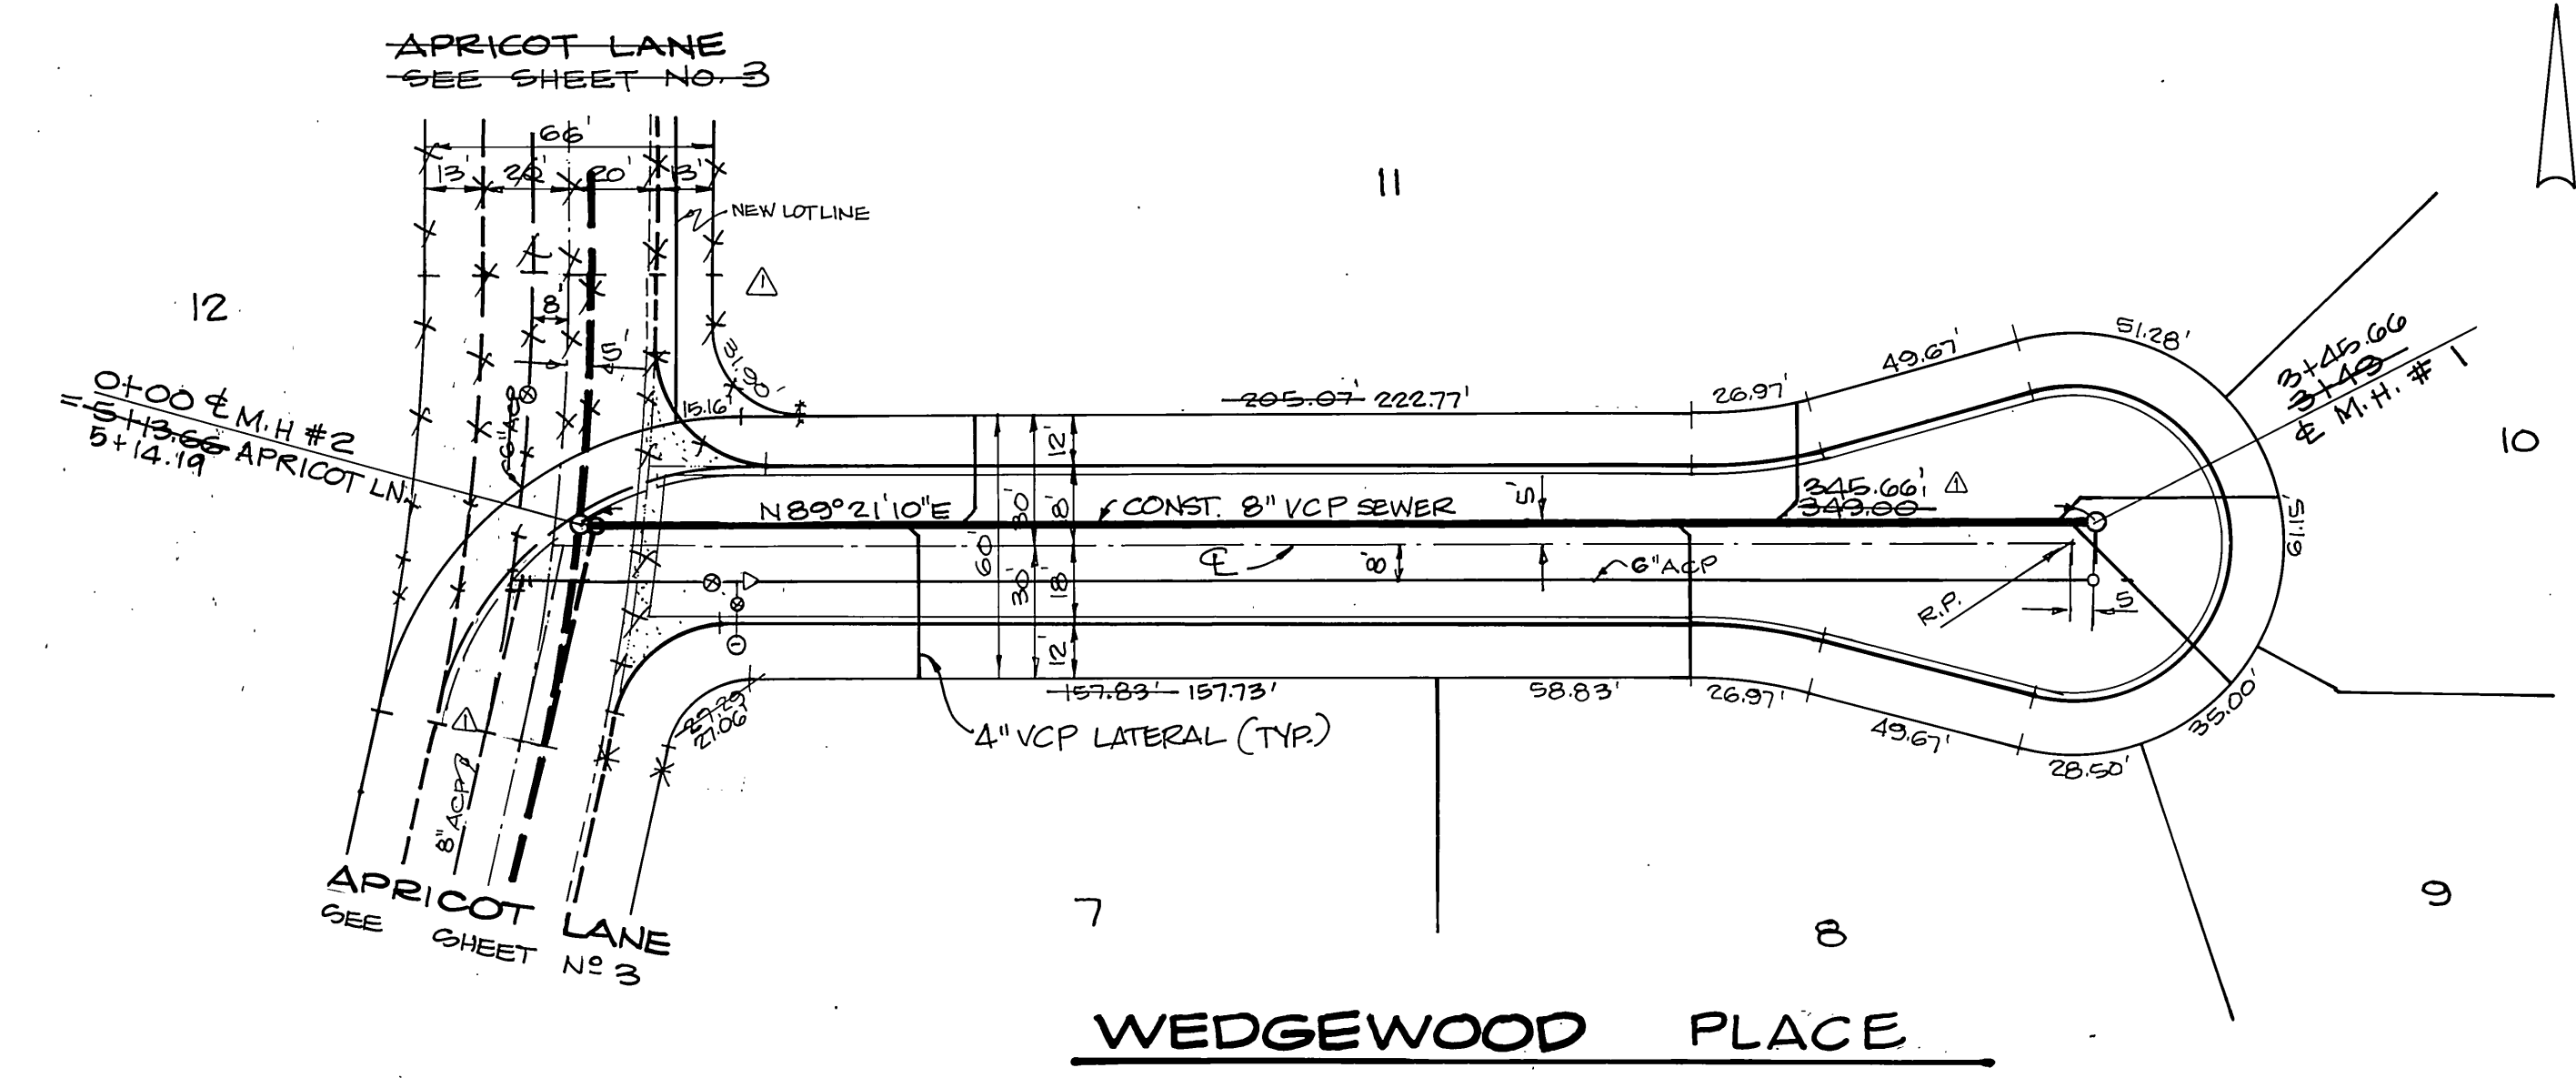

WEDGEWOOD PLACE

NOT BUILT

PLANS CHECKED AND FOUND TO COMPLY WITH CITY OF RIVERSIDE REQUIREMENTS.

BY Max Sloan RCE 10554 2-5-82
 BERRYMAN & STEPHENSON - INC. DATE

BENCH MARK
 FD. BRASS DISK STAMPED (H7-C) CAPPED AT THE INTERSECTION OF CENTRAL AVE. AND VICTORIA AVE. FB717/73 EL. 946.578

CITY OF RIVERSIDE DOMESTIC SYSTEM <i>Fred Lent</i> 1/22/10 CHIEF UTILITIES ENGINEER, WATER DATE	MADOLE AND ASSOCIATES, INC. CONSULTING CIVIL ENGINEERS AND LAND PLANNERS 1820 E. 16 TH STREET SANTA ANA, CALIFORNIA 92701 PHONE 714 • 835-2548 <i>J.M. Madole</i> J.M. MADOLE, RCE 14814 FOR: DAINA HOUSE CORP. OF CALIF. DATE 8-13-79	REVISIONS REVISED APRICOT LN. ALIGNMENT WATER LINE SIZE DATE DESIGNED BY D.M. DRAWN BY R.S. CHECKED BY	CITY OF RIVERSIDE, CALIFORNIA PUBLIC WORKS DEPARTMENT	SEWER PLAN & PROFILE TRACT NO. 9700 BRIDGEPORT PLACE WEDGEWOOD PLACE	ACCOUNT NO. DRAWING NUMBER 5-1264 SHEET 4 OF 4
			APPROVED BY PRINCIPAL ENGINEER PARK DEPARTMENT TRAFFIC DIVISION DATE 3/12/82	APPROVED BY DIRECTOR OF PUBLIC WORKS DATE 3/12/82	SCALE: HORIZ. 1"=40' VERT. 1"=4'

70-1061