
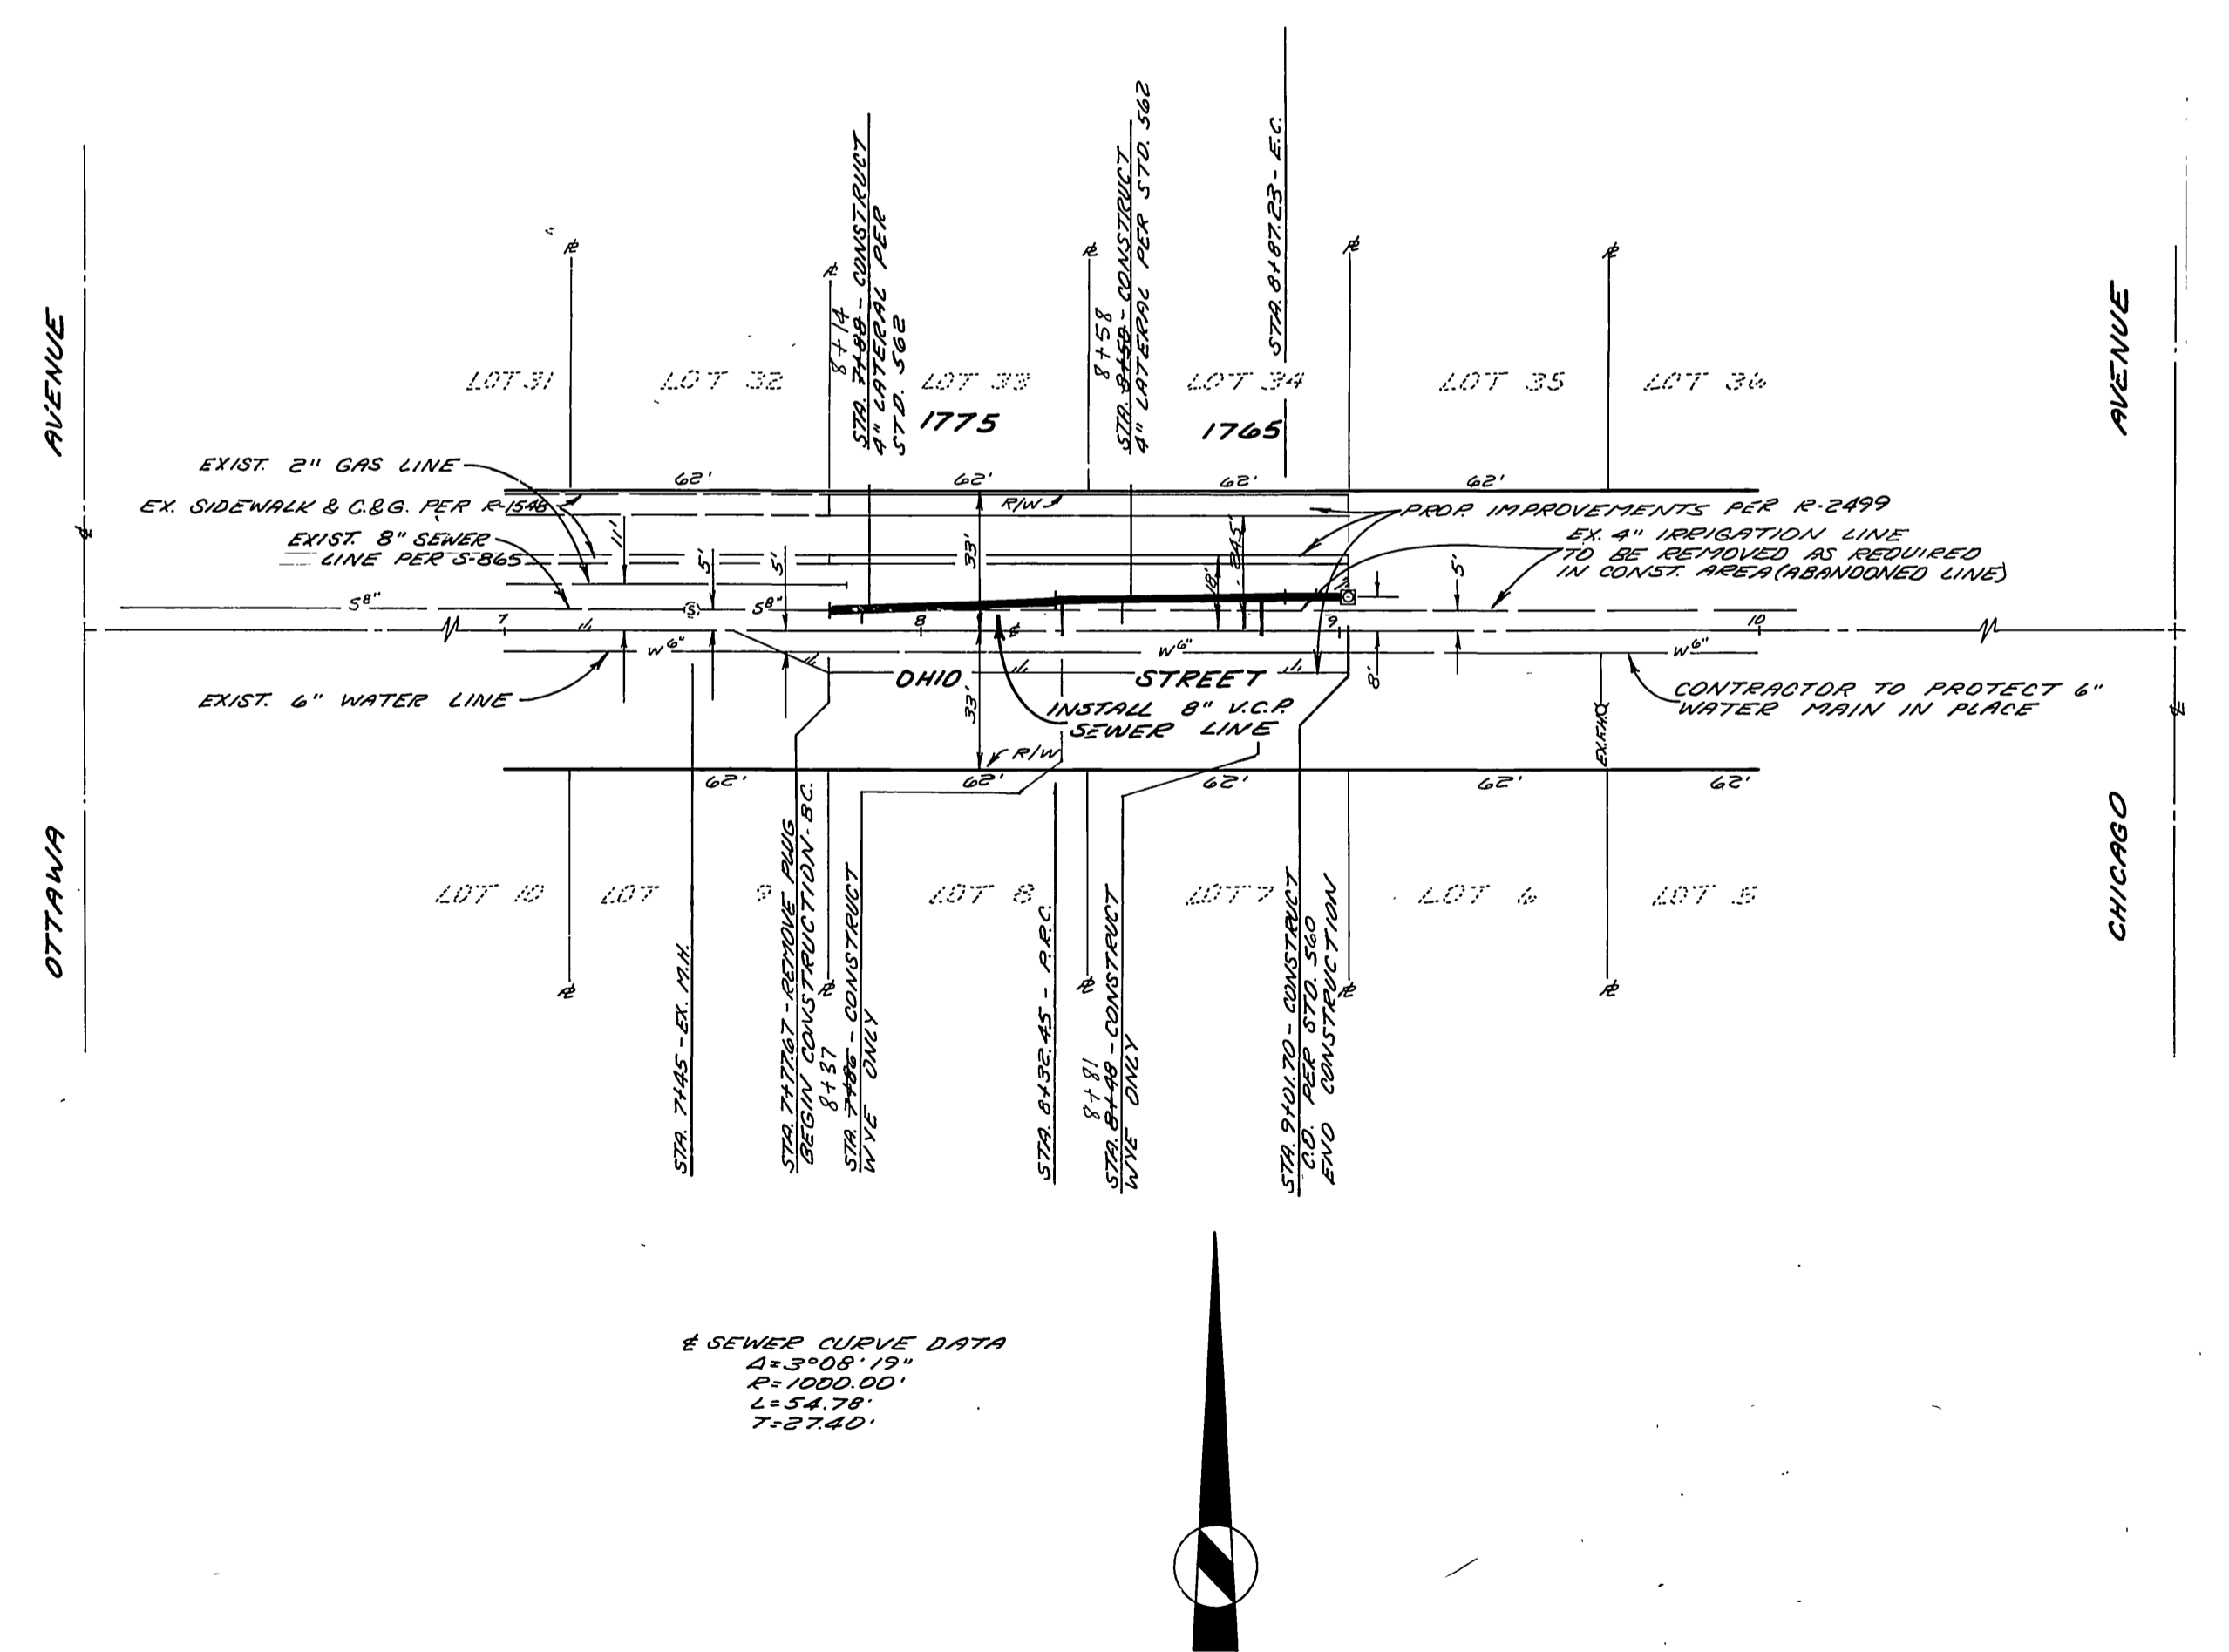


**GENERAL NOTES**

- IT SHALL BE THE RESPONSIBILITY OF THE CONTRACTOR TO CLEAR THE RIGHT OF WAY IN ACCORDANCE WITH THE PROVISIONS OF LAW AS IT AFFECTS EACH UTILITY INCLUDING IRRIGATION LINES AND APPURTENANCES AND AT NO COST TO THE CITY.
- CONSTRUCTION SHALL BE IN ACCORDANCE WITH THE CITY OF RIVERSIDE, DEPARTMENT OF PUBLIC WORKS STANDARD DRAWINGS, AND THE STANDARD SPECIFICATIONS FOR PUBLIC WORKS CONSTRUCTION, 1988 EDITION.
- CONTRACTOR IS TO VERIFY EXISTING SEWER ELEVATION PRIOR TO CONSTRUCTION.
- QUANTITIES SHOWN ARE FOR INFORMATION ONLY AND THE CITY OF RIVERSIDE IS NOT RESPONSIBLE FOR THEIR ACCURACY.
- ALL FLAGGED ELEVATIONS SHALL BE STAKED IN THE FIELD BY THE PRIVATE ENGINEER.
- A PLUG SHALL BE INSTALLED AND WILL REMAIN IN PLACE WHERE THE NEW SEWER CONNECTS WITH THE EXISTING SEWER UNTIL THE NEW SEWER IS ACCEPTED BY CITY.
- THE PRIVATE ENGINEER SIGNING THESE PLANS IS RESPONSIBLE FOR ASSURING THE ACCURACY AND ACCEPTABILITY OF THE WORK HEREON. IN THE EVENT OF DISCREPANCIES ARISING DURING CONSTRUCTION AS A RESULT OF ERRORS OR OMISSIONS, THE PRIVATE ENGINEER SHALL BE RESPONSIBLE FOR DETERMINING AN ACCEPTABLE SOLUTION AND REVISING THE PLANS FOR APPROVAL BY THE CITY.
- THE SEWER CONTRACTOR SHALL ADJUST CLEARCUT TO FINAL GRADE AFTER PAVING IS COMPLETED.

**ESTIMATE OF QUANTITIES**

1. INSTALL 8" V.C.P.	124 L.F.
2. INSTALL 4" V.C.P. LATERAL	50 L.F.
3. INSTALL CLEARCUT PER STA SID	1 EA.
4. INSTALL WYE AS SHOWN	2 EA.
5. REMOVE EX. 4" I.R.C. LINE AS REQUIRED	WUMP SUIT

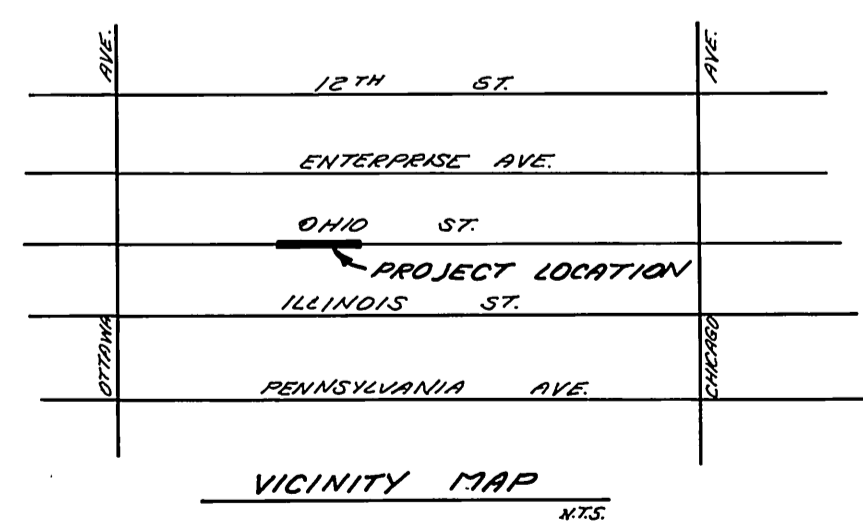

APPROVED BY:  
 DATE: 1-14-83  
 Owen R. McDevan  
 SO CALIF. GAS COMPANY

APPROVED BY:  
 DATE: 12/29/82  
 Fred Lamb  
 WATER SYSTEM MANAGER  
 WATER DIVISION

LYNN A. TERRY & ASSOCIATES  
 42321 MARBOLA AVENUE SUITE 11  
 RIVERSIDE, CALIFORNIA 92503  
 735-6850 399-0823  
 Lynn A. Terry R.C.E. P. 800 DATE

CITY OF RIVERSIDE, CALIFORNIA PUBLIC WORKS DEPARTMENT		SEWER IMPROVEMENT PLAN & PROFILE		INDEX OF ACCOUNT No.
APPROVED BY PRINCIPAL ENGINEER TRAFFIC DIVISION	BY DATE 12/14/83	APPROVED BY DIRECTOR OF PUBLIC WORKS	DRAWING NUMBER S-1311	
DESIGNED BY JERRY DRAWN BY JERRY CHECKED BY L.A.T.		DATE: 4/1/83	SHEET 1 OF 1	
SCALE: HORIZ. 1"=40' VERT. 1"=4'		* AS BUILT 3-15-84 B.M.E!		