





1170

1160


1150

1170


1160

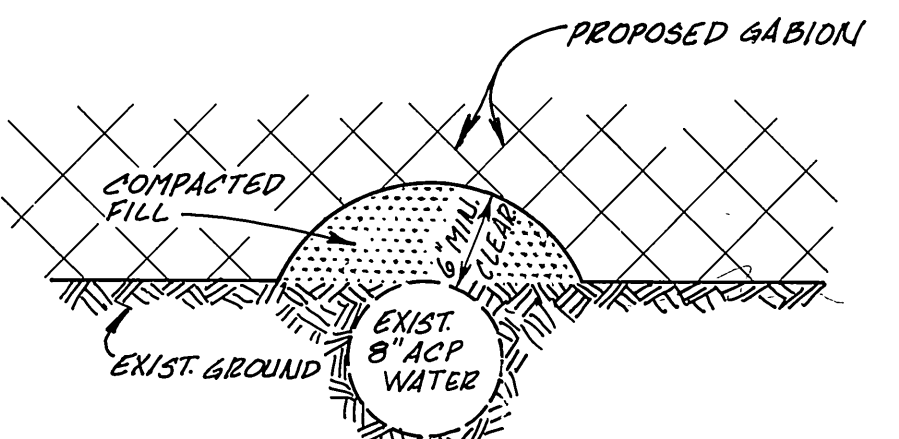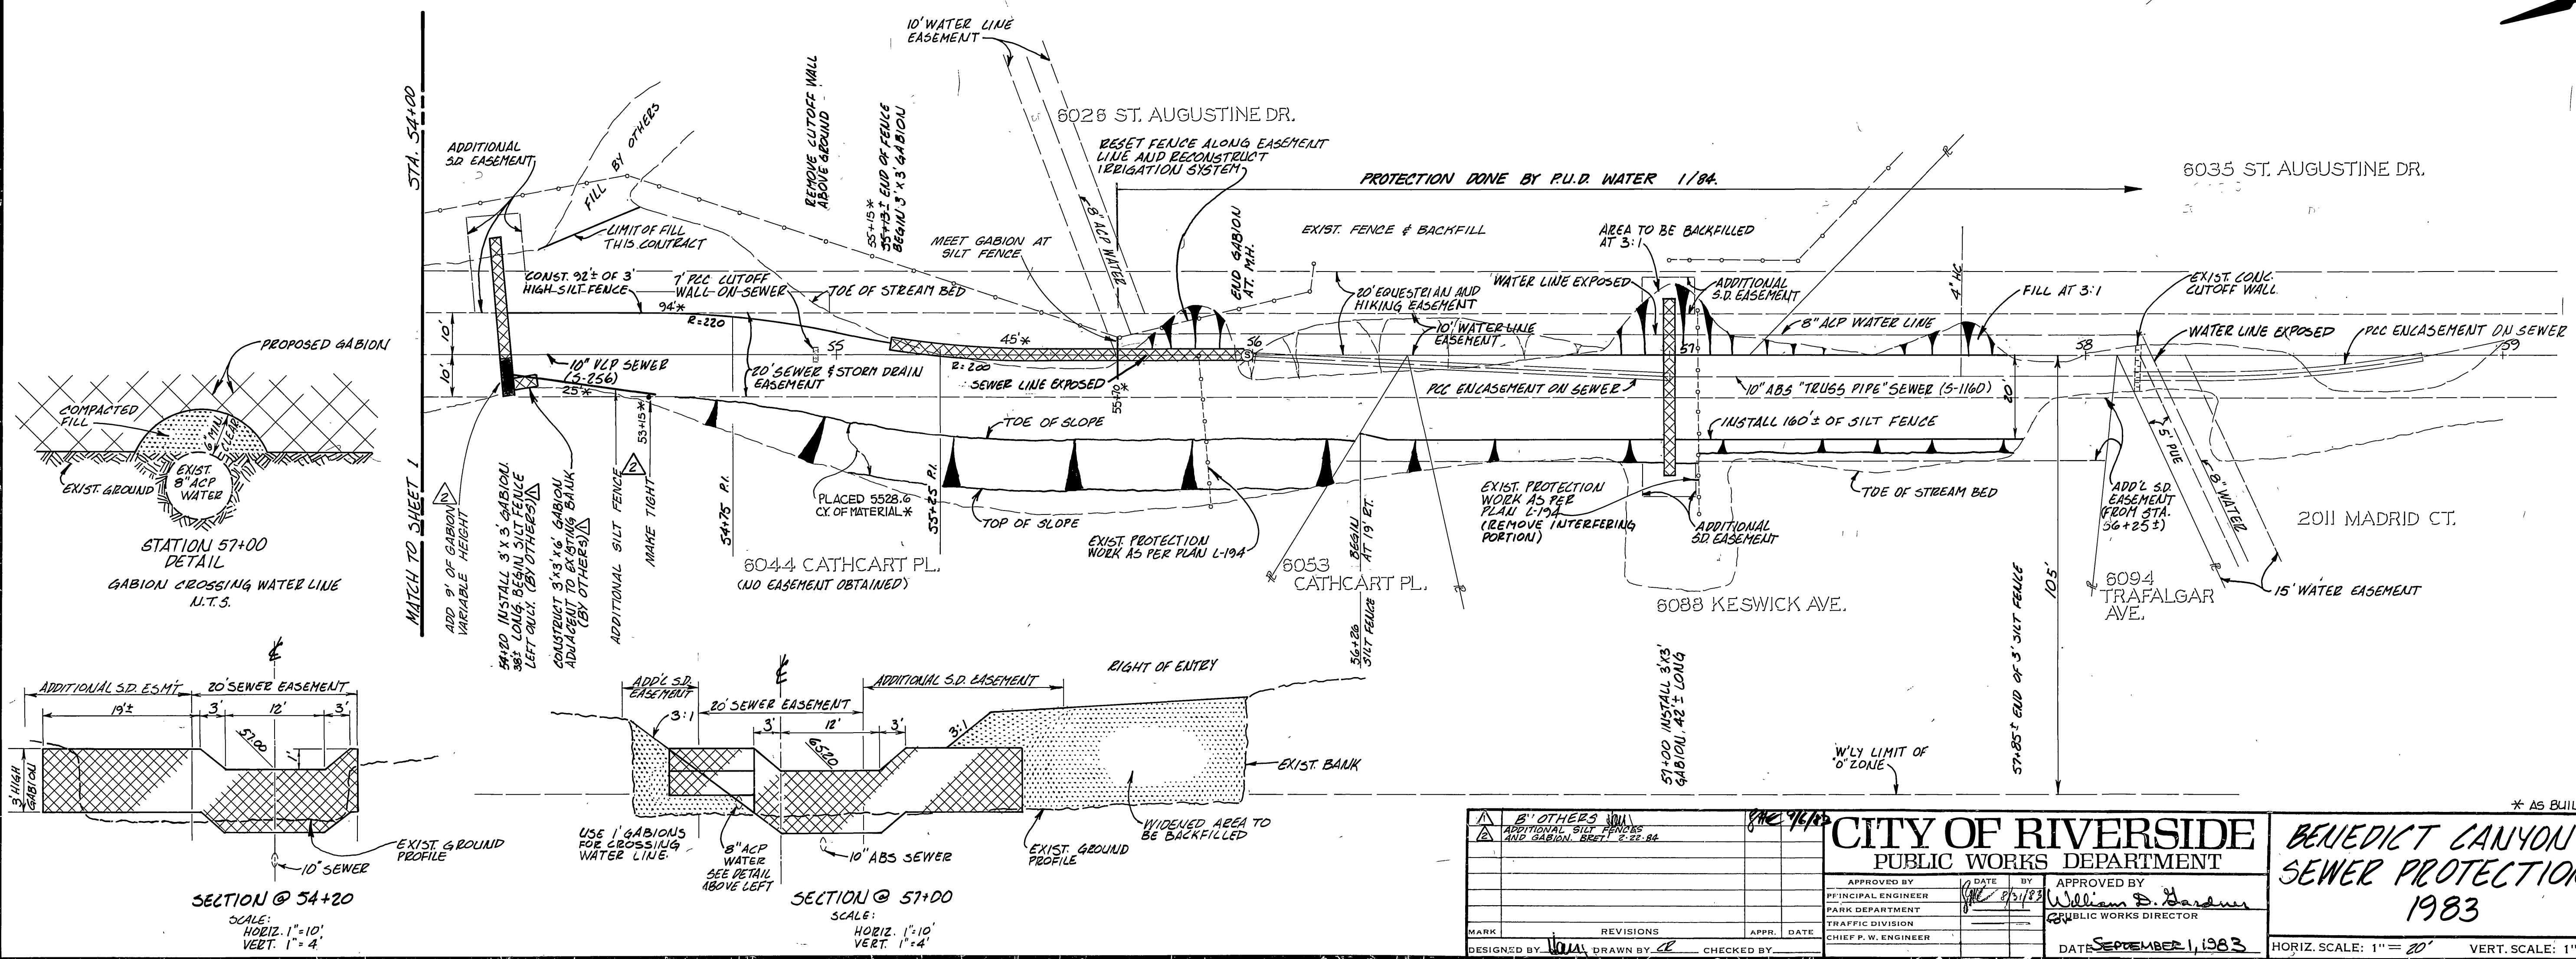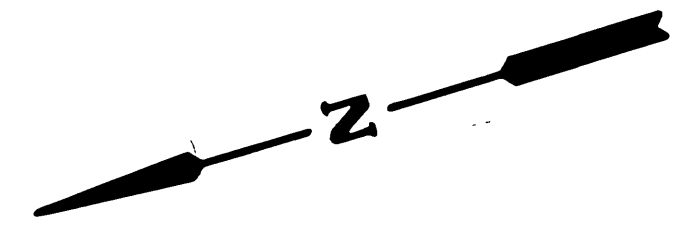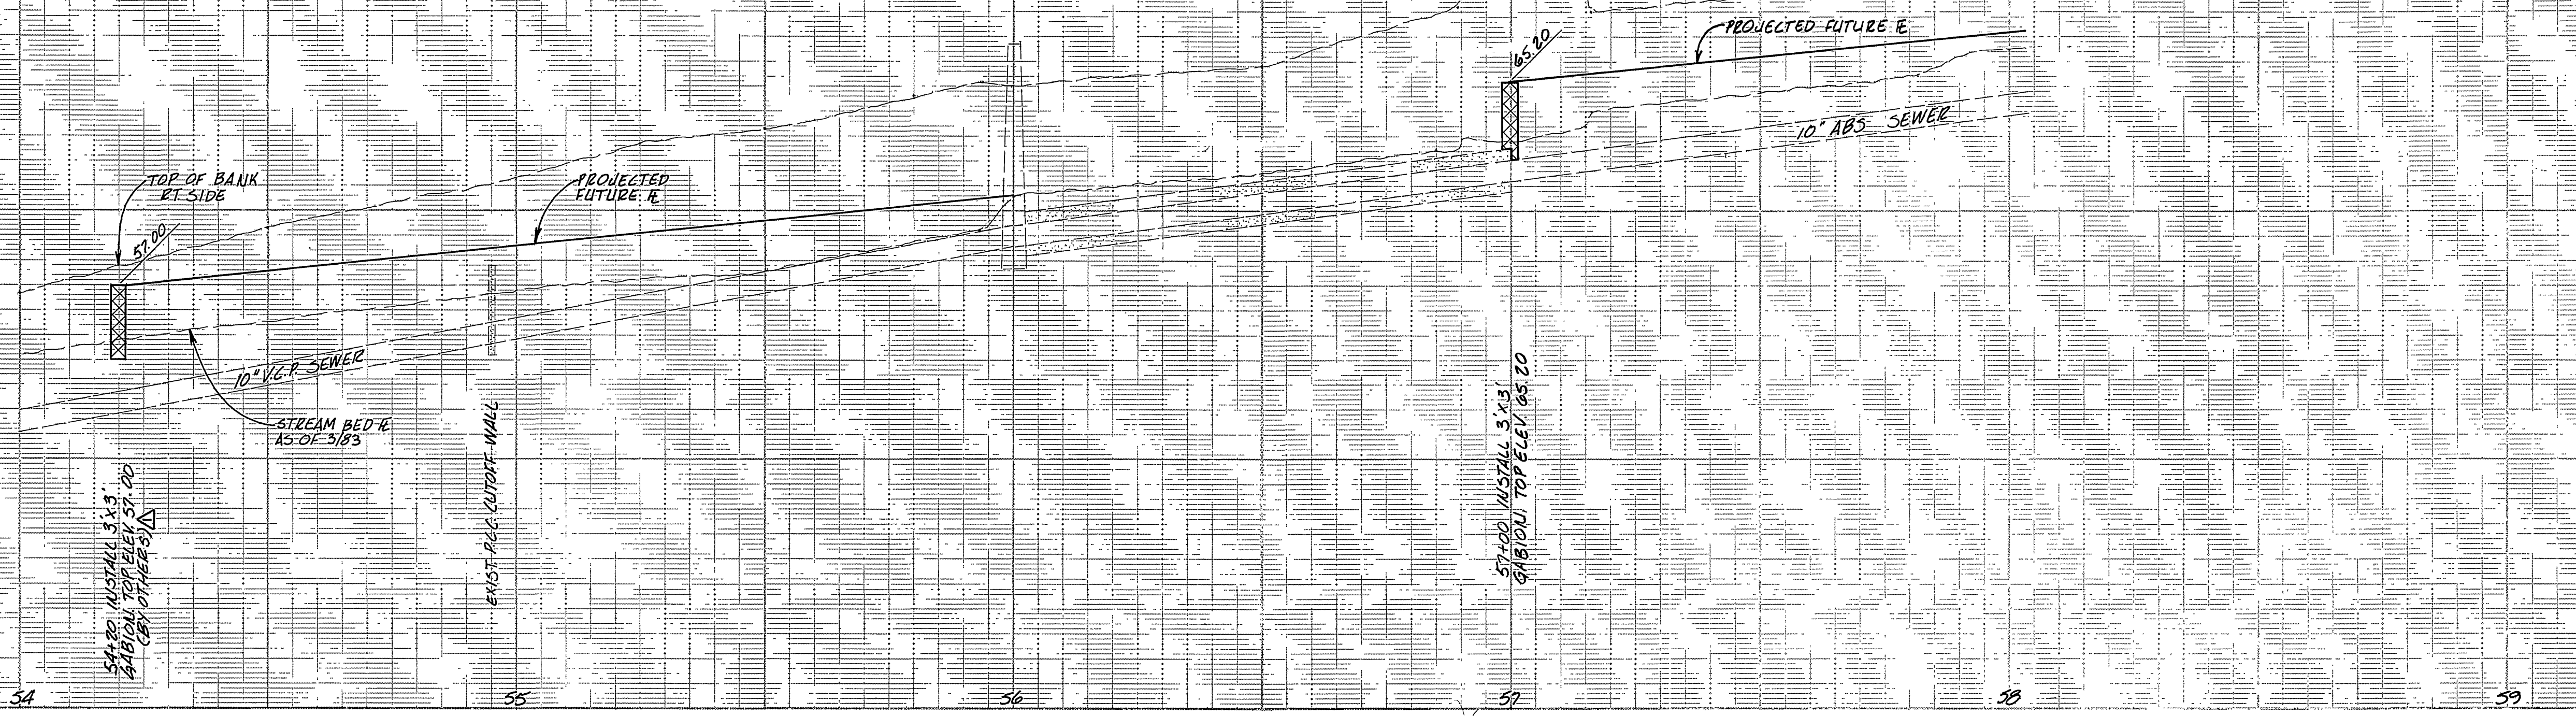

STATION 57+00
DETAIL
GABION CROSSING WATER LINE
U.T.S.

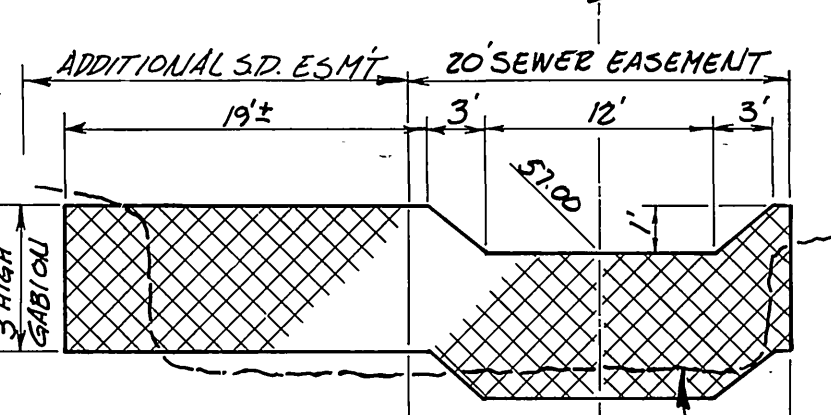

SECTION @ 54+20
SCALE:
HORIZ. 1"=10'
VERT. 1"=4'

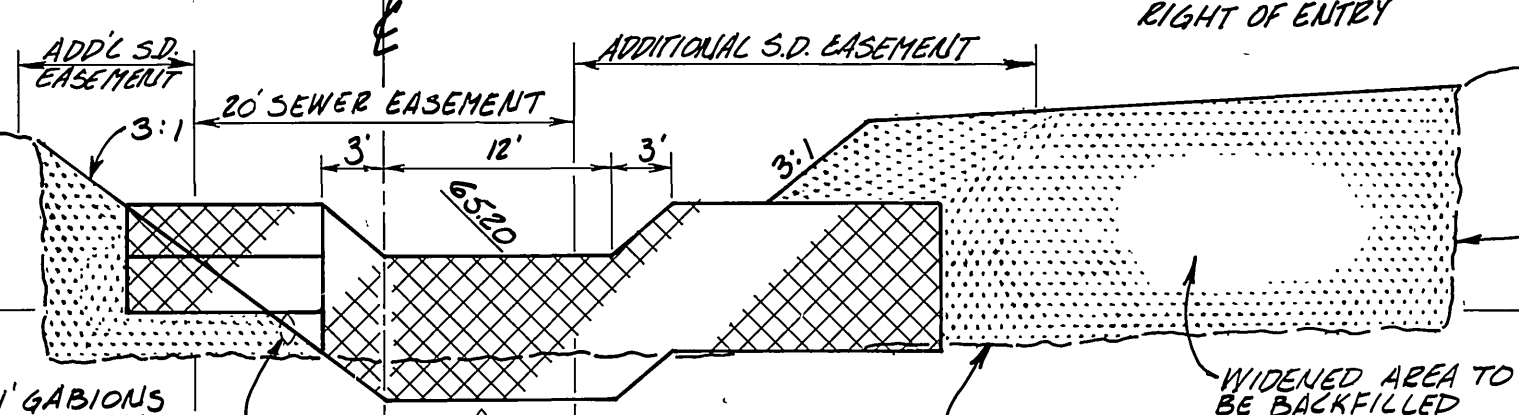

SECTION @ 57+00
SCALE:
HORIZ. 1"=10'
VERT. 1"=4'

8' OTHERS WALL ADDITIONAL SILT FENCES AND GABION BECT 2-27-84		CITY OF RIVERSIDE PUBLIC WORKS DEPARTMENT		BENEDICT CANYON SEWER PROTECTION 1983		ACCOUNT NO. 32-577-551 S-1317	
APPROVED BY PRINCIPAL ENGINEER PARK DEPARTMENT TRAFFIC DIVISION CHIEF P.W. ENGINEER		DATE 9/1/83		APPROVED BY William D. Gardner PUBLIC WORKS DIRECTOR		SHEET 2 OF 2	
DESIGNED BY: WAL		DRAWN BY: CE		CHECKED BY:		DATE: SEPTEMBER 1, 1983	
				HORIZ. SCALE: 1"=20'		VERT. SCALE: 1"=4'	