


<b>CITY OF RIVERSIDE</b> PUBLIC WORKS DEPARTMENT		<b>JONES AVENUE</b> <b>ASSESSMENT DISTRICT</b> (SEWER)		<b>S-1350</b>
APPROVED BY: [Signature] DATE: 11/4/85 PRINCIPAL ENGINEER		APPROVED BY: [Signature] DATE: 11/4/85 PUBLIC WORKS DIRECTOR		ACCOUNT NO. 85-451-001-00
DESIGNED BY: [Signature] DRAWN BY: [Signature] CHECKED BY: [Signature]		HORIZ. SCALE: 1" = 40' VERT. SCALE: 1" = 4'		SHEET 2 OF 2

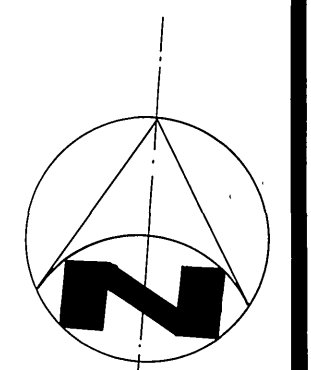

\*As built 6-12-87 7/2