

GENERAL NOTES:


- CONSTRUCTION SHALL BE IN ACCORDANCE WITH THE CITY OF RIVERSIDE, DEPT. OF PUBLIC WORKS, STANDARD DRAWINGS, AND THE STANDARD SPECIFICATIONS FOR PUBLIC WORKS CONSTRUCTION, 1982 EDITION.
- LOCATION OF LATERALS TO BE DETERMINED IN THE FIELD AT THE DIRECTION OF THE OWNER. AVOID CONFLICTS WITH PROPOSED AND/OR EXISTING FACILITIES.
- CONTRACTOR IS TO VERIFY EXISTING SEWER ELEVATION PRIOR TO CONSTRUCTION.
- FINISHED FLOOR ELEVATIONS SHALL NOT BE LESS THAN 4' ABOVE THE SEWER FLOW LINE AT POINT OF CONNECTION WITHOUT HAVING A PROPER BACKWATER VALVE INSTALLED IN THE LATERAL.
- THE SEWER CONTRACTOR SHALL ADJUST MANHOLES TO FINAL GRADE AFTER PAVING IS COMPLETED.
- A PLUG SHALL BE INSTALLED AND WILL REMAIN IN PLACE WHERE THE NEW SEWER CONNECTS WITH THE EXISTING SEWER UNTIL THE NEW SEWER IS ACCEPTED BY THE CITY.
- THE PRIVATE ENGINEER SIGNING THESE PLANS IS RESPONSIBLE FOR ASSURING THE ACCURACY AND ACCEPTABILITY OF THE WORK HEREON. IN THE EVENT OF DISCREPANCIES ARISING DURING CONSTRUCTION, THE PRIVATE ENGINEER SHALL BE RESPONSIBLE FOR DETERMINING AN ACCEPTABLE SOLUTION AND REVISING THE PLANS FOR THE APPROVAL BY THE CITY.
- THE CONTRACTOR SHALL CALL IN A LOCATION REQUEST TO "UNDERGROUND SERVICE ALERT" (USA), PHONE NO. 1-800-422-4133, TWO WORKING DAYS BEFORE DIGGING. CONSTRUCTION PERMITS WILL NOT BE ISSUED BY THE PUBLIC WORKS DEPARTMENT INVOLVING EXCAVATION FOR UNDERGROUND FACILITIES UNLESS THE APPLICANT HAS BEEN PROVIDED AN INQUIRY IDENTIFICATION NUMBER BY "USA".
- QUANTITIES SHOWN ARE FOR INFORMATION ONLY AND THE CITY OF RIVERSIDE IS NOT RESPONSIBLE FOR THEIR ACCURACY.

BENCH MARK

FD BRASS DISK STAMPED (F.T.A) CAPPED AT THE INTERSECTION OF 2ND THIRD STREET AND 2ND CHICAGO AVENUE (FB 711/68) ELEVATION: 241.005

QUANTITIES

8" VCP	507.99 LF
MANHOLE (BTD. 500)	3 EA
6" VCP	6 LF

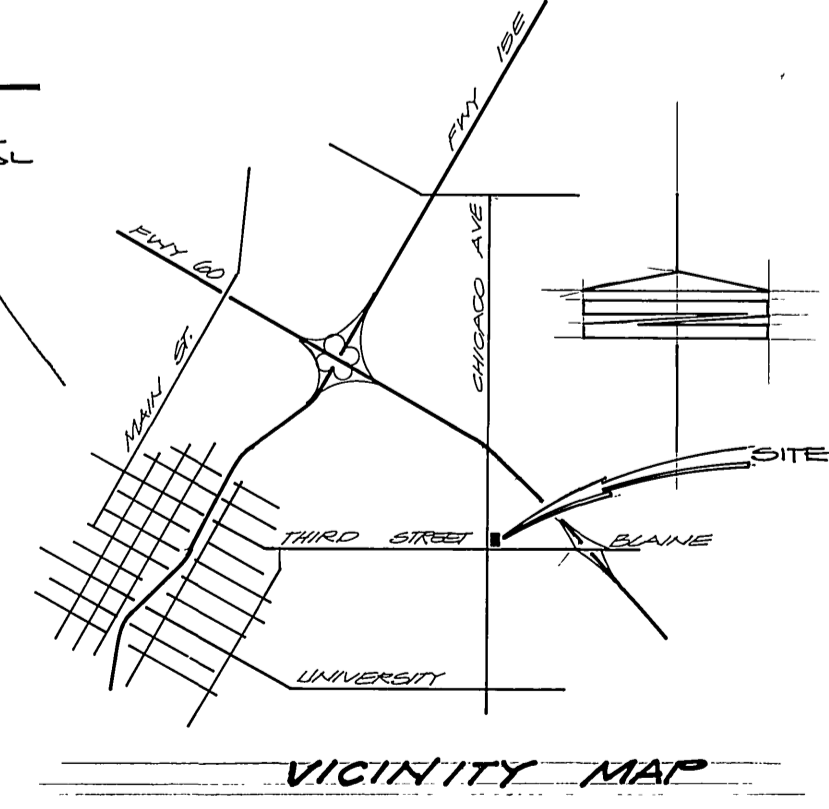

* As built 10-86 76

INDEX LF

PACIFIC BELL CO. <i>[Signature]</i> DATE 3-1-85	SOUTHERN CALIFORNIA GAS CO. <i>[Signature]</i> DATE 3/6/85	CITY OF RIVERSIDE DOMESTIC WATER SYSTEM <i>[Signature]</i> APPROVED DATE 3-11-85	CITY OF RIVERSIDE OVERHEAD & UNDERGROUND <i>[Signature]</i> CHIEF UTILITIES ENGINEER - ELEC. DATE 3/7/85	ALBERT A. WEBB ASSOCIATES CIVIL ENGINEERS RIVERSIDE, CALIFORNIA APPROVED BY <i>[Signature]</i> DATE 2-27-85 R.E. No. 21,982	CITY OF RIVERSIDE, CALIFORNIA PUBLIC WORKS DEPARTMENT APPROVED BY <i>[Signature]</i> DATE 3/1/85 CHIEF PUB. WKS. ENGR.	SEWER IMPROVEMENT PLAN ZONING CASE R-9-790 NE CORNER CHICAGO AVE THIRD STREET SCALE: 1"=40' HORIZ. 1"=4' VERT.	ACCOUNT No. 24-214 DRAWING NUMBER S-1384 SHEET 2 ND OF ONE 24-214
---	--	---	---	---	---	--	--