

QUANTITY ESTIMATE

STREET	8" V.C.P.	STD. M.H.	STD. C.O.	8"x4" WYES	4" HOUSE CONN.
WILLOW AVENUE	1349 lin. ft.	4	1	41	1338 lin. ft.
MELROSE STREET	330 lin. ft.			6	210 "
SYCAMORE AVENUE	1214 lin. ft.	4		40	1360 "
TOTALS	2893 lin. ft.	8	1	87	2908 "

GENERAL NOTES:

House Connection Wyes shall be field located. Construction to be in accordance with Specifications of the City of Riverside, Department of Public Works, 1985 Edition. Δ Lots 49 & 50 Willow Ave. & Lots 1 & 2 Sycamore Ave. have option to connect to exist. wyes in Jefferson St. Δ The contractor shall call in a location request to Underground Service Alert (USA), phone no. 1-800-482-4133, two working days before digging. No construction permit will be issued by the Public Works Department involving excavation for underground facilities unless the contractor has been provided an inquiry identification number by USA.

BENCH MARKS
 Spike in Lead in NW curb return at California & Jefferson. Elev. 771.47. F.B. 1911A*1/9
 P.K. nail in NE curb return at Jefferson & Sycamore. Elev. 778.70. F.B. 1911A*1/9.

REVISIONS		CITY OF RIVERSIDE CALIFORNIA DEPARTMENT OF PUBLIC WORKS
MARK	DATE	

DESIGNED BY REC
 DRAWN BY REC
 CHECKED BY [Signature]
 RECOMMENDED BY [Signature]

APPROVED BY [Signature]
 DIRECTOR OF PUBLIC WORKS

DATE 10/27/58

SHEET 1 OF 3

PROFILE


NOTED: GRADES CHECKED
 NO. 10001-1



DATE 10/27/58

PLAN

NOTED: ALIGNMENT CHECKED
 RT OF WAY CHECKED

DATE 10/27/58

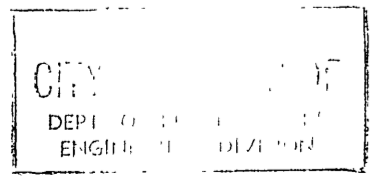

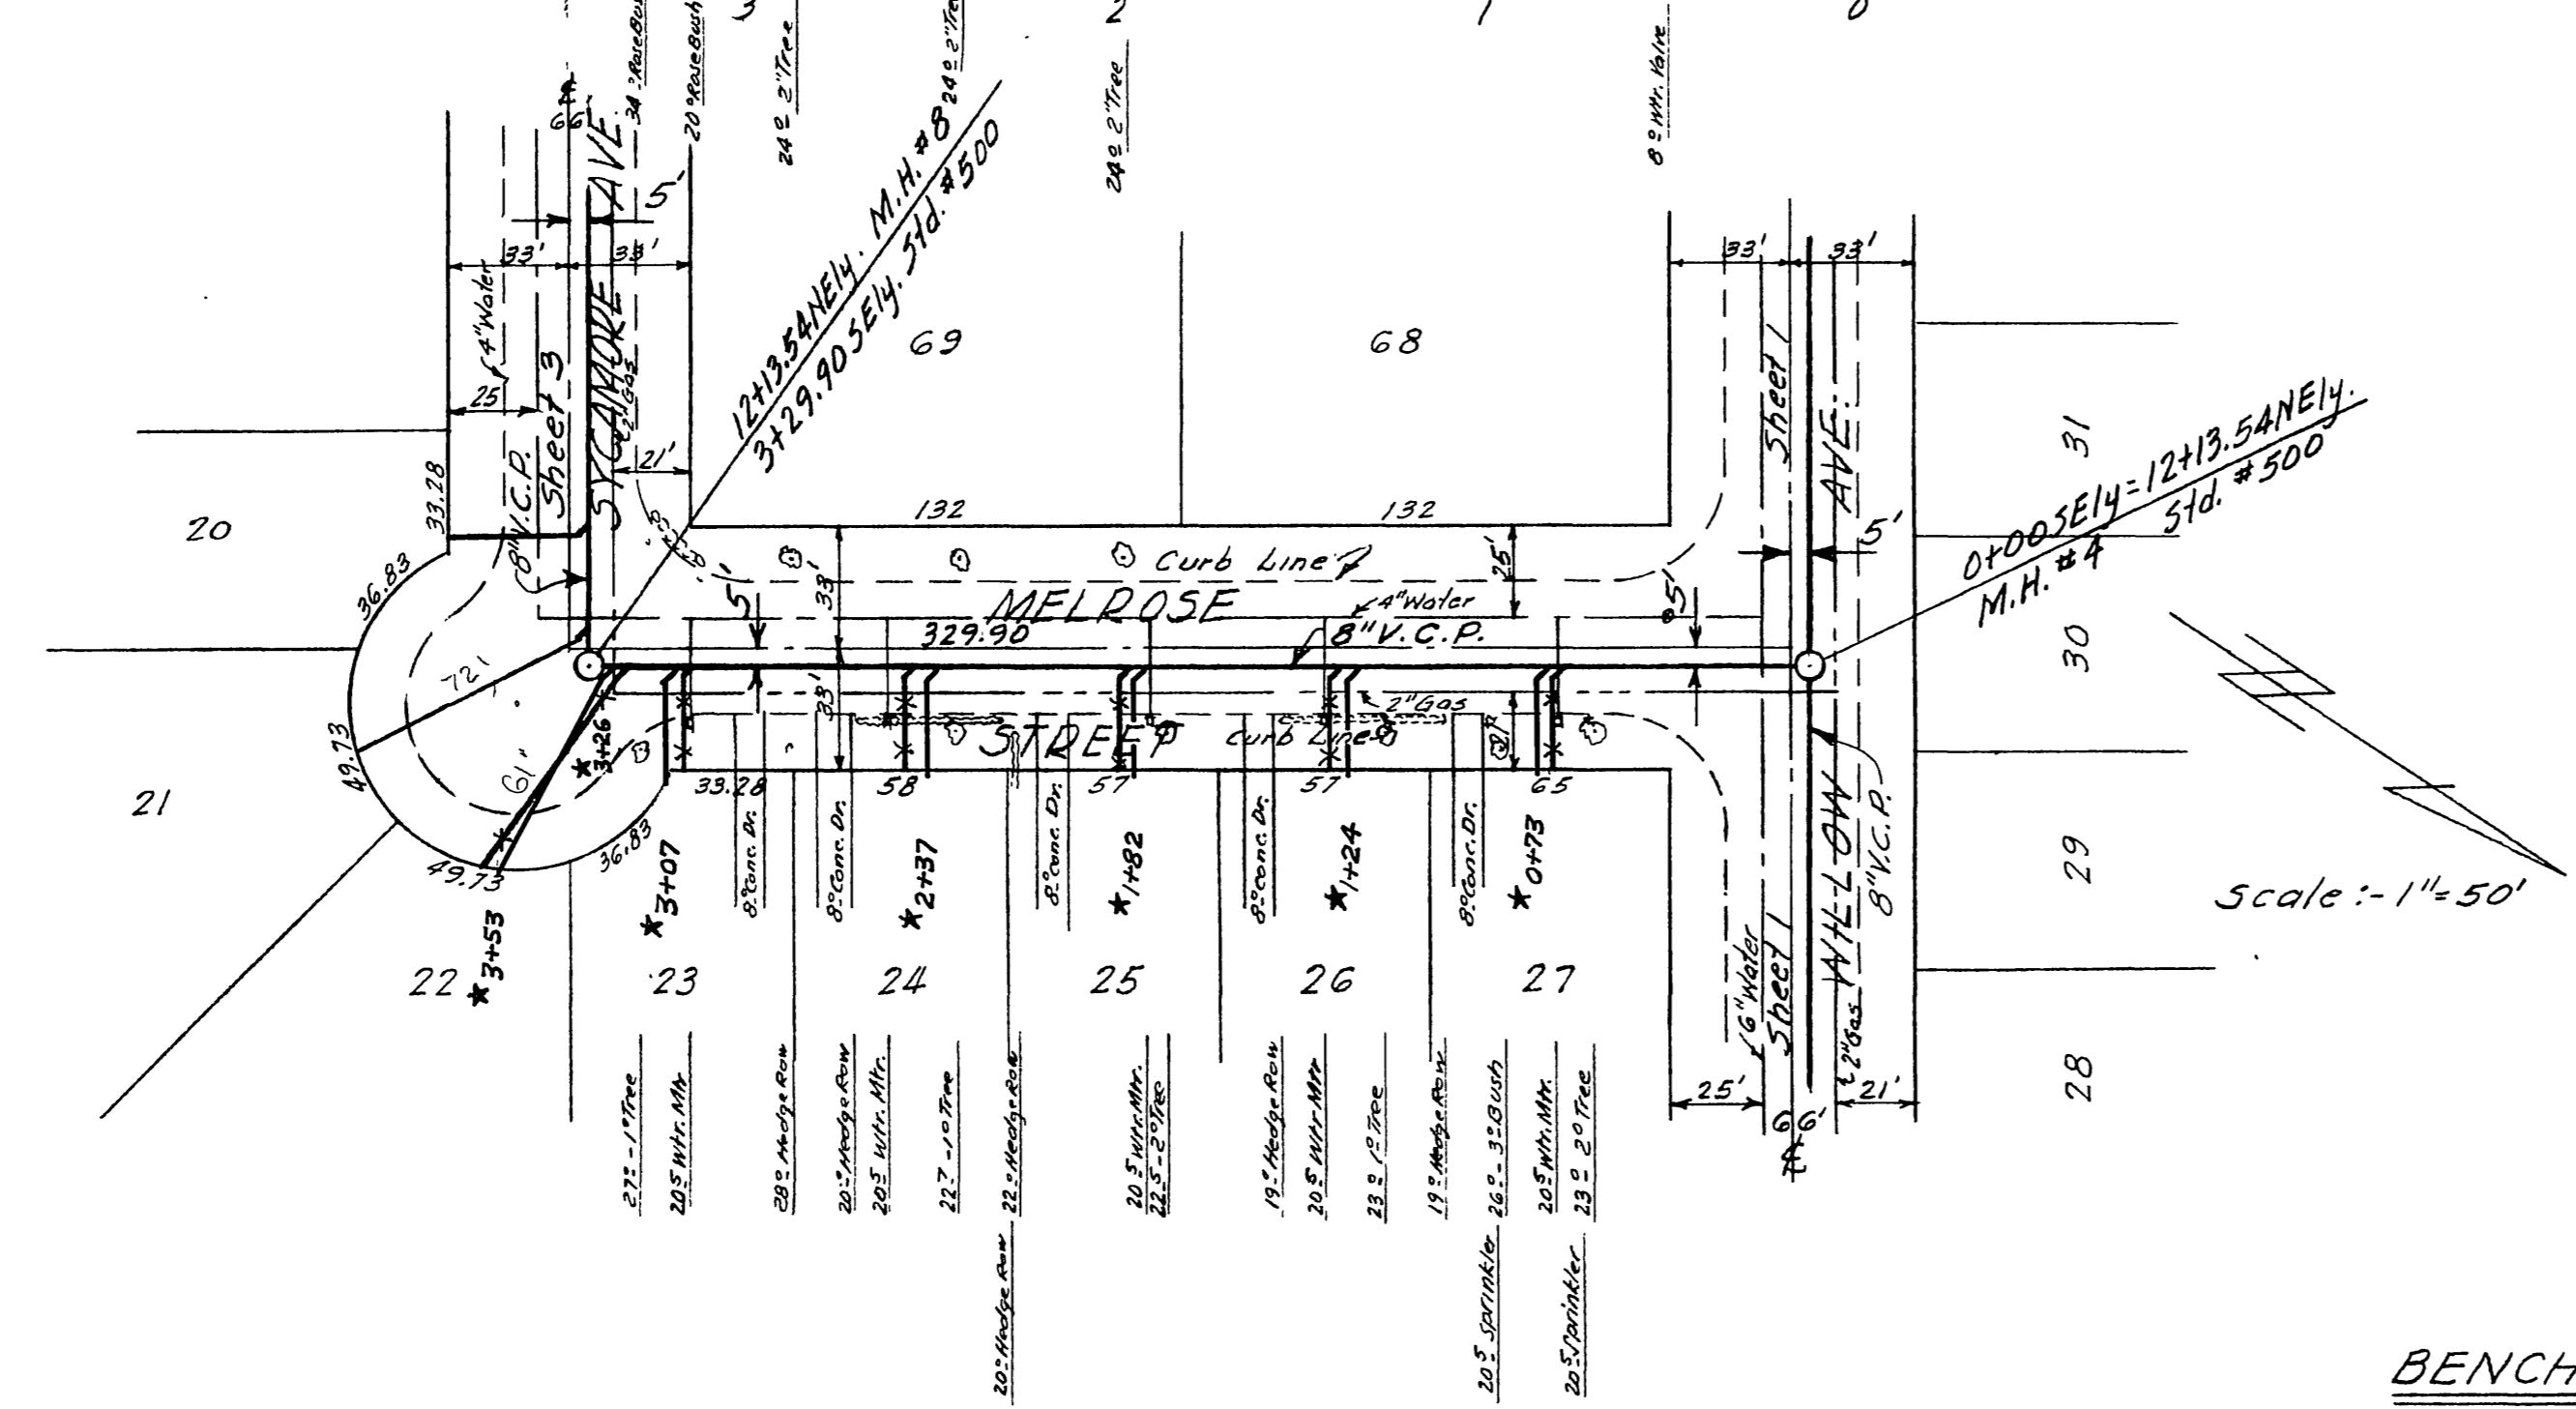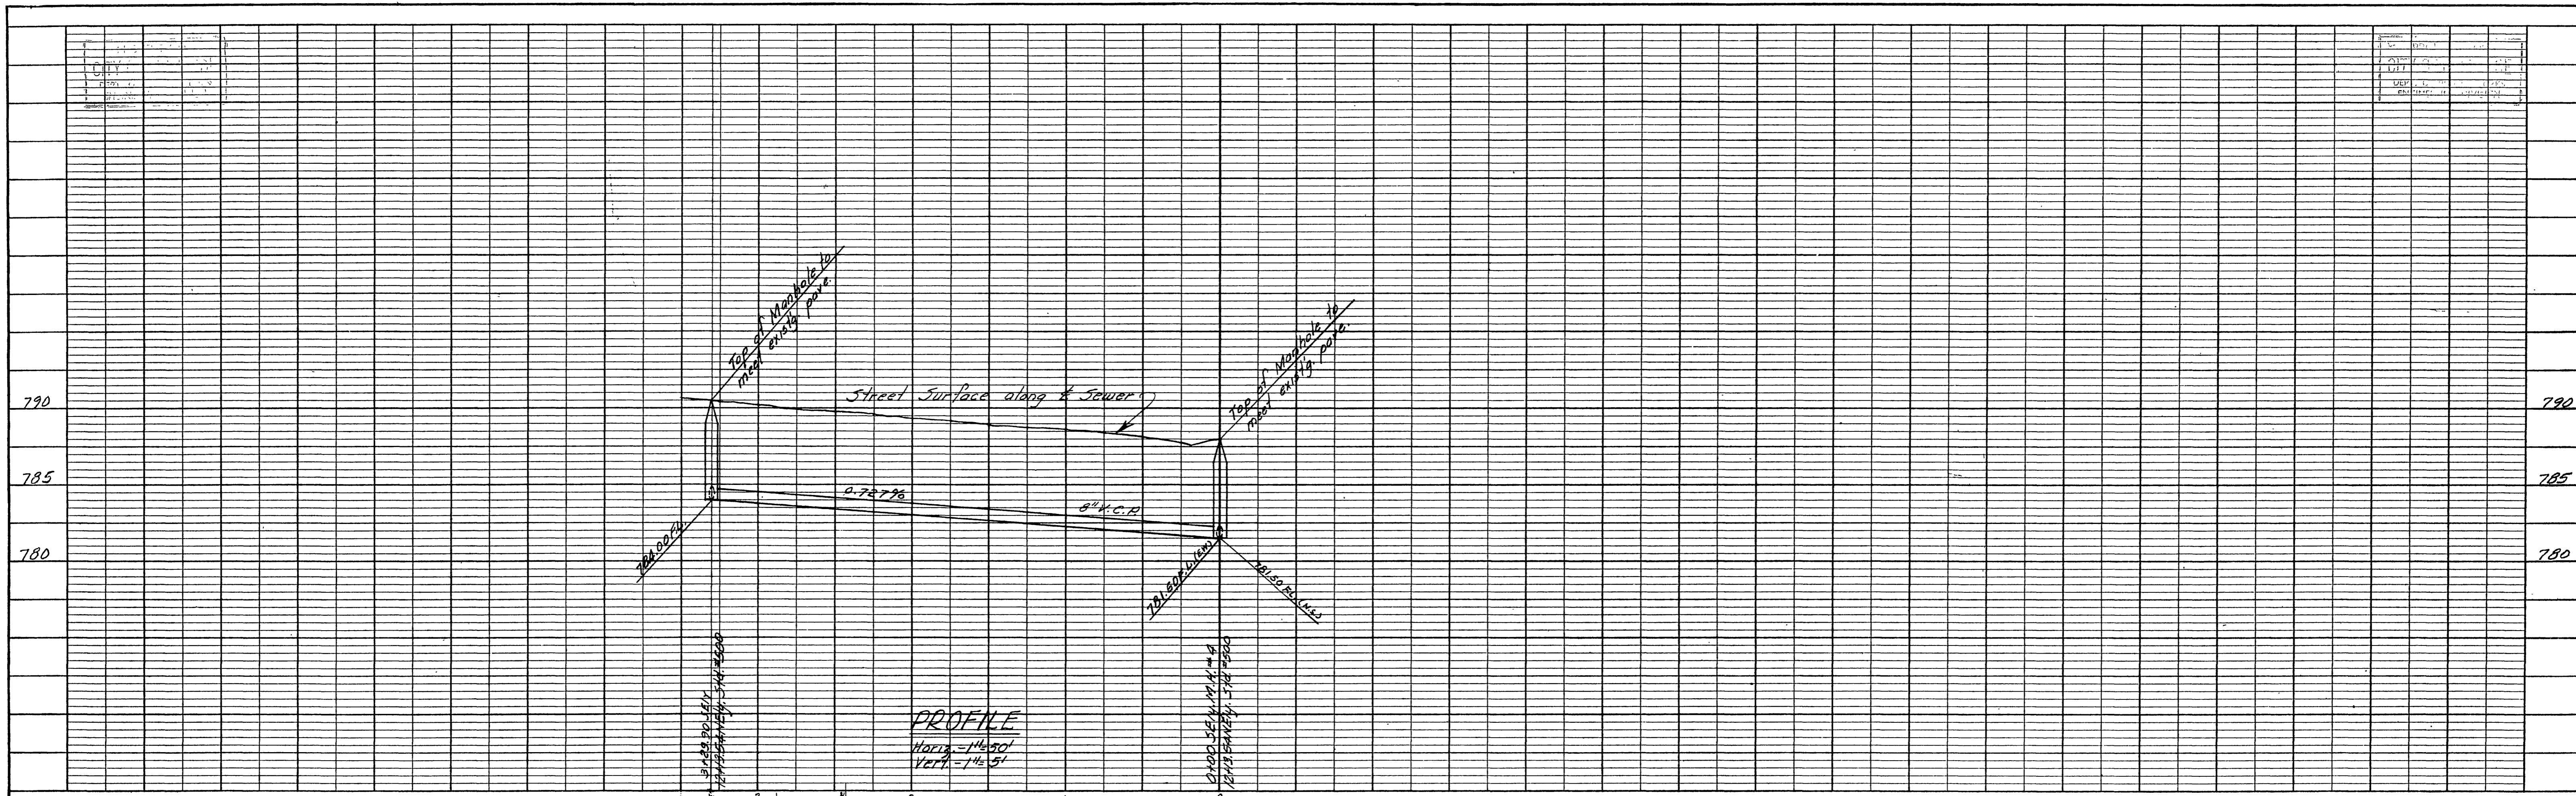

BENCH MARKS
 Spike in Lead in NW curb return at California & Jefferson. Elev. 771.47. F.B. 1911A#1/B
 P.K. nail in NE curb return at Jefferson & Sycamore. Elev. 778.70. F.B. 1911A#1/B.


* = As Built 3-18-53 H.Ball

PROFILE


SURVEYED	8/22/52	BY	
NOTE BOOK	8 M. 1307D	DATE	10/27/58
NO. 2114			
STRUCTURE NO. IN CURB			

PLAN


SURVEYED	8/22/52	BY	
NOTE BOOK	8 M. 1307D	DATE	10/27/58
NO. 2114			
STRUCTURE NO. IN CURB			

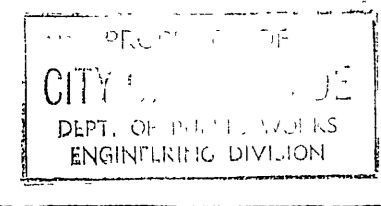

REVISIONS		CITY OF RIVERSIDE CALIFORNIA DEPARTMENT OF PUBLIC WORKS	
MARK	DATE	DESCRIPTION	
		JEFFERSON SQUARE SANITARY SEWER DISTRICT MELROSE ST.	
DESIGNED BY REC	CHECKED BY	APPROVED BY	S 142
DRAWN BY REC	R.E. 9876	Francis J. Tolson DIRECTOR OF PUBLIC WORKS	
RECOMMENDED BY	ASSISTANT CITY ENGINEER	DATE 10/27/58	
			SHEET 2 OF 3

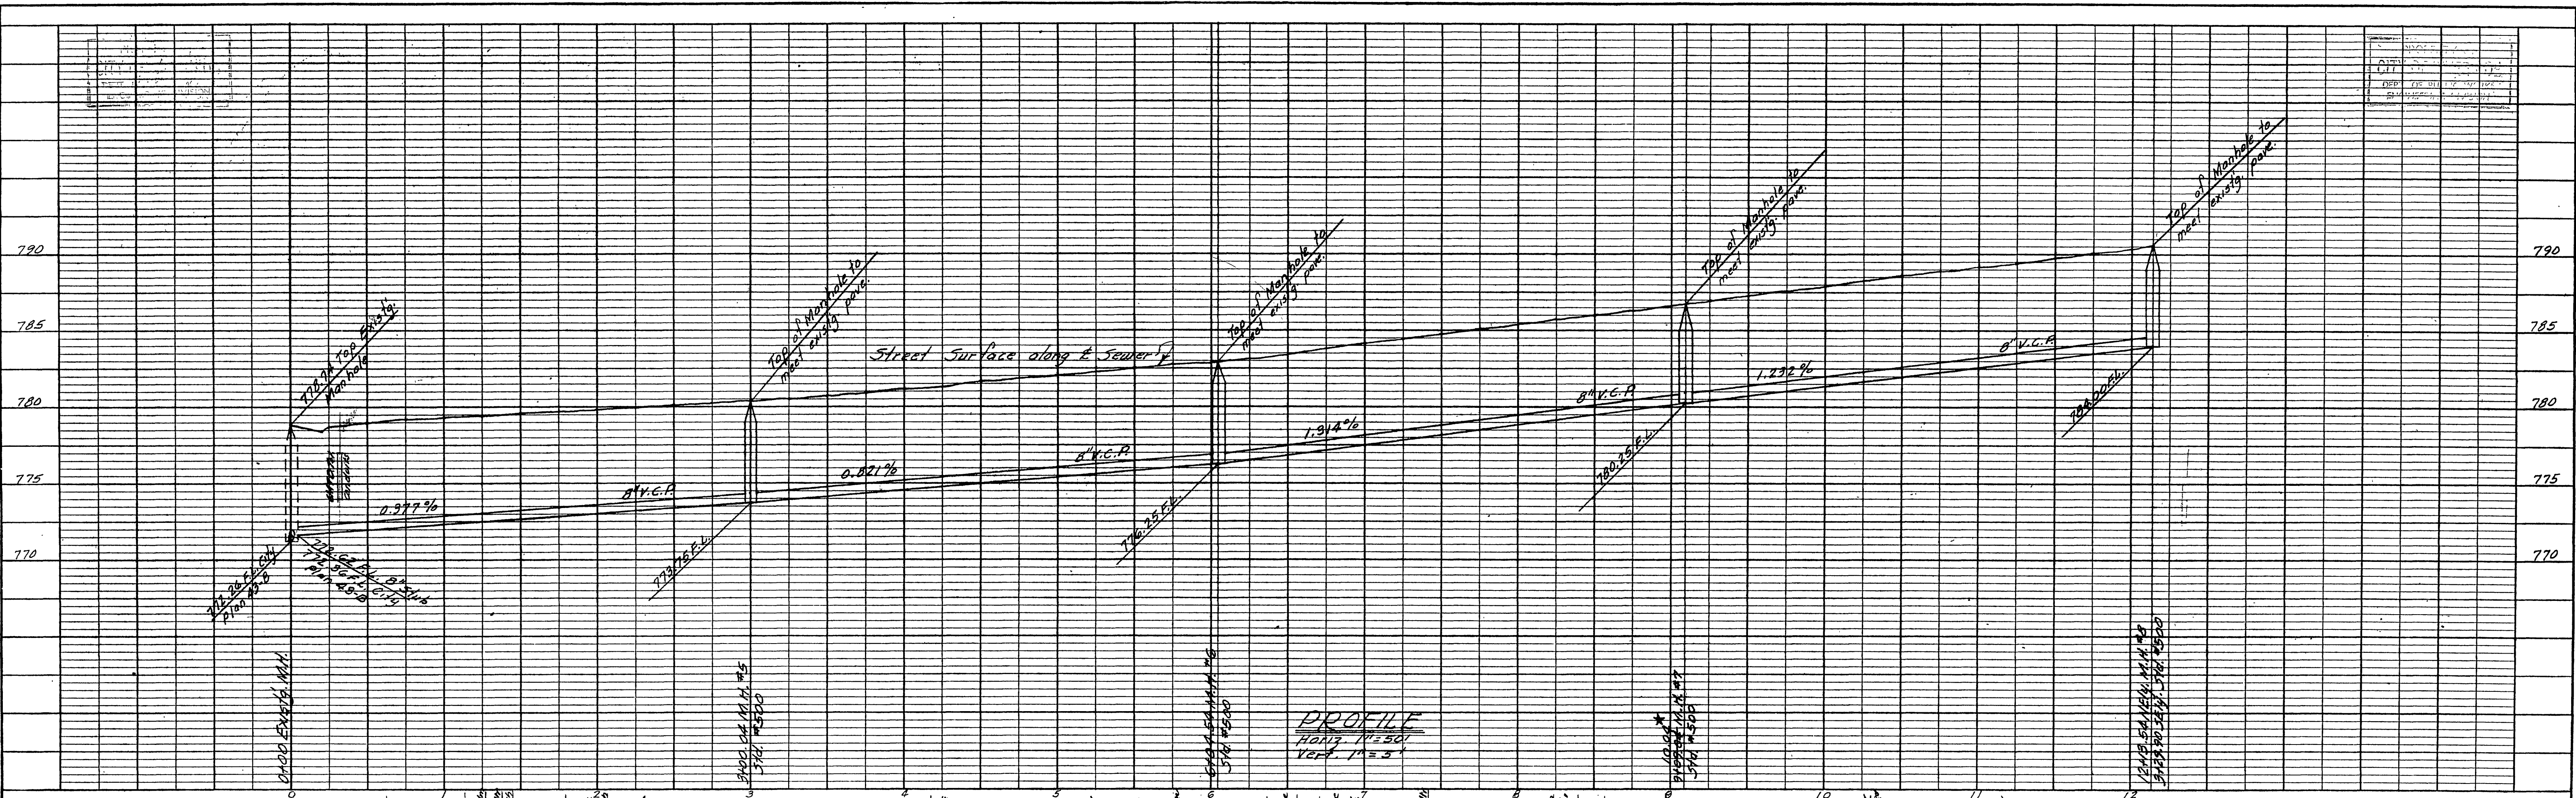

PROFILE	PROJECTED	DATE
NOTE BOOK	PROFILES CHECKED	
NO. 21147	SMITH, J. W.	10/21/58

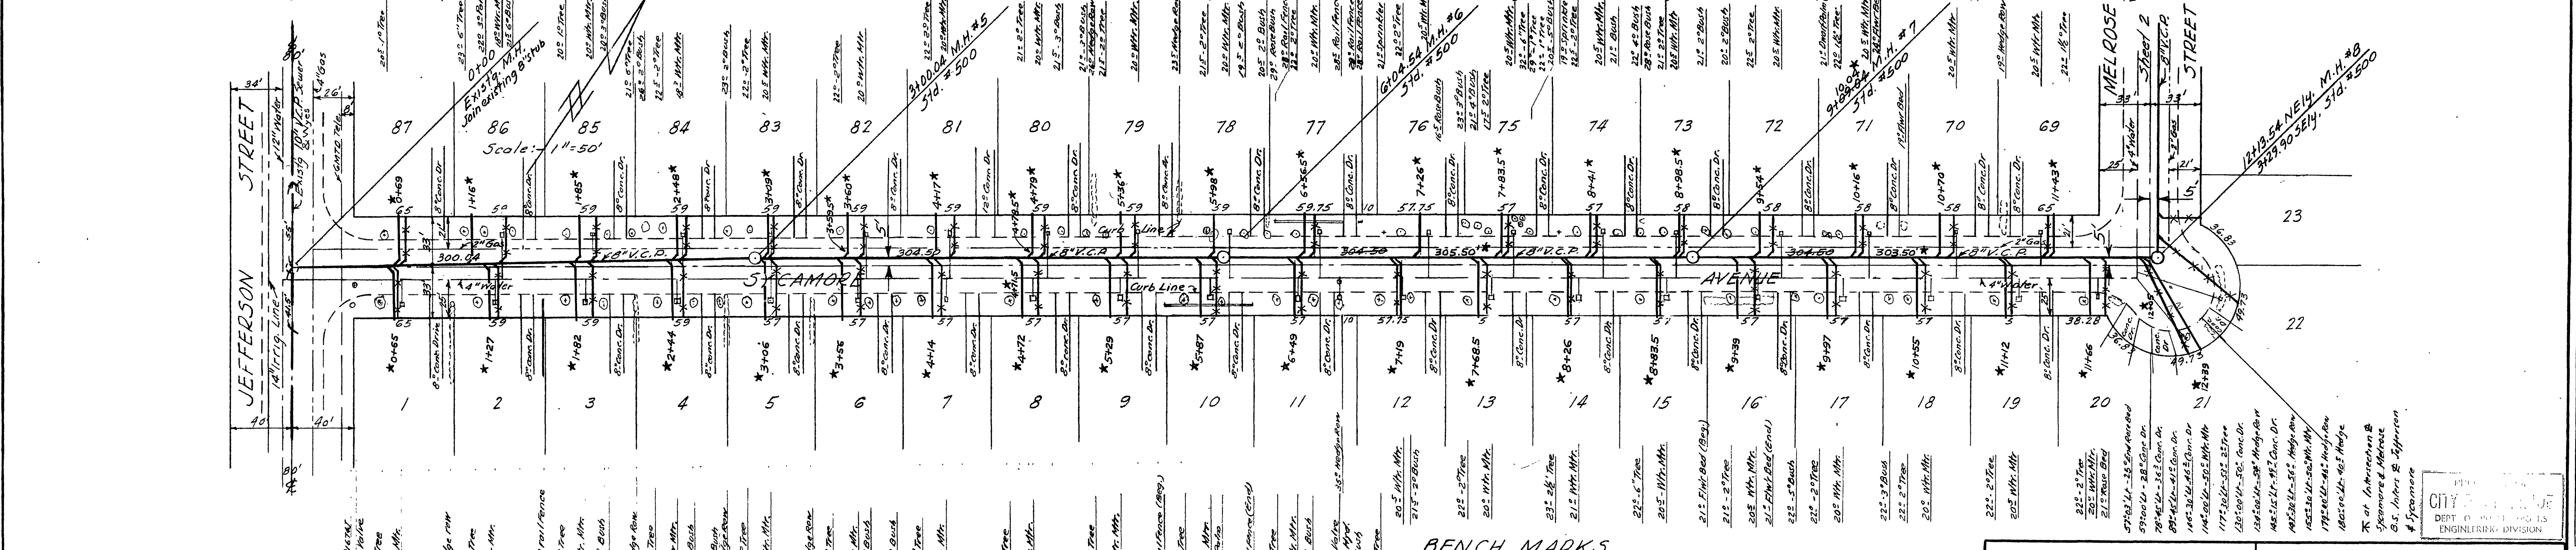

PLAN	PROJECTED	DATE
NOTE BOOK	ALIGNMENT CHECKED	
NO. 21147	SMITH, J. W.	10/21/58

BENCH MARKS
 Spike in Lead in NW curb return at California & Jefferson. Elev. 771.47. F.B. 1911A*110
 P.K. nail in NE curb return at Jefferson & Sycamore. Elev. 778.70. F.B. 1911A*119

REVISIONS MARK DATE DESCRIPTION		CITY OF RIVERSIDE CALIFORNIA DEPARTMENT OF PUBLIC WORKS	
DESIGNED BY REC DRAWN BY REC RECOMMENDED BY		CHECKED BY [Signature] APPROVED BY [Signature] ASSISTANT CITY ENGINEER	
DATE 10/27/58		DATE 10/27/58	
SHEET 3 OF 3		S 142	

