


Contractor to uncover invert of 36" stub before stakes are set between Sta 53+64 and Sta 57+52.

FB. 727 Pg. 1-35  
 BM. 803.687  
 TYP. NAIL IN CENTER OF SW. CB.  
 RETURN MISSION & BUENA VISTA

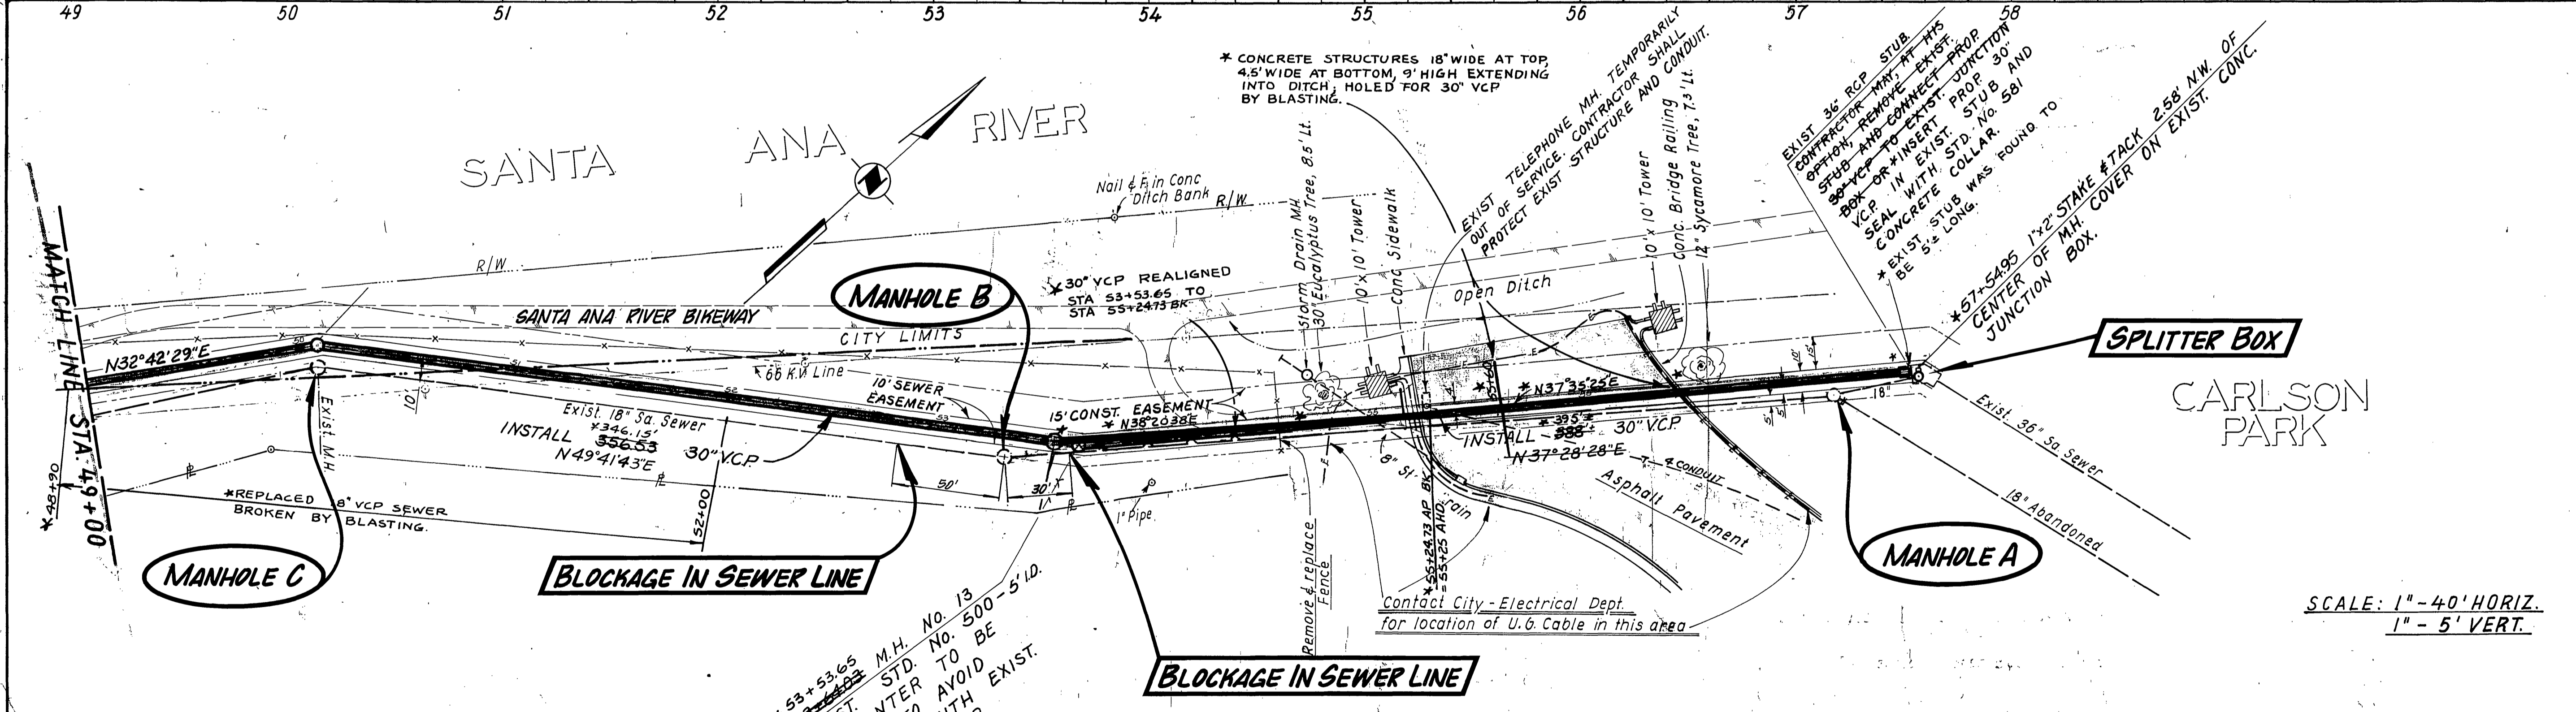

**-CAUTION-**  
**PACIFIC TELEPHONE**  
**CABLES UNDERGROUND**  
 BEFORE EXCAVATING

CALL COLLECT:

7:30 A.M. to 5 P.M.	After Hours & Holidays
Orange County 714-633-0811	714-547-6606
Riverside County 714-684-0071	714-547-6606
Inyo County 714-684-0071	714-547-6606
San Bernardino County 714-684-0071	714-547-6606
Los Angeles County 213-621-3111	24 HOUR SERVICE
Ventura County 213-621-3111	
San Diego County 714-298-0595	714-232-0027

FOR FREE CABLE LOCATING SERVICE

SCALE: 1" = 40' HORIZ.  
 1" = 5' VERT.

NOTES  
 1. SEE SHEET 2 OF 12 FOR GENERAL NOTES.

<b>CITY OF RIVERSIDE</b> PUBLIC WORKS DEPARTMENT		<b>NORTHSIDE OUTFALL REPAIR</b> NEAR CARLSON PARK	ACCOUNT NO. 32-571-989
			<b>S-1438</b> SHEET 1 OF 1
APPROVED BY: [Signature] PRINCIPAL ENGINEER	DATE: 11-21-86 TRAFFIC DIVISION	APPROVED BY: [Signature] PUBLIC WORKS DIRECTOR	HORIZ. SCALE: 1" = 40' VERT. SCALE: 1" = 5'

ADAPTED FROM PLAN: S-257, SHEET 6 OF 12