


- GENERAL NOTES**
- CONSTRUCTION SHALL BE IN ACCORDANCE WITH THE CITY OF RIVERSIDE DEPARTMENT OF PUBLIC WORKS, STANDARD DRAWINGS, STANDARD DRAWING NO. 10 AND THE STANDARD SPECIFICATIONS FOR PUBLIC WORKS CONSTRUCTION, CURRENT EDITION.
 - CONTRACTOR IS TO VERIFY EXISTING SEWER ELEVATIONS PRIOR TO CONSTRUCTION.
 - QUANTITIES SHOWN ARE FOR INFORMATION ONLY AND THE CITY OF RIVERSIDE IS NOT RESPONSIBLE FOR THEIR ACCURACY.
 - A TEMPORARY BRICK AND MORTAR PLUG SHALL BE INSTALLED AND WILL REMAIN IN PLACE WHERE THE NEW SEWER CONNECTS WITH THE EXISTING SEWER UNTIL THE NEW SEWER IS ACCEPTED BY THE CITY. ONCE THE SEWER IS ACCEPTED BY THE CITY, THE CONTRACTOR SHALL REMOVE THE PLUG.
 - THE PRIVATE ENGINEER SIGNING THESE PLANS IS RESPONSIBLE FOR ASSURING THE ACCURACY AND ACCEPTABILITY OF THE WORK HEREON. IN THE EVENT OF DISCREPANCIES ARISING DURING CONSTRUCTION, THE PRIVATE ENGINEER SHALL BE RESPONSIBLE FOR DETERMINING AN ACCEPTABLE SOLUTION AND REVISING THE PLANS FOR APPROVAL BY THE CITY.
 - THE CONTRACTOR SHALL CALL IN A LOCATION REQUEST TO UNDERGROUND SERVICE ALERT (USA), PHONE NO. 1-800-482-4195, TWO WORKING DAYS BEFORE DIGGING. NO CONSTRUCTION PERMIT WILL BE ISSUED BY THE PUBLIC WORKS DEPARTMENT INVOLVING EXCAVATION FOR UNDERGROUND FACILITIES UNLESS THE APPLICANT HAS BEEN PROVIDED AN INQUIRY IDENTIFICATION NUMBER BY USA.
 - THE DEVELOPER SHALL BE RESPONSIBLE FOR PRESERVING OR RE-ESTABLISHING AND REFERENCING SURVEY MONUMENTS DESTROYED, DISTURBED OR BURIED AS A RESULT OF CONSTRUCTION SHOWN HEREON.
 - ALL FLAGGED ELEVATIONS SHALL BE STAKED IN THE FIELD BY THE PRIVATE ENGINEER.
 - DEVELOPER AND/OR CONTRACTOR TO GIVE RCFC 5 DAYS WRITTEN NOTICE PRIOR TO DOING ANY WORK WITHIN RCFC EASEMENTS, RCFC ENCROACHMENT PERMIT NO. 1-2-170-1540.
- CONSTRUCTION NOTES**
- CONSTRUCT MANHOLES PER CITY OF RIVERSIDE STD. DWG. NO. 500 WITH 5' BOTTOM DIAMETER AND 3' TOP DIAMETER.
 - INSTALL 2 LF SECTION OF 8" V.C.P. INSIDE OF MANHOLE FOR FUTURE LATERAL. FORM CONCRETE CHANNEL IN MANHOLE BOTTOM PER STD. DWG. NO. 500. AFTER CONSTRUCTING 2 LF SECTION OF PIPE, PLUG BOTH THE LATERAL PIPE OPENING AND THE LATERAL CHANNEL WITHIN THE MANHOLE WITH BRICK AND MORTAR AND SANDBAG THE LATERAL PIPE OPENING ON THE OUTSIDE OF THE MANHOLE.

ALBERT A. WEBB ASSOCIATES
 CIVIL ENGINEERS
 3788 McCRA Y ST. RIVERSIDE, CA 92506
 (909)686-1070

APPROVED BY: *Mohammad Faghhi*
 DATE: 2-17-97
 R.C.E. NO. C39530

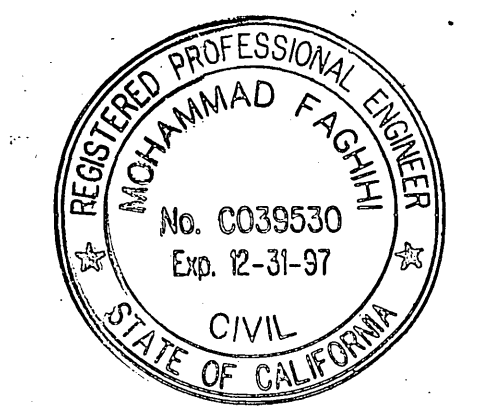

BENCH MARK:
 CITY OF RIVERSIDE BENCHMARK
 E2-D FOUND P.K. NAIL MARKED
 "B.M." IN CENTER OF SOUTHEAST
 CURB RETURN AT INDIANA AVENUE
 AND FILLMORE STREET
 ELEVATION=738.988'

PLANS PREPARED BY: DON GREEK & ASSOCIATES
 2425 N. GRAND AVE. SUITE L
 SANTA ANA, CA, 92701
 TEL. (714) 543-0190

PREPARED UNDER THE SUPERVISION OF:
Don Greek 4.12.88
 SURENDER DEWAN R.C.E. 34559

REVISIONS	DATE	BY	CHECKED BY
Rev. Abandoned M.H. & sewer line, notes added	11/13/97		
Relocate 10" SWR / Remove M.H. 14 1/2' SWR	12/15/97		
Revised Elevations & Grades	1/18/98		

DESIGNED BY: S.D.H. DRAWN BY: J.K.V./S.E.M. CHECKED BY: S.D.H.



QUANTITY ESTIMATE

INSTALL 8" V.C.P. SEWER MAIN	90 LF
INSTALL 10" V.C.P. SEWER MAIN	464 LF
INSTALL 12" V.C.P. SEWER MAIN	33 LF
INSTALL M.H. PER CITY OF RIVERSIDE STD. DWG. 500	3 EA

INDEXED 9-19-88

SEWER PLAN & PROFILE
PRICE COURT TO
LA SIERRA AVENUE
 PM 23068; R-17-834
 SCALE: HORIZ. 1" = 40' VERT. 1" = 4'

S-1459
 SHEET 1 OF 2

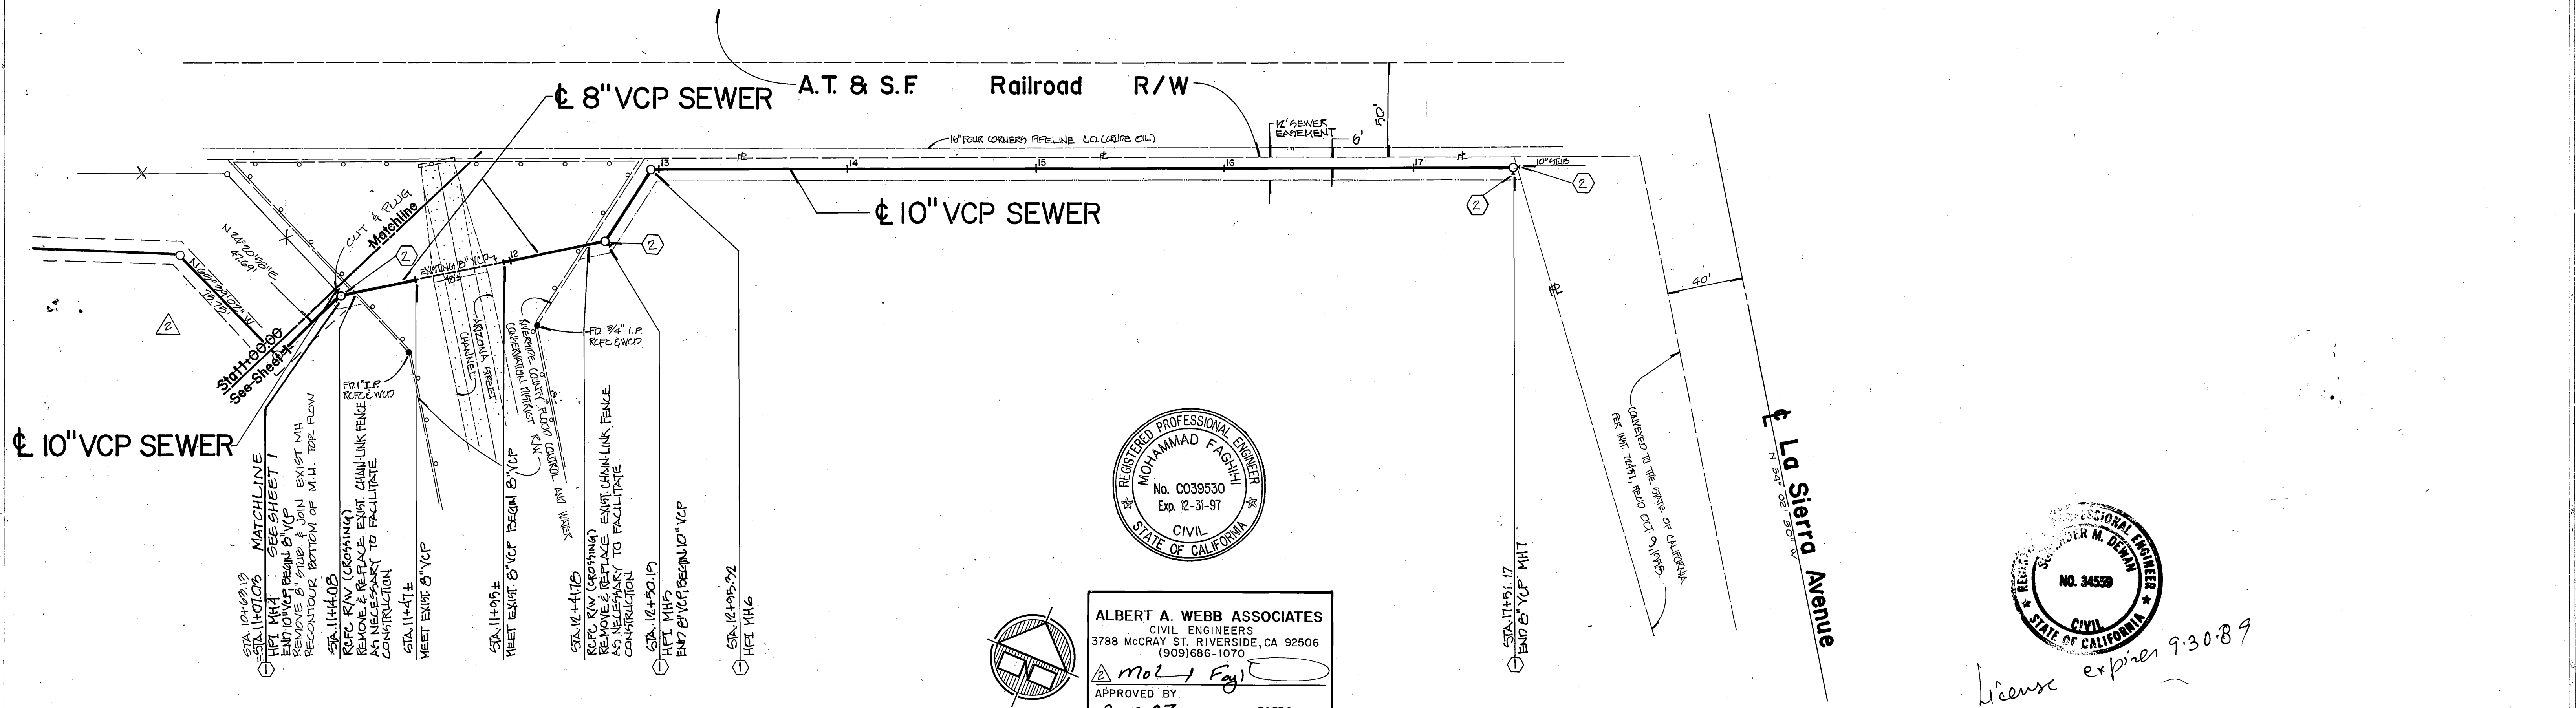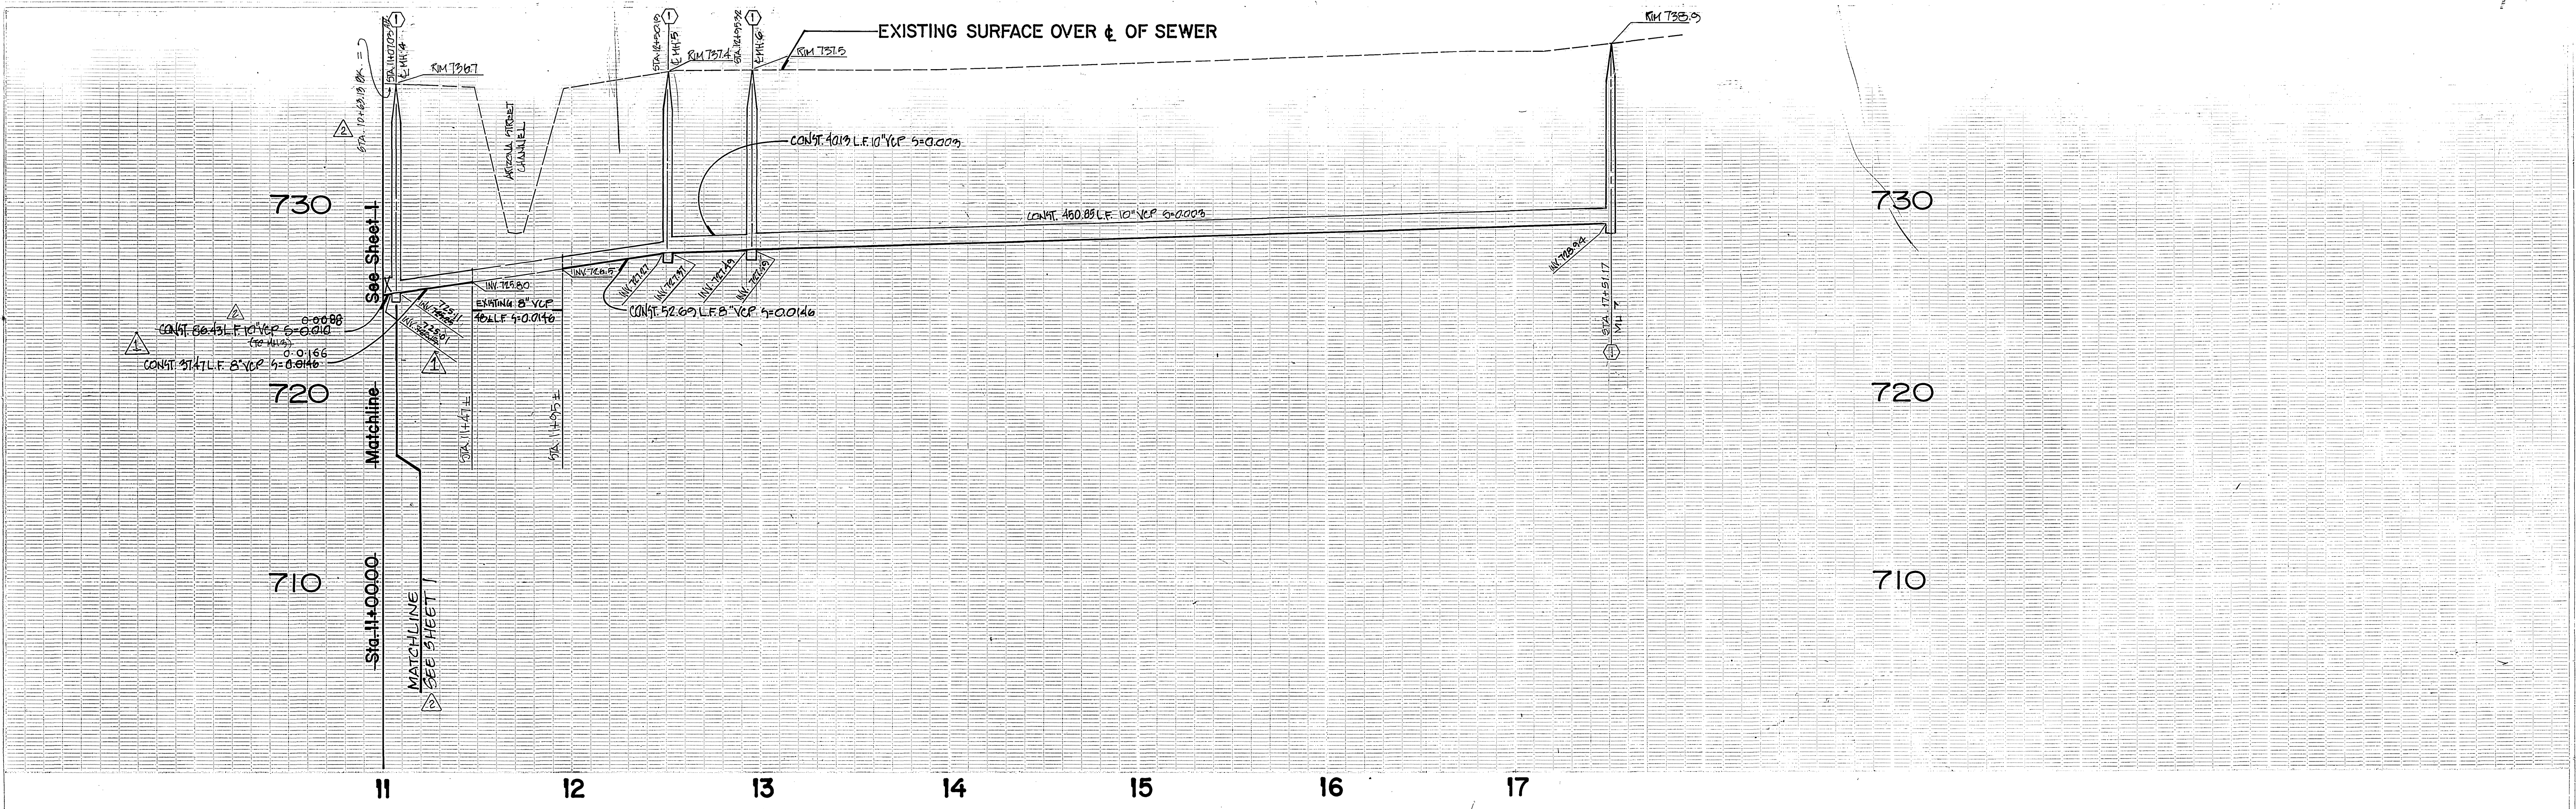

ALBERT A. WEBB ASSOCIATES
 CIVIL ENGINEERS
 3788 McCRAY ST. RIVERSIDE, CA 92506
 (909) 686-1070

APPROVED BY: *Mohammad Fajal*
 DATE: 2-17-97
 C.E. NO. C39530



License expires 9.30.89

BENCH MARK: CITY OF RIVERSIDE BENCHMARK 8'-0" FOUND P.K. NAIL MARKED "B.M." IN CENTER OF SOUTHEAST CURB RETURN AT INDIANA AVENUE AND FILLMORE STREET ELEVATION=738.868'	PLANS PREPARED BY: DON GREEK & ASSOCIATES 2428 N. GRAND AVE. SUITE L SANTA ANA, CA, 92701 TEL (714) 543-0190 PREPARED UNDER THE SUPERVISION OF: <i>Surrender Dewan</i> 4.12.88 SURRENDER DEWAN R.C.E. 34559	CITY OF RIVERSIDE PUBLIC WORKS DEPARTMENT APPROVED BY: <i>Carly Bed</i> DATE: 5-3-88 PRINCIPAL ENGINEER TRAFFIC DIVISION CHIEF P.W. ENGINEER DATE: 7/18/88	SEWER PLAN & PROFILE PRICE COURT TO LA SIERRA AVENUE PM 23068; R-17-834 CU-005-967 HORIZ. SCALE: 1" = 40' VERT. SCALE: 1" = 4'	ACCOUNT NO. S-1459 SHEET 2 OF 2