


B.M. ELEV. 825.69' - S. & L. IN N. CB. HOMEWOOD CT. IN FRONT OF HSE #4285. SEE B.M. BOOK.
 B.M. ELEV. 826.21' - SPK. IN POLE #609801 600' W. OF BROCKTON ON S. SIDE OF ALTA VISTA DR.
 F.B. 603/73-76
 SCALES: HOR. 1" = 20' VERT. 1" = 2'

PROFILE	SURVEYED	BY	DATE
NOTE BOOK NO.	GRADES CHECKED		
	B.M. NOTED		
	STRUCTURE NOTATIONS CHECKED		

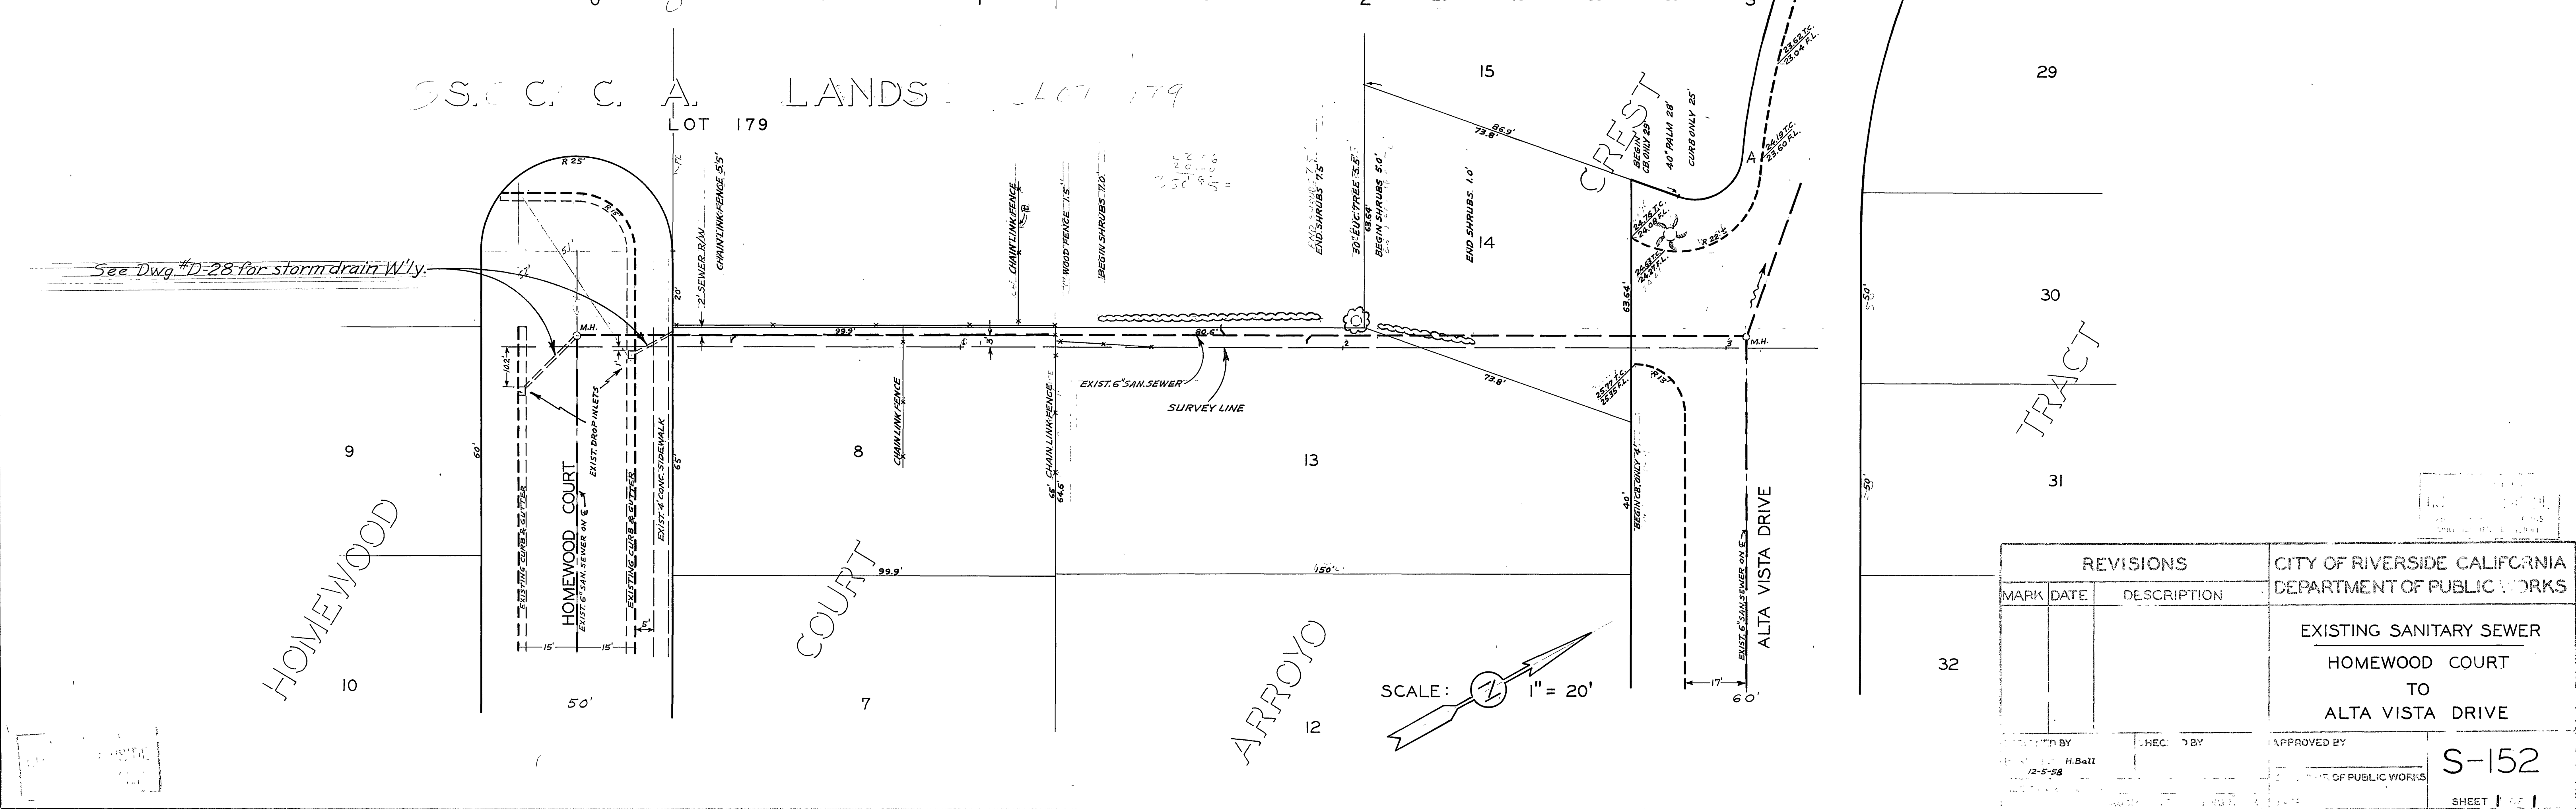

REVISIONS		CITY OF RIVERSIDE CALIFORNIA DEPARTMENT OF PUBLIC WORKS
MARK	DATE	
		EXISTING SANITARY SEWER HOMEWOOD COURT TO ALTA VISTA DRIVE

DESIGNED BY H. Ball 12-5-58	CHECKED BY	APPROVED BY
-----------------------------------	------------	-------------

S-152
SHEET 1

PLAN	SURVEYED	BY	DATE
NOTE BOOK NO.	PLANTING CHECKED		
	RT. OF WAY CHECKED		