

Underground Service Alert

Call: TOLL FREE
1-800-422-4133

TWO WORKING DAYS BEFORE YOU DIG

PRIVATE ENGINEERING NOTE

CONSTRUCTION CONTRACTOR AGREES THAT IN ACCORDANCE WITH GENERALLY ACCEPTED CONSTRUCTION PRACTICES CONSTRUCTION CONTRACTOR WILL BE REQUIRED TO ASSUME SOLE AND COMPLETE RESPONSIBILITY FOR JOB SITE CONDITIONS DURING THE COURSE OF CONSTRUCTION OF THE PROJECT, INCLUDING SAFETY OF ALL PERSONS AND PROPERTY. THAT THIS REQUIREMENT SHALL BE MADE TO APPLY CONTINUOUSLY AND NOT BE LIMITED TO NORMAL WORKING HOURS, AND CONSTRUCTION CONTRACTOR FURTHER AGREES TO DEFEND, INDEMNIFY AND HOLD DESIGN PROFESSIONAL HARMLESS FROM ANY AND ALL LIABILITY, REAL OR ALLEGED, IN CONNECTION WITH THE PERFORMANCE OF WORK ON THIS PROJECT EXCEPTING LIABILITY ARISING FROM THE SOLE NEGLIGENCE OF DESIGN PROFESSIONAL.

REGISTERED PROFESSIONAL ENGINEER
RICHARD D. GRANOFF
No. C22522
Exp. 12-31-89
CIVIL
STATE OF CALIFORNIA

PREPARED UNDER THE DIRECTION OF:
Robey D. Campbell
REGISTERED CIVIL ENGINEER NO. 22522
EXPIRATION DATE: 12/31/89 DATE: 9-8-89

APPROVED BY:

J.F. Davidson Associates, Inc.
ENGINEERING PLANNING SURVEYING ARCHITECTURE LANDSCAPE ARCHITECTURE

3880 Lemon Street, Suite 300 P.O. Box 493 Riverside, CA 92502 (714) 686-6844 FAX 714-686-5954

11200 S. Mt. Vernon Ave., Suite "D" Colton, CA 92324 (714) 825-1082

23-080 El Paseo, Suite 106 Palm Desert, CA 92260 (818) 346-5691 FAX 818-340-0529

SCALE: AS SHOWN
DATE: JUN 1988

SEE SHEET 1

DESIGNED BY M.M. DRAWN BY L.A.T. CHECKED BY R.C.H.

ADDED SEWER LATERAL
ADDED TELEPHONE LINE

REVISIONS

APPR / DATE

CITY OF RIVERSIDE, CALIFORNIA
DEPARTMENT OF PUBLIC WORKS

APPROVED BY: [Signature] DATE: 12/15/89

PRINCIPAL ENGINEER: [Signature] DATE: 12/15/89

TRAFFIC DIVISION: [Signature] DATE: 12/15/89



CHIEF P.W. ENGR: [Signature] DATE: 12/15/89

CFD 86-1 IMPROVEMENT AREA No. 1
SEWER IMPROVEMENT PLANS
MISSION GROVE PKWY SO
STA. 20+00.00 TO STA. 32+00.00

PROJECT NO. S-1544
SHEET 38 OF 88
FILE NO: 8710164

HORIZ. SCALE: 1" = 40'
VERT. SCALE: 1" = 4'

INDEXED 7-24-90 4H

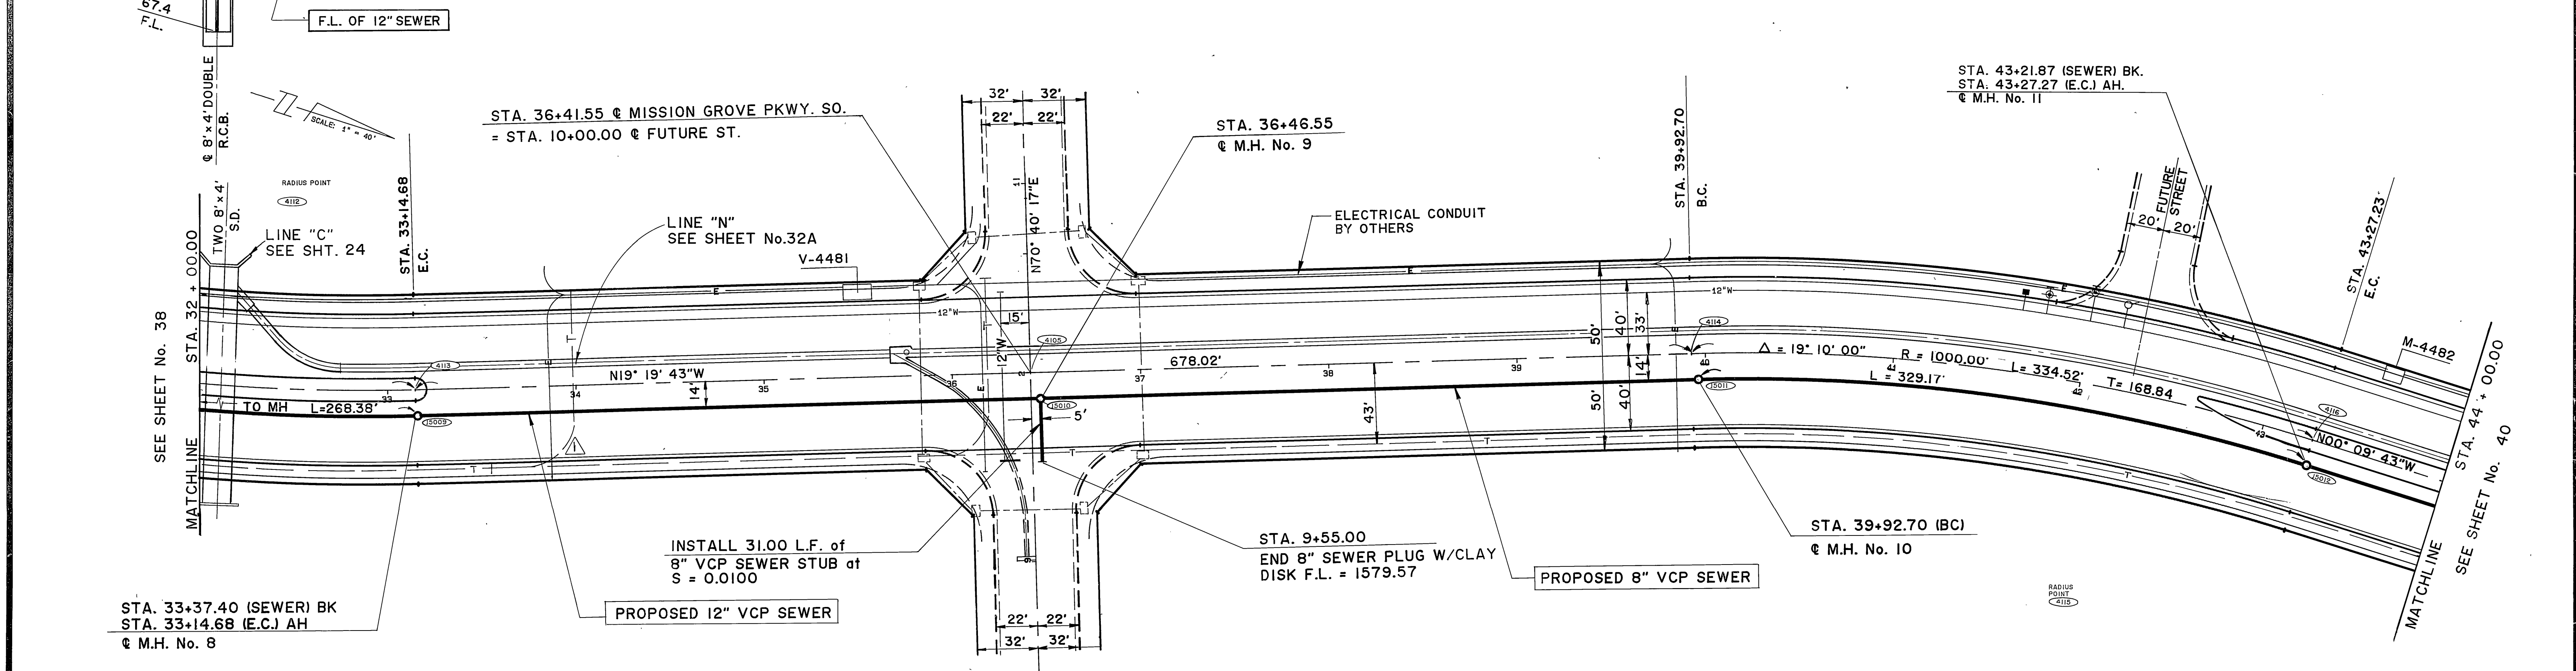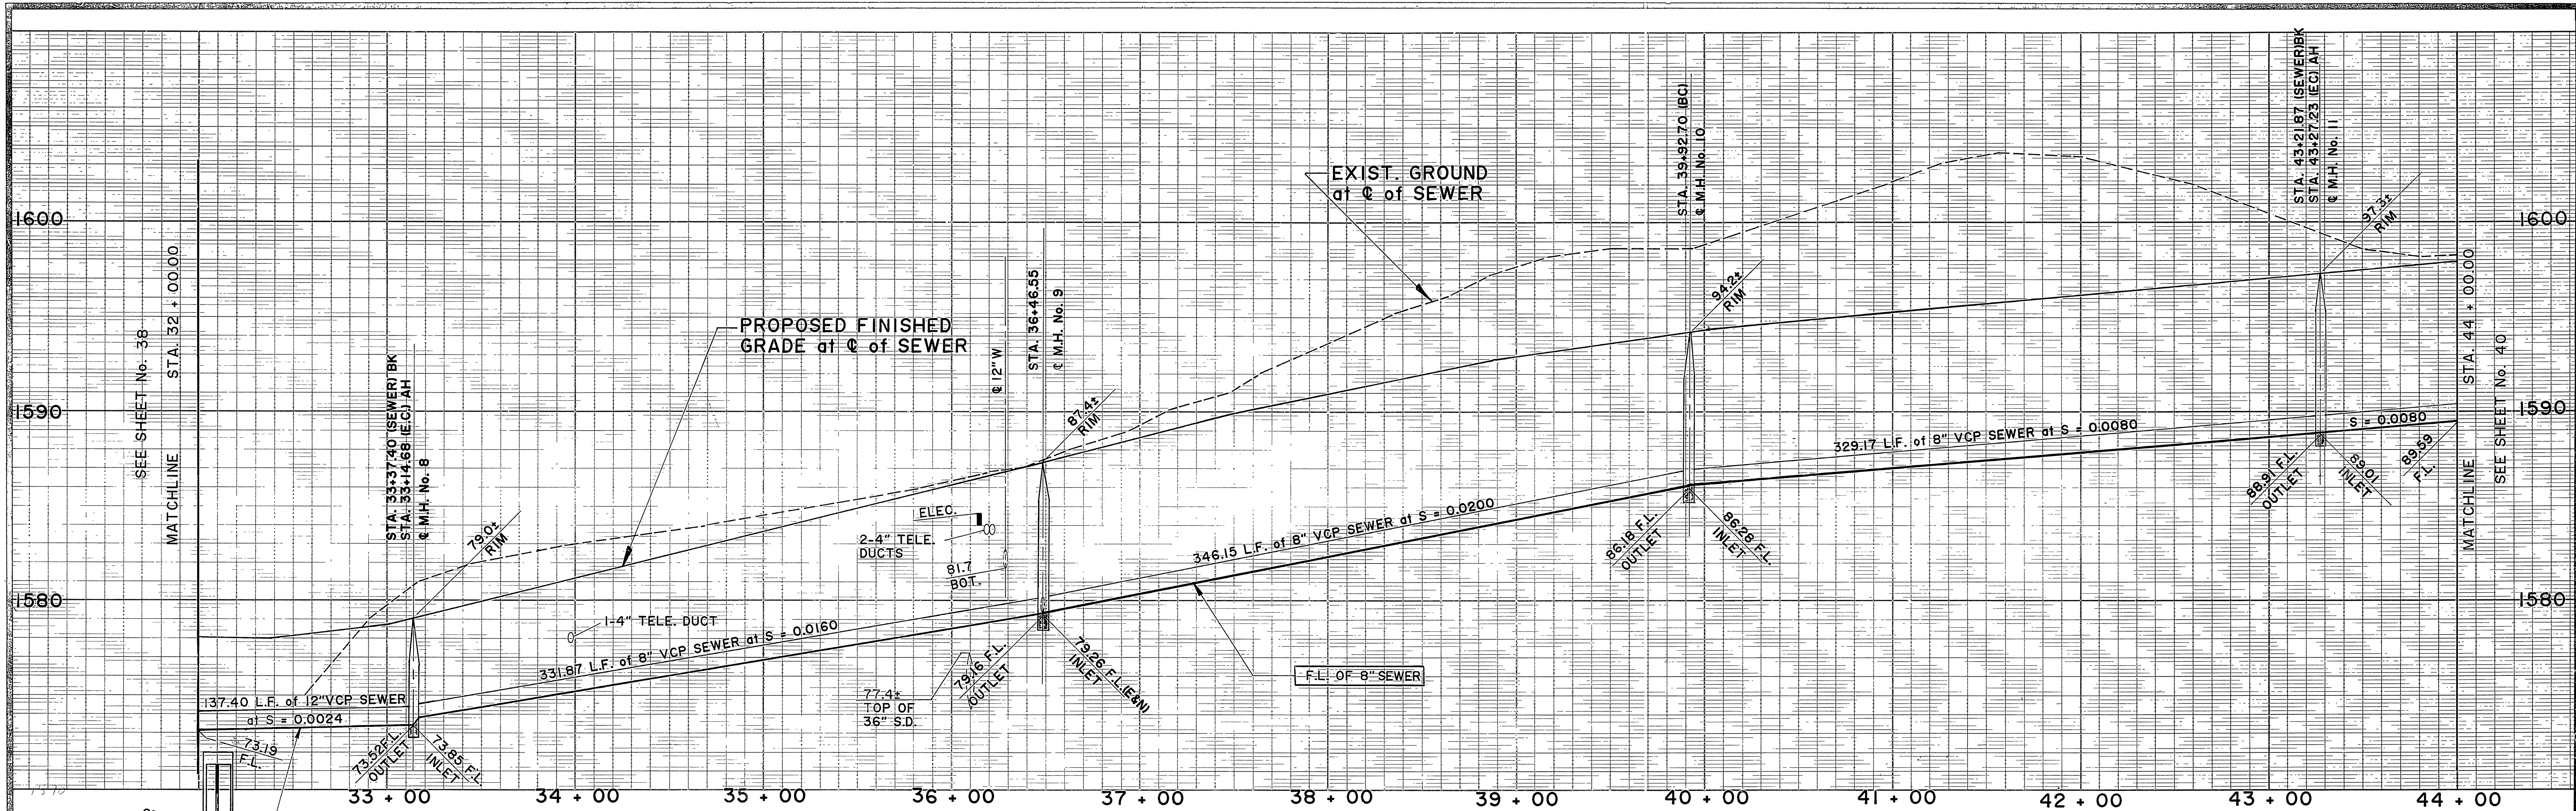


MISSION GROVE PKWY (SOUTH)

NOTE: SEE SHEET 2 FOR SEWER CONSTRUCTION NOTES.

SEE R-3056 & S-1544 FOR BALANCE OF PLANS

Underground Service Alert
 Call: TOLL FREE
1-800 422-4133
 TWO WORKING DAYS BEFORE YOU DIG

PRIVATE ENGINEERING NOTE
 CONSTRUCTION CONTRACTOR AGREES THAT IN ACCORDANCE WITH GENERALLY ACCEPTED CONSTRUCTION PRACTICES, CONSTRUCTION CONTRACTOR WILL BE REQUIRED TO ASSUME SOLE AND COMPLETE RESPONSIBILITY FOR JOB SITE CONDITIONS DURING THE COURSE OF CONSTRUCTION OF THE PROJECT, INCLUDING SAFETY OF ALL PERSONS AND PROPERTY. THAT THIS REQUIREMENT SHALL BE MADE TO APPLY CONTINUOUSLY AND NOT BE LIMITED TO NORMAL WORKING HOURS AND CONSTRUCTION CONTRACTOR FURTHER AGREES TO DEFEND, INDEMNIFY AND HOLD DESIGN PROFESSIONAL HARMLESS FROM ANY AND ALL LIABILITY, REAL OR ALLEGED, IN CONNECTION WITH THE PERFORMANCE OF WORK ON THIS PROJECT, EXCEPTING LIABILITY ARISING FROM THE SOLE NEGLIGENCE OF DESIGN PROFESSIONAL.

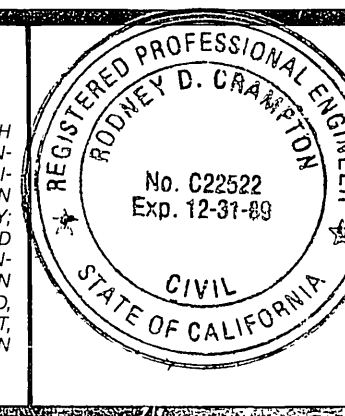




PREPARED UNDER THE DIRECTION OF:
Rodney D. Crawford
 REGISTERED CIVIL ENGINEER NO. 22522
 EXPIRATION DATE: 12/31/89 DATE: 9-8-89
 APPROVED BY:

J.F. Davidson Associates, Inc.
 ENGINEERING PLANNING SURVEYING ARCHITECTURE LANDSCAPE ARCHITECTURE
 3880 Lemon Street, Suite 300 P.O. Box 483 Riverside, CA 92502 (714) 686-0844 FAX 714-686-5954
 11200 S. Mt. Vernon Ave., Suite "D" Colton, CA 92524 (714) 825-1082
 73480 El Paseo, Suite 106 Palm Desert, CA 92260 (619) 346-5891 FAX 619-340-0529
 BENCH MARK: SEE SHEET I
 DATE: JUN 1988

DESIGNED BY	RDC	DRAWN BY	F.P.	CHECKED BY	R.C.H.
ADDED TELEPHONE LINE					
REVISIONS					
APPROVED BY: [Signature]					

CITY OF RIVERSIDE, CALIFORNIA
DEPARTMENT OF PUBLIC WORKS
 APPROVED BY: [Signature] DATE: 12/15/89
 PRINCIPAL ENGINEER: [Signature]
 TRAFFIC DIVISION: [Signature]
 CHIEF P.W. ENGR: [Signature]

CFD 86-1 IMPROVEMENT AREA No. 1
 SEWER IMPROVEMENT PLANS
MISSION GROVE PKWY SO
 STA. 32+00.00 TO STA. 44+00.00
 PROJECT NO. **S-1544**
 SHEET **39** OF **88**
 HORIZ. SCALE: 1"=40' VERT. SCALE: 1"=4'
 FILE NO.: 8710164
 INDEXED 7-24-90 lfh

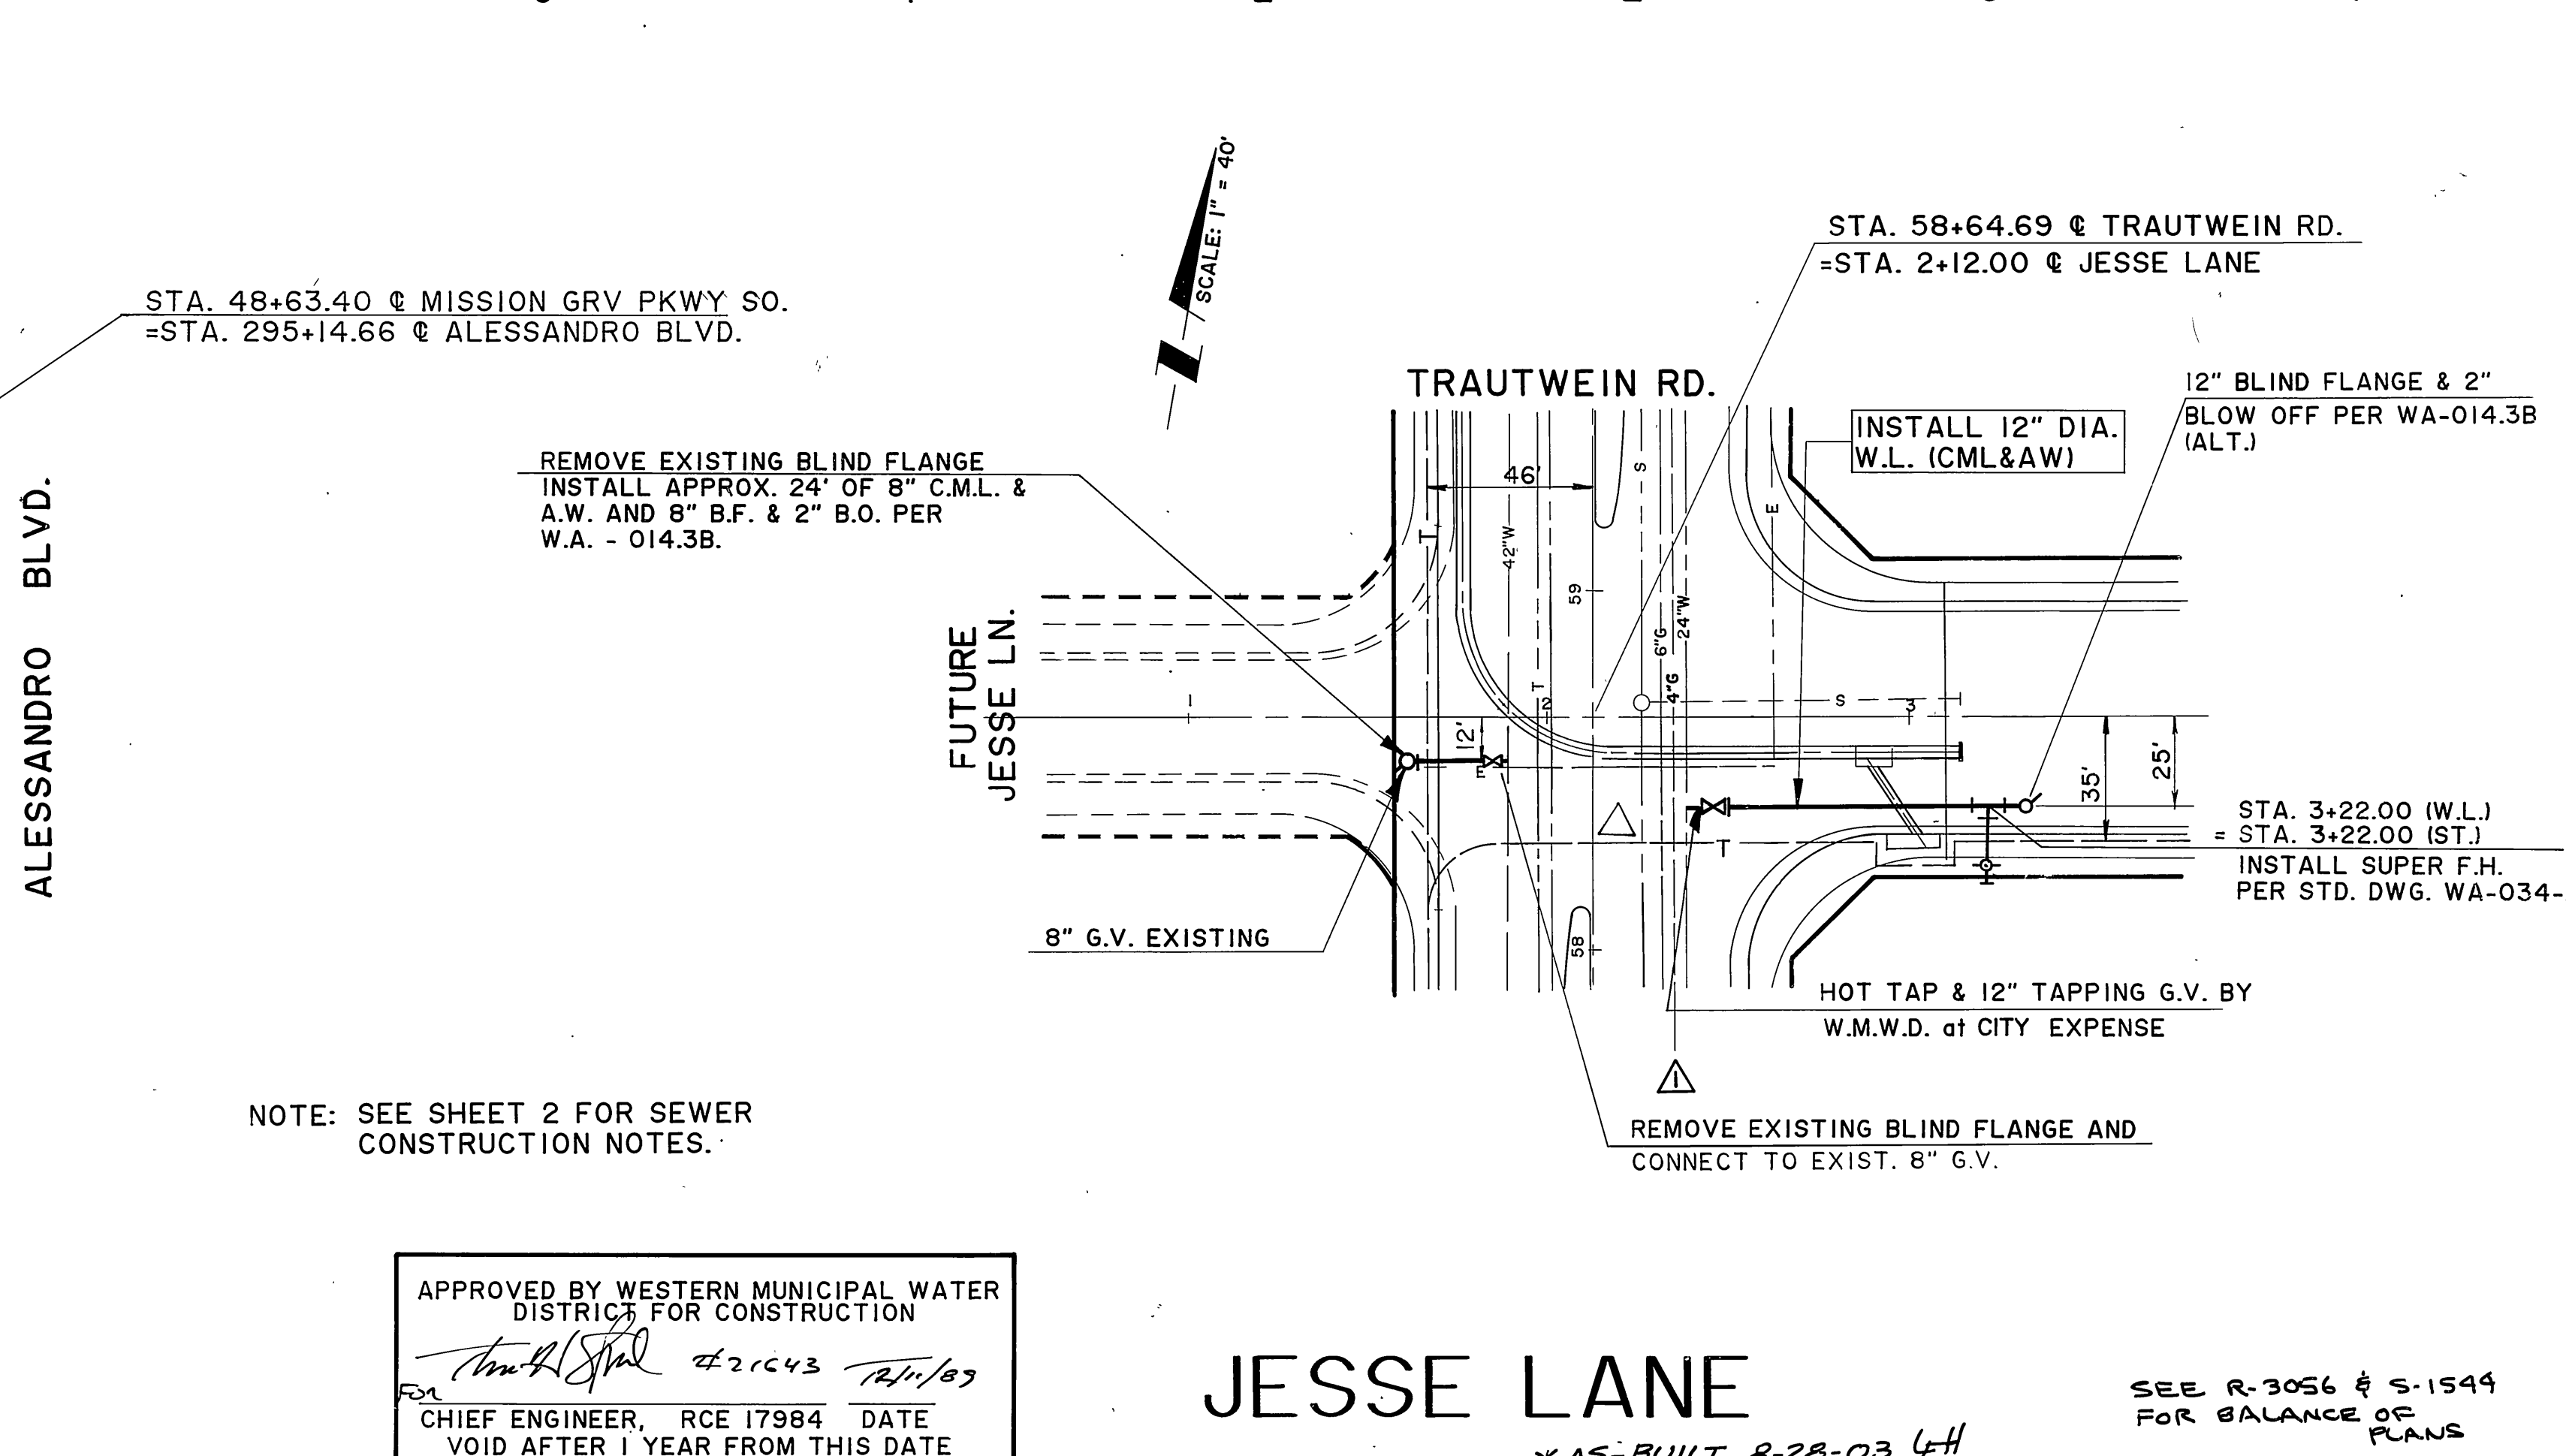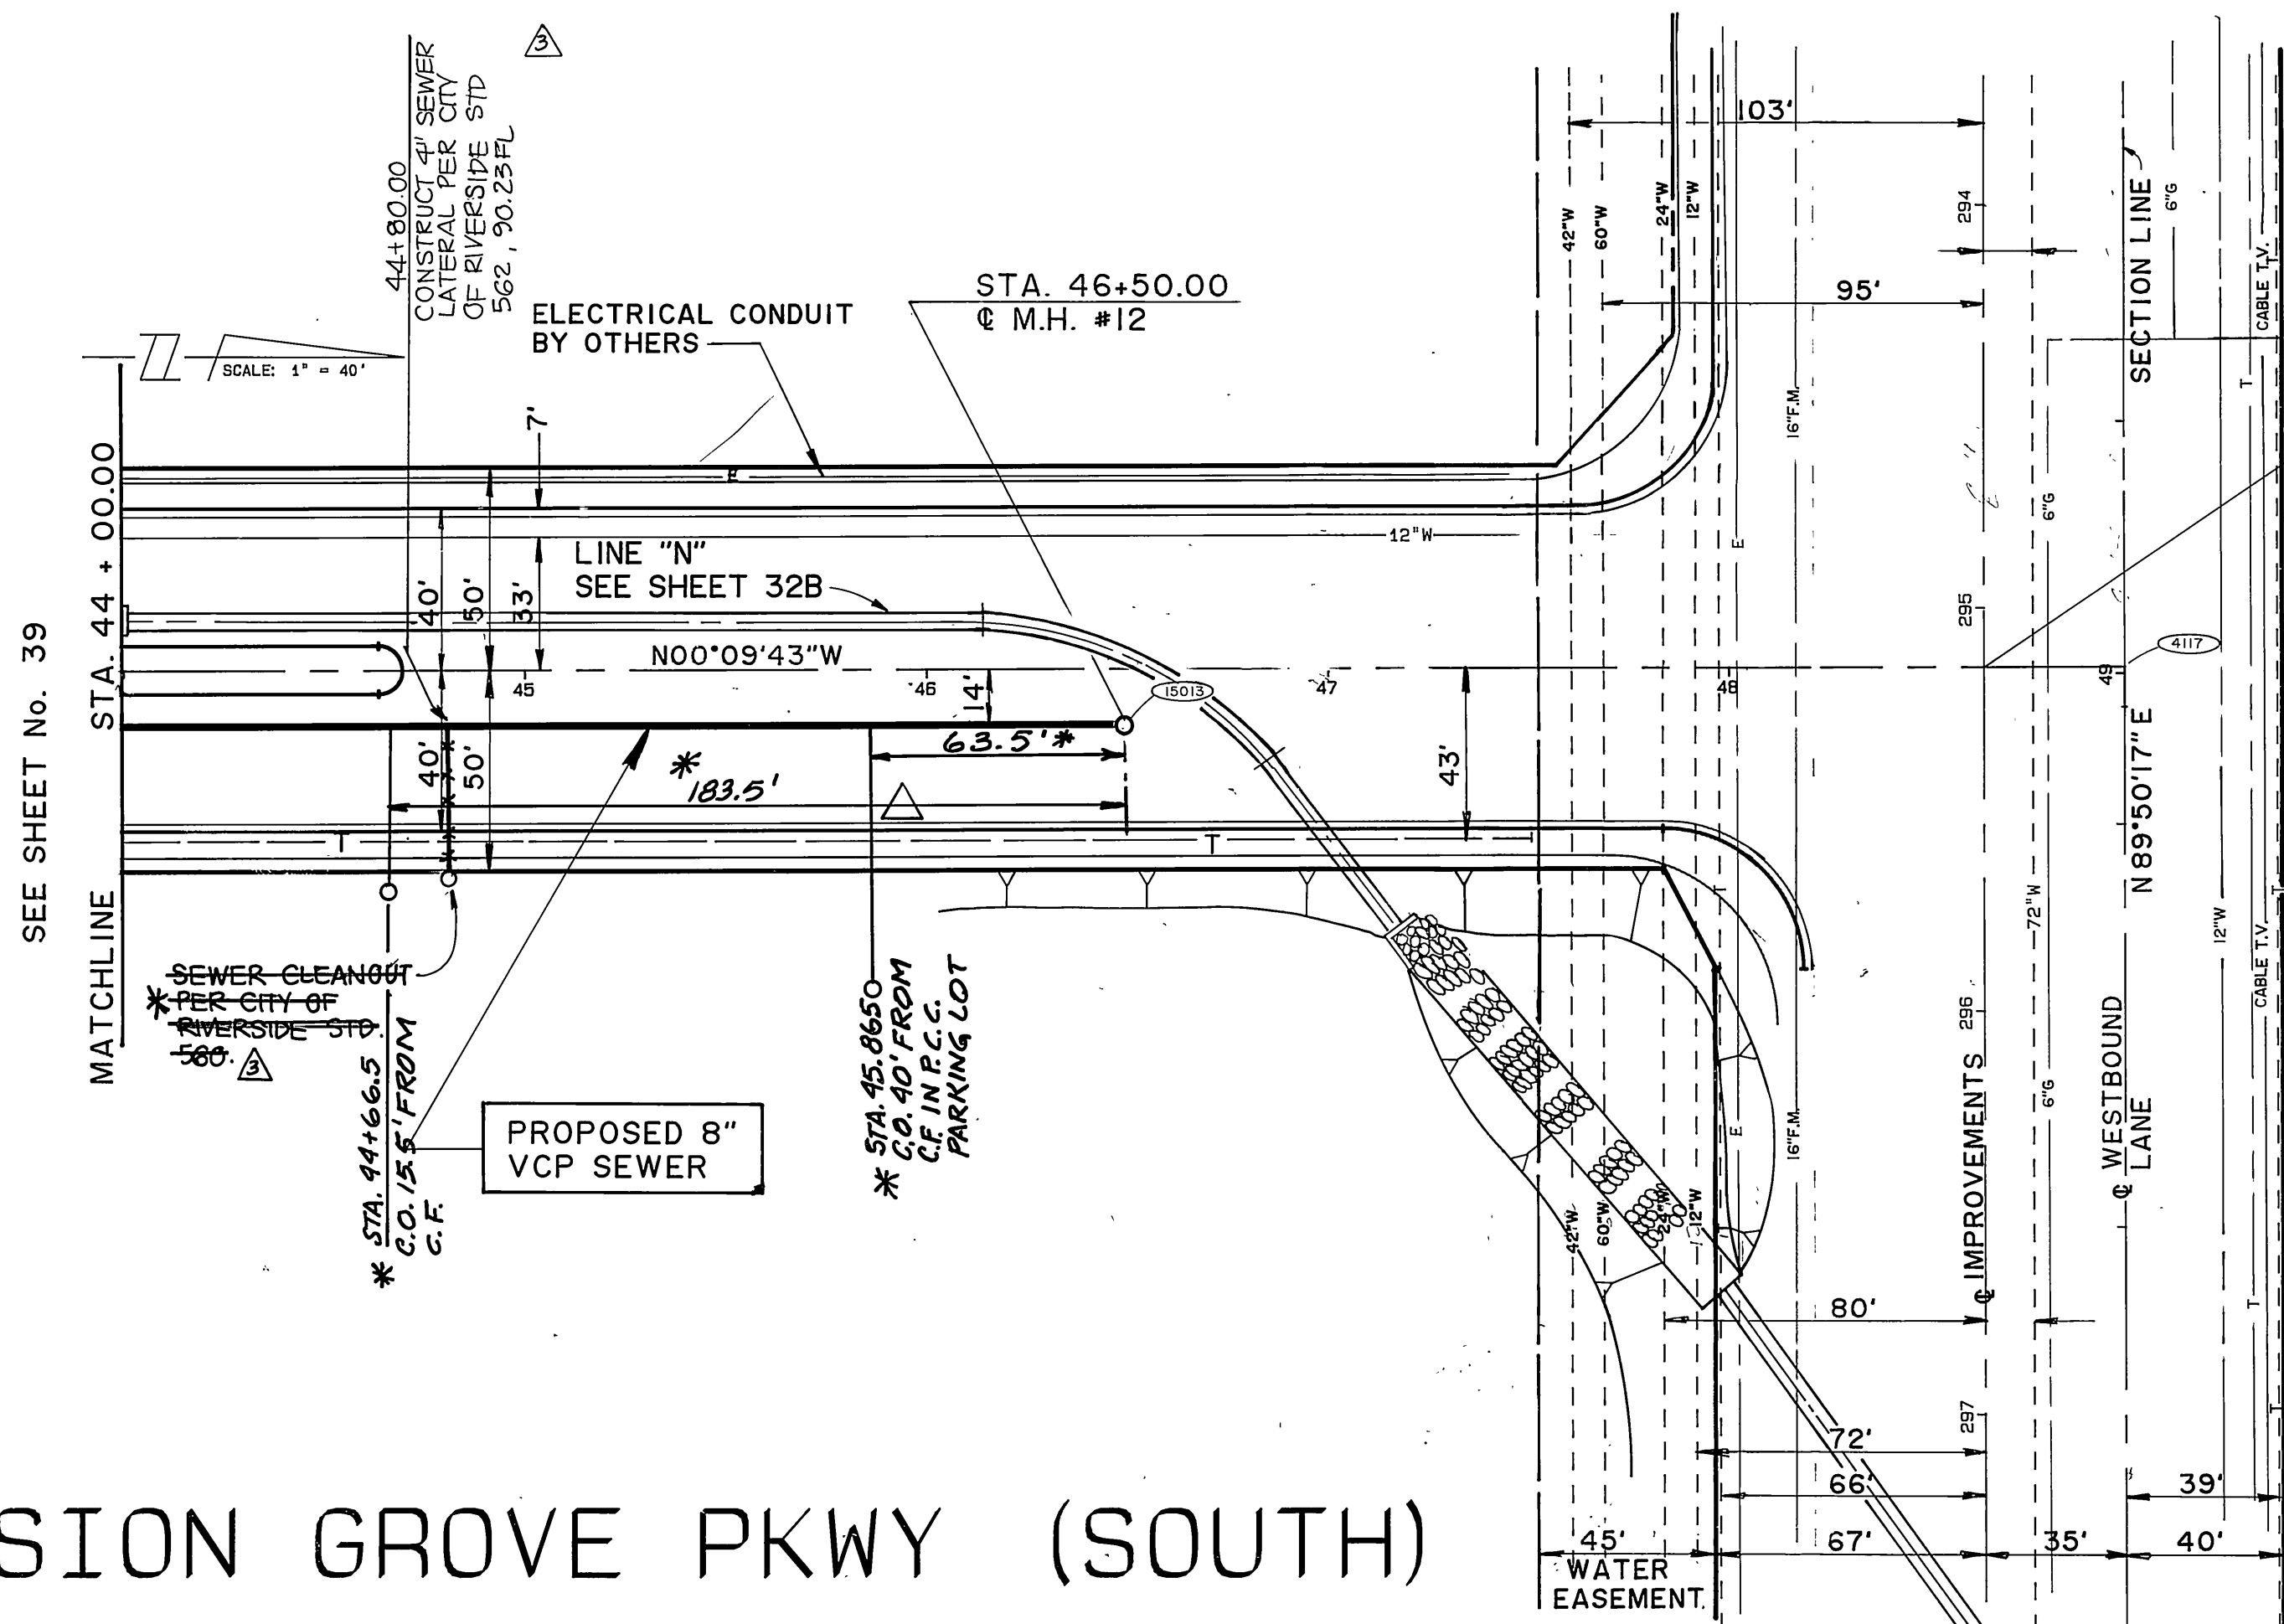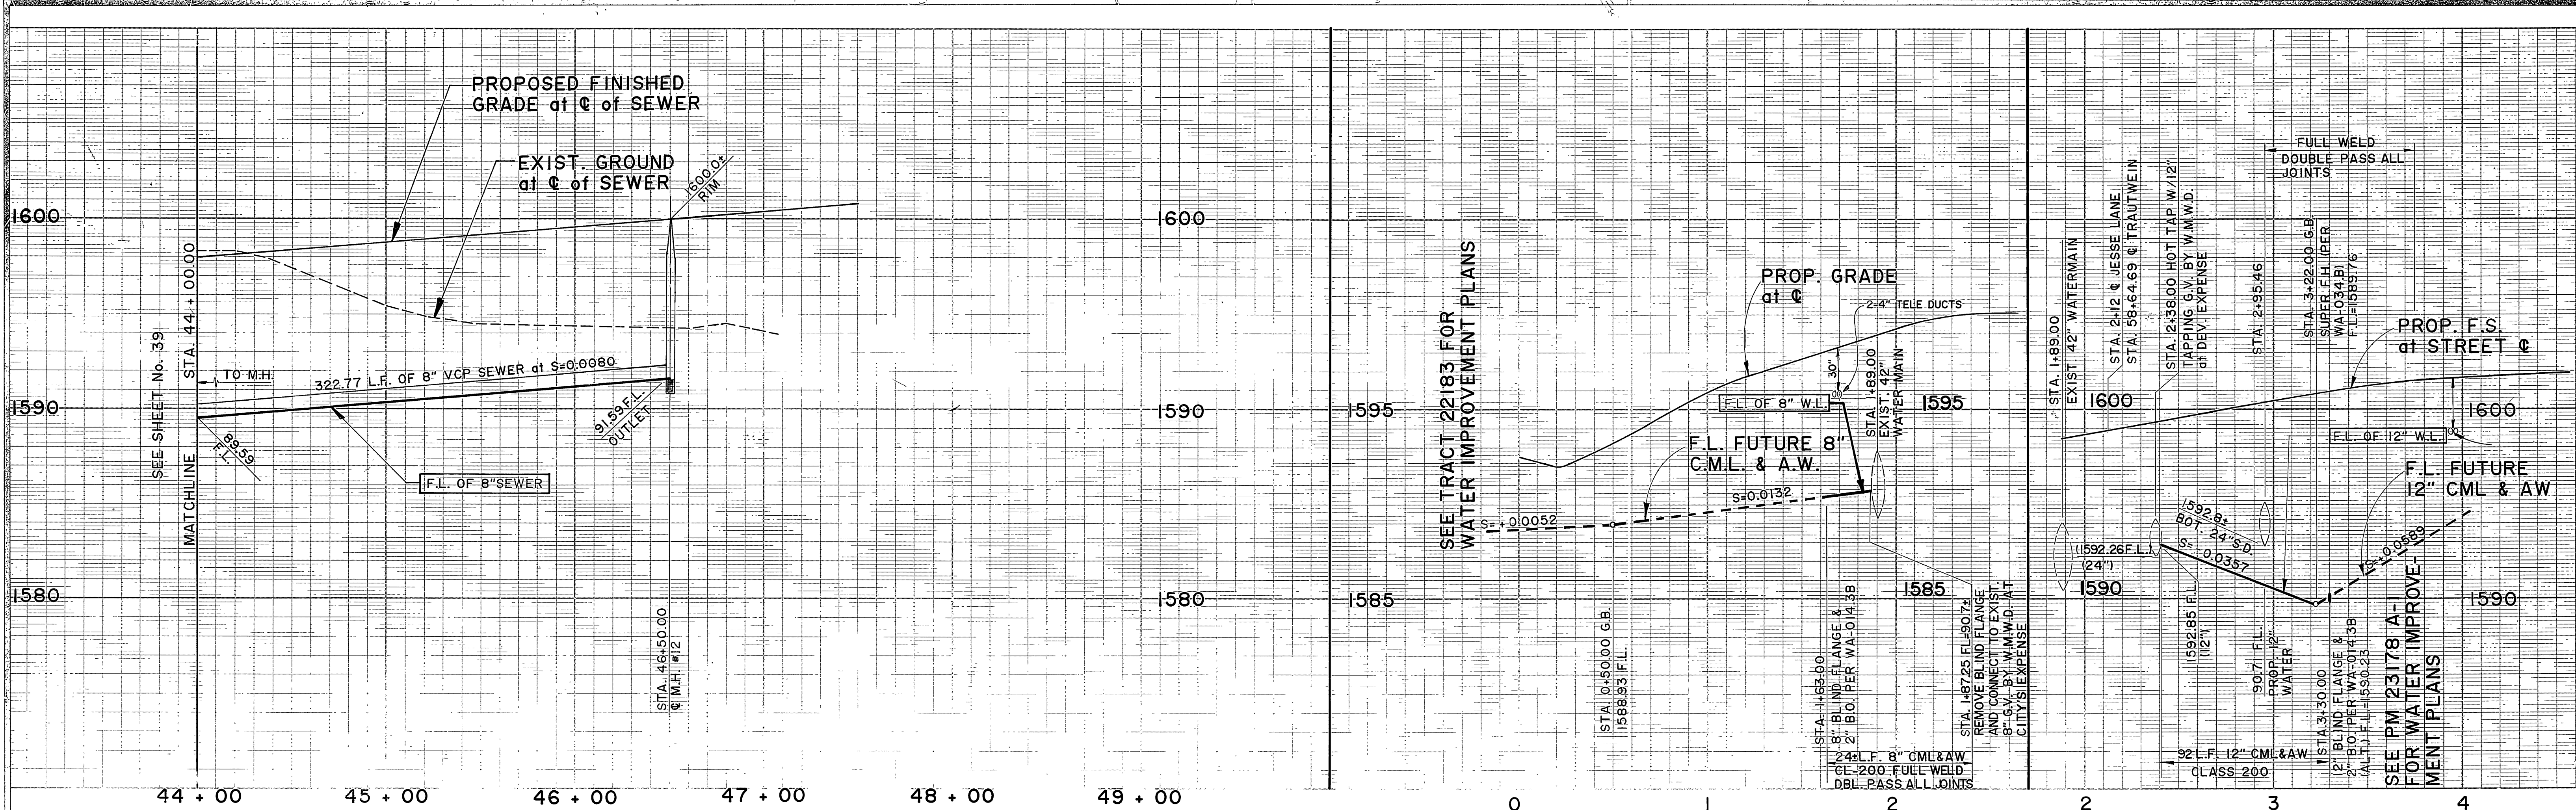

MISSION GROVE PKWY (SOUTH)


JESSE LANE

APPROVED BY WESTERN MUNICIPAL WATER DISTRICT FOR CONSTRUCTION
Tom H. Spald 12/15/89
 CHIEF ENGINEER, RCE 17984 DATE
 VOID AFTER 1 YEAR FROM THIS DATE

SEE R-3056 & S-1544 FOR BALANCE OF PLANS

Underground Service Alert
 Call: TOLL FREE
 1-800-422-4133
 TWO WORKING DAYS BEFORE YOU DIG

PRIVATE ENGINEERING NOTE
 CONSTRUCTION CONTRACTOR AGREES THAT IN ACCORDANCE WITH GENERALLY ACCEPTED CONSTRUCTION PRACTICES, CONSTRUCTION CONTRACTOR WILL BE REQUIRED TO ASSUME SOLE AND COMPLETE RESPONSIBILITY FOR JOB SITE CONDITIONS DURING THE COURSE OF CONSTRUCTION OF THE PROJECT, INCLUDING SAFETY OF ALL PERSONS AND PROPERTY. THAT THIS REQUIREMENT SHALL BE MADE TO APPLY CONTINUOUSLY AND NOT BE LIMITED TO NORMAL WORKING HOURS, AND CONSTRUCTION CONTRACTOR FURTHER AGREES TO DEFEND, INDEMNIFY AND HOLD DESIGN PROFESSIONAL HARMLESS FROM ANY AND ALL LIABILITY, REAL OR ALLEGED, IN CONNECTION WITH THE PERFORMANCE OF WORK ON THIS PROJECT, EXCEPTING LIABILITY ARISING FROM THE SOLE NEGLIGENCE OF DESIGN PROFESSIONAL.

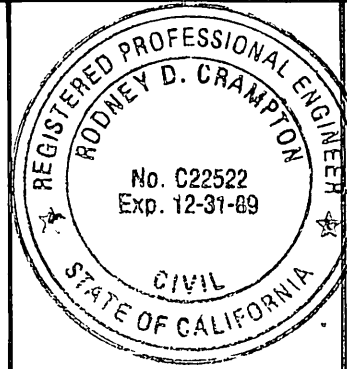

PREPARED UNDER THE DIRECTION OF:
Robyn D. Crampston
 REGISTERED CIVIL ENGINEER NO. 22522
 EXPIRATION DATE: 12/31/89 DATE: 9-8-89
 APPROVED BY:

J.F. Davidson Associates, Inc.
 ENGINEERING PLANNING SURVEYING ARCHITECTURE LANDSCAPE ARCHITECTURE
 3880 Lemon Street, Suite 300 P.O. Box 483
 Riverside, CA 92502 (714) 686-0844 FAX 714-686-5954
 11200 S Mt Vernon Ave., Suite "D" Colton, CA 92324 (714) 825-1082
 73-080 El Paseo, Suite 106 Palm Desert, CA 92260 (818) 346-6891 FAX 818-346-2629

SCALE: BENCH MARK: SEE SHEET 1
 DATE: JUN 1988

DESIGNED BY: RDC	DRAWN BY: F.P.	CHECKED BY: R.C.H.
ADDED 4" SEWER LATERAL	TCL 11/19/89	12/15/89
ADDED TELEPHONE LINES	3	12/15/89
ADDED 4" GAS		
REVISIONS	APPR. DATE	
TRAFFIC DIVISION		
CHIEF P.W. ENGR.		

CITY OF RIVERSIDE, CALIFORNIA
 DEPARTMENT OF PUBLIC WORKS
 APPROVED BY: *Bary Bul*
 DIRECTOR OF PUBLIC WORKS
 DATE: 12/15/89

CFD 86-1 IMPROVEMENT AREA No. 1
 SEWER & WATER IMPROVEMENT PLANS
MISSION GROVE PKWY SO
 STA. 44+00.00 TO STA. 46+50.00
 PROJECT NO. **S-1544**
 SHEET **40** OF **88**
 HORIZ. SCALE: 1"=40' VERT. SCALE: 1"=4'
 FILE NO. 8710164
 INDEXED 7-24-90 JH